

ADDENDUM NO. 3

PENDER COUNTY LAW ENFORCEMENT CENTER

PENDER COUNTY
BURGAW, NORTH CAROLINA

Architect's Project Number: 611888

Prepared by

MOSELEY ARCHITECTS
6210 ARDREY KELL ROAD
THE HUB AT WAVERLY PLACE, SUITE 425
CHARLOTTE, NORTH CAROLINA 28277

DATE OF ISSUE – JUNE 12, 2024

**PENDER COUNTY LAW ENFORCEMENT CENTER
BURGAW, NC**

1
2
3
GENERAL:

Planholders are requested to insert this Addendum in the front of their Project Manual. Inform all concerned that the Bidding Documents are modified by this Addendum.

The following modifications and clarifications are hereby made a part of the Bidding Documents and supersede or otherwise modify the provisions of the published *Project Manual* and *Drawings*, dated May 01, 2024.

Refer to the Drawings, Specification Sections, or other Documents, if any, attached to this Addendum, which are hereby made a part of this Addendum.

MODIFICATIONS TO THE PROJECT MANUAL:

SECTION 000110 – TABLE OF CONTENTS

REPLACE this entire section

SECTION 042000 – UNIT MASONRY

REPLACE this entire section

SECTION 078100 – APPLIED FIREPROOFING

DELTE this entire section

SECTION 064100 – ARCHITECTURAL WOODWORK & CASEWORK

REPLACE this entire section

SECTION 083313 – COILING COUNTER DOORS

REPLACE this entire section

SECTION 085653 – SECURITY WINDOWS

REPLACE this entire section

SECTION 092900 – GYPSUM BOARD

REPLACE this entire section

SECTION 096536 – STATIC-CONTROL RESILIENT FLOORING

ADD this entire section

SECTION 096700 – FLUID APPLIED FLOORING

REPLACE this entire section

SECTION 096813 – TILE CARPETING

REPLACE this entire section

SECTION 096813.13 – STATIC-CONTROL TILE CARPETING

REPLACE this entire section

**PENDER COUNTY LAW ENFORCEMENT CENTER
BURGAW, NC**

49 MODIFICATIONS TO THE DRAWINGS:

- 50 SHEET G0.1
- 51 REPLACE with attached
- 52
- 53 SHEET LS1.1
- 54 REPLACE with attached
- 55
- 56 SHEET LS2.1
- 57 REPLACE with attached
- 58
- 59 SHEET LS2.2
- 60 REPLACE with attached
- 61
- 62 SHEET LS2.3
- 63 REPLACE with attached
- 64
- 65 SHEET LS4.1
- 66 REPLACE with attached
- 67
- 68 SHEET LS4.2
- 69 REPLACE with attached
- 70
- 71 SHEET LS4.3
- 72 DELETE this sheet entirely
- 73
- 74 SHEET LS4.4
- 75 DELETE this sheet entirely
- 76
- 77 SHEET LS4.5
- 78 DELETE this sheet entirely
- 79
- 80 SHEET C5.03
- 81 REPLACE this sheet entirely
- 82
- 83 SHEET A2.1.1
- 84 REPLACE with attached
- 85
- 86 SHEET A2.1.2
- 87 REPLACE with attached
- 88
- 89 SHEET A2.1.3
- 90 REPLACE with attached
- 91
- 92 SHEET A2.1.4
- 93 REPLACE with attached
- 94
- 95 SHEET A2.1.5
- 96 REPLACE with attached
- 97
- 98 SHEET A2.1.6
- 99 REPLACE with attached

100

**PENDER COUNTY LAW ENFORCEMENT CENTER
BURGAW, NC**

101 SHEET A2.1.12
102 REPLACE with attached
103
104 SHEET A2.1.13
105 REPLACE with attached
106
107 SHEET A2.1.14
108 REPLACE with attached
109
110 SHEET A2.1.15
111 REPLACE with attached
112
113 SHEET A3.0.1
114 REPLACE this sheet entirely
115
116 SHEET A3.2.2
117 REPLACE with attached
118
119 SHEET A5.1.2
120 REPLACE with attached
121
122 SHEET A5.1.3
123 REPLACE with attached
124
125 SHEET A5.1.4
126 REPLACE with attached
127
128 SHEET A5.1.5
129 REPLACE with attached
130
131 SHEET A5.1.6
132 REPLACE with attached
133
134 SHEET A5.1.7
135 REPLACE with attached
136
137 SHEET A5.1.8
138 REPLACE with attached
139
140 SHEET A7.1.1
141 REPLACE with attached
142
143 SHEET A7.1.2
144 REPLACE with attached
145
146 SHEET A7.1.9
147 REPLACE with attached
148
149 SHEET A8.1.1
150 REPLACE with attached
151
152

**PENDER COUNTY LAW ENFORCEMENT CENTER
BURGAW, NC**

153 SHEET A8.1.2
154 REPLACE with attached
155
156 SHEET P2.0.2
157 REPLACE with attached
158
159 SHEET P2.1.2
160 REPLACE with attached
161
162 SHEET P2.1.3
163 REPLACE with attached
164
165 SHEET P2.1.5
166 REPLACE with attached
167
168 SHEET P2.1.6
169 REPLACE with attached
170
171 SHEET P2.1.7
172 REPLACE with attached
173
174 SHEET P2.1.8
175 REPLACE with attached
176
177 SHEET P2.2.2
178 REPLACE with attached
179
180 SHEET P2.3.1
181 REPLACE with attached
182
183 SHEET P2.3.2
184 REPLACE with attached
185
186 SHEET P2.3.3
187 REPLACE with attached
188
189 SHEET P2.3.4
190 REPLACE with attached
191
192 SHEET P2.4.1
193 REPLACE with attached
194
195 SHEET P2.4.2
196 REPLACE with attached
197
198 SHEET P2.4.3
199 REPLACE with attached
200
201 SHEET P2.4.5
202 REPLACE with attached
203
204

**PENDER COUNTY LAW ENFORCEMENT CENTER
BURGAW, NC**

205 SHEET P2.4.6
206 REPLACE with attached
207
208 SHEET P5.3
209 REPLACE with attached
210
211 SHEET P5.4
212 REPLACE with attached
213
214 SHEET P6.1
215 REPLACE with attached
216
217 SHEET M0.2
218 REPLACE with attached
219
220
236 **ATTACHMENTS:**

237 SPECIFICATIONS:
238 000110
239 042000
240 064100
241 083313
242 085653
243 092900
244 096536
245 096700
246 096813
247 096813.13
248

**PENDER COUNTY LAW ENFORCEMENT CENTER
BURGAW, NC**

249 DRAWINGS:

- 250 G0.1
- 251 LS1.1
- 252 LS2.1
- 253 LS2.2
- 254 LS2.3
- 255 LS4.1
- 256 LS4.2
- 257 C5.03
- 258 A2.1.1
- 259 A2.1.2
- 260 A2.1.3
- 261 A2.1.4
- 262 A2.1.5
- 263 A2.1.6
- 264 A2.1.12
- 265 A2.1.13
- 266 A2.1.14
- 267 A2.1.15
- 268 A3.0.1
- 269 A3.2.2
- 270 A5.1.2
- 271 A5.1.3
- 272 A5.1.4
- 273 A5.1.5
- 274 A5.1.6
- 275 A5.1.7
- 276 A5.1.8
- 277 A7.1.1
- 278 A7.1.2
- 279 A7.1.9
- 280 A8.1.1
- 281 A8.1.2
- 282 P2.02
- 283 P2.1.2
- 284 P2.1.3

**PENDER COUNTY LAW ENFORCEMENT CENTER
BURGAW, NC**

285	P2.1.5
286	P2.1.6
287	P2.1.7
288	P2.1.8
289	P2.2.2
290	P2.3.1
291	P2.3.2
292	P2.3.3
293	P2.3.4
294	P2.4.1
295	P2.4.2
296	P2.4.3
297	P2.4.5
298	P2.4.6
299	P5.3
300	P5.4
301	P6.1
302	M0.2
303	

END OF ADDENDUM NO. 03

TABLE OF CONTENTS (AD 03)

DIVISION 0 – PROCUREMENT AND CONTRACTING REQUIREMENTS

001100	Invitation to Bid (*AD 01) (*AD 02)
002100	Instructions to Bidders (AIA Document A701)
003132	Geotechnical Report Request Form
004100	Bid Form (*AD 01)
004513	Contractor's Qualification Statement (AIA Document A305) A305 Exhibit A: General Information A305 Exhibit B: Financial and Performance Information A305 Exhibit C: Project Specific Information A305 Exhibit D: Contractor's Past Project Experience A305 Exhibit E: Contractor's Past Project Experience, Continued
005213	Standard Form of Agreement Between Owner and Contractor (AIA Document A101)
005213.01	Form of Agreement Exhibit A – Insurance & Bond Requirements
006113	Performance Bond (AIA Document A312)
006113	Payment Bond (AIA Document A312)
007200	General Conditions of the Contract for Construction (AIA Document A201)
007339	Minority Business Participation Requirements

Prebid Question Form: (Use on-line process. To access go to www.moseleyarchitects.com, at the top of the page select the "Bidding" link, find the appropriate project, and select the "Submit a Question" link).

SPECIFICATIONS

DIVISION 1 – GENERAL REQUIREMENTS

011000	Summary
012000	Price and Payment Procedures
012100	Allowances
012200	Unit Prices
012300	Alternates (*AD 01)
012500	Substitution Procedures Substitution Request Form – Prior to Receipt of Bids
013000	Administrative Requirements
013216	Construction Progress Schedule
014000	Quality Requirements
014200	Definitions and Reference Standards
014520	Testing, Adjusting, and Balancing for HVAC
015000	Temporary Facilities and Controls
016000	Product Requirements
017000	Execution and Closeout Requirements
017419	Construction Waste Management and Disposal
017800	Closeout Submittals
017900	Demonstration and Training
018119	Indoor Air Quality Requirements
018317	Exterior Building Enclosure Air Barrier Requirements
19113	General Commissioning Requirements

DIVISION 2 – EXISTING CONDITIONS (not used)

DIVISION 3 – CONCRETE

033000	Cast-In-Place Concrete
033100	Sealed and Polished Concrete Floor Finish
034500	Precast Architectural Concrete

DIVISION 4 – MASONRY

042000	Unit Masonry (*AD 01) (AD 03)
--------	-------------------------------

DIVISION 5 – METALS

051200	Structural Steel Framing
052100	Steel Joist Framing
053100	Steel Decking
054000	Cold Formed Steel Framing – Structural (CFSF-S)
054003	Continuous Insulation (CI) Framing System, Clipped
055000	Metal Fabrications
055100	Metal Stairs
055133	Metal Ladders
055213	Pipe and Tube Railings

DIVISION 6 – WOOD PLASTICS AND COMPOSITES

061000	Rough Carpentry
064100	Architectural Woodwork and Casework (AD 03)

DIVISION 7 – THERMAL AND MOISTURE PROTECTION

072100	Thermal Insulation
072736	Sprayed Foam (SPF) Air Barrier
074113	Metal Roof Panels
074213	Metal Wall Panels
074213.23	Metal Composite Material Wall Panels
075419	PVC Membrane Roofing (*AD 01) Roofing Installer's Warranty
076200	Sheet Metal Flashing and Trim
077100	Roof Specialties
077200	Roof Accessories
078100	Applied Fire Protection (AD 03)
078400	Firestopping
078426	Thermal Barriers for Plastics
079200	Joint Sealants
079513	Expansion Joint Cover Assemblies

DIVISION 8 – OPENINGS

081113	Steel Doors and Frames
081416	Flush Wood Doors
083100	Access Doors and Panels
083313	Coiling Counter Doors (AD 03)
083323	Overhead Coiling Doors
084313	Aluminum-Framed Storefronts

PENDER COUNTY LAW ENFORCEMENT CENTER
BURGAW, NORTH CAROLINA
Architect's Project No: 611888

084413	Glazed Aluminum Curtain Walls
085653	Security Windows (AD 03)
087100	Door Hardware
088000	Glazing
088813	Mirrors
088813	Fire-Rated Glazing
089100	Louvers

DIVISION 9 – FINISHES

092216	Cold Formed Steel Framing - Non-Structural (CFSF-NS)
092900	Gypsum Board (AD 03)
095100	Acoustical Ceilings
096513	Resilient Base and Accessories
096516	Resilient Sheet Flooring
096519	Resilient Tile Flooring
096536	<u>Static-Control Resilient Flooring (AD 03)</u>
096566	Resilient Athletic Flooring
096700	Fluid-Applied Flooring (AD 03)
096813	Tile Carpeting (AD 03)
096813.13	Static-Control Tile Carpeting (AD 03)
096900	Access Flooring
098414	Acoustic Stretched-Fabric Wall and Ceiling Systems
098430	Sound-Absorbing Wall and Ceiling Units
099100	Painting

DIVISION 10 – SPECIALTIES

101100	Visual Display Units
101400	Signage (*AD 01)
102113	Metal Compartments / Partitions
102113.19	Plastic Toilet Compartments
102123	Cubicle Curtains and Track
102600	Wall and Door Protection
102800	Toilet and Bath Accessories
104400	Fire Protection Specialties
105113	Metal Lockers
105113.13	Metal Evidence Lockers
105129	Phenolic Lockers
105613	Metal Storage Shelving
105626	Mobile Storage Shelving (*AD 02)
107300	Protective Covers
107500	Flagpoles

DIVISION 11 – EQUIPMENT

111900	Detention Equipment
111910	Custom / Security Hollow Metal Work
111950	Security Glass and Glazing
111960	Security Hardware
114000	Food Service Equipment

PENDER COUNTY LAW ENFORCEMENT CENTER
BURGAW, NORTH CAROLINA
Architect's Project No: 611888

DIVISION 12 – FURNISHINGS

122400	Window Shades (*AD 02)
123553.19	Wood Laboratory Casework

DIVISION 13 – SPECIAL CONSTRUCTION

133419	Metal Building Systems
134263.16	Manufactured Steel Detention Cells

DIVISION 14 – CONVEYING SYSTEMS (not used)

DIVISION 21 – FIRE SUPPRESSION

210500	Common Work Results for Fire Suppression
211000	Water-Based Fire Suppression Systems

DIVISION 22 – PLUMBING

220500	Common Work Results for Plumbing
220513	Motors for Plumbing Equipment
220516	Expansion Fittings and Loops for Plumbing Piping
220517	Sleeves and Sleeve Seals for Plumbing Piping
220519	Meters and Gages for Plumbing Piping
220523	General-Duty Valves for Plumbing Piping
220529	Hangers and Supports for Plumbing Piping and Equipment
220553	Identification for Plumbing Piping and Equipment
220700	Plumbing Insulation
220800	Commissioning of Plumbing Systems
221113	Facility Natural Gas Piping
221116	Domestic Water Piping
221119	Domestic Water Piping Specialties
221125	Circulating Pumps
221316	Sanitary Waste and Vent Piping
221319	Sanitary Waste Piping Specialties
221413	Facility Storm Drainage Piping
221423	Storm Drainage Piping Specialties
223400	Fuel-Fired, Domestic-Water Heaters
224000	Plumbing Fixtures
224600	Security Plumbing Fixtures

DIVISION 23 – MECHANICAL

230500	Common Work Results for HVAC
230513	Motors for HVAC Equipment
230514	Variable Speed Drives
230517	Sleeves and Sleeve Seals for HVAC Piping
230529	Hangers and Supports for HVAC Piping and Equipment
230548	Vibration and Seismic Control for HVAC
230553	Identification for HVAC Piping and Equipment
230700	HVAC Insulation
230800	Commissioning of Mechanical Systems
230900	Building Automation System
230993	Sequence of Operations for HVAC Controls

PENDER COUNTY LAW ENFORCEMENT CENTER
BURGAW, NORTH CAROLINA
Architect's Project No: 611888

232113	Hydronic Piping
232300	Refrigerant Piping for Split Systems
233113	Metal Ducts
233300	Air Duct Accessories
233423	HVAC Power Ventilators
233600	Air Terminal Units
233713	Diffusers, Registers, and Grilles
234100	Particulate Air Filtration
237413	Packaged Outdoor Central Station Air Handling Units
237433	Direct-Fired Makeup Air Units
238123	Computer Room Air Conditioners
238124	Ductless Mini-Split Air Conditioning Units
238239	Unit Heaters

DIVISION 25 – INTEGRATED AUTOMATION

250800	Commissioning of Integrated Automation Systems
--------	--

DIVISION 26 – ELECTRICAL

260500	Common Work Results for Electrical
260519	Low-Voltage Electrical Power Conductors and Cables
260526	Grounding and Bonding for Electrical Systems
260529	Hangers and Supports for Electrical Systems
260533	Raceways and Boxes for Electrical Systems (*AD 02)
260543	Underground Ducts and Raceways for Electrical Systems
260548	Seismic Controls for Electrical Systems
260553	Identification for Electrical Systems
260572	Overcurrent Protective Device Short-Circuit Study
260573	Overcurrent Protective Device Coordination Study
260574	Overcurrent Protective Device Arc-Flash Study
260800	Commissioning of Electrical Systems
260923	Lighting Control Devices
260943	Relay-Based Lighting Controls
262200	Low-Voltage Transformers
262413	Switchboards
262416	Panelboards
262550	Generator Docking Stations
262713	Electricity Metering
262714	Utility Service Entrance
262726	Wiring Devices
262813	Fuses
262816	Enclosed Switches and Circuit Breakers
262913	Enclosed Controllers
263213	Engine Generators
263600	Transfer Switches
264113	Lightning Protection for Structures
264313	Surge Protection for Low-Voltage Electrical Power Circuits
265119	LED Interior Lighting
265613	Lighting Poles and Standards
265619	LED Exterior Lighting

DIVISION 27 – COMMUNICATIONS

270500	Common Work Results for Communications
270526	Grounding and Bonding for Communications Systems
270528	Pathways for Communications Systems (*AD 02)
270536	Cable Trays for Telecommunications Systems
271100	Communications Equipment Room Fittings
271500	Communications Backbone Cabling
271500	Communications Horizontal Cabling (*AD 02)
276410	RF BDA-Based Signal Booster System

DIVISION 28 – ELECTRONIC SAFETY AND SECURITY

280500	Common Work Results for Electronic Safety and Security
283111	Digital, Addressable Fire-Alarm System
285000	Security Control System
285010	PLC, Network, and UPS Systems
285020	Video Graphical User Interface
285030	Cabinets and Enclosures
280533	Raceway and Boxes for Division 28 Systems (*AD 02)
285100	Audio Communication Systems
285200	Video Surveillance
285220	Interview Room Recording System
285260	Video Management System
285300	Access Control System
285400	Duress – Misc. Systems
285500	Auxiliary Control Systems
285900	Security Management Server

DIVISION 32 – EXTERIOR IMPROVEMENTS

323113.53	High-Security Chain-Link Fences and Gates
-----------	---

DIVISION 33 – UTILITIES

338116	Radio Antenna Tower
--------	---------------------

CIVIL/SITWORK SPECIFICATIONS (TOWN OF BURGAW STANDARD SPECIFICATIONS)

00410	Proofrolling
00415	Soil Type Base Course
00420	Aggregate Base Course
00425	Excavation and Backfill
00450	Plant Mix Bituminous Concrete Surface Course and Bituminous Concrete Base Course
00490	Precast Drainage Structures
02713	Water Mains
02722	Sanitary Sewers
02723	Force Mains

END OF TABLE OF CONTENTS

SECTION 042000
UNIT MASONRY (*AD-01) (*AD-03)

PART 1 GENERAL

1.01 REFERENCE STANDARDS

- A. ACI SP-66 - ACI Detailing Manual.
- B. ASTM A153/A153M - Standard Specification for Zinc Coating (Hot-Dip) on Iron and Steel Hardware.
- C. ASTM A240/A240M - Standard Specification for Chromium and Chromium-Nickel Stainless Steel Plate, Sheet, and Strip for Pressure Vessels and for General Applications.
- D. ASTM A615/A615M - Standard Specification for Deformed and Plain Carbon-Steel Bars for Concrete Reinforcement.
- E. ASTM A641/A641M - Standard Specification for Zinc-Coated (Galvanized) Carbon Steel Wire.
- F. ASTM A951/A951M - Standard Specification for Steel Wire for Masonry Joint Reinforcement.
- G. ASTM A1064/A1064M - Standard Specification for Carbon-Steel Wire and Welded Wire Reinforcement, Plain and Deformed, for Concrete.
- H. ASTM B117 - Standard Practice for Operating Salt Spray (Fog) Apparatus.
- I. ASTM C33/C33M - Standard Specification for Concrete Aggregates.
- J. ASTM C55 - Standard Specification for Concrete Building Brick.
- K. ASTM C62 - Standard Specification for Building Brick (Solid Masonry Units Made From Clay or Shale).
- L. ASTM C67/C67M - Standard Test Methods for Sampling and Testing Brick and Structural Clay Tile.
- M. ASTM C90 - Standard Specification for Loadbearing Concrete Masonry Units.
- N. ASTM C91/C91M - Standard Specification for Masonry Cement.
- O. ASTM C140/C140M - Standard Test Methods for Sampling and Testing Concrete Masonry Units and Related Units.
- P. ASTM C144 - Standard Specification for Aggregate for Masonry Mortar.
- Q. ASTM C151 - Standard Test Method for Autoclave Expansion of Hydraulic Cement.
- R. ASTM C216 - Standard Specification for Facing Brick (Solid Masonry Units Made from Clay or Shale).
- S. ASTM C270 - Standard Specification for Mortar for Unit Masonry.
- T. ASTM C331/C331M - Standard Specification for Lightweight Aggregates for Concrete Masonry Units.
- U. ASTM C404 - Standard Specification for Aggregates for Masonry Grout.
- V. ASTM C476 - Standard Specification for Grout for Masonry.
- W. ASTM C494/C494M - Standard Specification for Chemical Admixtures for Concrete.
- X. ASTM C618 - Standard Specification for Coal Fly Ash and Raw or Calcined Natural Pozzolan for Use in Concrete.
- Y. ASTM C641 - Standard Test Method for Iron Staining Materials in Lightweight Concrete Aggregates.

- Z. ASTM C780 - Standard Test Method for Preconstruction and Construction Evaluation of Mortars for Plain and Reinforced Unit Masonry.
- AA. ASTM C887 - Standard Specification for Packaged, Dry, Combined Materials for Surface Bonding Mortar.
- BB. ASTM C1019 - Standard Test Method for Sampling and Testing Grout for Masonry.
- CC. ASTM C1072 - Standard Test Methods for Measurement of Masonry Flexural Bond Strength.
- DD. ASTM C1314 - Standard Test Method for Compressive Strength of Masonry Prisms.
- EE. ASTM D1227/D1227M - Standard Specification for Emulsified Asphalt Used as a Protective Coating for Roofing.
- FF. ASTM E119 - Standard Test Methods for Fire Tests of Building Construction and Materials.
- GG. ASTM E154/E154M - Standard Test Methods for Water Vapor Retarders Used in Contact with Earth Under Concrete Slabs, on Walls, or as Ground Cover.
- HH. ASTM E514/E514M - Standard Test Method for Water Penetration and Leakage Through Masonry.
- II. BIA Technical Notes No. 7 - Water Penetration Resistance – Design and Detailing.
- JJ. BIA Technical Notes No. 13 - Ceramic Glazed Brick Exterior Walls.
- KK. BIA Technical Notes No. 20 - Cleaning Brickwork.
- LL. BIA Technical Notes No. 28B - Brick Veneer/Steel Stud Walls.
- MM. BIA Technical Notes No. 46 - Maintenance of Brick Masonry.
- NN. NCMA TEK 08-04A - Cleaning Concrete Masonry.
- OO. NCMA TEK 12-01B - Anchors and Ties for Masonry.
- PP. NCMA TEK 12-02B - Joint Reinforcement for Concrete Masonry.
- QQ. TMS 402/602 - Building Code Requirements and Specification for Masonry Structures.

1.02 ADMINISTRATIVE REQUIREMENTS

- A. Preinstallation Meeting: Convene a preinstallation meeting at the Project site one week before starting work of this section; require attendance by all relevant installers.

1.03 SUBMITTALS

- A. Product Data: Provide data for masonry units, fabricated wire reinforcement, mortar, and masonry accessories.
- B. Shop Drawings: Indicate pertinent dimensions, materials, anchorage, size and type of fasteners, and accessories, for each type of masonry.
 - 1. Provide elevations indicating steel reinforcing bar locations; provide details of reinforcing including bends and cross-sections, in accordance with ACI SP-66.
 - 2. Indicate control and expansion joint locations.
 - 3. Provide flashing details indicating corners, end dams, and other special conditions.
- C. Samples: Face brick and mortar selections will be verified in mock-up panel. Provide samples of exposed accessories and trim requiring color selection.
- D. Material Certificates and Test Reports: Provide manufacturer's certificates and test reports for the following:
 - 1. Masonry Units:
 - a. Brick: Size data including fabrication tolerances.

- b. Brick: Efflorescence test, per ASTM C67/C67M.
 - c. Masonry Units: Compressive strength test data.
 - d. Concrete Masonry: Data indicating aggregates comply with ASTM C33/C33M (normal weight), ASTM C331/C331M (lightweight), and ASTM C618 (fly ash).
- 2. Mortar and Grout Mixes: Provide description and proportion of materials for each type of mortar and grout.
 - 3. Provide material certificates for each type of metal accessory, including reinforcing bars, joint reinforcement, veneer ties and anchors, and other indicated accessories, indicating compliance with requirements.
- E. Installer's Qualification Statement.

1.04 QUALITY ASSURANCE

- A. Comply with provisions of ACI 530.1/ASCE 6/TMS 402/602, except where exceeded by requirements of Contract Documents.
- B. Fire Rated Assemblies: Provide products that comply with fire-resistance ratings indicated as determined by testing according to ASTM E119, by equivalent testing thickness, or by means acceptable to authorities having jurisdiction.
- C. **Masonry Subcontractor Qualifications: The work of this section shall be bid and performed by a firm certified as a "North Carolina Masonry Contractors Association Certified Masonry Contractor" as described in the most current version of the NCMCA's "Guide to Masonry Contractor Certification." (North Carolina Masonry Contractors Association, PO Box 3463, Hickory, NC 28603-3463, 828-324-1564, information@ncmca.com). (*AD-01)**
 - 1. **The masonry subcontractor shall at all times when work is in progress, provide an individual from its own staff designated by the North Carolina Masonry Contractors Association Masonry Contractor Certification Program as a "CMP-Certified Masonry Professional" or "CME-Certified Masonry Executive" (as described in the most current version of the NCMCA's "Guide to Masonry Contractor Certification") on-site to supervise work in progress.**
- D. Source Limitations for Masonry: Provide each type of masonry unit from a single manufacturer's plant, sourced through a single supplier. Each type of masonry unit shall maintain consistency of color and texture for all product required on the entire project. The approved mockup/sample panel shall be used to determine acceptable color and texture range.
 - 1. Source Limitations for Decorative Concrete Masonry: Provide decorative concrete veneers from a manufacturer with a quality control agreement with water repellent manufacturer, certifying that units have been manufactured with integral water repellent to conform to performance requirements indicated. Provide current certificate from water repellent manufacturer confirming conformance.
- E. Source Limitations for Mortar: Provide each mortar mix from a single manufacturer, sourced through a single supplier. Each required mortar mix shall maintain consistency of each component, including cementitious materials and aggregate, to provide consistent color and texture for all product required on the entire project. The approved mockup/sample panel shall be used to determine acceptable color and texture range.
- F. Aggregate for Concrete Masonry Units: If bottom ash is used as aggregate in the CMU, the Source for the bottom ash shall be a power station that has a minimum of ten (10) years continuous experience as a supplier of quality material as verified by independent certified laboratory testing and no defects in the marketplace.

- G. Pre-Construction Testing: Owner shall engage an independent testing agency to perform field quality control tests, in accordance with Section 014000 - Quality Requirements.
1. Clay Masonry Unit Tests: Testing agency shall test each variety of clay masonry in accordance with ASTM C67/C67M compressive strength requirements.
 2. Concrete Masonry Unit Tests: Testing agency shall test each variety of concrete unit masonry in accordance with ASTM C140/C140M compressive strength requirements.

1.05 MOCK-UPS

- A. See Section 014000 - Quality Requirements for additional requirements.
- B. Integrated Exterior Mockups: Attend preinstallation conference and provide masonry work for integrated exterior mockup as indicated on Drawings and as specified in Division 1 Section "Quality Requirements."

1.06 FIELD CONDITIONS

- A. Wall Cavity Protection: Provide temporary waterproof sheet coverings over masonry walls at top of walls, sills, parapets, and other horizontal projections. Install coverings at end of each workday, when rain or precipitation is expected, and after masonry work is completed.
1. Extend coverings down vertically at least 24 inches on each side of masonry wall. At multi-wythe walls where one wythe is more than 24 inches taller than other wythe(s), extend covering as required to fully cover all wythes and cavities.
 - a. At roof parapets, extend covering on rear side of parapet full height down to roof deck/membrane, until vertical protection/roof membrane is installed.
 2. Secure all coverings in place with tape or adhesive that does not leave residue, or other securement method that does not penetrate or damage permanent construction.
 3. Provide protective coverings at sills and horizontal projections that can also serve as protection from mortar droppings.
 4. Provide protective coverings over tops of foundation walls containing insulation to protect from exposure to sun and from construction traffic damage.
 5. Do not remove or allow removal of temporary covers until permanent top of wall protection elements (coping, sill, roof surface, waterproof membrane, etc) are underway.
- B. Cold- and Hot-Weather Requirements: Comply with requirements of TMS 402/602 or applicable building code, whichever is more stringent.

1.07 DELIVERY, STORAGE, AND HANDLING

- A. Deliver, handle, and store masonry units by means that will prevent mechanical damage and contamination by other materials.

PART 2 PRODUCTS

2.01 CONCRETE MASONRY UNITS

- A. Concrete Block: Comply with referenced standards and as follows:
1. Size: Standard units with nominal face dimensions of 16 by 8 inches and nominal depths as indicated on drawings for specific locations.
 2. Special Shapes: Provide nonstandard blocks configured for corners, lintels, headers, other detailed conditions, and as indicated below.
 - a. Provide bullnose units for outside corners.
 - b. Provide solid block with bullnosed top edges at free-standing CMU walls and where top of block is exposed at window sills and similar applications.

3. Concrete Masonry Units: ASTM C90, lightweight.
 - a. Exposed Faces: Manufacturer's standard color and texture.
 - b. Aggregates:
 - 1) Lightweight Aggregates: Lightweight aggregate shall strictly comply with ASTM C331/C331M, ASTM C151, and ASTM C641. Drying shrinkage of aggregate shall not exceed 0.10% at 100 days.
 - 2) Waste concrete, scoria, and aglite shall not be permitted.
 4. Decorative Concrete Block: ASTM C90, normal weight.
 - a. **Pattern: Manufacturer's standard split-face ground-face pattern. (*AD-03)**
 - b. Size: Match standard nominal dimensions per "Concrete Block" paragraph above.
 - c. Color: To be selected by Architect from manufacturer's full range.
 - d. Provide integral water repellent and companion mortar additive at all exterior decorative CMU.
 - e. Topcoat: Where recommended by manufacturer of decorative units, provide clear acrylic top-coat, minimum 20 percent solids content.
 5. Units with Integral Water Repellent: Concrete block units as specified in this section with polymeric liquid admixture added to concrete masonry units at the time of manufacture.
 - a. Performance of Units with Integral Water Repellent:
 - 1) Water Permeance: When tested per ASTM E514/E514M and for a minimum of 72 hours.
 - (a) No water visible on back of wall above flashing at the end of 24 hours.
 - (b) No flow of water from flashing equal to or greater than 0.032 gallons per hour at the end of 24 hours.
 - (c) No more than 25 percent of wall area above flashing visibly damp at end of test.
 - 2) Flexural Bond Strength: ASTM C1072; minimum 10 percent increase.
 - 3) Compressive Strength: ASTM C1314; maximum 5 percent decrease.
 - b. Use only in combination with mortar that also has integral water repellent admixture.
 - c. Use water repellent admixtures for masonry units and mortar by a single manufacturer.
 - d. Available Products:
 - 1) ACM Chemistries; RainBloc.
 - 2) BASF Aktiengesellschaft; Rheopel Plus.
 - 3) Grace Construction Products (W.R. Grace & Co.); Dry-Block.
- B. Concrete Brick:
1. Actual Size: 3-5/8 inches wide by 2-1/4 inches high by 7-5/8 inches long.
 2. Concrete Building Brick: ASTM C55; lightweight, solid, for interior or concealed use.

2.02 BRICK UNITS

- A. **Unit Cost Allowance: Face brick shall be furnished via unit cost allowance. Unit cost shall cover purchase of brick and transport to the project site. (*AD-01)**
1. **Face Brick Unit Cost (Utility – Field Brick): \$1,100 per thousand.**
 2. **Face Brick Unit Cost (Economy – Soldier Courses): \$800 per thousand.**
 3. **The unit cost shall not cover installation, overhead, or profit.**
 4. **Bidders and material suppliers are responsible for determining cost to produce special shape units, such as “lipped” brick units.**
-

5. **The Contract Sum will be adjusted to reflect the actual cost of selected brick in accordance with the General Conditions. The Contractor shall submit receipts and initiate the Change Order process.**
6. **The Contractor is reminded that unit cost includes all required taxes, less applicable trade discounts, in accordance with the General Conditions.**
- B. Facing Brick: ASTM C216, Type FBS or FBX, Grade SW.
 1. **Actual Size: 3-5/8 inches wide by 3-5/8 inches high by 11-5/8 inches long (utility) – provide as field brick size throughout, except for soldier courses as indicated below. (*AD-01)**
 2. **Actual Size: 3-5/8 inches wide by 3-5/8 inches high by 7-5/8 inches long (economy) – provide at soldier course locations only. (*AD-01)**
 3. Special Shapes: Molded units (plant-fabricated) as required by conditions indicated, unless standard units can be sawn to produce equivalent effect. Cut or sawn edges shall not be exposed in the finished work.
 4. Efflorescence: Provide brick that has been tested per ASTM C67/C67M and received a rating of "not effloresced."
- C. Building (Common) Brick: ASTM C62, Grade SW, except MW may be used in locations indicated acceptable in reference standard; solid units.
 1. Actual size: Match face brick.
 2. Locations: May be used in concealed locations in lieu of face brick.

2.03 MORTAR AND GROUT MATERIALS

- A. Masonry Cement: ASTM C91/C91M.
 1. Colored Mortar: Premixed cement as required to match Architect's color sample.
 2. Available Products:
 - a. Argos USA; Magnolia Masonry Cement.
 - b. Holcim (US) Inc.; Rainbow Mortamix Custom Color Masonry Cement.
 - c. Lehigh Hanson; flamingo Colored Cement.
 - d. Roanoke Cement; a division of Titan America; Colored Masonry Cement.
 - e. York Building Products, a Stewart Company; Workrite Colored Masonry Cement.
- B. Surface Bonding Mortar (Parge Coat): ASTM C887.
- C. Mortar Aggregate: ASTM C144.
- D. Grout Aggregate: ASTM C404.
- E. Water: Clean and potable.
- F. Accelerating Admixture: ASTM C494/C494M, Type C; nonchloride, noncorrosive type for use in cold weather; approved by manufacturer for use in masonry mortar.
- G. Integral Water Repellent Admixture for Mortar: Polymeric liquid admixture added to mortar at the time of manufacture.
 1. Use only in combination with masonry units manufactured with integral water repellent admixture.
 2. Use only water repellent admixture for mortar from the same manufacturer as water repellent admixture in masonry units.
 3. Meet or exceed performance specified for water repellent admixture used in masonry units.

2.04 DAMPPROOFING

- A. General: Dampproofing may be provided as a Contractor option to parge coat, applied to exterior face of below grade CMU back up wall (prior to insulation or grouting).
- B. Bituminous Dampproofing: Cold-applied water-based emulsion; asphalt with mineral colloid or chemical emulsifying agent; with or without fiber reinforcement; asbestos-free; suitable for application on vertical and horizontal surfaces.
 - 1. Emulsified Asphalt Coating (Brush or Spray Applied): ASTM D1227/D1227M, Type II, Class 1 - Mineral colloid emulsifying agents with non-asbestos fibers or Type III, Class 1 - Mineral colloid emulsifying agents without fibrous reinforcement.
 - 2. Accessory Materials: Provide asphaltic primer, glass fiber reinforcement, and compatible patching compounds as required and as recommended by manufacturer.
 - 3. Manufacturers:
 - a. Henry Company.
 - b. Karnak Corporation.
 - c. Mar-Flex Systems, Inc.
 - d. W. R. Meadows, Inc.
 - e. Substitutions: See Section 016000 - Product Requirements.

2.05 REINFORCEMENT AND ANCHORAGE

- A. Reinforcing Steel: ASTM A615/A615M, Grade 60 (60,000 psi), deformed billet bars; uncoated.
- B. Joint Reinforcement, Anchorage, and Ties, General: Comply with NCMA TEK 12-02B, NCMA TEK 12-01B, and requirements below.
 - 1. Use ladder type joint reinforcement, unless otherwise indicated. Truss type reinforcement may be used only when approved by Architect, at walls indicated not to have vertical reinforcing steel and not to be grouted.
 - 2. Provide prefabricated joint reinforcement sections for corners and for T-intersections.
 - 3. Provide joint reinforcement in minimum 10 foot lengths.
 - 4. At multi-wythe/cavity wall applications, size all anchors, ties, and reinforcement for depths of cavities indicated, including indicated insulation thickness as applicable. Ties shall maintain full adjustability at veneer wythe without affecting insulation.
 - 5. At cavities with air space wider than 4-1/2 inches, provide high strength ties engineered for cavity depths indicated.
- C. Single Wythe Joint Reinforcement: ASTM A951/A951M.
 - 1. Material: Mill-galvanized steel for interior walls, hot-dip galvanized steel for exterior walls.
 - 2. Size: 0.1483 inch side rods with 0.1483 inch cross rods; width as required to provide not less than 5/8 inch of mortar coverage on each exposure.
- D. Multiple Wythe Joint Reinforcement: ASTM A951/A951M. Provide at composite walls and subgrade walls where all wythes are of the same material.
 - 1. Material: Mill-galvanized steel for interior walls, hot-dip galvanized steel for exterior walls.
 - 2. Size: 0.1483 inch side rods with 0.1483 inch cross rods; width as required to provide not less than 5/8 inch of mortar coverage on each exposure.
 - a. Provide two side rods for each wythe that is nominal 6-inch depth or greater, and one side rod for each wythe that is nominal 4-inch depth.
- E. Adjustable Multiple Wythe Joint Reinforcement: ASTM A951/A951M. Provide at cavity walls/masonry veneer walls.
 - 1. Type: Ladder, with adjustable ties or tabs spaced at 16 in on center.

2. Material: Hot-dip galvanized steel.
 3. Size: 0.1483 inch side rods with 0.1483 inch cross rods and adjustable components of 0.1875 inch wire, width of components as required to extend at least halfway through veneer wythe, but provide not less than 5/8 inch of mortar coverage from each masonry face.
 4. Vertical adjustment: Not more than 1 1/4 inches.
- F. Strap Anchors: Bent steel shapes, 1-1/2 inch width, 0.105 inch thick, 24 inch length, with 2 inch long, 90 degree bend at each end to form a U or Z shape or with cross pins, hot dip galvanized to ASTM A153/A153M Class B.
- G. Flexible Anchors: 2-piece anchors that permit differential movement between masonry and building frame, sized to provide not less than 5/8 inch of mortar coverage from masonry face.
1. For Anchorage to Structural Steel Framing: Crimped wire anchors for welding to frame, 0.25 inch thick, with triangular/trapezoidal wire ties 0.1875 inch thick, hot dip galvanized to ASTM A 153/A 153M, Class B.
- H. Masonry Veneer Anchors: 2-piece anchors that permit differential movement between masonry veneer and structural backup, hot dip galvanized to ASTM A 153/A 153M, Class B. Provide at masonry veneer walls with metal framing backup. At cavity walls with CMU backup and masonry veneer, masonry veneer anchors may be used in conjunction with standard horizontal joint reinforcing, at Contractor's option, in lieu of adjustable multiple wythe joint reinforcement.
1. Anchor Plates: Not less than 0.075 inch thick, designed for fastening to structural backup through sheathing by two fasteners; provide design with legs that penetrate sheathing and insulation to provide positive anchorage.
 2. Wire Ties: Manufacturer's standard shape, 0.1875 inch thick.
 - a. Size wire ties to extend at least halfway through veneer wythe, but provide not less than 5/8 inch of mortar coverage from masonry face.
 3. Vertical Adjustment: Not less than 3-1/2 inches.
- I. Metal-to-Metal Fasteners (for Steel Studs): Self-drilling, self-tapping #10 hex screws; fabricated of either 304 stainless steel or of steel with corrosion resistant polymer coating tested to ASTM B117. Fasteners shall include integral neoprene or EPDM washer.
1. Manufacturers:
 - a. ELCO Construction Products; Dril-Flex with Stalgard Finish.
 - b. Heckmann Building Products; #668 TEK Self-Drilling Steel Stud Screw.
 - c. ITW Commercial Construction North America; Teks Maxiseal with Climaseal Finish, or Scots Long Life Teks (stainless steel).

2.06 FLASHINGS

- A. Combination Nonasphaltic Flashing Materials - Copper:
1. Copper/Polymer Film or Fabric Flashing: 5 oz/sq ft copper sheet laminated between two sheets of polymer film. Minimum Puncture Resistance of 780 psi, when measured in accordance with ASTM E154/E154M.
 - a. Available Products:
 - 1) Advanced Building Products, Inc.; Copper Sealtite 2000.
 - 2) Hohmann & Barnard, Inc; Copper-Fabric NA.
 - 3) STS Coatings, Inc.; Wall Guardian Copper TWF.
 - 4) York Manufacturing, Inc; Multi-Flash 500 Series.
- B. Combination Non-Asphaltic Flashing Materials - Stainless Steel:

1. Stainless Steel/Polymer Fabric Flashing: ASTM A240/A240M; 2 mil type 304 stainless steel sheet bonded on one side to one sheet of polymer fabric.
 - a. Manufacturers:
 - 1) Hohmann & Barnard, Inc; Mighty-Flash Stainless Flashing.
 - 2) Prosoco; R-Guard SS ThruWall.
 - 3) STS Coatings; Wall Guardian Stainless Steel TWF.
 - 4) York Manufacturing, Inc; Multi-Flash SS.
 - C. Factory-Fabricated Flashing Corners and End Dams: Stainless steel.
 - D. Termination Bars: One-inch wide, fabricated of 0.125-inch PVC, 0.090-inch extruded aluminum, or 0.075-inch stainless steel; compatible with membrane and adhesives.
 - E. Drip Edge: Stainless steel; angled drip with hemmed edge; compatible with membrane and adhesives.
 - F. Flashing Sealant/Adhesive/Liquid Seam Tape: Polyether-based, 100% solids, moisture-curing elastomeric products recommended by flashing manufacturer for bonding flashing sheets to each other and to substrates; and that are compatible with asphalt-free flashing materials and air barrier materials. Traditional mastic is not acceptable.
 1. Available Products:
 - a. Master Builders Solutions; MasterSeal NP150.
 - b. STS Coatings; GreatSeal LT-100 Liquid Tape.
 - c. York; UniverSeal US-100 Liquid Tape.

2.07 ACCESSORIES

- A. Preformed Control Joints: Rubber material. Provide with corner and tee accessories, fused joints.
 1. Provide nominal 2.5-inch "standard" and "tee" configurations to suit application unless indicated otherwise.
- B. Joint Filler: Closed cell polyvinyl chloride; oversized 50 percent to joint width; self expanding; in maximum lengths available.
- C. Cavity Mortar Control: Semi-rigid polyethylene or polyester mesh panels, sized to thickness of wall cavity, and designed to prevent mortar droppings from clogging weeps and cavity vents and allow proper cavity drainage.
 1. Mortar Diverter: Semi-rigid mesh designed for installation at flashing locations. Provide in depth matching cavity depth without gap at front or back of mesh. Fabricate approximately 10 inches high with minimum 6 inch high dovetail shape projections.
 - a. Available Products:
 - 1) Advanced Building Products, Inc; Mortar Break DT.
 - 2) Heckmann Building Products; WallDefender.
 - 3) Hohmann & Barnard, Inc.; Mortar Trap.
 - 4) Mortar Net Solutions; MortarNet.
 - 5) Wire-Bond; Cavity Net DT (3611D).
 - b. At cavities with depth greater than 2 inches, provide companion drainage product by one of the manufacturers above; nominal 1/2-inch thickness by 20 inches wide, to be field inserted into cavity in a "U" configuration. Basis-of-Design is "Mortar Catch 352" by Advanced Building Products, Inc.
- D. Bond Break: ASTM D226/D226M, Type I ("No.15") asphalt felt or polyethylene tape.

- E. Weeps/Cavity Vents:
1. Cellular Type: Extruded propylene with honeycomb design.
 - a. Color(s): Clear.
 - b. Available Products:
 - 1) Advanced Building Products, Inc.; Mortar Break weep mesh.
 - 2) Blok-Lok Limited; Cell-Vent.
 - 3) CavClear/Archovations, Inc.; CavClear Weep Vent.
 - 4) Heckmann Building Products Inc.; No. 85 Cell Vent.
 - 5) Hohmann & Barnard, Inc.; Quadro-Vent.
 - 6) Mortar Net Solutions; WeepVent.
 - 7) Wire-Bond; Cell Vent.
 2. Bed Joint Weep System: Corrugated plastic drainage system incorporating continuous drainage strip within cavity portion of wall with integral weephole extensions at 9-1/2 inches on center located above flashing in the bed joint of the veneer masonry. Provide at masonry units over 32 inches long, and as indicated.
 - a. Available Products:
 - 1) Heckmann Building Products; Core/Cavity Vent Weep System #367.
 - 2) Masonry Technology Incorporated (MTI); Cavity Weep CV 5010.
- F. Reinforcing Positioners: Provide wire positioners in bed joints to keep steel reinforcing bars centered in cells, fabricated of 0.1483-inch hot-dip galvanized steel wire.
1. Available Products:
 - a. Heckmann Building Products, Inc.; No. 376 Rebar Positioner.
 - b. Hohmann & Barnard, Inc.; #RB or #RB-Twin Rebar Positioner.
 - c. Wire-Bond; O-Ring or Double O-Ring Rebar Positioner.
- G. Cleaning Solution: Non-acidic, not harmful to masonry work or adjacent materials.

2.08 LINTELS

- A. Masonry Lintels: Fabricated of bond beam CMUs, with texture matching adjacent standard CMU. Provide reinforcing bars and grout in accordance with structural requirements. Provide temporary supports until cured.
- B. Precast Concrete Lintels: Comply with structural requirements for concrete strength and reinforcing. Precast U-lintels fabricated in accordance with performance standards of PCI MNL-116 with 3500 psi concrete for standard lintels and 6000 psi concrete for prestressed lintels as manufactured by Cast-Crete are acceptable in lieu of rectangular section lintels.
- C. Steel Lintels: Refer to Section 055000 - Metal Fabrications.

2.09 MORTAR AND GROUT MIXING

- A. Mortar for Unit Masonry: ASTM C270, using the Proportion Specification.
1. Masonry below grade and in contact with earth: Type S.
 2. Reinforced masonry: Type S.
 3. Mortar parge coats: Type S.
 4. Exterior, loadbearing and non-loadbearing, and interior, loadbearing and non-loadbearing: Type N, except as indicated above.
 - a. Interior, non-loadbearing masonry may use Type O at Contractor's option.

- B. Colored Mortar: Proportion selected pigments and other ingredients to match Architect's sample, without exceeding manufacturer's recommended pigment-to-cement ratio.
 - 1. Use colored mortar for all veneer masonry. Separate colors shall be required for each type and color of veneer.
- C. Grout: ASTM C476; consistency required to fill completely volumes indicated for grouting; fine grout for spaces with smallest horizontal dimension of 2 inches or less; coarse grout for spaces with smallest horizontal dimension greater than 2 inches.
- D. Admixtures: Add to mixture at manufacturer's recommended rate and in accordance with manufacturer's instructions; mix uniformly.
- E. Mixing: Use mechanical batch mixer and comply with referenced standards.

PART 3 EXECUTION

3.01 EXAMINATION

- A. Verify that field conditions are acceptable and are ready to receive masonry.
- B. Verify that related items provided under other sections are properly sized and located.
- C. Verify that built-in items are in proper location, and ready for roughing into masonry work.

3.02 PREPARATION

- A. Direct and coordinate placement of metal anchors supplied for installation under other sections.
- B. Provide temporary bracing during installation of masonry work. Maintain in place until building structure provides permanent bracing.

3.03 COLD AND HOT WEATHER REQUIREMENTS

- A. For installation in cold or hot weather, comply with requirements of TMS 402/602 or applicable building code, whichever is more stringent.

3.04 GENERAL INSTALLATION REQUIREMENTS

- A. Establish lines, levels, and coursing indicated. Protect from displacement.
- B. Maintain masonry courses to uniform dimension. Form vertical and horizontal joints of uniform thickness.
 - 1. CMU Coursing: One unit and one mortar joint equal 8 inches.
 - 2. Brick Coursing: Either two or three units with accompanying mortar joints shall equal 8 inches, based on basis-of-design brick size(s) indicated above.
- C. Provide running bond for all masonry units unless otherwise indicated.
- D. Tool all mortar joints slightly concave where they will be exposed, unless otherwise indicated.
 - 1. Provide flush joints where they will be concealed by surface-applied treatments or finishes other than paint; including but not limited to tile, wall coverings, fluid-applied or SPF air barriers, or membranes.

3.05 PLACING AND BONDING

- A. Remove broken, cracked, chipped, or otherwise damaged masonry units from pallets and set aside. Do not use unless they may be field cut to remove damaged section, for installation where special shape is required to fit construction.
- B. Create a consistent blend for each type of veneer masonry by mixing units from a minimum of three pallets.

- C. Provide asphalt felt or polyethylene tape bond-breaker between clay masonry and concrete or other masonry types. Rake back joints for sealant.
- D. Lay solid masonry units in full bed of mortar, with full head joints, uniformly jointed with other work.
- E. Lay hollow masonry units with face shell bedding on head and bed joints.
- F. Remove excess mortar and mortar smears as work progresses.
- G. Remove excess mortar with water repellent admixture promptly. Do not use acids, sandblasting or high pressure cleaning methods.
- H. Do not shift or tap masonry units after mortar has achieved initial set. Where adjustment must be made, remove mortar and replace.
- I. Perform job site cutting of masonry units with proper tools to provide straight, clean, unchipped edges. Prevent broken masonry unit corners or edges.
 - 1. Do not cut masonry unless it is required for certain shapes, such as rowlock sills, or unless it is unavoidable due to fitting around other construction, such as wall penetrations.
 - 2. Cut masonry edges shall not be visible in the final work. Where special shapes are required that would expose cut edges, they shall be plant-fabricated.

3.06 WEEPS/CAVITY VENTS

- A. Install weeps in veneer and cavity walls at 24 inches on center horizontally on top of through-wall flashing above shelf angles and lintels and at bottom of walls.

3.07 CAVITY MORTAR CONTROL

- A. Do not permit mortar to drop or accumulate into cavity air space or to plug weep/cavity vents.
- B. For cavity walls, build inner wythe ahead of outer wythe to accommodate accessories.
- C. Install cavity mortar diverter at base of cavity and at other flashing locations as recommended by manufacturer to prevent mortar droppings from blocking weep/cavity vents.

3.08 REINFORCEMENT AND ANCHORAGE - GENERAL, SINGLE WYTHE MASONRY, AND CAVITY WALL MASONRY

- A. Unless otherwise indicated on drawings or specified under specific wall type, install horizontal joint reinforcement 16 inches on center.
- B. Place masonry joint reinforcement in first and second horizontal joints above and below openings. Extend minimum 16 inches each side of opening.
- C. Place continuous joint reinforcement in first and second joint below top of walls.
- D. At parapets and below-grade/foundations, provide joint reinforcement at 8 inches o.c. vertically.
- E. Embed longitudinal wires of joint reinforcement in mortar joint with at least 5/8 inch mortar cover on each side.
- F. Lap joint reinforcement ends minimum 6 inches.
- G. Do not extend reinforcement across control, expansion, and other building movement joints.
- H. Reinforce corners and intersections with prefabricated T- or L-shaped reinforcing.
- I. Fasten anchors to structural framing and embed in masonry joints as masonry is laid. Unless otherwise indicated on drawings or closer spacing is indicated under specific wall type, space anchors at maximum of 36 inches horizontally and 24 inches vertically.

- J. Embed ties and anchors in mortar joint and extend at least halfway through masonry veneer unit; with at least 5/8 inch mortar cover to the outside face of the anchor.

3.09 REINFORCEMENT AND ANCHORAGE - MASONRY VENEER

- A. Masonry and/or Metal Framing Back-Up: Embed anchors to bond veneer at maximum 16 inches on center vertically and 24 inches on center horizontally. Place additional anchors at perimeter of openings and ends of panels, so maximum spacing of anchors is 8 inches on center.

3.10 REINFORCEMENT AND ANCHORAGES - COMPOSITE UNIT MASONRY

- A. Install continuous horizontal joint reinforcement at 16 inches o.c. vertically, except at below grade foundation walls install at 8 inches o.c. vertically.
- B. Where concrete foundations are indicated, tie below-grade masonry to concrete with rigid anchors spaced at maximum 8 inches o.c. vertically.
- C. Coordinate with parging/dampproofing and with installation of insulation, where indicated.

3.11 MASONRY FLASHINGS

- A. Whether or not specifically indicated, install masonry flashing to divert water to exterior at all locations where downward flow of water will be interrupted.
 - 1. Remove or cover protrusions or sharp edges that could puncture flashings.
 - 2. Seal lapped ends and penetrations of flashing before covering with mortar.
- B. Terminate flashing up 16 inches minimum on vertical surface of backing:
 - 1. Anchor vertical leg of flashing into backing with a termination bar and sealant.
- C. Extend metal flashings to within 1/2 inch of exterior face of masonry and adhere to top of stainless steel angled drip with hemmed edge.
 - 1. Notch and hem exterior corners of drip edges to eliminate sharp, exposed cut metal edges at locations below 6' - 0" above grade.
- D. Support flexible flashings across gaps and openings.
- E. Lap end joints of flashings at least 6 inches, minimum, and seal watertight with flashing sealant/adhesive.

3.12 LINTELS

- A. Comply with requirements on Structural Drawings for type of lintel at each opening, additional lintel sizing, reinforcement, and installation requirements.
- B. Install loose steel or precast lintels over openings, where indicated.
- C. Install reinforced unit masonry lintels over openings where steel or precast concrete lintels are not scheduled.
 - 1. Allow masonry lintels to attain specified strength before removing temporary supports.
- D. Maintain minimum 8 inch bearing on each side of opening, unless otherwise indicated.

3.13 GROUTED COMPONENTS

- A. Comply with requirements on Structural Drawings for locations of structural grouted components and accessories, including but not limited to, grouted bond beams, reinforced unit masonry walls, (including locations and sizing of vertical steel bar reinforcing), grouted solid CMU, and composite wall collar joints.
- B. Lap splices minimum 24 bar diameters.

- C. Support and secure reinforcing bars from displacement. Maintain position within 1/2 inch of dimensioned position.
- D. Place and consolidate grout fill without displacing reinforcing.

3.14 CONTROL AND EXPANSION JOINTS

- A. Do not continue horizontal joint reinforcement through control or expansion joints.
- B. Install preformed control joint device in continuous lengths. Seal butt and corner joints in accordance with manufacturer's instructions.
- C. Provide control and expansion joints at locations indicated on Drawings, and as follows:
 - 1. At changes in wall height.
 - 2. At changes in wall thickness
 - 3. At change in support (eg: transition from foundation support to floor slab support).
 - 4. Adjacent to corners of walls within a distance equal to no more than half the maximum control joint spacing.
 - 5. Wall intersections.
 - 6. Do not place control joints closer than 16 inches to edge of wall openings (doors, windows, louvers, ducts).
 - 7. Distance between joints shall not exceed a length to height ratio of 1.5:1.
 - 8. Distance between joints shall not exceed 25 feet where no openings occur between joints.
 - 9. Distance between joints shall not exceed 20 feet where openings occur between joints.

3.15 BUILT-IN WORK

- A. As work progresses, install built-in metal door frames, anchor bolts, and plates and other items to be built into the work and furnished under other sections.
- B. Install built-in items plumb, level, and true to line.
- C. Bed anchors of metal door frames in adjacent mortar joints. Fill frame voids solid with grout.
 - 1. Mix mortar (or grout) to a 4-inch maximum slump consistency and hand trowel into place in accordance with Steel Door Institute (SDI-100).
 - 2. Fill adjacent masonry cores with grout minimum 12 inches from framed openings.
- D. Do not build into masonry construction organic materials that are subject to deterioration.

3.16 TOLERANCES

- A. Install masonry within the site tolerances found in TMS 402/602.
- B. Maximum Variation from Unit to Adjacent Unit: 1/16 inch.
- C. Maximum Variation from Plane of Wall: 1/4 inch in 10 ft and 1/2 inch in 20 ft or more.
- D. Maximum Variation from Plumb: 1/4 inch per story non-cumulative; 1/2 inch in two stories or more.
- E. Maximum Variation from Level Coursing: 1/8 inch in 3 ft and 1/4 inch in 10 ft; 1/2 inch in 30 ft.
- F. Maximum Variation of Mortar Joint Thickness: Head joint, minus 1/4 inch, plus 3/8 inch.
- G. Maximum Variation from Cross Sectional Thickness of Walls: 1/4 inch.

3.17 CUTTING AND FITTING

- A. Cut and fit for chases, pipes, conduit, and other penetrations. Coordinate with other sections of work to provide correct size, shape, and location.

- B. Obtain approval prior to cutting or fitting masonry work not indicated or where appearance or strength of masonry work may be impaired.

3.18 PARGING

- A. Dampen masonry walls prior to parging.
- B. Parge cavity side of CMU below grade back-up wythe with a single coat of surface-bonding mortar to a total thickness of 1/4 inch.
 - 1. In lieu of parging, Contractor may at its option apply bituminous dampproofing, at a minimum rate of 1.25 gal per 100 sq. ft. Apply primer if required by manufacturer and comply with manufacturer's installation requirements.
- C. Steel trowel surface smooth and flat with a maximum surface variation of 1/8 inch per foot.
- D. Strike top edge of parging at 45 degrees.

3.19 FIELD QUALITY CONTROL

- A. Field Inspection: The Owner shall engage an independent inspection agency to perform field quality control inspections and prepare field reports.
 - 1. The Contractor shall permit full access to inspectors in order to perform inspections, including use of temporary facilities and equipment such as scaffolding or lifts.
 - 2. Do not enclose cavities or spaces to be grouted solid until inspections have approved grout and reinforcement for material properties, size, and installation locations.
- B. Field Testing: The Owner shall engage an independent testing agency to perform field quality control tests, as specified in Section 014000 - Quality Requirements. For each type of masonry unit, 5 randomly chosen units shall be sampled for each 5,000 square feet of wall.
 - 1. Clay Masonry Unit Tests: Testing agency shall test each variety of clay masonry in accordance with ASTM C67/C67M requirements.
 - 2. Concrete Masonry Unit Tests: Testing agency shall test each variety of concrete unit masonry, of each load-bearing size indicated, in accordance with ASTM C140/C140M requirements.
 - 3. Mortar Tests: Testing agency shall test each type of mortar in accordance with ASTM C780. Mortar shall be tested on each of the first 3 days. Alert testing agency if mortar mix is altered during construction to allow for retesting.
 - 4. Grout Test: Testing agency shall test each type of grout in accordance with ASTM C1019. Grout shall be tested on each of the first 3 days. Alert testing agency if grout mix is altered during construction to allow for retesting.

3.20 REPAIR AND CLEANING

- A. Remove masonry units that have become damaged or stained, or that do not display acceptable blend of color and texture matching mockup/sample panel. Remove as whole units, do not cut. Replace with new units with fresh mortar joints.
- B. Remove excess mortar and mortar droppings.
- C. Replace defective mortar and repoint. Enlarge holes or voids at defective mortar, and remove enough adjacent mortar to allow for repointing. Install fresh mortar joint and match to adjacent work.
- D. Where expansion/control joints and sealant joints are indicated, clean joints and leave them clear and ready for installation of joint or sealant materials.
- E. Clean concrete masonry in accordance with NCMA TEK 08-04A and clean clay masonry in accordance with BIA Technical Notes No. 20. Use hand cleaning/bucket-and-brush methods.

- F. To prevent freezing of cleaners and rinse water, do not clean when masonry surface temperature will drop below 40 degrees F.
- G. Test cleaning methods and materials on one half of mockup/sample panel; leave the other half uncleaned. Obtain approval of Architect before cleaning the finished work.
- H. Protect adjacent non-masonry surfaces from cleaning materials and processes with temporary sheeting or masking.
- I. Provide "in-progress" cleaning; clean masonry in each area as soon as possible after mortar has fully cured (approximately 7 to 28 days; coordinate with manufacturer's recommendations for each mortar type specified). Field test a small area to ensure mortar curing is complete prior to large-scale cleaning.
- J. Pre-wet masonry surfaces and clean with specified cleaning solution. Rinse surfaces immediately after cleaning; do not allow cleaning solution to dry or set into the masonry.
- K. Use non-metallic tools in cleaning operations.
- L. Final Cleaning: As part of Project Closeout (prior to Substantial Completion), provide Final Cleaning of masonry veneer. Remove construction dust with a very low pressure rinse. Perform a visual inspection and spot clean to remove efflorescence, staining, or organic growth, in accordance with recommendations of BIA and NCMA technical notes.

3.21 PROTECTION

- A. Provide temporary protective waterproof sheet coverings over tops of walls, parapets, sills, and other horizontal projections as the work progresses, in accordance with FIELD CONDITIONS article in Part 1 above.
- B. Without damaging completed work, provide protective boards at exposed external corners that are subject to damage by construction activities.
- C. Provide protective vertical boards and horizontal sheeting at grade level base of walls to prevent staining or splashing from rain, mud, or mortar droppings.

3.22 MASONRY WASTE

- A. Fill Material: Clean masonry waste may be used as fill material. Break up masonry waste into small pieces no greater than 4 inches any direction. Mix with Division 31 engineered fill material so that masonry waste is no more than 33% of the fill (1 part masonry waste, 2 parts engineered fill). Fill containing masonry waste shall be at least 18 inches below grade level.
 - 1. Excess waste shall be removed and disposed of or recycled in accordance with Division 1 waste disposal requirements.

END OF SECTION 042000

SECTION 064100
ARCHITECTURAL WOODWORK AND CASEWORK (*AD-03)

PART 1 GENERAL

1.01 DEFINITIONS

- A. Exposed: Portions of casework visible when drawers and cabinet doors are closed, including end panels, bottoms of cases more than 42 inches above finished floor, tops of cases less than 72 inches above finished floor and all members visible in open cases or behind glass doors.
- B. Semi-Exposed: Portions of casework and surfaces behind solid doors, tops of cases more than 72 inches above finished floor and bottoms of cabinets more than 30 inches but less than 42 inches above finished floor.
- C. Concealed: Sleepers, web frames, dust panels and other surfaces not generally visible after installation and cabinets less than 30 inches above finished floor.

1.02 REFERENCE STANDARDS

- A. ANSI A208.1 - American National Standard for Particleboard.
- B. ANSI A208.2 - Medium Density Fiberboard (MDF) for Interior Applications.
- C. ANSI A208.1 - American National Standard for Particleboard.
- D. ANSI A208.2 - Medium Density Fiberboard (MDF) for Interior Applications.
- E. ASTM E84 - Standard Test Method for Surface Burning Characteristics of Building Materials.
- F. AWI (QCP) - Quality Certification Program.
- G. AWI/AWMAC/WI (AWS) - Architectural Woodwork Standards, 2nd Edition.
- H. AWMAC/WI (NAAWS) - North American Architectural Woodwork Standards.
- I. BHMA A156.9 - Cabinet Hardware.
- J. CAL (CDPH SM) - Standard Method for the Testing and Evaluation of Volatile Organic Chemical Emissions from Indoor Sources Using Environmental Chambers Version 1.2.
- K. CARB (SCM) - Suggested Control Measure for Architectural Coatings; California Air Resources Board.
- L. EPA (TSCA); Title VI - Toxic Substances Control Act, Title VI: Formaldehyde Standards for Composite Wood Products.
- M. ISFA 2-01 - Classification and Standards for Solid Surfacing Material.
- N. NEMA LD 3 - High-Pressure Decorative Laminates.
- O. SCAQMD 1113 - Architectural Coatings.
- P. SCAQMD 1168 - Adhesive and Sealant Applications.

1.03 ADMINISTRATIVE REQUIREMENTS

- A. Preinstallation Meeting: Convene a preinstallation meeting not less than one week before starting work of this section; require attendance by all affected installers.

1.04 SUBMITTALS

- A. Product Data: Component dimensions, configurations, construction details, joint details, attachments.

1. Include product data for each type of hardware and accessory.
- B. Shop Drawings: Indicate materials, component profiles, fastening methods, jointing details, and accessories.
 1. Include field measurements, and indicate where field measurements differ from documents.
- C. Selection Samples: Submit manufacturer's color charts indicating full range of available colors, for each product requiring color selection.
- D. Fabricator Qualifications: Include evidence of accreditation with quality control program.
- E. Certificate: Submit labels and certificates required by quality assurance and quality control programs.

1.05 QUALITY ASSURANCE

- A. Fabricator Qualifications: Company specializing in fabricating the products specified in this section with experience on Projects of similar size and scope.
 1. Accredited participant in the specified certification program prior to the commencement of fabrication and throughout the duration of the project.
 2. Single Source Responsibility: Provide and install this work from single fabricator.
 - a. It is acceptable to subcontract portions of the work to a separate specialty subcontractor (for example, pre-fabricated plastic-laminate-faced casework); however, each fabricator shall be independently accredited; submit accreditation for each fabricator. The primary woodwork contractor shall be responsible for ensuring the work of all Division 06 sections is well coordinated and properly fabricated and installed.
- B. ~~Quality Certification:~~
 1. ~~Comply with AWI (QCP) woodwork association quality certification service/program in accordance with requirements for work specified in this section. (*AD-03)~~

1.06 DELIVERY, STORAGE, AND HANDLING

- A. Comply with Section 2 of the Architectural Woodwork Standards: "Care & Storage."
- B. Deliver woodwork after finishes are complete, including painting, and HVAC is operating at occupancy conditions in all spaces where woodwork will be installed.
- C. Store in an environmentally controlled location. Protect units from moisture damage.

1.07 FIELD CONDITIONS

- A. During and after installation of woodwork, maintain temperature and humidity conditions in building spaces at same levels planned for occupancy.

PART 2 PRODUCTS

2.01 PERFORMANCE REQUIREMENTS

- A. Quality Standard: Custom Grade, in accordance with AWI/AWMAC/WI (AWS), unless noted otherwise.
- B. Surface Burning Characteristics: Flame spread index of 25, maximum; smoke developed index of 450, maximum; when tested in accordance with ASTM E84, unless otherwise indicated for specific products.
- C. All countertop surfaces shall be NSF approved for food contact.

- D. Accessibility Requirements: Fabricate and install woodwork and casework in compliance with ICC/ANSI A117.1 and with ADA Standards for Accessible Design.
- E. Low-Emitting Materials:
 - 1. Composite Wood: Any composite wood materials installed inside the weatherproofing system shall meet either EPA (TSCA); Title VI for ultra-low-emitting formaldehyde or no added formaldehyde (ULEF / NAUF).
 - 2. Paints and Coatings: Paints and coatings field-applied inside the weatherproofing system shall be tested and determined compliant in accordance with CAL (CDPH SM) AND shall meet applicable VOC limits of CARB (SCM) or SCAQMD 1113.
 - 3. Adhesives and Sealants: Adhesives and sealants field-applied inside the weatherproofing system shall be tested and determined compliant in accordance with CAL (CDPH SM) AND shall meet the chemical content requirements of SCAQMD 1168.

2.02 CABINETS

- A. Quality Standard: Custom Grade, in accordance with AWI/AWMAC/WI (AWS), unless noted otherwise.
- B. Plastic-Laminate-Clad Cabinets: Custom grade, except as modified below. Solid wood and wood panel construction; each unit self-contained and not dependent on adjacent units or building structure for rigidity; in sizes necessary to avoid field cutting except for scribes and filler panels. Include adjustable levelers for base cabinets.
 - 1. Style: Reveal overlay. Ease doors and drawer fronts slightly at edges.
 - 2. Cabinet Nominal Dimensions: Unless otherwise indicated, provide cabinets of widths and heights indicated on drawings, and with following front-to-back dimensions:
 - a. Base Cabinets: 24 inches.
 - b. Tall Cabinets: 24 inches.
 - c. Wall Cabinets: 12-1/2 inches. (Minimum clear interior depth shall be 11 inches)
 - 3. Drawer Construction: Provide AWI premium grade for drawer box construction.
 - 4. Base Construction: Provide adjustable levelers for all base cabinets to facilitate load transfer to the floor, isolate cabinet ends from the floor, and permit leveling.
 - a. Provide one of the following two types of base construction:
 - 1) Separate Sub-Base: Cabinet sub-base shall be separate and continuous (no cabinet body sides-to-floor), exterior grade plywood with concealed fastening to cabinet bottom. Sub-base shall be ladder-type construction of individual front, back, and intermediates, to form a secure and level platform to which cabinets attach. Recess sub-base at exposed cabinet end panels 1/4 inch from face of finished end, for flush installation of finished base material by other trades.
 - 2) Integral Base: Provide end panels, cabinet bottoms, and horizontal toe kick members integrally joined together for structural strength. Adjustable levelers shall be provided at each corner for each cabinet.
 - b. Toe Kick: Toe kick shall be nominal 4 inch height. Reduce as necessary via field modification due to construction tolerances and concrete slab levelness to maintain maximum height dimensions indicated.
 - 5. Plastic Laminate: Apply plastic laminate finish in full uninterrupted sheets consistent with manufactured sizes. Fit corners and joints hairline.
 - a. Finish: Matte or suede, gloss rating of 5 to 20.
 - b. Surface Color and Pattern: To be selected by Architect from manufacturer's full range.

- c. Exposed Interior Surfaces: Thermally fused laminate (melamine) is acceptable only at drawer boxes. Provide HPDL, type VGS or CLS, at semi-exposed interiors of cabinets (cabinets with doors). Provide type VGS for exposed interior horizontal shelving surfaces and interiors of open cabinets (no doors).
 - d. Apply undecorated laminate backing sheet to concealed reverse side of plastic laminate finished surfaces.
 - e. Wood Grain Pattern: If wood grain is indicated or selected for plastic laminate color/pattern, provide sequence matched finish across each elevation. Grain shall run vertically across all doors, drawers, fronts, and false fronts; mismatched grain direction is not allowed.
- C. ADA Sink Cabinets: Fabricate a panel of 3/4-inch moisture resistant core material and veneer/cladding material to match adjacent cabinets. Panel shall be removable for service access to undercounter plumbing. Provide with Z-clip attachment system for concealed fastening and with a steel cable retainer, minimum 4 feet long, so that panel can be set aside for service access. Fasten Z-clips and steel cable retainer to panel and to substrate with tamper-resistant fasteners.
- 1. Provide an undercounter vertical "apron" piece at front of ADA sink locations as indicated, flush to fronts of adjacent cabinets and finished to match.
- D. ADA Sink Cabinets with Doors: Provide casework manufacturer's standard hinged front door panels, with matching veneer/cladding material and toe kick built into door panels, to match appearance of adjacent base cabinets. Front door panels swing open to 160 degrees minimum to allow for ADA-compliant undercounter knee space and for plumbing access to sink.

2.03 WOOD-BASED COMPONENTS

- A. Low-Emitting Materials: Provide composite wood products that meet the requirements of EPA (TSCA); Title VI for formaldehyde emissions.
- B. Core Material for Cabinets: ANSI A208.1, Grade M-2 particleboard.
 - 1. At Contractor's option, cabinet backs may be fabricated of ANSI A208.2, Grade MD fiberboard.
- C. Core Material for Countertops: Manufacturer's standard ANSI A208.1, Grade M-2 particleboard, or ANSI A208.2, Grade MD fiberboard.
 - 1. At countertops containing sinks, provide core material meeting ANSI MR10 for moisture resistance. Available Products:
 - a. Arauco North America; Duraflake VESTA Moisture Resistant ULEF.
 - b. Collins Pine; FreeForm.
 - c. Georgia-Pacific; Ultrastock MR MDF.
 - d. Roseburg Forest Products; SkyBlend MR-10.

2.04 PANEL CORE MATERIALS

- A. Particleboard: Composite panel composed of cellulosic particles, additives, and bonding system; comply with ANSI A208.1.
- B. Medium Density Fiberboard (MDF): Composite panel composed of cellulosic fibers, additives, and bonding system; cured under heat and pressure; comply with ANSI A208.2.

2.05 THERMALLY FUSED LAMINATE PANELS

- A. Thermally Fused Laminate (TFL): Melamine- or polyester-resin-saturated decorative papers; for fusion to composite wood substrates under heat and pressure.
 - 1. Test in accordance with NEMA LD 3 Section 3.

2. Panel Core Substrate: Particleboard.
3. Color: White.

2.06 LAMINATE MATERIALS

- A. Manufacturers:
 1. Formica Corporation; High Pressure Laminate.
 2. Panolam Industries International, Inc; Nevamar Standard HPL.
 3. Panolam Industries International, Inc; Pionite Standard HPL.
 4. Wilsonart LLC; High Pressure Laminate (HPL).
- B. High Pressure Decorative Laminate (HPDL): NEMA LD 3, types as recommended for specific applications.
- C. Color and Pattern: To be selected by Architect from Manufacturer's full range (standard and premium colors) in standard textured finish (textured gloss, fine textured, or suede finish). High gloss, heavy textured, metallic, or other special surface products (abrasion-resistant, chemical-resistant) will not be required for use in this project.
- D. Provide specific types as follows:
 1. Horizontal Countertop Surfaces: HGS, 0.048 inch (1.2 mm) nominal thickness.
 2. Vertical Surfaces and Non-Countertop Horizontal Surfaces: VGS, 0.028 inch (0.7 mm) nominal thickness.
 3. Cabinet Liner: CLS, 0.020 inch (0.5 mm) nominal thickness.
 4. Laminate Backer: BKL, 0.020 inch nominal thickness, undecorated; for application to concealed backside of panels faced with high pressure decorative laminate.

2.07 SOLID SURFACING MATERIAL

- A. Solid Surfacing Material: ISFA 2-01.
 1. Products:
 - a. Avonite Surfaces, a Brand of Aristech Surfaces, LLC; Avonite.
 - b. E. I. du Pont de Nemours and Company; Corian.
 - c. Formica Group; Solid Surfacing.
 - d. Hanwha L&C; Hanex.
 - e. LG Hausys America; HI-MACS.
 - f. Lotte Advanced Materials Co. Ltd.; Staron.
 - g. US Surface Warehouse; LivingStone.
 - h. Wilsonart LLC; Solid Surface.
 2. Thickness: 1/2-inch.
 3. Type: Standard Type.
 4. Color and Pattern: Provide colors per the following:
 - a. Colors and Patterns for Countertops: As selected by Architect from manufacturer's full range of colors equivalent to Dupont Corian price group 4.
 - b. Colors and Patterns for Window Stools: As selected by Architect from manufacturer's full range of colors equivalent to Dupont Corian price group 1.

2.08 COUNTERTOPS

- A. Fabricate in accordance with AWI/AWMAC/WI (AWS), Section 11 - Countertops, Custom Grade and with manufacturer's requirements.

- B. ~~Plastic Laminate Countertops: High-pressure decorative laminate (HPDL) sheet bonded to substrate. (*AD-03)~~
- ~~1. Laminate Sheet: NEMA LD 3, Grade HGS, 0.048 inch nominal thickness.~~
 - ~~2. Core: Particleboard or fiberboard as specified, except provide moisture resistant type at sink locations.~~
 - ~~3. Exposed Edge Treatment: Square, substrate built up to 1-1/2 inch thick unless otherwise indicated; covered with 3 mm edge banding with eased ends.~~
 - ~~4. Back and End Splashes: 3/4-inch thick core material with Grade HGS face and 0.5 mm edge banding/tape at edges.~~
- C. Solid Surfacing Countertops and Window Stools: Solid surfacing sheet or plastic resin casting over structural substrate/core material.
- Solid Surfacing Sheet and Plastic Resin Castings: Complying with ISFA 2-01 and NEMA LD 3; acrylic or polyester resin, mineral filler, and pigments; homogenous, non-porous and capable of being worked and repaired using standard woodworking tools; no surface coating; color and pattern consistent throughout thickness.
 - Core: Fabricate solid surface countertop core of manufacturer's recommended moisture-resistant MDF. Provide continuous structural substrate at unsupported/overhang conditions; ladder construction acceptable over cabinets. Build up core material for total countertop thickness indicated.
 - Fabricate in accordance with manufacturer's standard requirements, and in one piece to the greatest extent possible.
 - Shop-fabricate cutouts and holes in solid surface for plumbing fixtures, deck-mounted soap dispensers, and other items indicated on Drawings.
 - Provide manufacturer's standard configuration for exposed edges, back and end splashes, and per the requirements below:
 - Edge and Corner Profiles: Eased.
 - Provide built up edges to standard thickness indicated (1-1/2 inches unless otherwise indicated).
 - Provide 4 inch high back and end splashes, unless otherwise indicated.
 - Window Stools: Scribe window stools to fit jamb conditions as indicated.

2.09 ACCESSORIES & ACCESSORY MATERIALS

- A. Adhesive: Type recommended by fabricator to suit application.
- B. Plastic Edge Banding: Extruded PVC, flat shaped; smooth finish; of width to match component thickness.
- Provide 3 mm edge banding at all door and drawer front edges and laminate countertop edges.
 - Provide 0.5 mm edge banding (tape) at cabinet body edges, shelf edges, and other semi-exposed/exposed interior edges.
 - Color: To be selected by Architect from Manufacturer's full range to match selected laminate.
- C. Bolts, Nuts, Washers, Lags, Pins, and Screws: Of size and type to suit application; galvanized or chrome-plated finish in concealed locations and stainless steel or chrome-plated finish in exposed locations.
- D. Concealed Joint Fasteners: Threaded steel.
- E. Grommets: Standard plastic grommets for cut-outs, color as selected by Architect from manufacturer's full range.
-

1. Grommet Size: To fit 2-1/2 inch diameter cut-out, nominal, unless otherwise indicated.
 2. Grommets shall have removable caps and slot for wire passage.
- F. Undercounter Wire Management: Provide the following, as indicated:
1. Vinyl J-shaped channel wire manager for undercounter mounting, continuous for full length of countertop.
- G. Undercounter CPU Mount: Adjustable, locking CPU tower mount that can be installed to underside of workstation countertop or to adjacent side wall. Minimum load capacity of 75 lbs.
1. Products:
 - a. Knapé & Vogt; CPU Holder 7300 Series (lockable).
 - b. Richelieu; Locking Slide & Swivel CPU Holder.
 - c. WorkRite Ergonomics; Track Mount 920 CPU Holder.
 - d. Substitutions: See Section 016000 - Product Requirements.
- H. **Mailroom Mailslot Casework Modules: Modular paper sorting assembly of closed-back, open-front case modules with adjustable horizontal shelves, fabricated of fire-resistant, impact-resistant, high-strength plastic or coated steel. Provide manufacturer's standard module sizes for overall unit dimensions and mail slot quantity required. Provide with metal nameplate at each mail slot. (*AD-03)**
1. Manufacturers:
 - a. Datum Filing Systems.
 - b. Hamilton Sorter Company.
 - c. Modular Millwork, Division of International Office Products Cooperative.

2.10 HARDWARE

- A. Hardware: BHMA A156.9, types as recommended by fabricator for quality grade specified.
- B. Adjustable Shelf Supports: Standard side-mounted system using recessed metal shelf standards or multiple holes for pin supports and coordinated shelf rests, polished chrome finish, for nominal 1 inch spacing adjustments.
- C. Workstation Brackets: Fixed, L-shaped, corner reinforced, face-of-stud mounting. Provide at all countertop/worksurface that is unsupported by cabinetry at 16 inches o.c., unless otherwise indicated.
1. Materials: Formed steel shapes.
 - a. Finish: Manufacturer's standard, factory-applied, textured powder coat.
 - b. Color: Paint to match wall color.
 2. Load Capacity: 1000 lbs minimum per pair of brackets, tested at 16 inches o.c. spacing.
 3. Size: Provide nominal sizes below. Provide additional sizes as required for other countertop/workstation applications indicated on Drawings.
 - a. Provide 21 inches high by 28 inches deep for standard 30 inch deep countertops.
 - b. Provide 21 inches high by 21 inches deep for standard 25 inch deep countertops.
 4. Products:
 - a. A&M Hardware, Inc; Standard Brackets.
 - b. Best Brackets; ADA Workstation Support Standard Steel Bracket.
 - c. FastCap; SpeedBrace.
 - d. Lyman Associates; Counter Top Supports.
 - e. Substitutions: See Section 016000 - Product Requirements.

PENDER COUNTY LAW ENFORCEMENT CENTER
BURGAW, NORTH CAROLINA
Architect's Project No.: 611888

- D. Concealed Countertop Support Brackets: Fabricated of 1/4-inch flat plate steel with 1/4-inch diameter mounting holes in vertical flange, for face mounting into framing substrate. Coordinate with countertop fabrication, provide additional shimming and furring to underside of countertop as required for flush installation. Finish color to be selected by Architect from manufacturer's full range. Provide at countertops 18" deep or less.
 - 1. Basis-of-Design Product; Federal Brace; Freedom Hidden Countertop Bracket.
- E. Drawer and Door Pulls: BHMA A156.9, B02011, back-mounted "U" shaped wire pull, steel with satin finish, 4 inch centers.
- F. Cabinet and Drawer Locks: Keyed cylinder, two keys per lock, master keyed, steel with satin finish. Provide on all cabinet doors and drawers unless otherwise indicated.
- G. Drawer Slides:
 - 1. Type: Full extension.
 - 2. Static Load Capacity: Heavy Duty grade.
 - a. For standard box drawers under 30 inches wide, provide BHMA Grade 1HD-100 with minimum load capacity of 100 lbf.
 - b. For file drawers and drawers 30 inches wide or larger, provide BHMA Grade 2HD-200 with minimum load capacity of 200 lbf.
 - c. For pencil drawer slides, provide 3/4 extension with minimum load capacity of 45 lbf.
 - 3. Mounting: Side mounted.
 - 4. Stops: Integral type.
 - 5. Features: Provide soft close type.
 - 6. Manufacturers:
 - a. Accuride International, Inc.
 - b. Fulterer USA.
 - c. Grass America Inc.
 - d. Knappe & Vogt Manufacturing Company.
- H. Filing Cabinet Suspension System: Provide 14-gauge steel file suspension rails, epoxy powder coated. File followers, or other split bottom hardware, are not acceptable.
- I. Hinges: Butt type, BHMA A156.9, Grade 1, 2-3/4 inch, 5-knuckle steel with satin finish. Provide with antifriction bearings and rounded hospital tips.
 - 1. Provide two hinges for doors less than 48 inches high, and three hinges for doors more than 48 inches high.

2.11 DETENTION CASEWORK

- A. Fabricate casework indicated on the Drawings as "Detention Casework," or casework that is located within Detention areas, in accordance with AWI/AWMAC/WI (AWS) Premium grade. Locate equipment consoles, cabinets, and countertops in locations and configuration as indicated on Drawings.
 - 1. Provide plastic laminate casework utilizing particleboard core material as specified for general Division 06 casework.
 - 2. Provide solid surfacing countertops utilizing veneer-core plywood subtop.
- B. Solid Surface Countertops: Fabricate in accordance with AWI/AWMAC/WI (AWS) Premium grade and the following additional requirements:
 - 1. Countertops shall be constructed of 1/2 inch thickness solid-surface material with 3/4 inch veneer-core plywood subtop.

2. Unsupported countertop spans shall not exceed 48 inches, and shall be reinforced to prevent deflection in excess of 1/4 inch under a 100 lb per square foot load.
 3. The maximum distance a solid-surface material countertop (with or without subtop) may cantilever from a support is 12 inches for 3/4 inch thick, or 6 inches for 1/2 inch thick material, whether in the front, back, or end.
 4. Install solid-surface countertops with support adequately furnished to minimize stresses and maximum full perimeter and joint support on all horizontal applications with a maximum on center separation between supports of 24" and with a maximum unsupported and unloaded overhang of 6" for countertop with subtop.
- C. Provide the following hardware items in addition to hinges, shelf supports, and basic items specified for general casework applications:
1. Provide grommets and wiretray required for installation of equipment items.
 2. Provide locks for all drawers and doors.
- D. Mount security control equipment within or on consoles as indicated on Drawings.
1. Coordinate equipment requirements with the Security Control System Contractor (SCSC) prior to submitting shop drawings. Show coordination of detention equipment on the shop drawings.
 2. Locate wire management slots in countertop of size and location required to install monitors and keyboard with minimal exposure of wires from the countertop view. Finish wire management slots with vinyl grommets as specified.
 3. Provide for and coordinate installation of hopper pass and package pass units specified in Division 11 detention equipment sections.

2.12 FABRICATION

- A. Assembly: Shop assemble casework items for delivery to site in units easily handled and to permit passage through building openings.
- B. Edging: Fit shelves, doors, and exposed edges with specified edging. Do not use more than one piece for any single length.
- C. Fitting: When necessary to cut and fit on site, provide materials with ample allowance for cutting. Provide matching trim for scribing and site cutting.
1. Fittings and Fixture Locations: Cut and drill components for fittings and fixtures.
 2. Scribes and Fillers: Panels of matching construction and finish, for locations where cabinets do not fit tight to adjacent construction.
 3. Seal or prime paint concealed cut edges of wood and laminate casework.
- D. Hardware Application: Factory-machine casework members for hardware that is not surface applied.
- E. Apron Frames: Construction similar to other cabinets, with modifications.
1. Frames fabricated from panels standard with the manufacturer. Include front and back panels, with drawer suspension framing mechanically fastened to support channels spanning between them.
- F. Plastic Laminate: Apply plastic laminate finish in full uninterrupted sheets consistent with manufactured sizes. Fit corners and joints hairline; secure with concealed fasteners. Slightly bevel exposed edges.
- G. Solid Surfacing: Fabricate in one piece to greatest extent possible; join pieces with adhesive sealant and finish joints smooth in accordance with manufacturer's recommendations and instructions.

1. Fabricate with butt-jointed / square edge at all solid surface corners. Mitered solid surface corners are not acceptable.
- H. Countertop Fabrication: Fabricate tops and splashes in the largest sections practicable, with top surface of joints flush.
 1. Fabricate to overhang fronts and ends of cabinets 1 inch except where top butts against cabinet or wall, or as indicated.
 2. Prepare all cutouts accurately to size; replace tops having improperly dimensioned or unnecessary cutouts or fixture holes.
- I. Provide back/end splash wherever counter edge abuts vertical surface unless otherwise indicated.
 1. Height: 4 inches, unless otherwise indicated.
 2. Mechanically fasten back and end splashes to countertops with steel brackets at 16 inches on center.
- J. Wall-Mounted Counters (not mounted over cabinets): Provide ADA compliant knee space with brackets, skirts, or aprons, as indicated on Drawings.

PART 3 EXECUTION

3.01 EXAMINATION

- A. Site Verification of Environmental Conditions:
 1. Do not deliver woodwork or casework until the following conditions have been met:
 - a. Building has been enclosed (windows and doors sealed and weather-tight).
 - b. An operational HVAC system that maintains temperature and humidity at occupancy levels has been put in place.
 - c. Ceiling, overhead ductwork, piping, and lighting have been installed.
 - d. Installation areas do not require further "wet work" construction.
- B. For Base Cabinets Installation: Examine floor levelness and flatness of installation space. Do not proceed with installation if encountered floor conditions required more than 1/2 inch leveling adjustment. When installation conditions are acceptable, for each space, establish the high point of the floor. Set and make level and plumb first cabinet in relation to this high point, and provide field modifications as required to not exceed maximum height dimensions.
 1. Construction tolerances shall not apply to casework maximum height dimensions; maximum indicated dimension shall be maintained at any point along the length of casework, regardless of floor levelness.
 2. Field modifications shall be made to the toe kick to account for leveling due to floor levelness.
- C. For Wall Cabinets Installation: Examine wall surfaces in installation space. Do not proceed with installation if the following conditions are encountered:
 1. Maximum variation from plane of masonry wall exceeds 1/4 inch in 10 ft and 1/2 inch in 20 ft or more, and/or maximum variation from plumb exceeds 1/4 inch per story.
 2. Maximum Variation of finished gypsum board surface from true flatness: 1/8 inch in 10 feet in any direction.
- D. Verify adequacy of backing and support framing.
- E. Verify location and sizes of utility rough-in associated with work of this section.

3.02 INSTALLATION

- A. Install work in accordance with AWI/AWMAC/WI (AWS) requirements for grade(s) indicated and in accordance with manufacturer's instructions.
- B. Set and secure custom cabinets in place, assuring that they are rigid, plumb, and level.
- C. Use fixture attachments in concealed locations for wall mounted components.
- D. Carefully scribe casework abutting other components, with maximum gaps of 1/32 inch. Do not use additional overlay trim for this purpose.
- E. Secure cabinets to floor using appropriate angles and anchorages.
- F. Fasten together cabinets in continuous runs, with joints flush, uniform and tight. Misalignment of adjacent units not to exceed 1/16 inch. In addition, do not exceed the following tolerances:
 - 1. Variation of Tops of Base Cabinets from Level: 1/16 inch in 10 feet.
 - 2. Variation of Bottoms of Wall Cabinets from Level: 1/8 inch in 10 feet.
 - 3. Variation of Faces of Cabinets from a True Plane: 1/8 inch in 10 feet.
 - 4. Variation of Adjacent Surfaces from a True Plane (Lippage): 1/32 inch.
 - 5. Variation in Alignment of Adjacent Door and Drawer Edges: 1/16 inch.
- G. Secure wall cabinets at top and bottom, at each end and no more than 16 inches on center. Secure directly into metal wall framing, or into FRT wood or metal channel blocking with No. 10 wafer head screws. Wall mounted hanger strips are not acceptable.
- H. Countertops: Install countertops intended and furnished for field installation in one true plane, with ends abutting at hairline joints, and no raised edges.
- I. Countersink anchorage devices at exposed locations. Conceal with solid wood plugs of species to match surrounding wood; finish flush with surrounding surfaces.

3.03 ADJUSTING

- A. Test installed work for rigidity and ability to support loads.
- B. Adjust moving or operating parts to function smoothly and correctly.

3.04 CLEANING

- A. Clean casework, counters, shelves, hardware, fittings, and fixtures.

3.05 PROTECTION

- A. Do not permit finished casework to be exposed to continued construction activity.
- B. Protect casework and countertops from ongoing construction activities. Prevent workmen from standing on, or storing tools and materials on casework or countertops.
- C. Repair damage, including to finishes, that occurs prior to Date of Substantial Completion, using methods prescribed by manufacturer; replace units that cannot be repaired to like-new condition.

END OF SECTION 064100

SECTION 083313
COILING COUNTER DOORS (AD 03)

PART 1 GENERAL

1.01 REFERENCE STANDARDS

- A. ASTM A36/A36M - Standard Specification for Carbon Structural Steel.
- B. ASTM A123/A123M - Standard Specification for Zinc (Hot-Dip Galvanized) Coatings on Iron and Steel Products.
- C. ASTM A653/A653M - Standard Specification for Steel Sheet, Zinc-Coated (Galvanized) or Zinc-Iron Alloy-Coated (Galvannealed) by the Hot-Dip Process.
- D. NFPA 80 - Standard for Fire Doors and Other Opening Protectives.
- E. UL (DIR) - Online Certifications Directory.
- F. UL 1784 - Standard for Air Leakage Tests of Door Assemblies.

1.02 SUBMITTALS

- A. Product Data: Submit manufacturer's standard literature showing materials and details of construction and finish. Include electrical data for fire release mechanism.
- B. Shop Drawings: Indicate rough and actual opening dimensions, anchorage methods, hardware locations, and installation details.
- C. Samples: Submit manufacturer's color charts indicating standard range of powder coat finishes.
- D. Operation and Maintenance Data: Indicate modes of operation, lubrication requirements and frequency, and periodic adjustments required.
- E. Project Record Documents: Include as-built electrical diagrams for electrical operation and connection to fire alarm system.
- F. Warranty: Provide executed warranty, completed in Owner's name.

1.03 QUALITY ASSURANCE

- A. Products Requiring Electrical Connection: Listed and classified by UL (DIR) as suitable for the purpose specified and indicated.

1.04 WARRANTY

- A. Refer to Section 017800 - Closeout Submittals, for additional warranty requirements.
- B. Manufacturer Warranty: Provide two-year manufacturer warranty for materials and workmanship for all components of coiling doors. Complete forms in Owner's name and register with manufacturer.

PART 2 PRODUCTS

2.01 MANUFACTURERS

- A. Coiling Counter Doors:
 - 1. Alpine Overhead Doors, Inc.
 - 2. Amarr.
 - 3. C.H.I. Overhead Doors.
 - 4. Clopay Building Products.

5. Cornell Iron Works, Inc.
6. Hörmann High Performance Doors.
7. McKeon Rolling Steel Door Co., Inc.
8. Overhead Door Corporation.
9. Raynor Garage Doors.
10. The Cookson Company.
11. Wayne-Dalton, a Division of Overhead Door Corporation.
12. Substitutions: See Section 016000 - Product Requirements.

2.02 COILING COUNTER DOORS (AD 03)

- A. ~~Coiling Counter Doors, Non-Fire-Rated: Galvanized steel slat curtain.~~
1. ~~Mounting: Face of wall mounted (mount on non-secure/non-public side).~~
 2. ~~Nominal Slat Size: Manufacturer's standard.~~
 3. ~~Slat Profile: Flat.~~
 4. ~~Finish, Galvanized Steel: Factory powder coated.~~
 5. ~~Color: As selected by Architect from manufacturer's standard range.~~
 6. ~~Guides: Formed track; same material and finish unless otherwise indicated.~~
 7. ~~Hood Enclosure: Manufacturer's standard; galvanized steel. Finish to match slats.~~
 8. ~~Manual push up operation.~~
 9. ~~Locking Device: Slide bolt for padlock (padlocks NIC).~~
 10. ~~Integral Counter/Sill: Not required. Coordinate coiling door height so that doors will close to the top of indicated stainless steel detention counters.~~
- B. Coiling Counter Doors, Fire-Rated: Galvanized steel slat curtain.
1. Location: Provide where coiling counter door is indicated in fire-rated wall or partition.
 2. Mounting: Face of wall mounted as indicated below:
 - a. At windows AM104B and AM104C: Mount on Magistrate side.
 - b. At window IP108C: Mount on Booking side.
 3. Fire Rating: 3/4 hour at windows AM104B and AM104C; and 1/3 hour at window IP108C. Comply with NFPA 80.
 - a. Provide product listed and labeled by UL (DIR) as suitable for the purpose specified and indicated.
 4. Smoke Control: Provide doors tested to UL 1784, with maximum air-leakage rate of 3.0 cfm/sq. ft. at 0.10-inch wg. Doors shall be listed and labeled by UL (DIR) with letter "S" designating smoke-control.
 5. Nominal Slat Size: Manufacturer's standard.
 6. Slat Profile: Flat.
 7. Finish, Galvanized Steel: Factory powder coated.
 8. Color: As selected by Architect from manufacturer's standard colors.
 9. Guides: Formed track; same material and finish unless otherwise indicated.
 10. Hood Enclosure: Manufacturer's standard; galvanized steel. Finish to match slats.
 11. Fire Release Mechanism: Automatic door release device, actuated by fire alarm and smoke detection systems, with manual reset.
 12. Integral Counter/Sill: Not required. Coordinate coiling door height so that doors will close to the top of indicated counters.
-

2.03 MATERIALS

- A. Curtain Construction: Interlocking, single thickness slats.
 - 1. Slat Ends: Alternate slats fitted with end locks to act as wearing surface in guides and to prevent lateral movement.
 - 2. Curtain Bottom: Fitted with angles to provide reinforcement and positive contact in closed position; neoprene astragal along bottom edge.
 - 3. Steel Slats: ASTM A653/A653M galvanized steel sheet, with minimum G90/Z275 coating; minimum thickness 16 gauge, 0.06 inch.
- B. Guide Construction: Continuous, of profile to retain door in place, with mounting brackets of same metal.
 - 1. Guides for Galvanized Curtains: ASTM A36/A36M steel angles, size as indicated, hot-dip galvanized per ASTM A123/A123M.
- C. Hood Enclosure: Internally reinforced to maintain rigidity and shape.
 - 1. Include automatic hood baffle on fire-rated doors to prevent smoke or fire penetration at hood.
- D. Lock Hardware:
 - 1. For fire shutter units, additional lock or latching mechanisms are not required.
 - 2. Slide Bolt: Provide on single-jamb side, extending into slot in guides, with padlock on one side.
- E. Roller Shaft Counterbalance: Steel pipe and torsion steel spring system, capable of producing torque sufficient to ensure smooth operation of curtain from any position and capable of holding position at mid-travel; with adjustable spring tension; requiring 25 lb nominal force to operate.
 - 1. Provide fire-rated doors with auxiliary counterbalance spring to allow for operation of fire release mechanism without tension release of main counterbalance spring.
- F. Smoke Seals/Gasketing: Provide fire-rated doors with continuous smoke seal gaskets around perimeter of door in accordance with requirements of UL-tested and -listed assembly.

2.04 ELECTRIC OPERATION

- A. Operator, Controls, Actuators, and Safeties: Listed and classified by UL (DIR) or testing agency acceptable to authorities having jurisdiction (AHJ) as suitable for purpose specified and indicated.
 - 1. Fire Release Mechanism: Provide fire-rated door with a constantly energized release device with governor unit and battery backup; complying with NFPA 80; 110/120V. Release device shall be designed to activate upon fire-alarm or smoke-detection system activation. Connection and wiring of release device to fire-alarm and smoke-detection system shall be by Division 26.
 - a. Release device shall allow for testing and manual resetting without retensioning the counterbalance spring system.
 - b. Release device shall have replaceable fusible link above the door designed to activate release at 165 degrees F, as backup in the event of fire-alarm/smoke-detection failure.
 - c. Provide additional mounting hardware and accessories as required for a complete assembly.

PART 3 EXECUTION

3.01 EXAMINATION

- A. Verify that opening sizes, tolerances and conditions are acceptable.

3.02 INSTALLATION

- A. Install units in accordance with manufacturer's instructions.
- B. Install fire-rated doors in accordance with NFPA 80.
- C. Use anchorage devices to securely fasten assembly to wall construction and building framing without distortion or stress.
- D. Securely and rigidly brace components suspended from structure. Secure guides to structural members only.
- E. Fit and align assembly including hardware; level and plumb, to provide smooth operation.
- F. Coordinate installation of electrical service with Division 26, including wiring from fire-alarm and smoke-detection systems.
- G. Complete wiring from disconnect to unit components.

3.03 TOLERANCES

- A. Maintain dimensional tolerances and alignment with adjacent work.
- B. Maximum Variation From Plumb: 1/16 inch.
- C. Maximum Variation From Level: 1/16 inch.
- D. Longitudinal or Diagonal Warp: Plus or minus 1/8 inch per 10 ft straight edge.

3.04 ADJUSTING

- A. Adjust operating assemblies for smooth and noiseless operation.

3.05 CLEANING

- A. Clean installed components.
- B. Remove labels and visible markings.

END OF SECTION 083313

SECTION 085653
SECURITY WINDOWS (AD 03)

PART 1 GENERAL

1.01 REFERENCE STANDARDS

- A. AAMA 2604 - Voluntary Specification, Performance Requirements and Test Procedures for High Performance Organic Coatings on Aluminum Extrusions and Panels (with Coil Coating Appendix).
- B. ASTM A1008/A1008M - Standard Specification for Steel, Sheet, Cold-Rolled, Carbon, Structural, High-Strength Low-Alloy, High-Strength Low-Alloy with Improved Formability, Required Hardness, Solution Hardened, and Bake Hardenable.
- C. ASTM B221 - Standard Specification for Aluminum and Aluminum-Alloy Extruded Bars, Rods, Wire, Profiles, and Tubes.
- D. ASTM B221M - Standard Specification for Aluminum and Aluminum-Alloy Extruded Bars, Rods, Wire, Profiles, and Tubes (Metric).
- E. ASTM E283/E283M - Standard Test Method for Determining Rate of Air Leakage Through Exterior Windows, Skylights, Curtain Walls, and Doors Under Specified Pressure Differences Across the Specimen.
- F. ASTM E330/E330M - Standard Test Method for Structural Performance of Exterior Windows, Doors, Skylights and Curtain Walls by Uniform Static Air Pressure Difference.
- G. ASTM E331 - Standard Test Method for Water Penetration of Exterior Windows, Skylights, Doors, and Curtain Walls by Uniform Static Air Pressure Difference.
- H. SSPC-Paint 33 - Coal Tar Mastic Coating, Cold-Applied.
- I. UL (DIR) - Online Certifications Directory.
- J. UL 752 - Standard for Bullet-Resisting Equipment.

1.02 ADMINISTRATIVE REQUIREMENTS

- A. Coordination: Furnish anchorages, including sleeves, concrete inserts, anchor bolts, and items with integral anchors, to be embedded into concrete or masonry, with setting diagrams and installation, to applicable installer in time for installation.
- B. Preinstallation Meeting: Prior to start of installation arrange a meeting on site to familiarize installer and installers of related work with requirements relating to this work.

1.03 SUBMITTALS

- A. Product Data: Manufacturer's published data showing materials, construction details, dimensions of components, and finishes.
- B. Shop Drawings: Drawings prepared specifically for this project, showing plans, elevations, sections, details of construction, anchorage to other work, hardware, and glazing.
 - 1. For existing and in-place openings show verified field dimensions.
 - 2. Show required opening dimensions and allowance for field deviation.
- C. Test Reports: Test reports for specific window model and glazing to be furnished, showing compliance with specified requirements; window and glazing may be tested separately, provided window test sample adequately simulates the glazing to be used.
 - 1. Include testing agency qualifications.

2. For structural, forced entry, and ballistic tests, provide details on method of anchorage to test frame.
 3. Reports for thermal requirements may be based on calculations, in accordance with the specified standard.
- D. Selection Samples: Color charts for factory finishes.
- E. Verification Samples:
1. Actual sections of frame members, at least 12 inch long, showing finish, weatherstripping, and fasteners.
- F. Installer's Qualification Statement.

1.04 QUALITY ASSURANCE

- A. Testing Agency Qualifications: Independent testing agency able to show experience in conducting tests of the type specified.
- B. Installer Qualifications: Company specializing in performing work of the type specified; certified or approved in writing by security window manufacturer.
- C. Welder Qualifications: Qualified in accordance with AWS procedures for type of welding required.

1.05 WARRANTY

- A. See Section 017800 - Closeout Submittals for additional warranty requirements.
- B. Provide manufacturer's warranty agreeing to repair or replace windows and window components that fail within three years after Date of Substantial Completion due to, but not limited to, the following:
1. Structural failure, failure of welds, and deterioration of metals and finishes beyond that expected under detention use and normal weathering.
 2. Failure of glazing due to excessive deflection of supporting members under wind load.

PART 2 PRODUCTS

2.01 MANUFACTURERS

- A. Security View Windows:
1. Armortex.
 2. Chicago Bullet Proof Systems.
 3. C. R. Laurence Co., Inc.
 4. Creative Industries, Inc.
 5. Insulgard Security Products.
 6. Krieger Specialty Products.
 7. National Bullet Proof, Inc.
 8. Norshield Security Products.
 9. Overly Door Company.
 10. United States Bullet Proofing.
 11. Substitutions: See Section 016000 - Product Requirements.
- B. Source Limitations: Provide windows from a single manufacturer.

2.02 ASSEMBLIES

- A. Security and Detention Windows:
1. Dimensions, profiles, features, and performance specified and indicated on drawings are required; do not deviate unless specifically approved by Architect under substitution procedures; see Section 016000.
 2. Design to fit openings indicated on drawings; design to accommodate deviation of actual construction from dimensions indicated on drawings.
 3. Fabricate frames and sash with corners mitered or coped full depth with concealed welded joints.
 4. Design anchorages to provide performance equivalent to that required for window unit; provide anchorages at least equivalent to those by which the tested units were anchored to the test frame.
 5. Separate dissimilar metals to prevent corrosion by galvanic action by painting contact surfaces with primer or with sealant or tape recommended by manufacturer for the purpose.
 6. Weld components before finishing and in concealed locations, to greatest extent possible; minimize distortion and discoloration of finish; remove residue of welding; grind exposed welds smooth and finish to match.
 7. Label units to indicate which side is which, such as inside/outside or secure/non-secure; use labels that are removable after installation but durable enough not to be lost during delivery, storage, handling, and installation.
- B. Exterior Window Requirements: Comply with following performance requirements as well as other specified criteria.
1. Structural Performance: Capable of withstanding wind loads as specified by code without permanent deformation or breakage of components, when tested in accordance with ASTM E330/E330M.
 2. Deflection of Framing Members Supporting Glass: Provide glass edge support system sufficiently stiff to limit the lateral deflection of supported glass edge to less than 1/175 of their lengths under specified design load.
 3. Air Leakage of Fixed Windows: 0.10 cfm/sq ft maximum leakage for fixed window units when tested at 6.27 psf pressure difference in accordance with ASTM E283/E283M.
 4. Water Penetration: None, when tested in accordance with ASTM E331 at test pressure difference of 2.86 psf.
 5. Thermal Performance: Whole-window U-value of 0.38 Btu/sq ft h degF at 15 mph exterior wind velocity and winter condition temperatures.
 6. Provide thermally improved construction using integral, low conductance thermal barrier in frame and sash members.
 7. Provide weep holes and internal water passages to conduct infiltrated water to exterior.
 8. Provide water shed members where sash frames lap in wrong direction to shed water.
 9. Provide factory-installed weatherstripping on operable sash.

2.03 SECURITY VIEW WINDOWS (AD 03)

- A. Security View Windows: Factory-assembled fixed glazing panel reglazable from secure side without disassembly of frame, with non-removable trim and glazing stops on non-secure side (outside).
1. Glazing: Manufacturer's standard laminated type; kind as required to achieve performance criteria specified.

- a. Total Thickness: 1- to 1-1/4-inches, as standard with manufacturer to meet performance requirements indicated.
 - b. Tint: Gray.
 - c. Low-E Coating: Provide with low-e coating at exterior window applications to achieve required system thermal performance indicated.
2. Factory glazed.
 3. Framing and Glazing Stops: Formed aluminum-clad steel sheet; fluoropolymer finish.
 - a. Framing Cross Section: 4-1/2-inches deep, with sightline either 2- or 2-1/2-inches, as standard with manufacturer.
 4. Ballistic Resistance: UL 752 Level 3 (super-power handgun).
 5. Communication: Standard talk-through portal; stainless steel; matching ballistic resistance of window.
 6. **Deal Trays: Formed stainless steel, recessed into counter or sill for mounting under glazing frame.**
 - a. **Clear Opening Height: 1-1/2 inches.**
 - b. **Tray Dimensions: 12 by 8 inches, wide by deep.**
 - c. **Listed and labeled by UL as bullet resisting to UL 752 Level 3.**

2.04 ASSEMBLY COMPONENTS

- A. Formed Steel Framing: ASTM A1008/A1008M, Designation CS (commercial steel), cold-rolled steel sheet; 12 gauge, 0.1046 inch minimum thickness.
- B. Aluminum Framing: ASTM B221 (ASTM B221M) extrusions of alloy and temper selected by manufacturer for strength, corrosion resistance, and finish required; not less than 1/8 inch thick at any location of frame and sash members.
- C. Weeps: Include integral weeps for exterior window framing to drain water to the exterior along horizontal framing members.
- D. Frame Anchors: Mild steel plates, shapes, or bars, concealed in completed construction; provide anchorage devices as necessary to securely fasten windows to adjacent construction; use security fasteners for exposed anchors.
 1. For Setting in Masonry: Minimum 3/16 inch thick angles or plates, minimum 4 inches long with hooked ends, welded to back of window frame.
 2. Provide minimum of two anchors per side of window plus one additional anchor for each 18 inches or fraction thereof more than 36 inches in height or width.
- E. Weatherstripping: Factory installed; molded EPDM or neoprene.
- F. Glazing Seals: Factory installed; molded EPDM or neoprene compressible gaskets and compression strips.
- G. Security Fasteners: Operable only by tools produced by fastener manufacturer or manufacturer's licensee; head style appropriate to installation conditions, strength, and finish of materials being fastened; use countersunk heads wherever possible.
- H. Package Receiver: Through-wall mounted, with hinged doors on each side with interlock device allowing door to be open on only one side at a time. Provide manufacturer's standard hinge and latch hardware, door on exterior (non-secure) side shall have automatic door closer. Provide with mounting flanges for flush appearance to both sides of wall.
 1. Material (Body): Formed 12 gauge sheet steel, prime painted.

2. Material (Doors): On secure side, formed 16 gauge sheet steel, prime painted. On non-secure side, provide stainless steel door. Both doors shall have UL 752 Level 3 bullet resistant armor.
 3. Operation: Manual.
 4. Dimensions: Minimum of 18 inches by 18 inches; by 18 inch total depth. Provide 4 inch maximum projection on non-secure (lobby) side.
- I. Speaking Aperture Covers: Stainless steel, round, allowing passage of speech at normal volume without distortion; listed and labeled by UL (DIR) as bullet resisting to UL 752, same level as window.
 - J. Bituminous Paint: Cold-applied asbestos-free asphalt mastic, complying with SSPC-Paint 33; 30 mils, 0.030 inch minimum thickness per coat.
 - K. Sealant for Setting Sills and Sill Flashing: Non-curing butyl type.

2.05 FINISHES

- A. Fluoropolymer Finish: Cleaned and pretreated; two coat thermosetting finish containing not less than 70 percent polyvinylidene fluoride resin by weight, complying with AAMA 2604; 1.5 to 2 mils thick, applied in accordance with paint manufacturer's recommendations; medium gloss.
- B. Color: To be selected by Architect from manufacturer's full range.

PART 3 EXECUTION

3.01 EXAMINATION

- A. Verify that window openings are ready for installation of windows.
- B. Verify that correct embedded anchors are in place and in proper location; repair or replace anchors as required to achieve satisfactory installation.
- C. Notify Architect if conditions are not suitable for installation of windows; do not proceed until conditions are satisfactory.

3.02 INSTALLATION

- A. Install in accordance with manufacturer's instructions and approved shop drawings.
- B. Install windows in correct orientation (inside/outside or secure/non-secure).
- C. Anchor windows securely in manner so as to achieve performance specified.
- D. Separate metal members from concrete and masonry using bituminous paint.
- E. Separate dissimilar metals, and metal members in contact with concrete and masonry, using bituminous paint.

3.03 ADJUSTING

- A. Adjust operating components for smooth operation while also providing tight fit at contact points and a secure enclosure; lubricate operating hardware.

3.04 CLEANING AND REPAIR

- A. Clean exposed surfaces promptly after installation without damaging finishes.
- B. Remove and replace defective work.

END OF SECTION 085653

SECTION 092900
GYPSUM BOARD (AD 03)

PART 1 GENERAL

1.01 REFERENCE STANDARDS

- A. ANSI A108.11 - American National Standard Specifications for Interior Installation of Cementitious Backer Units.
- B. ANSI A118.9 - American National Standard Specifications for Test Methods and Specifications for Cementitious Backer Units.
- C. ASTM B221 - Standard Specification for Aluminum and Aluminum-Alloy Extruded Bars, Rods, Wire, Profiles, and Tubes.
- D. ASTM C423 - Standard Test Method for Sound Absorption and Sound Absorption Coefficients by the Reverberation Room Method.
- E. ASTM C475/C475M - Standard Specification for Joint Compound and Joint Tape for Finishing Gypsum Board.
- F. ASTM C665 - Standard Specification for Mineral-Fiber Blanket Thermal Insulation for Light Frame Construction and Manufactured Housing.
- G. ASTM C840 - Standard Specification for Application and Finishing of Gypsum Board.
- H. ASTM C1047 - Standard Specification for Accessories for Gypsum Wallboard and Gypsum Veneer Base.
- I. ASTM C1177/C1177M - Standard Specification for Glass Mat Gypsum Substrate for Use as Sheathing.
- J. ASTM C1280 - Standard Specification for Application of Exterior Gypsum Panel Products for Use as Sheathing.
- K. ASTM C1325 - Standard Specification for Fiber-Mat Reinforced Cementitious Backer Units.
- L. ASTM C1396/C1396M - Standard Specification for Gypsum Board.
- M. ASTM C1629/C1629M - Standard Classification for Abuse-Resistant Nondecorated Interior Gypsum Panel Products and Fiber-Reinforced Cement Panels.
- N. ASTM C1658/C1658M - Standard Specification for Glass Mat Gypsum Panels.
- O. ASTM D3273 - Standard Test Method for Resistance to Growth of Mold on the Surface of Interior Coatings in an Environmental Chamber.
- P. ASTM G21 - Standard Practice for Determining Resistance of Synthetic Polymeric Materials to Fungi.
- Q. GA-216 - Application and Finishing of Gypsum Panel Products.
- R. UL 752 - Standard for Bullet-Resisting Equipment.

1.02 SUBMITTALS

- A. Product Data:
 - 1. Provide data on metal framing, gypsum board, accessories, and joint finishing system.
- B. Ballistic Test Reports: Indicate compliance of bullet-resistant sheathing and wallboard assemblies with specified requirements.

1.03 DELIVERY, STORAGE, HANDLING, AND FIELD CONDITIONS

- A. Do not deliver or install until building is weather-tight and conditioned.
- B. Store materials in dry and clean location until needed for installation. During installation, handle in a manner that will prevent damage and to prevent marring and soiling of finished surfaces.
- C. Do not install gypsum products that have gotten wet or moldy, or show signs of past moisture damage.
- D. Maintain uniform temperature and humidity at occupancy conditions during and after installation. Allow products to acclimatize prior to installation.

PART 2 PRODUCTS

2.01 BOARD MATERIALS

- A. Gypsum Wallboard: Paper-faced gypsum panels as defined in ASTM C1396/C1396M; sizes to minimize joints in place; with tapered edges.
 - 1. Application: Use for vertical surfaces and ceilings, unless otherwise indicated.
 - 2. Mold Resistance: Score of 10, when tested in accordance with ASTM D3273.
 - a. Mold-resistant board is required whenever gypsum board is indicated in rooms subject to steam or water, including mechanical rooms, toilet rooms, custodial rooms, and kitchens.
 - 3. At Assemblies Indicated with Fire-Resistance Rating: Use type required by indicated tested assembly; if no tested assembly is indicated, use Type X board, UL or WH listed.
 - 4. Thickness:
 - a. Vertical Surfaces: 5/8 inch.
 - b. Ceilings: 5/8 inch.
 - c. Curved Surfaces: Provide flexible 1/4 inch thickness gypsum board, installed in two layers.
- B. Impact Resistant Wallboard:
 - 1. Application: ~~High-traffic areas indicated.~~ **All corridors, Interview Rooms 173,174,175, Interview Waiting 172, Public LEC Lobby 101, Fitness 128, Computer Forensics Room 179. (AD 03)**
 - 2. Surface Abrasion: Level 3, minimum, when tested in accordance with ASTM C1629/C1629M.
 - 3. Indentation: Level 1, minimum, when tested in accordance with ASTM C1629/C1629M.
 - 4. Soft Body Impact: Level 3, minimum, when tested in accordance with ASTM C1629/C1629M.
 - 5. Hard Body Impact: Level 2, minimum, when tested in accordance with ASTM C1629/C1629M.
 - 6. Mold Resistance: Score of 10, when tested in accordance with ASTM D3273.
 - 7. Paper-Faced Type: Gypsum wallboard, as defined in ASTM C1396/C1396M.
 - 8. Glass Mat-Faced Type: Gypsum wallboard, as defined in ASTM C1658/C1658M.
 - 9. Type: Fire-resistance-rated Type X, UL or WH listed.
 - 10. Thickness: 5/8 inch.
 - 11. Edges: Tapered.
 - 12. Paper-Faced Products:
 - a. American Gypsum Company; M-Bloc IR Type X.
 - b. CertainTeed Corporation; Extreme Impact Resistant Drywall with M2Tech.

PENDER COUNTY LAW ENFORCEMENT CENTER
BURGAW, NORTH CAROLINA
Architect's Project No.: 611888

- c. National Gypsum Company; Gold Bond Hi-Impact XP Gypsum Board.
- d. Substitutions: See Section 016000 - Product Requirements.
- 13. Glass Mat Faced Products:
 - a. Georgia-Pacific Gypsum; DensArmor Plus Impact-Resistant.
 - b. USG Corporation; USG Sheetrock Brand Glass-Mat Panels Mold Tough VHI.
 - c. Substitutions: See Section 016000 - Product Requirements.
- C. Tile Backing Board:
 - 1. Application: Surfaces behind tile in wet areas including tub and shower surrounds.
 - 2. Mold Resistance: Score of 10, when tested in accordance with ASTM D3273.
 - 3. ANSI Cement-Based Board: Non-gypsum-based; cementitious panels with glass fiber mesh embedded in front and back surfaces complying with ANSI A118.9 and ASTM C 1288 or ASTM C1325.
 - a. Thickness: 5/8 inch.
 - b. Available Products:
 - 1) FinPan, Inc.; Util-A-Crete Backer Board.
 - 2) National Gypsum Company; PermaBase Cement Board.
 - 3) USG Corporation; Durock Cement Board.
 - 4) Substitutions: See Section 016000 - Product Requirements.
- D. Bullet Resistant Sheathing and Wallboard: Woven roving, multi-ply, ballistic grade fiberglass cloth with thermoset polyester resin; comply with UL 752 Level 3. Size boards to minimize joints.
 - 1. Thickness: Nominal 7/16 inch or 1/2 inch as standard with manufacturer.
 - 2. Available Products:
 - a. ArmorCore by Waco Composites; Bullet Resistant Fiberglass Panels.
 - b. Armortex, Div. of Safeguard Security System, Inc.; OF 300.
 - c. Chicago Bullet Proof Systems; Fibre-Tex.
 - d. C.R. Laurence of North America; BRF300.
 - e. Insulgard Corporation; FG-300.
- E. Exterior Sheathing Board for Ceilings and Soffits: Sizes to minimize joints in place; ends square cut.
 - 1. Mold Resistance: Score of 10, when tested in accordance with ASTM D3273.
 - 2. Fungal Resistance: No fungal growth when tested in accordance with ASTM G21.
 - 3. Glass Mat Faced Sheathing: Glass mat faced gypsum substrate as defined in ASTM C1177/C1177M.
 - 4. Edges: Square.
 - 5. Available Glass Mat Faced Products:
 - a. American Gypsum Company; M-Glass Exterior Sheathing.
 - b. CertainTeed Corporation; GlasRoc Exterior Sheathing.
 - c. Georgia-Pacific Gypsum; DensGlass Sheathing.
 - d. National Gypsum Company; Gold Bond eXP Sheathing.
 - e. USG Corporation; USG Securock Brand Ultralight Glass-Mat Sheathing.
- F. Shaftwall Liner Panels: Type X; 1 inch thick, square long edges, ends square cut.
 - 1. Glass Mat Faced Type: Glass mat shaftliner gypsum panel or glass mat coreboard gypsum panel as defined in ASTM C1658/C1658M.

2. Mold Resistance: Score of 10, when tested in accordance with ASTM D3273.

2.02 GYPSUM BOARD ACCESSORIES

- A. Sound Attenuation Batts: ASTM C665; preformed glass fiber, friction fit type, unfaced. Thickness sized to fit metal stud cavity.
- B. Acoustic Sealant: Acrylic emulsion latex or water-based elastomeric sealant; do not use solvent-based non-curing butyl sealant. Refer to sealant AS-1 in Division 07 Section "Joint Sealants."
- C. Putty Pads: Non-hardening endothermic material, in pad form, faced on both sides with poly liner, designed to seal around penetrations and wiring devices, enhancing acoustic performance.
 1. Nominal Size: 7-1/4 x 7-1/4 x 3/16 inches.
 2. Available Products:
 - a. 3M; Fire Barrier Moldable Putty Pads MPP+.
 - b. Hilti; Firestop Putty Pad, CFS-P PA.
 - c. Specified Technologies, Inc.; SpecSeal Putty Pad.
- D. Beads, Joint Accessories, and Other Trim: ASTM C1047, galvanized steel or rolled zinc, unless noted otherwise.
 1. Corner Beads: Low profile, for 90 degree outside corners.
 2. L-Bead, LC-Bead, and U-Bead: Sized to fit gypsum wallboard size(s) indicated.
 - a. Provide LC-bead at exposed panel edges and U-bead at concealed panel edges, unless otherwise indicated. Provide L-bead at locations indicated.
- E. Decorative Metal Trim:
 1. Material: Extruded aluminum alloy 6063-T5 temper.
 2. Finish: Anodized, clear.
 3. Type: Profile(s) as indicated on Drawings; selected from manufacturer's standard range.
 4. Reveal Trim: Provide 1/2-inch wide by either 1/2-inch or 5/8-inch deep, as standard with manufacturer.
 - a. Products:
 - 1) Fry Reglet; Model DRM-625-50.
 - 2) Flannery, Inc; Model DWR 625-50.
 - 3) Gordon, Inc; Part # 512-5/8.
 - 4) Pittcon Industries; Model SWR-050-063.
 - 5) Tamlyn; Model RV5-12.
 5. "F" Reveal Molding: 1/2-inch wide by 5/8-inch deep with 7/8-inch flange on one side only for reveals where drywall terminates against jamb, ceiling, or other finish material.
 - a. Products:
 - 1) Fry Reglet; Model DRMF-625-50.
 - 2) Flannery, Inc; Model DWRF 625-50.
 - 3) Gordon, Inc; Part # 412-5/8.
 - 4) Pittcon Industries; Model SWR-050U-063.
 - 5) Tamlyn; Model MCR5-12
 6. L-Trim Molding: "L" angle molding where drywall raised panel terminates at other substrates.
 - a. Products:

PENDER COUNTY LAW ENFORCEMENT CENTER
BURGAW, NORTH CAROLINA
Architect's Project No.: 611888

- 1) Fry Reglet; Model DRML-625.
 - 2) Flannery, Inc; Model DWL 625.
 - 3) Gordon, Inc; Part # 258.
 - 4) Pittcon Industries; Model ST-063.
 - 5) Tamlyn; Model MLR-58.
7. Stepped Outside Corner: Exposed metal reveal profile for 90 degree outside corners.
- a. Products:
 - 1) Fry Reglet; Model DRMW 625-625.
 - 2) Flannery, Inc; Model DWRW 625-625.
 - 3) Gordon, Inc; Part # 945-2X-58.
 - 4) Pittcon Industries; Model SCS-2X 063-063.
 - 5) Tamlyn; (no product - provide custom to match profiles above).
- F. Metal Edge Trim for "Cloud" Suspended Ceilings: Steel or extruded aluminum; provide attachment clips, splice plates, and preformed corner pieces for a complete trim system.
1. Trim Height: 4 inches.
 2. Finish: Baked enamel; white.
 3. Available Products:
 - a. Armstrong World Industries, Inc.; Axiom Classic.
 - b. Certainteed; Terminus Perimeter Trim.
 - c. Chicago Metallic Corp.; Infinity System.
 - d. USG Corporation; Compasso Suspension Trim.
- G. Acoustic Partition Closure at Storefront or Curtain Wall: Multi-piece rectangular-section assembly of nested U-shape aluminum extrusions for finished closure between aluminum storefront or curtainwall system vertical mullion (and glass where indicated), and partition assembly. Closure shall allow for movements of framing and glass it attaches to, and shall not allow direct metal to glass contact. Fill cavity of partition closure with acoustic batt insulation.
1. Thickness: Aluminum closure plates not less than 0.125-inch thick.
 2. Acoustic Rating: Provide product with a minimum tested STC rating of 55.
 - a. Acoustic Material: Fungi- and microbe-resistant foam, Class A rated when tested per ASTM E 84.
 3. Acoustical Sealant: Seal both ends of partition closure with acoustical sealant.
 4. Finish: Powder coat; color selected by Architect from manufacturer's full range.
 5. Available Products:
 - a. Gordon, Inc; Mullion Mate.
 - b. Mull-It-Over Products; Mull-It-Over.
- H. Joint Materials: ASTM C475/C475M and as recommended by gypsum board manufacturer for project conditions.
- I. Exterior Soffit Vents: One piece, perforated, ASTM B221 6063 T5 alloy aluminum, with edge suitable for direct application to gypsum board and manufactured especially for soffit application. Provide continuous vent.
1. Available Manufacturers:
 - a. Fry Reglet.
 - b. Gordon, Inc.
 - c. Pittcon Industries.
 - d. Stockton Products.

2. Flat, horizontal-to-horizontal application: 2-inch wide with three rows of vent slots for a minimum of 3 square inches of opening per linear foot.
 3. Finish: High performance organic coating; color selected by Architect from manufacturer's full range.
- J. Security Barrier Mesh: ASTM F 1267, Type II, Class 1; expanded and flattened diamond mesh security barrier. Fabricate of uncoated, minimum 18 gage carbon steel, weight 0.66 lbs/sq. ft. Provide with lath mesh size approximately 1/2-inch by 1-1/4-inch.
1. Mesh Fasteners: Provide fasteners that are non-corrosive to both mesh and framing substrate; as recommended by manufacturer for mesh-to-mesh and mesh-to-framing fastening.

PART 3 EXECUTION

3.01 EXAMINATION

- A. Verify that project conditions are appropriate for work of this section to commence.

3.02 SHAFT WALL INSTALLATION

- A. Shaft Wall Framing: Install in accordance with manufacturer's installation instructions.
- B. Shaft Wall Liner: Cut panels to accurate dimensions and install sequentially between special friction studs.

3.03 ACOUSTIC ACCESSORIES INSTALLATION

- A. Sound Attenuation Batts: Place tightly within spaces, around cut openings, behind and around electrical and mechanical items within partitions, and tight to items passing through partitions.
- B. Acoustic Sealant: Install in accordance with manufacturer's instructions.

3.04 BOARD INSTALLATION

- A. Comply with ASTM C840, GA-216, and manufacturer's instructions. Install to minimize butt end joints, especially in highly visible locations.
- B. Single-Layer Nonrated: Install gypsum board in most economical direction, with ends and edges occurring over firm bearing.
- C. Double-Layer, Nonrated: Use gypsum board for first layer, placed parallel to framing or furring members, with ends and edges occurring over firm bearing. Use glass mat faced gypsum board at exterior walls and at other locations as indicated. Place second layer perpendicular to framing or furring members. Offset joints of second layer from joints of first layer.
- D. Fire-Resistance-Rated Construction: Install gypsum board in strict compliance with requirements of assembly listing.
- E. Security Gypsum Partitions and Ceilings: At security gypsum assemblies indicated, install expanded/flattened metal security barrier mesh followed by impact resistant gypsum board.
- F. Install gypsum board with an open horizontal joint (gap) not to exceed 5/8-inch above finished floor slab, and tape and finish vertical joints to bottom edge of board to afford a smooth substrate for applied wall base.
- G. Exterior Sheathing: Comply with ASTM C1280. Install sheathing vertically, with edges butted tight and ends occurring over firm bearing.
- H. Cementitious Backing Board: Install over steel framing members where indicated, in accordance with ANSI A108.11 and manufacturer's instructions.

- I. Bullet Resistant Sheathing and Wallboard:
 - 1. Install bullet-resistant sheathing according to manufacturer's written recommendations and with manufacturer-approved fasteners.
 - 2. Cover all joints between boards with a 4-inch strip of the same thickness material as the boards, centered on the joint.

3.05 INSTALLATION OF TRIM AND ACCESSORIES

- A. Control Joints: Place control joints in compliance with ASTM C 840, consistent with lines of building spaces, and as indicated.
 - 1. Not more than 30 feet apart on walls and ceilings over 50 feet long.
 - 2. At exterior soffits, not more than 30 feet apart in both directions.
- B. Corner Beads: Install at external corners, using longest practical lengths.
- C. Decorative Trim: Install at locations shown on drawings and in accordance with manufacturer's instructions.
- D. Exterior Soffit Vents: Install according to manufacturer's written instructions and in locations indicated on drawings. Provide vent area specified.
- E. Putty Pads: Install putty pads on the backside of items penetrating gypsum board on STC-rated walls/partitions. Items include, but are not limited to, wiring devices, cable, conduit, and pipe. Completely cover and seal around each penetration.

3.06 JOINT TREATMENT

- A. Finish gypsum board in accordance with levels defined in ASTM C840, as follows:
 - 1. Level 4: Walls and ceilings to receive paint finish or wall coverings, unless otherwise indicated.
 - 2. Level 2: In utility areas, behind cabinetry, and on backing board to receive tile finish.
 - 3. Level 1: Fire-resistance-rated wall areas above finished ceilings, whether or not accessible in the completed construction.
- B. Tape, fill, and sand exposed joints, edges, and corners to produce smooth surface ready to receive finishes.
 - 1. Feather coats of joint compound so that camber is maximum 1/32 inch.
- C. Fill and finish joints and corners of cementitious backing board as recommended by manufacturer.

3.07 TOLERANCES

- A. Maximum Variation of Finished Gypsum Board Surface from True Flatness: 1/8 inch in 10 feet in any direction.

END OF SECTION 092900

SECTION 096536
STATIC-CONTROL RESILIENT FLOORING (*AD-03)

PART 1 GENERAL

1.01 REFERENCE STANDARDS

- A. AATCC Test Method 134 - Test Method for Electrostatic Propensity of Carpets.
- B. ANSI/ESD STM7.1 - The Protection of Electrostatic Discharge Susceptible Items Flooring Systems Resistive Characterization.
- C. ANSI/ESD STM97.1 - ESD Association Standard Test Method for the Protection of Electrostatic Discharge Items - Floor Materials And Footwear - Resistance Measurement in Combination with a Person.
- D. ANSI/ESD STM97.2 - Floor Materials and Footwear - Voltage Measurement in Combination with a Person.
- E. ASTM F150 - Standard Test Method for Electrical Resistance of Conductive and Static Dissipative Resilient Flooring.
- F. ASTM F710 - Standard Practice for Preparing Concrete Floors to Receive Resilient Flooring.
- G. ASTM F1344 - Standard Specification for Rubber Floor Tile.
- H. ASTM F1869 - Standard Test Method for Measuring Moisture Vapor Emission Rate of Concrete Subfloor Using Anhydrous Calcium Chloride.
- I. ASTM F2170 - Standard Test Method for Determining Relative Humidity in Concrete Floor Slabs Using in situ Probes.

1.02 SUBMITTALS

- A. Product Data: Provide data on specified products, describing physical and performance characteristics; including sizes, patterns and colors available; and installation instructions.
- B. Shop Drawings: Indicate seaming plans, floor patterns, and dye lot.
- C. Selection Samples: Submit manufacturer's complete set of color samples for Architect's initial selection.
- D. Concrete Subfloor Test Report: Submit a copy of the moisture and alkalinity (pH) test reports.
- E. Warranty: Submit manufacturer warranty and ensure forms have been completed in Owner's name and registered with manufacturer.

1.03 DELIVERY, STORAGE, AND HANDLING

- A. Upon receipt, immediately remove any shrink-wrap and check materials for damage and the correct style, color, quantity and run numbers.
- B. Store all materials off of the floor in an acclimatized, weather-tight space.
- C. Maintain temperature in storage area between 55 degrees F and 90 degrees F.

1.04 FIELD CONDITIONS

- A. Store materials for not less than 48 hours prior to installation in area of installation at a temperature of 70 degrees F to achieve temperature stability. Thereafter, maintain conditions above 55 degrees F.

1.05 WARRANTY

- A. See Section 017800 - Closeout Submittals, for additional warranty requirements.
- B. Manufacturer's Warranty: Provide a ten (10) year manufacturer warranty, covering defective material and installation.
- C. Installer's Warranty: Installer shall warrant that the products have been installed in accordance with manufacturer's instructions.
 - 1. The installer shall provide a ten (10) year warranty against product failure due to excessive moisture vapor transmission through the slab.

PART 2 PRODUCTS

2.01 STATIC FLOORING

- A. Static Control Tile - Type RFT: Homogeneous; color and pattern throughout thickness.
 - 1. Manufacturers:
 - a. Nora; norament grano ed.
 - b. Roppe Corporation; ESD Rubber Static Control Tile.
 - c. StaticWorx; SD Architectural Rubber.
 - 2. Minimum Requirements: Rubber tile complying with ASTM F1344, Class 1, Type B.
 - 3. Electrical Resistance:
 - a. Dissipative Tile (Material): Resistance between 1.0 megohms and 1000 megohms as tested in accordance with ASTM F150 or ANSI/ESD STM7.1.
 - b. Dissipative Tile (System - Flooring and Footwear in combination with a person): Resistance between 1.0 megohms and 35 megohms as tested in accordance with ANSI/ESD STM97.1.
 - 4. Static Generation (System - Flooring and Footwear in combination with a person): Less than 100 V when tested per AATCC Test Method 134 or ANSI/ESD STM97.2.
 - 5. Critical Radiant Flux (CRF): Minimum 0.45 watt per square centimeter, when tested in accordance with ASTM E648 or NFPA 253.
 - 6. Tile Size: Tile size shall match size of raised access floor panel. Coordinate with access flooring manufacturer.
 - 7. Total Thickness: 2 mm, minimum.
 - 8. Texture: Hammered.
 - 9. Color: To be selected by Architect from manufacturer's full range.

2.02 ACCESSORIES

- A. Subfloor Filler: Type recommended by adhesive material manufacturer.
- B. Primers, Adhesives, and Seam Sealer: Waterproof; types recommended by flooring manufacturer.
 - 1. For static-control flooring, provide types as required by manufacturer to maintain static dissipative properties of flooring system and grounded connection.
 - 2. VOC Content Limits: As specified in Section 016116.
- C. Copper Grounding Strips: Type and size as recommended by static control flooring manufacturer.

PART 3 EXECUTION

3.01 EXAMINATION

- A. Verify that surfaces are flat to tolerances acceptable to flooring manufacturer, free of cracks that might telegraph through flooring, clean, dry, and free of curing compounds, surface hardeners, and other chemicals that might interfere with bonding of flooring to substrate.
- B. Cementitious Subfloor Surfaces: Verify that substrates are ready for resilient flooring installation by testing for moisture and alkalinity (pH).
 - 1. Test as Follows: Perform one of each test per 1,000 sf of installation area.
 - a. Alkalinity (pH): ASTM F710.
 - b. Internal Relative Humidity: ASTM F2170.
 - c. Moisture Vapor Emission: ASTM F1869.
 - 2. If test results are not within limits recommended by flooring manufacturer, apply moisture vapor treatment (MVT) in accordance with manufacturer's requirements. MVT shall be provided per unit price and quantity allowance requirements.

3.02 PREPARATION

- A. Prepare floor substrates as recommended by flooring and adhesive manufacturers.
- B. Remove subfloor ridges and bumps. Fill minor low spots, cracks, joints, holes, and other defects with subfloor filler to achieve smooth, flat, hard surface.
- C. Prohibit traffic until filler is fully cured.
- D. Clean substrate.

3.03 INSTALLATION - GENERAL

- A. Starting installation constitutes acceptance of subfloor conditions.
- B. Install in accordance with manufacturer's written instructions.
- C. Adhesive-Applied Installation:
 - 1. Place copper grounding strip in conductive adhesive and apply additional adhesive to top side of strip before installing static control flooring. Allow strip to extend beyond flooring in accordance with static control flooring manufacturer's instructions.
 - 2. Fit joints and butt seams tightly.
 - 3. Set flooring in place, press with heavy roller to attain full adhesion.
- D. Where type of floor finish, pattern, or color are different on opposite sides of door, terminate flooring under centerline of door.
- E. Install edge strips at unprotected or exposed edges, where flooring terminates, and where indicated.
- F. Scribe flooring to walls, columns, cabinets, floor outlets, and other appurtenances to produce tight joints.
- G. Install flooring in recessed floor access covers, maintaining floor pattern.

3.04 INSTALLATION - TILE FLOORING

- A. Mix tile from container to ensure shade variations are consistent when tile is placed, unless otherwise indicated in manufacturer's installation instructions.
- B. Lay flooring with joints and seams aligned with access floor panel joints. Access flooring panels shall be removable without needing removal of floor finish.

3.05 CLEANING

- A. Remove excess adhesive from floor, base, and wall surfaces without damage.
- B. Clean in accordance with manufacturer's written instructions.

3.06 PROTECTION

- A. Prohibit traffic on resilient flooring for 48 hours after installation.

END OF SECTION 096536

SECTION 096700
FLUID-APPLIED FLOORING (*AD-03)

PART 1 GENERAL

1.01 REFERENCE STANDARDS

- A. ASTM D4060 - Standard Test Method for Abrasion Resistance of Organic Coatings by the Taber Abraser.
- B. ASTM F710 - Standard Practice for Preparing Concrete Floors to Receive Resilient Flooring.
- C. ASTM F1869 - Standard Test Method for Measuring Moisture Vapor Emission Rate of Concrete Subfloor Using Anhydrous Calcium Chloride.
- D. ASTM F2170 - Standard Test Method for Determining Relative Humidity in Concrete Floor Slabs Using in situ Probes.
- E. ICRI 310.2R - Selecting and Specifying Concrete Surface Preparation for Sealers, Coatings, Polymer Overlays, and Concrete Repair.

1.02 ADMINSTRATIVE REQUIREMENTS

- A. Preinstallation Meeting: Convene at project site seven calendar days prior to scheduled beginning of construction activities of this section to review section requirements.
 - 1. Require attendance by representatives of installer and other entities directly affecting, or affected by, construction activities of this section.
 - 2. Notify Architect four calendar days in advance of scheduled meeting date.

1.03 SUBMITTALS

- A. Product Data: Provide data on specified products, describing physical and performance characteristics; sizes, patterns and colors available.
- B. Selection Samples: Provide manufacturer's color charts illustrating full range of patterns and colors for each flooring material.
- C. Verification Samples: Manufacturer's standard size physical samples, on rigid backing, illustrating each selected pattern and color.
- D. Concrete Subfloor Test Report: Submit a copy of the moisture and alkalinity (pH) test reports.
- E. Manufacturer's Installation Instructions: Indicate special procedures, perimeter conditions requiring special attention, and application rate for each coat.
- F. Applicator's Qualification Statement.
- G. Field Quality Control Reports: Submit inspection reports of manufacturer's technical representative.
- H. Maintenance Data: Include maintenance procedures, recommended maintenance materials, procedures for stain removal, repairing surface, and suggested schedule for cleaning.

1.04 QUALITY ASSURANCE

- A. Applicator Qualifications: Company specializing in performing the work of this section; certified and approved by manufacturer in writing.
 - 1. Approved by manufacturer.

1.05 MOCK-UPS

- A. Construct mock-up(s) of each type of fluid applied flooring and wall coating to serve as basis for evaluation of texture and workmanship.
 - 1. Number of Mock-Ups to be Prepared: One.
 - 2. Use same materials and methods for use in the work.
 - 3. Use approved design samples as basis for mock-ups.
 - 4. Locate where directed by Architect.
 - 5. Minimum Size: 48 inches by 48 inches.
- B. See Section 014000 - Quality Requirements for additional requirements.
- C. Obtain approval of mock-up by Architect before proceeding with work.
- D. Approved mock-up may remain as part of the work.

1.06 DELIVERY, STORAGE, AND HANDLING

- A. Store resin materials in a dry, secure area.
- B. Store materials for three days prior to installation in area of installation to achieve temperature stability.

1.07 FIELD CONDITIONS

- A. Maintain minimum temperature in storage area of 55 degrees F.
- B. Store materials in area of installation for minimum period of 24 hours prior to installation.
- C. Maintain ambient temperature required by manufacturer 72 hours prior to, during, and 24 hours after installation of materials.

PART 2 PRODUCTS

2.01 MANUFACTURERS

- A. Fluid-Applied Flooring:
 - 1. Crossfield Products Corp.
 - 2. Dur-A-Flex, Inc.
 - 3. Elite Crete Systems.
 - 4. Key Resin Company.
 - 5. Master Builders Solutions.
 - 6. Sherwin-Williams Company.
 - 7. Sika Corporation.
 - 8. Stonhard, Inc.
 - 9. Substitutions: See Section 016000 - Product Requirements.
- B. Source Quality Control: Complete fluid-applied flooring system shall be supplied by a single manufacturer.
 - 1. Accessory and floor preparation products shall be provided by fluid-applied manufacturer or by a manufacturer approved for compatibility by the primary fluid-applied manufacturer.

2.02 PERFORMANCE REQUIREMENTS

- A. Performance Requirements: Specific requirements for each system are indicated in the article below. Where a specific Basis-of-Design value is indicated, minor variations in test numbers shall be permitted for comparable/substitute products at Architect's discretion.

- B. Critical Radiant Flux: Minimum of 0.45 watts/sq cm, when tested in accordance with ASTM E648.
- C. Slip Resistance: Minimum dynamic coefficient of friction (DCOF) of 0.6, when tested in accordance with NFSI / ANSI B101 Standard.

2.03 FLUID-APPLIED FLOORING SYSTEMS

- A. ~~Fluid-Applied Flooring (RES-A1): Hybrid system consisting of urethane base coat, epoxy bonding coat, quartz broadcast aggregate, and aliphatic polyaspartic polyurethane top coat. (*AD-03)~~
 - 1. ~~Basis-of-Design System: Stonhard; Stonetec TRF.~~
 - 2. ~~Compressive Strength: 5,000 psi, minimum, when tested in accordance with ASTM C579.~~
 - 3. ~~Abrasion Resistance: Maximum weight loss of 70-90 mg, when tested in accordance with ASTM D4060 (Basis-of-Design).~~
 - 4. ~~Impact Resistance: No cracking, chipping or delamination, when tested with Gardner Impact Tester at 16 ft lbs.~~
 - 5. ~~Adhesion: Minimum 300 psi at concrete substrate failure, per ASTM D4541.~~
 - 6. ~~System Thickness: 1/4 inch, nominal, dry film thickness (DFT).~~
 - 7. ~~Aggregate: Quartz granules.~~
 - 8. ~~Texture: Slip resistant.~~
 - 9. ~~Sheen: Semi-gloss.~~
 - 10. ~~Color: To be selected by Architect from manufacturer's full range.~~
 - 11. ~~Provide cove base matching floor system, as indicated on Drawings.~~
- B. Fluid-Applied Flooring (RES-A1 and RES-A2): Urethane system consisting of urethane base coat, quartz broadcast aggregate, and urethane top coat. (*AD-03)
 - 1. Basis-of-Design System: Stonhard; Stonshield URT.
 - 2. Abrasion Resistance: Maximum weight loss of 100 mg, when tested in accordance with ASTM D4060 (Basis-of-Design).
 - 3. Impact Resistance: No cracking, chipping or delamination, when tested with Gardner Impact Tester at 16 ft lbs.
 - 4. Adhesion: Minimum 300 psi at concrete substrate failure, per ASTM D4541.
 - 5. System Thickness: 1/8 inch, nominal, dry film thickness (DFT).
 - 6. Aggregate: Quartz granules.
 - 7. Texture: Slip resistant.
 - 8. Sheen: Semi-gloss.
 - 9. Color: Two colors shall be required, one for RES-A1 and one for RES-A2. Each color shall be selected by Architect from manufacturer's full range.
 - 10. Provide cove base matching floor system, as indicated on Drawings.
- C. Fluid-Applied Flooring (RES-C): Hybrid system consisting of two epoxy base coats, vinyl flake aggregate, and urethane top coat. (*AD-03)
 - 1. Basis-of-Design System: Stonhard; Stontec TRF (with urethane top coat).
 - 2. Abrasion Resistance: Maximum weight loss of 30 mg, when tested in accordance with ASTM D4060. (Basis-of-Design)
 - 3. Impact Resistance: No cracking, chipping or delamination, when tested with Gardner Impact Tester at 16 ft lbs.
 - 4. Adhesion: Minimum 300 psi at concrete substrate failure, per ASTM D4541.

5. System Thickness: 1/4 inch, nominal, dry film thickness (DFT).
6. Aggregate: 1/4-inch vinyl flakes.
7. Texture: Slip resistant.
8. Sheen: Semi-gloss.
9. Color: To be selected by Architect from manufacturer's full range.
10. Provide cove base matching floor system, as indicated on Drawings.

2.04 FLUID APPLIED WALL SYSTEMS

- A. Urethane Coating (RES-B):
 1. Basis-of-Design System: Stonhard, Inc; Stoneglaze VSE.
 2. Number of Coats: Two.
 3. Product Characteristics:
 - a. Dry film thickness, per coat: 6-7 mils, minimum. Total DFT 12-15 mil.
 4. Top Coat(s): Polyurethane, Two-Component.
 - a. Sheen: Eggshell.

2.05 ACCESSORIES

- A. Subfloor Filler: Type recommended by fluid-applied flooring manufacturer.
- B. Primer: Type recommended by fluid-applied flooring manufacturer.
- C. Moisture Vapor Treatment: Where fluid-applied flooring and accessories are installed over concrete slabs, provide alkaline-resistant product designed to control excessive moisture vapor transmission through concrete slab, per the following:
 1. Products: Provide product approved by flooring manufacturer and complying with performance requirements below, equivalent to one of the following:
 - a. Duraamen Engineered Products, Inc.; Perdure MVT.
 - b. Maxxon Corporation; Maxxon MVP.
 - c. Tnemec Company Inc.; Epoxoprime MVT, Series 208.
 2. Performance Requirements:
 - a. Verify with flooring manufacturer that submitted product maintains compliance with all provisions of flooring manufacturer's warranty.
 - b. Low-VOC: Provide product with VOC content less than 15 g/L.
 - c. Bond Strength to Concrete: Minimum 400 psi per ASTM D 4541 (100% concrete failure).
 - d. Permeance: Maximum 0.1 perm per ASTM E 96, and 0.10 grains/hr/ft²/in-Hg, per ASTM F3010.
 - e. Applications: Provide MVT for all concrete slabs on-grade and lightweight concrete elevated slabs.

PART 3 EXECUTION

3.01 EXAMINATION

- A. Verify that subfloor surfaces are smooth and flat within the tolerances specified for that type of work and are ready to receive flooring.
- B. Verify that subfloor surfaces are dust-free and free of substances that could impair bonding of materials to subfloor surfaces.

- C. Cementitious Subfloor Surfaces: Verify that substrates are ready for fluid-applied flooring installation by testing for moisture and alkalinity (pH).
 - 1. Test as Follows: Perform one test in each installation area.
 - a. Alkalinity (pH): ASTM F710.
 - b. Internal Relative Humidity: ASTM F2170.
 - c. Moisture Vapor Emission: ASTM F1869.
 - 2. If test results are not within limits recommended by fluid-applied flooring manufacturer, apply moisture vapor treatment (MVT) in accordance with manufacturer's requirements. MVT shall be provided per unit price and quantity allowance requirements.
- D. Verify that required floor-mounted utilities are in correct location.

3.02 PREPARATION

- A. Remove subfloor ridges and bumps. Fill low spots, cracks, joints, holes, and other defects with subfloor filler.
- B. Prepare concrete surfaces according to ICRI 310.2R, CSP 4, minimum, unless otherwise required by manufacturer's installation requirements..
- C. Apply, trowel, and float filler to achieve smooth, flat, hard surface. Grind irregularities above the surface level. Prohibit traffic until filler is cured.
- D. Vacuum clean substrate.
- E. Apply primer to surfaces required by flooring manufacturer.

3.03 INSTALLATION - FLOORING

- A. Apply in accordance with manufacturer's instructions.
- B. Apply each coat to minimum thickness required by manufacturer.
- C. Finish to smooth level surface.
- D. Install flooring to the center of cased openings, and into door openings such that the transition to other floor material will occur under the center of the door leaf. Where transitions occur to another flooring material, extend resinous flooring to suit transition.
- E. Cove at vertical surfaces.

3.04 FIELD QUALITY CONTROL

- A. See Section 014000 - Quality Requirements, for additional requirements.
- B. Provide services of manufacturer's technical representative to inspect for proper installation of fluid-applied flooring system and submit inspection report.

3.05 PROTECTION

- A. Prohibit traffic on floor finish for minimum 48 hours after installation.
- B. Barricade area to protect flooring until fully cured.

END OF SECTION 096700

SECTION 096813
TILE CARPETING (*AD-03)

PART 1 GENERAL

1.01 REFERENCE STANDARDS

- A. NFPA 253 - Standard Method of Test for Critical Radiant Flux of Floor Covering Systems Using a Radiant Heat Energy Source.

1.02 ADMINISTRATIVE REQUIREMENTS

- A. Substitutions/Prequalification: Manufacturers seeking consideration to bid their product as an acceptable alternative shall provide full product data and full range of selection samples during the bid period. Products that do not meet the technical and aesthetic criteria will not be accepted. No substitutions shall be permitted for carpet tile after receipt of bids.

1.03 SUBMITTALS

- A. Product Data: Provide data on specified products, describing physical and performance characteristics; sizes, patterns, colors available, and method of installation.
- B. Shop Drawings: Indicate layout of joints, direction of carpet pile, dye lot, and location of edge moldings and transition strips.
 - 1. Where multiple carpet tile products are specified (including multiple products in a single space installed in an indicated pattern), indicate on the shop drawings the locations where each product is being installed.
- C. Selection Samples: Submit manufacturer's binder indicating full range of colors for carpet tiles and for accessories.
- D. Operation and Maintenance Data: Include maintenance procedures, recommended maintenance materials, and suggested schedule for cleaning.
 - 1. Include specific procedures and materials that are not recommended, including those that may be harmful to carpet tile or that would void warranty.
- E. Maintenance Materials: Furnish the following for Owner's use in maintenance of project.
 - 1. See Section 016000 - Product Requirements, for additional provisions.
 - 2. Extra Carpet Tiles: Quantity equal to 5 percent of total installed of each color and pattern installed.

1.04 QUALITY ASSURANCE

- A. Critical Radiant Flux: All carpet tiles shall be Class I rated, with a minimum CRF of 0.45 watts/sq cm, when tested by an independent testing agency in accordance with ASTM E648 or NFPA 253.

1.05 FIELD CONDITIONS, STORAGE AND HANDLING

- A. Comply with the Carpet and Rug Institute (CRI) Publication "CRI 104 - Standard for Installation of Commercial Carpet." Comply with Section 4.0 for storage and handling, Section 7.0 for ambient temperature and ventilation, and Section 9.0 for Product Acclimation.

1.06 WARRANTY

- A. See Section 017800 - Closeout Submittals, for additional warranty requirements.

- B. Carpet Tile Warranty: Provide a ten (10) year manufacturer warranty, covering defective material and faulty installation.
1. Warranty shall cover excessive surface wear (defined as more than 10% loss by weight of face fiber), edge raveling, backing separation, shrinking, stretching, cupping, doming, static electricity, or color loss or fading.

PART 2 PRODUCTS

2.01 MANUFACTURERS

- A. Tile Carpeting: Provide the basis-of-design carpet tiles or a prequalified alternate tile. No substitutions will be considered after the award of Contract.
1. Bentley Mills; Redux Deux. (basis of design)
 2. Interface, Inc.
 3. Mannington Commercial.
 4. Milliken & Company.

2.02 MATERIALS

- A. Tile Carpeting, Type C-TILE-A: Tufted textured loop, manufactured in one color dye lot.
1. Product: Redux Deux manufactured by Bentley Mills.
 2. Tile Size: 24 by 24 inch, nominal.
 3. Color: As selected by Architect from manufacturer's full range.
 4. Critical Radiant Flux: Minimum of 0.45 watts/sq cm, when tested in accordance with ASTM E648 or NFPA 253.
 5. Primary Backing Material: AFIRMA II Hardback Tile.
 6. **Fiber: Type 6 cationic nylon. (*AD-03)**
 7. **TARR Rating: Minimum 3.0. (*AD-03)**
- B. ~~Tile Carpeting, Type C-TILE-B: Tufted tip-sheared, manufactured in one color dye lot.~~
Refer to specification 096813.13 "Static-Control Tile Carpeting". (*AD-03)
1. ~~Product: Rough Idea manufactured by Bentley Mills..~~
 2. ~~Tile Size: 24 by 24 inch, nominal.~~
 3. ~~Color: As selected by Architect from manufacturer's full range..~~
 4. ~~Critical Radiant Flux: Minimum of 0.45 watts/sq cm, when tested in accordance with ASTM E648 or NFPA 253.~~
 5. ~~Primary Backing Material: AFIRMA II Hardback Tile.~~

2.03 ACCESSORIES

- A. Subfloor Filler: Type recommended by flooring material manufacturer.
- B. Edge Strips: Rubber, color as selected by Architect.
- C. Moisture Vapor Treatment: Where carpeting and accessories are installed over concrete slabs, provide alkaline-resistant product designed to control excessive moisture vapor transmission through concrete slab, per the following:
1. Products: Provide product approved by flooring manufacturer and complying with performance requirements below, equivalent to one of the following:
 - a. Duraamen Engineered Products, Inc.; Perdure MVT.
 - b. Maxxon Corporation; Maxxon MVP.
 - c. Tnemec Company Inc.; Epoxoprime MVT, Series 208.

2. Performance Requirements:

- a. Verify with flooring manufacturer that submitted product maintains compliance with all provisions of flooring manufacturer's warranty.
- b. Low-VOC: Provide product with VOC content less than 15 g/L.
- c. Bond Strength to Concrete: Minimum 400 psi per ASTM D 4541 (100% concrete failure).
- d. Permeance: Maximum 0.1 perm per ASTM E 96, and 0.10 grains/hr/ft²/in-Hg, per ASTM F3010.
- e. Applications: Provide MVT for all concrete slabs on-grade and lightweight concrete elevated slabs.

D. Carpet Tile Adhesive: Recommended by carpet tile manufacturer; releasable type.

PART 3 EXECUTION

3.01 EXAMINATION

- A. Verify that subfloor surfaces are smooth and flat within tolerances specified for that type of work and are ready to receive carpet tile.
- B. Verify that subfloor surfaces are dust-free and free of substances that could impair bonding of adhesive materials to subfloor surfaces.
- C. Cementitious Subfloor Surfaces: Verify that substrates are ready for flooring installation by testing for moisture and alkalinity (pH).
- D. Verify that required floor-mounted utilities are in correct location.

3.02 PREPARATION

- A. Prepare floor substrates as recommended by flooring and adhesive manufacturers.
- B. Remove subfloor ridges and bumps. Fill minor or local low spots, cracks, joints, holes, and other defects with subfloor filler.
- C. Apply, trowel, and float filler to achieve smooth, flat, hard surface. Prohibit traffic until filler is cured.

3.03 INSTALLATION

- A. Starting installation constitutes acceptance of subfloor conditions.
- B. Install carpet tile in accordance with manufacturer's instructions and CRI 104 (Commercial).
- C. Blend carpet from different cartons to ensure minimal variation in color match.
- D. Cut carpet tile clean. Fit carpet tight to intersection with vertical surfaces without gaps.
- E. Lay carpet tile in _____ pattern selected by Architect, with pile direction parallel to next unit, set parallel to building lines, unless otherwise indicated. **(*AD-03)**
- F. Locate change of color or pattern between rooms or at transitions to other finish flooring material directly under the door leaf centerlines, or at the center of cased openings.
- G. Fully adhere carpet tile to substrate.
- H. Install carpet tile into wall recesses, knee spaces under cabinets or countertops, closets, and other similar spaces.
- I. Trim carpet tile neatly at walls and around interruptions.
- J. Complete installation of edge strips, concealing exposed edges.

3.04 CLEANING AND PROTECTION

- A. Remove excess adhesive without damage, from floor, base, and wall surfaces.
- B. Clean and vacuum carpet surfaces.
- C. Protect installed carpet in accordance with CRI 104, Section 13.7 "Post Installation."

END OF SECTION 096813

SECTION 096813.13
STATIC-CONTROL TILE CARPETING

PART 1 GENERAL

1.01 REFERENCE STANDARDS

- A. AATCC Test Method 134 - Test Method for Electrostatic Propensity of Carpets.
- B. ANSI/ESD STM7.1 - The Protection of Electrostatic Discharge Susceptible Items Flooring Systems Resistive Characterization.
- C. ANSI/ESD STM97.1 - ESD Association Standard Test Method for the Protection of Electrostatic Discharge Items - Floor Materials And Footwear - Resistance Measurement in Combination with a Person.
- D. ANSI/ESD STM97.2 - Floor Materials and Footwear - Voltage Measurement in Combination with a Person.
- E. ASTM E648 - Standard Test Method for Critical Radiant Flux of Floor-Covering Systems Using a Radiant Heat Energy Source.
- F. CRI 104 - Standard for Installation of Commercial Carpet.
- G. NFPA 253 - Standard Method of Test for Critical Radiant Flux of Floor Covering Systems Using a Radiant Heat Energy Source.

1.02 ADMINISTRATIVE REQUIREMENTS

- A. Substitutions/Prequalification: Manufacturers seeking consideration to bid their product as an acceptable alternative shall provide full product data, test data indicating static-dissipative properties, and full range of selection samples during the bid period. Products that do not meet the technical and aesthetic criteria will not be accepted. No substitutions shall be permitted for carpet tile after receipt of bids.
- B. Preinstallation Meeting: Convene one week before starting work of this section.

1.03 SUBMITTALS

- A. Product Data: Provide data on specified products, describing physical and performance characteristics; sizes, patterns, colors available, and method of installation.
- B. Shop Drawings: Indicate layout of joints, direction of carpet pile, dye lot, and location of edge moldings and transition strips.
 - 1. Where multiple carpet tile products are specified (including multiple products in a single space installed in an indicated pattern), indicate on the shop drawings the locations where each product is being installed.
 - 2. Include grounding layout.
- C. Selection Samples: Submit manufacturer's color charts indicating full range of colors for carpet tiles and for accessories.
- D. ~~Verification Sample: Submit full size sample for each required color, pattern, and texture.~~
 - 1. ~~Submit samples in manufacturer's standard size for each accessory product. (*AD-03)~~
- E. Manufacturer's Qualification Statement.
- F. Installer's Qualification Statement.

- G. Operation and Maintenance Data: Include maintenance procedures, recommended maintenance materials, and suggested schedule for cleaning.
 - 1. Include specific procedures and materials that are not recommended, including those that may be harmful to carpet tile or that would void warranty.
- H. Maintenance Materials: Furnish the following for Owner's use in maintenance of project.
 - 1. See Section 016000 - Product Requirements, for additional provisions.
 - 2. Extra Carpet Tiles: Quantity equal to 5 percent of total installed of each color and pattern installed.

1.04 QUALITY ASSURANCE

- A. Manufacturer Qualifications: Company specializing in manufacturing static-control flooring.
- B. Installer Qualifications: Company specializing in installing carpet tile with minimum three years documented experience and approved by carpet tile manufacturer.
- C. Testing Agency Qualifications: Independent firm specializing in performing testing and inspections of the type specified in this section.

1.05 FIELD CONDITIONS, STORAGE AND HANDLING

- A. Comply with the Carpet and Rug Institute (CRI) Publication "CRI 104 - Standard for Installation of Commercial Carpet." Comply with Section 4.0 for storage and handling, Section 7.0 for ambient temperature and ventilation, and Section 9.0 for Product Acclimation.

1.06 WARRANTY

- A. See Section 017800 - Closeout Submittals, for additional warranty requirements.
- B. Carpet Tile Warranty: Provide a ten (10) year manufacturer warranty, covering defective material and faulty installation.
 - 1. Warranty shall cover excessive surface wear (defined as more than 10% loss by weight of face fiber), edge raveling, backing separation, shrinking, stretching, cupping, doming, static electricity, or color loss or fading.

PART 2 PRODUCTS

2.01 MANUFACTURERS

- A. Electrostatic-Dissipative (ESD) Tile Carpeting: Provide the basis-of-design carpet tiles or a prequalified alternate tile. No substitutions will be considered after the award of Contract.

2.02 PERFORMANCE REQUIREMENTS

- A. Static-Dissipative Properties: Carpeting shall be manufactured in accordance with industry-specific static-control standards Motorola R56 or ATIS-0600321, for mission critical/telecommunications facilities.
 - 1. Carpeting shall prevent the accumulation of static without requiring use of specialty ESD footwear.
 - 2. Electrical Resistance: Carpeting material shall measure greater than 10 megohms (1.0 x 10E6 ohms) and less than 1000 megohms (1.0 x 10E8 ohms) when tested per ANSI/ESD STM7.1.
 - 3. Static Generation: Less than 100 V when tested per AATCC Test Method 134 or ANSI/ESD STM97.2 at 20 percent relative humidity with conductive footwear.
 - 4. Static Decay: 5000 to zero V in less than 0.25 seconds when tested per MIL STD 3010, Method 4046.

- B. Critical Radiant Flux: All carpet tiles shall be Class I rated, with a minimum CRF of 0.45 watts/sq cm, when tested by an independent testing agency in accordance with ASTM E648 or NFPA 253.

2.03 MATERIALS

- A. Electrostatic Dissipative Tile Carpeting, Type C-TILE-B: Tufted, type 6,6 nylon, wrapped with electrically conductive fibers.
 - 1. Product: ShadowFX Static-Dissipative ESD Carpet Tile manufactured by StaticWorx.
 - 2. Tile Size: 24 by 24 inch, nominal. Verify size with submitted access flooring panel size.
 - 3. Color and Pattern: As selected by Architect from manufacturer's full range.
 - 4. Surface Flammability Ignition: Pass ASTM D2859 (the "pill test").
 - 5. Gauge: 1/12 inch.
 - 6. Stitches: 9 per inch.
 - 7. Backing Material: Manufacturer's standard layered backing; conductive primary backing, with conductive carbon-loaded fiberglass, and static-dissipative PVC bottom backing.

2.04 ACCESSORIES

- A. Grounding: Provide grounding path in accordance with manufacturer's requirements. Coordinate with access flooring manufacturer to ensure grounding system connects to a designated building or electrical ground.
 - 1. Grounding Connectors: 5 mm, 26 gauge copper strip. Provide a minimum of 1 ground connector per 1000 square feet of ESD flooring, and not less than one per room, unless otherwise required by manufacturer.
- B. Edge Strips: Rubber, color as selected by Architect.
- C. Carpet Tile Adhesive: Recommended by carpet tile manufacturer for substrate indicated; static-control type.

PART 3 EXECUTION

3.01 EXAMINATION

- A. Verify that subfloor surfaces are smooth and flat within tolerances specified for that type of work and are ready to receive carpet tile.
- B. Verify that subfloor surfaces are dust-free and free of substances that could impair bonding of adhesive materials to subfloor surfaces.
- C. Verify that required floor-mounted utilities are in correct location.

3.02 PREPARATION

- A. Prepare floor substrates as recommended by flooring and adhesive manufacturers.
- B. Access Flooring: Remove protective films, oils, and other coatings that may impair adhesion of carpet tile to access flooring panels in accordance with manufacturer's recommendations.
- C. Remove subfloor ridges and bumps. Fill minor or local low spots, cracks, joints, holes, and other defects with subfloor filler.
- D. Apply, trowel, and float filler to achieve smooth, flat, hard surface. Prohibit traffic until filler is cured.

3.03 INSTALLATION

- A. Starting installation constitutes acceptance of subfloor conditions.
- B. Install carpet tile in accordance with manufacturer's instructions and CRI 104 (Commercial).
- C. **At raised access floor locations, install grounding strips in static-control adhesive in accordance with manufacturer's standards and per approved shop drawings. Install to acceptable ground connections. (*AD-03)**
- D. Blend carpet from different cartons to ensure minimal variation in color match.
- E. Cut carpet tile clean. Fit carpet tight to intersection with vertical surfaces without gaps.
- F. Lay carpet tile in square pattern, with pile direction parallel to next unit, set parallel to building lines, unless otherwise indicated.
- G. Locate change of color or pattern between rooms or at transitions to other finish flooring material directly under the door leaf centerlines, or at the center of cased openings.
- H. Fully adhere carpet tile to substrate.
- I. Install carpet tile into wall recesses, knee spaces under cabinets or countertops, closets, and other similar spaces.
- J. Trim carpet tile neatly at walls and around interruptions.
- K. Complete installation of edge strips, concealing exposed edges.

3.04 FIELD QUALITY CONTROL

- A. Field Testing: Contractor shall engage a third-party testing agency to test the electrical resistance of installed static-dissipative flooring.
 - 1. Electrical Resistance: Flooring shall average greater than 10 megohms (1.0×10^6 ohms) and less than 1000 megohms (1.0×10^8 ohms) when tested as a floor covering system (including flooring materials and standard non-specialty footwear) in combination; in accordance with ANSI/ESD STM97.2.

3.05 CLEANING AND PROTECTION

- A. Remove excess adhesive without damage, from floor, base, and wall surfaces.
- B. Clean and vacuum carpet surfaces.
- C. Protect installed carpet in accordance with CRI 104, Section 13.7 "Post Installation."

END OF SECTION 096813.13

PENDER COUNTY LEC



PENDER COUNTY, NORTH CAROLINA BURGAW, NORTH CAROLINA

DHSR# J-368 / FID# 220537

MOSELEYARCHITECTS

6210 ARDREY KELL ROAD • THE HUB AT WAVERLY, SUITE 425 • CHARLOTTE, NC 28277
PHONE (704) 540-3755 FAX (704) 540-3754

MOSELEYARCHITECTS.COM

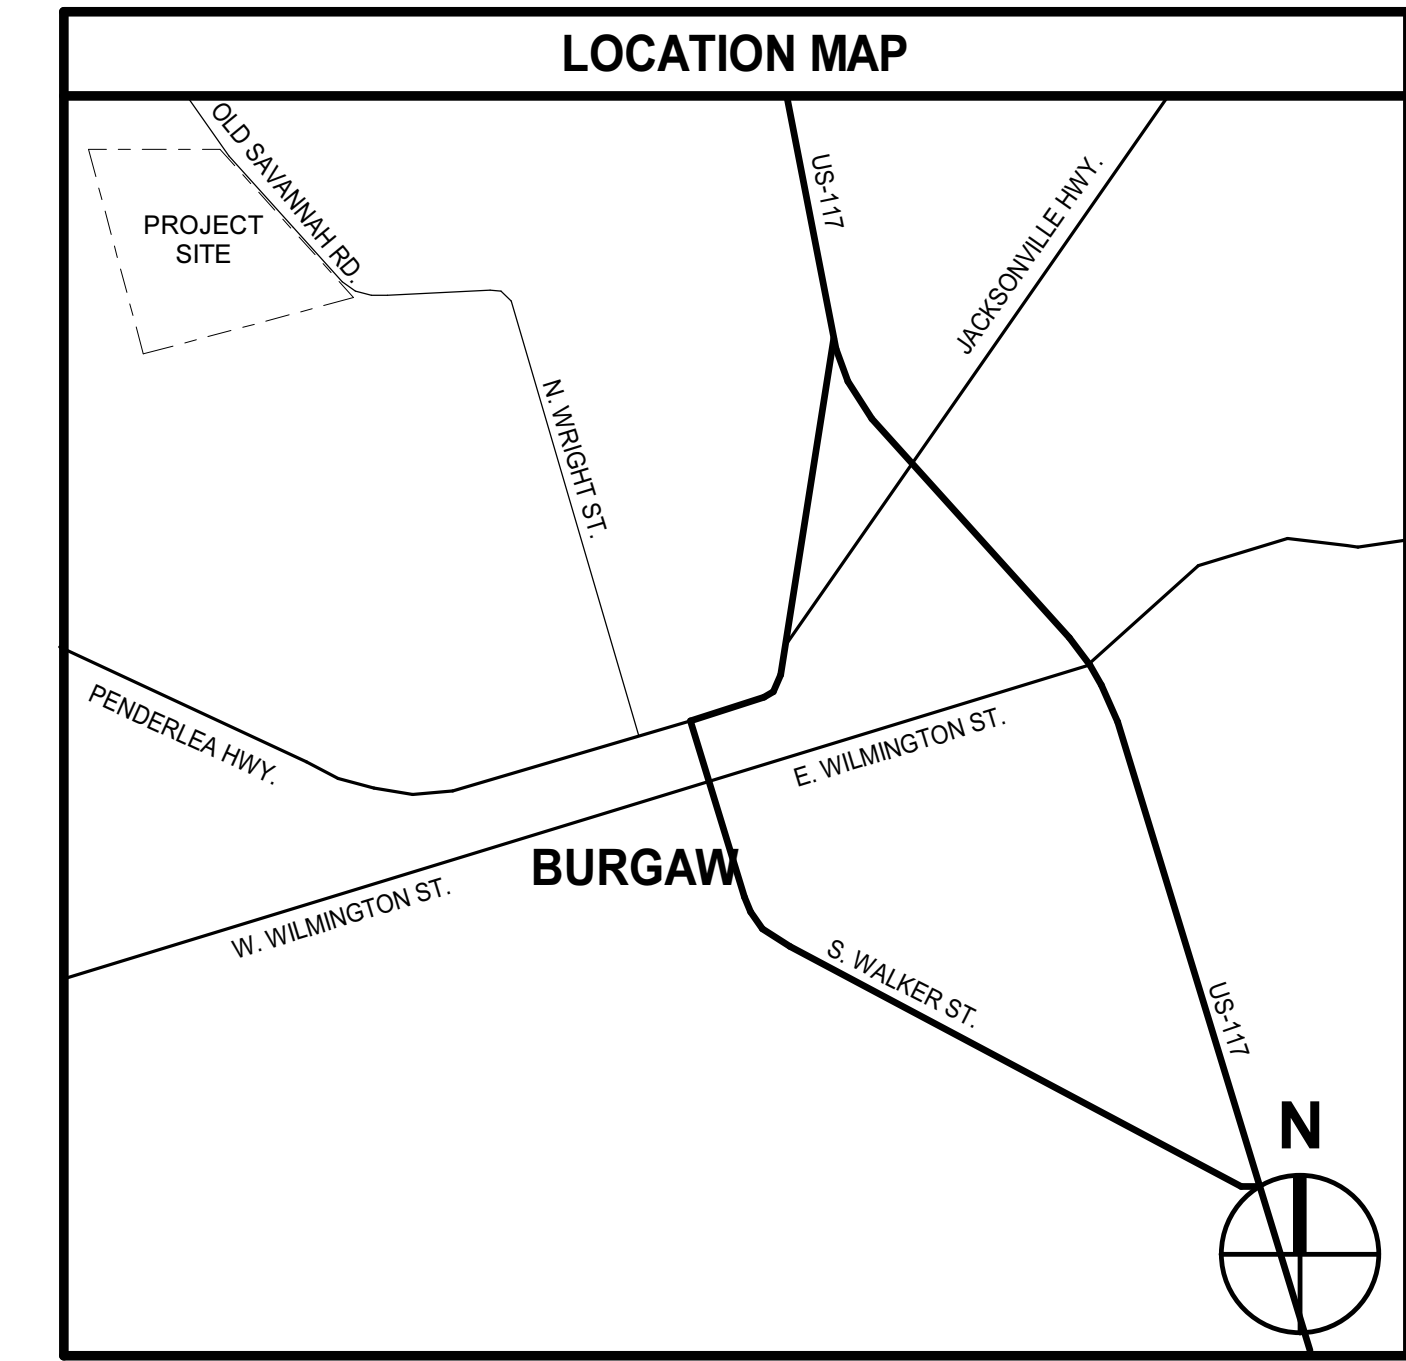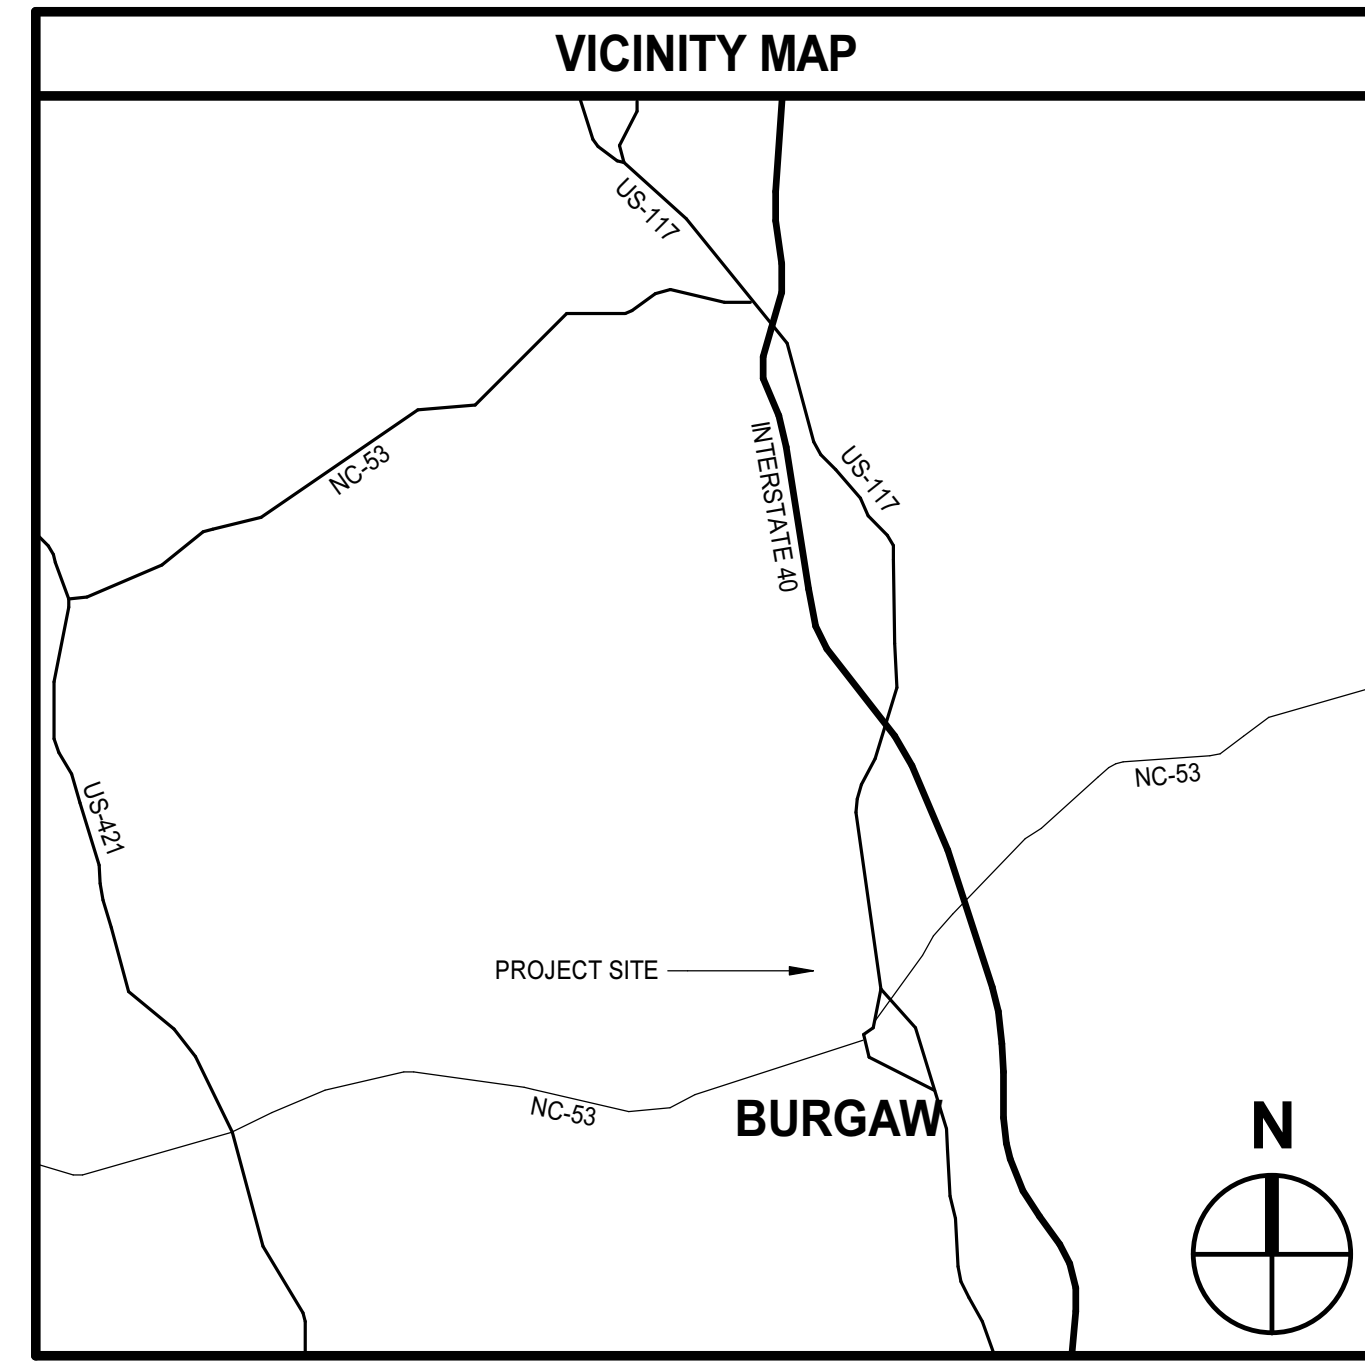

WithersRavenel

Civil Engineering

219 Station Road, Suite 101

Wilmington, North Carolina

Foodesign Associates

FOOD & LAUNDRY SERVICE DESIGN

615 South College Street

Charlotte, North Carolina

DRAWING INDEX

G0.1 COVER	C6.09 EROSION CONTROL DETAILS	A2.1.13 DIMENSION PLAN - PART B - TIER LEVEL	A10.2 ROOF PLAN - ALTERNATE	S2.2.4 ROOF FRAMING PLANS - PART C	P5.1 PLUMBING DETAILS	ELECTRICAL
G1.1 GENERAL	C7.00 SANITARY SEWER PLAN AND PROFILES	A2.1.14 DIMENSION PLAN - PART B - ALTERNATE	A10.3 ROOF DETAILS	S2.2.5 ROOF FRAMING PLANS - PART D	P5.2 PLUMBING DETAILS	E0.1 LEGENDS, ABBREVIATIONS AND GENERAL NOTES
G1.1.1 SECURE AREA & SECURITY WALLS FLOOR PLAN	C7.01 SANITARY SEWER PLAN AND PROFILES	A2.1.15 DIMENSION PLAN - PART B - TIER LEVEL - ALTERNATE	SECURITY	S3.0.1 TYPICAL FOUNDATION DETAILS	P5.3 PLUMBING DETAILS	E1.0 ELECTRICAL SITE PLAN
G1.1.2 INTEGRATED MOCKUP PANEL	C7.02 ROAD PLAN AND PROFILES	A2.1.16 DIMENSION PLAN - PART C	SE1.0 SECURITY ELECTRONICS SITE PLAN	S3.0.2 TYPICAL SLAB DETAILS	P5.4 PLUMBING DETAILS	E2.1.1 FIRST FLOOR PLAN - PART A - LIGHTING
G2.1 GENERAL INFORMATION - AIR BARRIER	C7.03 ROAD PLAN AND PROFILES	A2.1.17 DIMENSION PLAN - PART D	SE2.1 SECURITY ELECTRONICS FLOOR PLAN - PART A	S3.1.1 FOUNDATION SECTIONS	P6.1 SCHEDULES	E2.1.2 FIRST FLOOR PLAN - PART A - POWER
LIFE SAFETY	C7.04 ROAD PLAN AND PROFILES	A2.2.1 PLAN DETAILS	SE2.2 SECURITY ELECTRONICS FLOOR PLAN - PART B	S4.0.1 TYPICAL MASONRY WALL AND LINTEL DETAILS	P7.1 RISER DIAGRAMS - TYPICAL GENERAL POPULATION	E2.1.3 FIRST FLOOR PLAN - PART A - COMMUNICATION
LS1.0 CODE SUMMARY BUILDING A	C7.05 FINISH SCHEDULE	A3.0.1 FINISH SCHEDULE	SE3.0 SECURITY ELECTRONICS FLOOR PLAN - PART B - TIER LEVEL	S4.0.2 TYPICAL FRAMING DETAILS	P7.2 RISER DIAGRAMS - KITCHEN	E2.1.4 FIRST FLOOR PLAN - PART B - MECHANICAL POWER
LS1.1 CODE SUMMARY BUILDING B	C8.00 OFFSITE WATERLINE PLAN & PROFILE	A3.0.2 FINISH SCHEDULE	SE4.0 SECURITY ELECTRONICS FLOOR PLAN - PART B - ALTERNATE	S4.0.3 TYPICAL FRAMING DETAILS AND DECK SCHEDULE	P7.3 RISER DIAGRAMS - STORM - PARTS A & B	E2.2.1 FIRST FLOOR PLAN - PART B - LIGHTING
LS1.2 CODE SUMMARY BUILDING C	C8.01 SCM PLAN AND PROFILE	A3.1.1 INTERIOR EXTERIOR SIGNAGE	SE4.1 SECURITY ELECTRONICS FLOOR PLAN - PART B - TIER LEVEL - ALTERNATE	S4.1.1 FRAMING SECTIONS	P7.4 RISER DIAGRAMS - STORM - PARTS C & D	E2.2.2 FIRST FLOOR PLAN - PART B - POWER
LS1.3 CODE SUMMARY WAREHOUSE	C8.02 SITE DETAILS	A3.2.1 ARCHITECTURAL DOOR SCHEDULE	SE4.2 SECURITY ELECTRONICS FLOOR PLAN - PART B - TIER LEVEL - ALTERNATE	S4.1.2 FRAMING SECTIONS	P7.5 RISER DIAGRAMS - STORM - PART A & B - ALTERNATE	E2.2.3 FIRST FLOOR PLAN - PART B - COMMUNICATION
LS2.1 LIFE SAFETY INFORMATION - BASE BID	C9.01 WATER & SEWER DETAILS	A3.2.2 DOOR & FRAME GLAZING TYPES	SE4.3 SECURITY ELECTRONICS FLOOR PLAN - PART C	S4.1.3 FRAMING SECTIONS		E2.2.4 FIRST FLOOR PLAN - PART B - MECHANICAL POWER
LS2.2 LIFE SAFETY INFORMATION - ADD ALTERNATE	C9.02 SITE, STORMDRAIN, WATER, & SEWER DETAILS	A3.2.3 DOOR AND FRAME DETAILS	SE4.4 SECURITY ELECTRONICS FLOOR PLAN - PART D	S4.1.4 FRAMING SECTIONS		E2.2.4.1 TIER LEVEL FLOOR PLAN - PART B - LIGHTING
LS2.3 LIFE SAFETY INFORMATION - TIER LEVEL - BASE BID & ADD ALT.	L1.0 OVERALL LANDSCAPE PLAN	A3.2.4 DOOR AND FRAME DETAILS	SE7.0 SECURITY ELECTRONICS FLOOR PLAN - WAREHOUSE	S4.1.5 FRAMING SECTIONS		E2.3.2 TIER LEVEL FLOOR PLAN - PART B - POWER
LS3.1 LIFE SAFETY OCCUPANCY SCHEDULES	L1.1 DETAILED LANDSCAPE PLAN	A3.3.1 DETENTION DOOR & WINDOW SCHEDULES	SE7.1 SECURITY ELECTRONICS CAMERA SCHEDULE AND DETAILS	S5.1.1 BRACED FRAME ELEVATIONS		E2.3.3 TIER LEVEL FLOOR PLAN - PART B - COMMUNICATION
LS4.1 FIRE RESISTIVE ASSEMBLIES	L2.0 LANDSCAPE DETAILS	A3.3.2 DETENTION DOOR & FRAME DETAILS	SE4.0 SECURITY ELECTRONICS ONE LINE DIAGRAM	S5.2.2 PORTAL PLAN, ELEVATION, AND REC YARD FRAME ELEVATION		E2.3.4 TIER LEVEL FLOOR PLAN - PART B - MECHANICAL POWER
LS4.2 FIRE RESISTIVE ASSEMBLIES	SL1.0 LIGHTING PLAN	A4.1.1 BUILDING ELEVATIONS		S5.2.3 PORTAL PLANS AND ELEVATIONS		E2.4.1 FLOOR PLAN - PART B - ALTERNATE - LIGHTING
CIVIL		A4.1.2 BUILDING ELEVATIONS	FOOD SERVICE			E2.4.2 FLOOR PLAN - PART B - ALTERNATE - POWER
C0.0 COVER	PS1.00 PUMP STATION	A4.1.3 BUILDING ELEVATIONS	KL.1.1 KITCHEN AND LAUNDRY EQUIPMENT PLAN - LEVEL 1	PLUMBING		E2.4.3 FLOOR PLAN - PART B - ALTERNATE - COMMUNICATIONS
C0.0.1 NOTES AND LEGENDS	PS2.00 PUMP STATION GENERAL NOTES AND LEGEND	A4.2.1 INTERIOR ELEVATIONS	KL.1.2 KITCHEN AND LAUNDRY EQUIPMENT SCHEDULE - LEVEL 1	P0.1 LEGENDS, ABBREVIATIONS AND GENERAL NOTES		E2.5.1 TIER LEVEL FLOOR PLAN - PART B - ALTERNATE - LIGHTING
C0.0.2 GENERAL NOTES	PS2.10 PUMP STATION SITE PLAN	A4.2.2 INTERIOR ELEVATIONS & DETAILS	KL.1.3 KITCHEN AND LAUNDRY ELECTRICAL PLAN - LEVEL 1	P2.0.1 FOUNDATION PLAN - PART A - PLUMBING		E2.5.2 TIER LEVEL FLOOR PLAN - PART B - ALTERNATE - POWER
C1.00 OVERALL EXISTING CONDITIONS	PS2.20 PUMP STATION LAYOUT PLAN	A5.1.1 WALL SECTIONS	KL.1.4 KITCHEN AND LAUNDRY PLUMBING PLAN - LEVEL 1	P2.0.2 FOUNDATION PLAN - PART B - PLUMBING		E2.5.3 TIER LEVEL FLOOR PLAN - PART B - ALTERNATE - COMMUNICATIONS
C1.01 EXISTING CONDITIONS PLAN	PS2.30 PUMP STATION LAYOUT SECTION	A5.1.2 WALL SECTIONS	KL.1.5 COLD STORAGE DETAILS - LEVEL 1	P2.0.3 FOUNDATION PLAN - PART C - PLUMBING		E2.5.4 TIER LEVEL FLOOR PLAN - PART B - ALTERNATE - MECHANICAL POWER
C1.02 EXISTING CONDITIONS PLAN	PS2.40 PUMP STATION DETAILS	A5.1.3 WALL SECTIONS	KL.1.6 EXHAUST HOOD - LEVEL 1	P2.0.4 FOUNDATION PLAN - PART D - PLUMBING		
C2.00 OVERALL SITE PLAN	PS3.00 PUMP STATION ELECTRICAL PLANS AND DETAILS	A5.1.4 WALL SECTIONS	KL.1.7 DISH TABLE DETAILS - LEVEL 1	P2.1.1 FIRST FLOOR PLAN - PART A - SANITARY		
C2.01 LAW ENFORCEMENT CENTER SITE PLAN	PS3.10 PUMP STATION ELECTRICAL PLANS AND DETAILS	A5.1.5 WALL SECTIONS		P2.1.2 FIRST FLOOR PLAN - PART B - SANITARY		
C2.02 LAW ENFORCEMENT CENTER SITE PLAN	PS3.20 PUMP STATION ELECTRICAL PLANS AND DETAILS	A5.1.6 WALL SECTIONS	INTERIORS	P2.1.3 FIRST FLOOR PLAN - PART C - SANITARY		
C2.03 OFFSITE ROADWAY PLAN	PS4.00 FORCE MAIN PLAN AND PROFILES	A5.1.7 WALL SECTIONS	FE2.1 SCHEMATIC FURNITURE PLAN - PART A	P2.1.4 FIRST FLOOR PLAN - PART D - SANITARY		
C3.00 OVERALL LAW ENFORCEMENT CENTER DRAINAGE PLAN	PS4.10 FORCE MAIN PLAN AND PROFILES	A5.2.1 WALL SECTION DETAILS	FE2.2 SCHEMATIC FURNITURE PLAN - PART B	P2.1.5 FIRST FLOOR PLAN - PART A - DOMESTIC		
C3.01 OVERALL OFFSITE ROADWAY DRAINAGE PLAN	PS5.00 PUMP STATION MISC. DETAILS	A5.2.2 WALL SECTION DETAILS	FE2.3 SCHEMATIC FURNITURE PLAN - PART C	P2.1.6 FIRST FLOOR PLAN - PART B - DOMESTIC		
C3.02 LAW ENFORCEMENT CENTER DRAINAGE PLAN	PS5.10 PUMP STATION MISC. DETAILS	A6.1.1 ENLARGED STAIR & RAMP DETAILS	FE2.4 SCHEMATIC FURNITURE PLANS - PART D AND WAREHOUSE	P2.1.7 FIRST FLOOR PLAN - PART C - DOMESTIC		
C3.03 OFFSITE ROADWAY DRAINAGE PLAN	PS5.20 PUMP STATION MISC. DETAILS	A7.1.1 TOILET ASSEMBLIES, SCHEDULE & ENLARGED PLANS	FE2.5 SCHEMATIC FURNITURE PLAN - TIER LEVEL	P2.1.8 FIRST FLOOR PLAN - PART D - DOMESTIC		
C4.00 GRADING PLAN	ARCHITECTURAL	A7.1.2 ENLARGED PLANS	STRUCTURAL	P2.1.9 MEZZANINE LEVEL - PART B - SANITARY		
C4.01 GRADING PLAN	A0.1 GENERAL ARCHITECTURAL INFORMATION	A7.1.3 ENLARGED PLANS	S0.0.1 GENERAL NOTES AND LEGENDS	P2.2.1 MEZZANINE LEVEL - PART B - DOMESTIC		
C4.02 OFFSITE ROADWAY GRADING PLAN	A0.2 WALL/PARTITION TYPES, WALL JOINTS AND TERMINATIONS	A7.1.4 ENLARGED PLANS	S0.0.2 LOADING DIAGRAMS	P2.2.2 MEZZANINE LEVEL - PART B - DOMESTIC		
C5.00 OVERALL UTILITY PLAN	A1.0 ARCHITECTURAL SITE PLAN	A7.1.5 ENLARGED PLANS	S0.0.3 SPECIAL INSPECTION REPORTS - 2018 NC BUILDING CODE	P2.2.3 ROOF PLAN - PART A - PLUMBING		
C5.01 OFFSITE OVERALL UTILITY PLAN	A1.1 SITE AND FENCE DETAILS	A7.1.6 ENLARGED PLANS	S1.1.1 FOUNDATION PLAN - PART A	P2.2.4 ROOF PLAN - PART B - PLUMBING		
C5.02 DETAILED UTILITY PLAN	A1.2 SITE AND FENCE DETAILS	A7.1.7 ENLARGED PLANS	S1.1.2 FOUNDATION PLAN - PART B	P2.2.5 ROOF PLAN - PART D - PLUMBING		
C5.03 DETAILED UTILITY PLAN	A1.3 SITE AND FENCE DETAILS	A7.1.8 WAREHOUSE PLANS & DETAILS	S1.1.3 FOUNDATION PLAN - PART B ALTERNATE	P2.3.1 ROOF PLAN - PART A - PLUMBING		
C6.00 EROSION CONTROL STAGE 1	A2.0.1 OVERALL FLOOR PLANS	A7.1.9 WAREHOUSE PLANS & DETAILS	S1.1.4 FOUNDATION PLAN - PART C	P2.3.2 ROOF PLAN - PART B - PLUMBING		
C6.01 EROSION CONTROL STAGE 1 OFFSITE ROADWAY	A2.0.2 OVERALL FLOOR PLANS - ALTERNATE	A7.1.10 E911 EQUIPMENT BUILDINGS FOR COMM TOWER	S1.1.5 FOUNDATION PLAN - PART D	P2.3.3 ROOF PLAN - PART C - PLUMBING		
C6.02 EROSION CONTROL STAGE 1 OFFSITE FORCEMAIN	A2.1.1 FLOOR PLAN - PART A	A7.1.11 DETENTION EQUIPMENT DETAILS	S1.1.6 FOUNDATION AND FRAMING PLAN - WAREHOUSE	P2.3.4 ROOF PLAN - PART D - PLUMBING		
C6.03 EROSION CONTROL STAGE 2	A2.1.2 FLOOR PLAN - PART B	A8.1.1 CASEWORK AND ELEVATIONS	S1.1.7 FOUNDATION AND FRAMING PLAN - COMMS BUILDING	P2.4.1 FOUNDATION PLAN - PART B - PLUMBING - ALTERNATE		
C6.04 EROSION CONTROL STAGE 2 OFFSITE ROADWAY	A2.1.3 FLOOR PLAN - PART B - TIER LEVEL	A8.1.2 CASEWORK ELEVATIONS AND DETAILS	S1.1.8 SLAB CONTROL JOINT LAYOUT PLAN	P2.4.2 FIRST FLOOR PLAN - PART B - SANITARY - ALTERNATE		
C6.05 EROSION CONTROL STAGE 2 OFFSITE FORCEMAIN	A2.1.4 FLOOR PLAN - PART B - ALTERNATE	A8.1.3 REFLECTED CEILING PLAN - PART A	S1.1.9 SLAB CONTROL JOINT LAYOUT PLAN	P2.4.3 FIRST FLOOR PLAN - PART B - DOMESTIC - ALTERNATE		
C6.06 EROSION CONTROL STAGE 2 OFFSITE ROADWAY	A2.1.5 FLOOR PLAN - PART B - TIER LEVEL - ALTERNATE	A8.1.4 REFLECTED CEILING PLAN - PART B - BASE BID	S1.1.10 FRAMING PLAN PART A - CAP SLAB	P2.4.4 MEZZANINE LEVEL - PART B - SANITARY - ALTERNATE		
C6.07 EROSION CONTROL STAGE 2 OFFSITE FORCEMAIN	A2.1.6 FLOOR PLAN - PART C	A8.1.5 REFLECTED CEILING PLAN - PART B - TIER LEVEL - ALTERNATE	S2.1.3 FRAMING PLAN - PART B TIER ALTERNATE	P2.4.5 MEZZANINE LEVEL - PART B - DOMESTIC - ALTERNATE		
C6.08 EROSION CONTROL DETAILS	A2.1.7 FLOOR PLAN - PART D	A8.1.6 REFLECTED CEILING PLAN - PART C	S2.2.1 ROOF FRAMING PLANS - PART A	P2.4.6 ROOF PLAN - PART B - PLUMBING - ALTERNATE		
	A2.1.11 DIMENSION PLAN - PART A	A8.1.7 REFLECTED CEILING PLAN - PART D	S2.2.2 ROOF FRAMING PLAN - PART B	P2.5 WAREHOUSE PLANS - PLUMBING		
	A2.1.12 DIMENSION PLAN - PART B	A9.1 REFLECTED CEILING PLAN - PART A	S2.2.3 ROOF FRAMING PLAN - PART B ALTERNATE	P4.1 ENLARGED PLANS		
		A9.2 REFLECTED CEILING PLAN - PART B - TIER LEVEL - BASE BID		P4.2 ENLARGED PLANS		
		A9.3 REFLECTED CEILING PLAN - PART B - TIER LEVEL - ALTERNATE		P4.3 ENLARGED PLANS		
		A9.4 REFLECTED CEILING PLAN - PART B - TIER LEVEL - ALTERNATE		P4.4 ENLARGED PLANS		
		A9.5 REFLECTED CEILING PLAN - PART C		P4.5 ENLARGED KITCHEN PLANS - SANITARY		
		A9.6 REFLECTED CEILING PLAN - PART C		P4.6 ENLARGED KITCHEN PLAN - DOMESTIC		
		A9.7 REFLECTED CEILING PLAN - PART D				
		A10.1 ROOF PLAN				

THE CONTRACT DOCUMENTS ARE COMPLEMENTARY, AND WHAT IS REQUIRED BY ONE SHALL BE AS BINDING AS IF REQUIRED BY ALL.
IN CASE OF A CONFLICT, DISAGREEMENT, OR AMBIGUITY, PROVIDE THE BETTER QUALITY. IN CASE OF A CONFLICT, DISAGREEMENT, OR AMBIGUITY, PROVIDE THE GREATER QUANTITY OF WORK.

DATE	REVISIONS	DESCRIPTION
05/24/24	AD 01	
06/12/24	AD 03	

2018 APPENDIX B BUILDING CODE SUMMARY FOR ALL COMMERCIAL PROJECTS (BUILDING B) (EXCEPT 1 AND 2-FAMILY DWELLINGS AND TOWNHOUSES)

Name of Project: Pender County Law Enforcement Center
Address: 604 Savannah Road, Burgaw, North Carolina
Zip Code: 28425
Owner/Authorized Agent: Pender County/Alina Yavin

CONTACT: Moseley Architects Design Team
DESIGNER: FIRM, NAME, LICENSE #, TELEPHONE #, E-MAIL
Architectural: Moseley Architects, Steven J. Hopkins, 11547, (704) 540-3755

2018 NC BUILDING CODE: New Building
2018 NC EXISTING BUILDING CODE: N/A
CONSTRUCTED: (date)
RENOVATED: (date)

BASIC BUILDING DATA
Construction Type: II-B
Sprinklers: Yes, NFPA 13
Standpipes: No

Primary Fire District: No
Special Inspections Required: Yes (Contact the local inspection jurisdiction for additional procedures and requirements)

Gross Building Area Table
FLOOR, EXISTING (SQ FT), NEW (SQ FT), SUB-TOTAL
2nd Floor: 1,816 sq ft
Tier Level: 9,486 sq ft
1st Floor: 31,607 sq ft
TOTAL: 42,909 sq ft

ALLOWABLE AREA
Primary Occupancy Classification(s): Institutional - I-3 Condition 3 and 4
Accessory Occupancy Classification(s):
Incidental Uses (Table 509):
Special Uses (Chapter 4 - List Code Sections): N/A

Table with 5 columns: STORY NO., DESCRIPTION AND USE, (A) BLDG AREA PER STORY (SQ FT), (B) TABLE 506.2 AREA, (C) AREA FOR FRONTAGE (INCHES) 1/2, (D) ALLOWABLE AREA PER STORY (SQ FT)
Row 1: 2, I-3, 1,816, 30,000, N/A, 34,000

1 Frontage area increases from Section 506.3 are computed thus:
a. Perimeter which fronts a public way or open space having 20 feet minimum width = .7865' (F)
b. Total Building Perimeter = .985' (P)
c. Ratio (F/P) = .8 (F/P)
d. W = Minimum width of public way = .22' (W)
e. Percent of frontage increase = 100(F/P) - 0.251 * W/30 = .40 (%)

ALLOWABLE HEIGHT
Table with 4 columns: ALLOWABLE (ABOVE GRADE), SHOWN ON PLANS, CODE REFERENCE
Building Height in Feet (Table 504.3) 2: 75, 26, N/A
Building Height in Stories (Table 504.4) 3: 2, 2, N/A

1 Provide code reference if the "Shown on Plans" quantity is not based on Table 504.3 or 504.4.
2 The maximum height of air traffic control towers must comply with Table 412.3.1.
3 The maximum height of open parking garages must comply with Table 406.5.4.

FIRE PROTECTION REQUIREMENTS
Table with 7 columns: BUILDING ELEMENT, FIRE SEPARATION DISTANCE (FEET), RATING, RATIO PROVIDED, DETAIL # AND FOR WATER PENETRATION, DESIGN # FOR RATED ASSEMBLY, SHEET # FOR WATER RATED JOINTS, SHEET # FOR RATED JOINTS
Primary Structural Frame: GREATER THAN 30', 0 HR, 0 HR, --, --, --, --

PERCENTAGE OF WALL OPENING CALCULATIONS
Table with 4 columns: FIRE SEPARATION DISTANCE (FEET) FROM PROPERTY LINES, DEGREE OF OPENINGS PROTECTION (TABLE 705.8), ALLOWABLE AREA (%), ACTUAL SHOWN ON PLANS (%)
Greater than 30': U.P.S, No limit, N/A

2018 NC Administrative Code and Policies

LIFE SAFETY SYSTEM REQUIREMENTS
Emergency Lighting: Yes - Sheets E2.1.1, E2.2.1, E2.3.1, E2.4.1, E2.5.1, E2.6.1, E2.7.1
Exit Signs: Yes - Sheets E2.3.1, E2.4.1, E2.5.1, E2.6.1, E2.7.1
Fire Alarm: Yes - Sheets E2.1.3, E2.2.3, E2.3.3, E2.4.3, E2.5.3, E2.6.3, E2.7.3
Smoke Detection Systems: Yes - Sheet E4.2
Carbon Monoxide Detection: No

LIFE SAFETY PLAN REQUIREMENTS
Life Safety Plan Sheet #: LS2.1, LS2.2, LS2.3
Fire and/or smoke rated wall locations (Chapter 7)
Assumed and real property line locations (if not on the site plan)
Exterior wall opening area with respect to distance to assumed property lines (705.8)
Occupancy Use for each area as it relates to occupant load calculation (Table 1004.1.2)
Occupant loads for each area
Exit access travel distances (1017)
Common path of travel distances (Tables 1006.2.1 & 1006.3.2(1))
Dead end lengths (1020.4)
Clear exit widths for each exit door
Maximum calculated occupant load capacity each exit door can accommodate based on egress width (1005.3)
Actual occupant load for each exit door
A separate schematic plan indicating where fire rated floor/ceiling and/or roof structure is provided for purposes of occupancy separation
Location of doors with panic hardware (1010.1.10)
Location of doors with delayed egress locks and the amount of delay (1010.1.9.7)
Location of doors with electromagnetic egress locks (1010.1.9.9)
Location of doors equipped with hold-open devices
Location of emergency escape windows (1030)
The square footage of each fire area (202)
The square footage of each smoke compartment for Occupancy Classification I-2 (407.5)
Note any code exceptions or table notes that may have been utilized regarding the items above

ACCESSIBLE DWELLING UNITS (SECTION 1107)
Table with 7 columns: TOTAL UNITS, ACCESSIBLE UNITS, TYPE A UNITS, TYPE B UNITS, TYPE C UNITS, TYPE D UNITS, TOTAL ACCESSIBLE UNITS

ACCESSIBLE PARKING (SECTION 1106)
Table with 5 columns: LOT OR PARKING AREA, TOTAL # OF PARKING SPACES, # OF ACCESSIBLE SPACES PROVIDED, TOTAL # ACCESSIBLE PROVIDED
Public: 82, 163, 4
Staff: 163, 163, 9
TOTAL: 245, 245, 13

PLUMBING FIXTURE REQUIREMENTS (TABLE 2902.1)
Table with 10 columns: USE, WATER CLOSETS, URINALS, LAVATORIES, SHOWERS, DRINKING FOUNTAINS
Male Water Closets: 0
Female Water Closets: 0
Unisex Water Closets: 3
Male Lavatories: 0
Female Lavatories: 0
Unisex Lavatories: 3
Drinking Fountains: 0

SPECIAL APPROVALS
Special approval: (Local Jurisdiction, Department of Insurance, OSC, DPI, DHS, etc., describe below)
Pender County, NC DHSR; NC DOI

BUILDING B PLUMBING FIXTURE REQUIREMENTS FOR I-3 OCCUPANCY
INMATE PLUMBING COUNTS PROVIDED TO MEET NC DHSR JAIL STANDARDS (HOLDING & BOOKING AREAS)
TOTALS (NON-INMATE STAFF)
MALE WATER CLOSETS: 0
FEMALE WATER CLOSETS: 0
UNISEX WATER CLOSETS: 3
MALE LAVATORIES: 0
FEMALE LAVATORIES: 0
UNISEX LAVATORIES: 3
DRINKING FOUNTAINS: 0

ENERGY REQUIREMENTS
The following data shall be considered minimum and any special attribute required to meet the energy code shall also be provided. Each Designer shall furnish the required portions of the project information for the plan data sheet. If performance method, state the annual energy cost for the standard reference design vs annual energy cost for the proposed design.

Existing building envelope complies with code: Select one
Exempt Building: No
Climate Zone: 3A *Warm-humid location
Method of Compliance: Energy Code - Prescriptive
THERMAL ENVELOPE (Prescriptive method only)
Roof/ceiling Assembly (each assembly)
Description of assembly: RA1 on drawing A10.1
U-Value of total assembly: 0.04
R-Value of insulation: R-25ci
Skylights in each assembly: n/a
Exterior Walls (each assembly)
Description of assembly: WA assemblies on AS.1.1
U-Value of total assembly: 0.132 Mass; 0.064 Metal Framed
R-Value of insulation: R-7.6ci Mass; R-13 + R-7.5ci Metal Framed
Openings (windows or doors with glazing)
U-Value of assembly: 0.50
Solar heat gain coefficient: 0.25
projection factor: 0
Door R-Values: R-2
Walls below grade (each assembly)
Description of assembly: WA assemblies on AS.1.1
U-Value of total assembly: 0.133
R-Value of insulation: R-7.5ci
Floors over unconditioned space (each assembly)
Description of assembly: N/A
U-Value of total assembly: N/A
R-Value of insulation: -
Floors slab on grade
Description of assembly: Concrete slab on grade
U-Value of total assembly: 0.067
R-Value of insulation: R-15
Horizontal vertical requirements: 24"
slab heated: NA

2018 NC Administrative Code and Policies

2018 APPENDIX B BUILDING CODE SUMMARY FOR ALL COMMERCIAL PROJECTS (STRUCTURAL DESIGN) (PROVIDE ON THE STRUCTURAL SHEETS IF APPLICABLE)
DESIGN LOADS:
Importance Factors: Snow (Is), L1, Seismic (Ie), L2S, L1.5 REFER TO SHEET S0.0.1
Live Loads: Roof 20 psf, Tier 40 psf, Floor 100 psf
Ground Snow Load: 10 psf
Wind Load: Ultimate Wind Speed 147 mph (ASCE-7), Exposure Category C

SEISMIC DESIGN CATEGORY: C
Provide the following Seismic Design Parameters:
Risk Category (Table 1604.5): III
Spectral Response Acceleration Sa, 19.7%g, S1, .08 g/g
Site Classification (ASCE 7): D
Data Source: Field Test
Basic structural system: Bearing Wall
Analysis Procedure: Equivalent Lateral Force
Architectural, Mechanical, Components anchored? No

LATERAL DESIGN CONTROL: Earthquake
SOIL BEARING CAPACITIES: Field Test (provide copy of test report) 1500 psf
Shallow Foundation, no piles.
SCHEDULE OF SPECIAL INSPECTIONS: SHEET S0.0.3



2018 APPENDIX B BUILDING CODE SUMMARY FOR ALL COMMERCIAL PROJECTS (MECHANICAL DESIGN) (PROVIDE ON THE MECHANICAL SHEETS IF APPLICABLE)
MECHANICAL SUMMARY

MECHANICAL SYSTEMS, SERVICE SYSTEMS AND EQUIPMENT
Thermal Zone 3A
winter dry bulb: 23 F
summer dry bulb: 93 F
summer wet bulb: 79 F
Interior design conditions
winter dry bulb: 70 F
summer dry bulb: 75 F
relative humidity: 50%
Building heating load: 3,887,000 Btu/h
Building cooling load: 2,619,000 Btu/h
Mechanical Spacing Conditioning System
Unitary
description of unit: Unitary
heating efficiency: See schedules on M0.2 & M0.3
cooling efficiency: See schedules on M0.2 & M0.3
size category of unit: See schedules on M0.2 & M0.3
Boiler
Size category: If oversized, state reason: N/A
Chiller
Size category: If oversized, state reason: N/A
List equipment efficiencies: Listed above
Life Safety Equipment Schedules: Sheets M0.2 & M0.3
Fire Dampers: Sheets M0.2 & M0.3
Smoke Dampers/Fire/smoke combination dampers: Sheets M2.1, M2.2, M2.3, M2.4, M2.5
Smoke Exhaust Fans/Systems: Sheets M2.1, M2.2, M2.3, M2.4, M2.5
Smoke Supply Fans/Systems: Sheets M2.1, M2.2, M2.3, M2.4, M2.5
Duct Smoke Detectors: Sheets M2.1, M2.2, M2.3, M2.4, M2.5

2018 APPENDIX B BUILDING CODE SUMMARY FOR ALL COMMERCIAL PROJECTS (ELECTRICAL DESIGN) (PROVIDE ON THE ELECTRICAL SHEETS IF APPLICABLE)
ELECTRICAL SUMMARY

ELECTRICAL SYSTEM AND EQUIPMENT
Method of Compliance: ASHRAE 90.1 - Prescriptive
Lighting schedule (each fixture type)
lamp type required in fixture
number of lamps in fixture
ballast type used in the fixture
number of ballasts in fixture
total wattage per fixture
total interior wattage specified vs. allowed (whole building) .56 w/ft (specified)
.96 w/ft (allowed)
total exterior wattage specified vs. allowed (Parking) .04 w/ft (specified)
.06 w/ft (allowed) (ZONE 3)
Additional Efficiency Package Options (When using the 2018 NCEC; not required for ASHRAE 90.1)
C406.2 More Efficient HVAC Equipment Performance
C406.3 Reduced Lighting Power Density
C406.4 Enhanced Digital Lighting Controls
C406.5 On-Site Renewable Energy
C406.6 Dedicated Outdoor Air System
C406.7 Reduced Energy Use in Service Water Heating
Emergency Lighting Drawings: E2.1.1, E2.2.1, E2.3.1, E2.4.1, E2.5.1, E2.6.1, E2.7.1
Fire Alarm Drawings: E2.1.3, E2.2.3, E2.3.3, E2.4.3, E2.5.3, E2.6.3, E2.7.3

MOSELEY ARCHITECTS

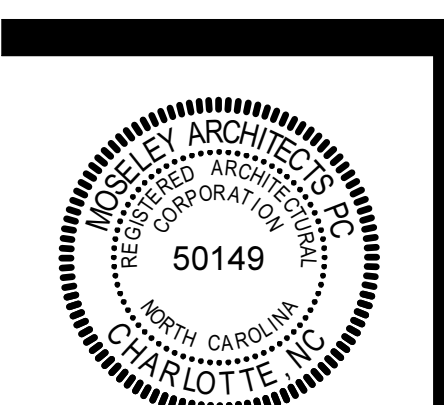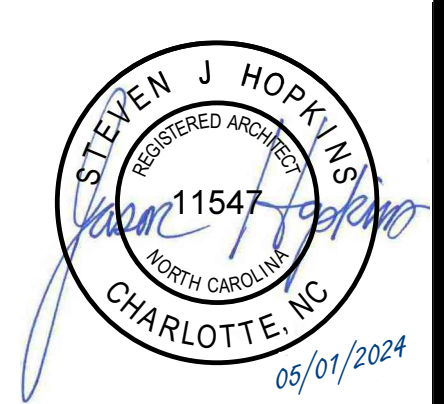


PENDER COUNTY LEG
DHSR# J-368 / FID# 220537
PENDER COUNTY, NORTH CAROLINA
1417 OLD SAVANNAH ROAD BURGAW, NC

PROJECT NO: 611688
DATE: 06/12/24
REVISIONS
DATE DESCRIPTION
06/12/24 AD-03

CODE SUMMARY BUILDING B

LS1.1

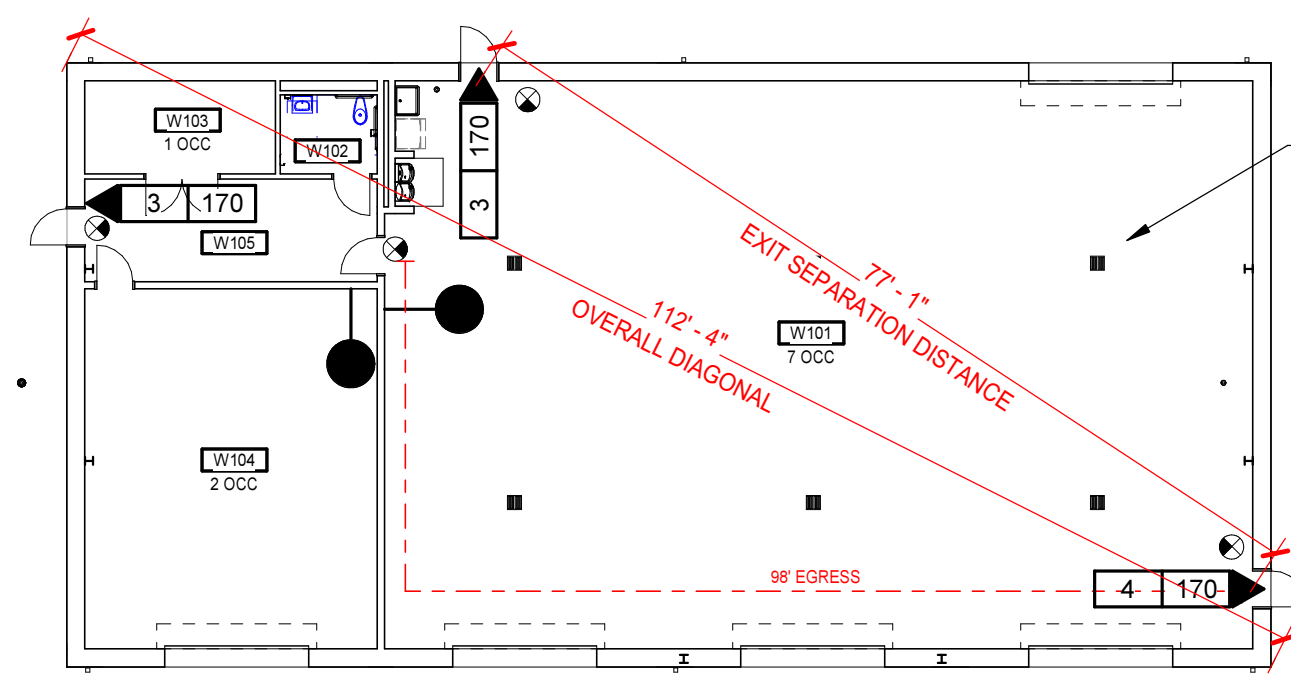

LIFE SAFETY PLAN - WAREHOUSE
1/16" = 1'-0"

LIFE SAFETY GENERAL NOTES

- SEE SHEET LS2.3 FOR LIFE SAFETY SYMBOL LEGEND AND FIRE RATED ASSEMBLIES LEGEND.
- SEE SHEET LS2.3 FOR SMOKE COMPARTMENT KEY PLANS

LIFE SAFETY PLAN KEYNOTES
APPLIES TO DRAWINGS LS2.1 - LS2.n
REPRESENTED BY []

- AUTOMATIC FIRE SHUTTER

GROUP S-2

GROUP B

GROUP I-3

GROUP B

GROUP I-3

BUILDING A
MIXED OCCUPANCY, I-3, B, S-2
CONSTRUCTION TYPE: II-B
FULLY SPRINKLERED, 1 STORY
FLOOR AREA: 21,355 SF
195 OCCUPANTS

SHADED AREA INDICATES REFUGE AREA FOR ADJACENT SMOKE COMPARTMENTS 1 AND 2. REQUIRES 396SF (6SF / INMATE OR STAFF)

SHADED AREA INDICATES REFUGE AREA FOR SMOKE COMPARTMENT 2 AND ADJACENT SMOKE COMPARTMENTS 1 & 4. REQUIRES 1,452SF (6SF / INMATE OR STAFF)

INCIDENTAL SPACE SHALL BE PROTECTED BY A MINIMUM OF A 1HR FIRE BARRIER PER NIOSC SECTION 509.4.1 & TABLE 509

SHADED AREA INDICATES REFUGE AREA FOR SMOKE COMPARTMENT 3 AND ADJACENT SMOKE COMPARTMENT 4. REQUIRES 1,445SF (6SF / INMATE)



SHADED AREA INDICATES REFUGE AREA FOR SMOKE COMPARTMENT 4 AND ADJACENT SMOKE COMPARTMENT 3. REQUIRES 1,445SF (6SF / INMATE)

BUILDING C
B OCCUPANCY
CONSTRUCTION TYPE: II-B
FULLY SPRINKLERED, 1 STORY
FLOOR AREA: 34,560 SF
355 OCCUPANTS


BUILDING B
I-3 OCCUPANCY
CONSTRUCTION TYPE: II-B
FULLY SPRINKLERED, 2 STORY
FIRST FLOOR AREA: 24,800 SF
SECOND FLOOR AREA: 1,918 SF
UPPER CELL TIER AREA: 6,016 SF
244 OCCUPANTS

LIFE SAFETY PLAN - BASE BID
1/16" = 1'-0"

1/16" = 1'-0"

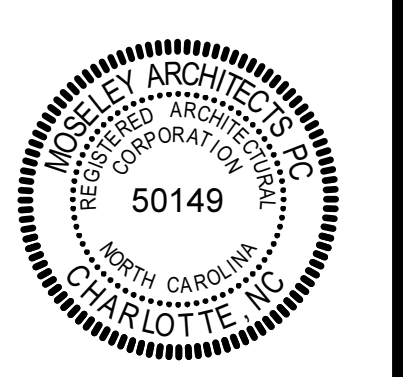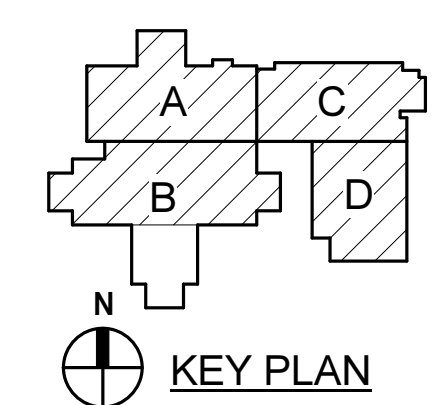

PROJECT NO:	611888
DATE:	06/12/24
REVISIONS:	
DATE:	DESCRIPTION
06/12/24	AD-03

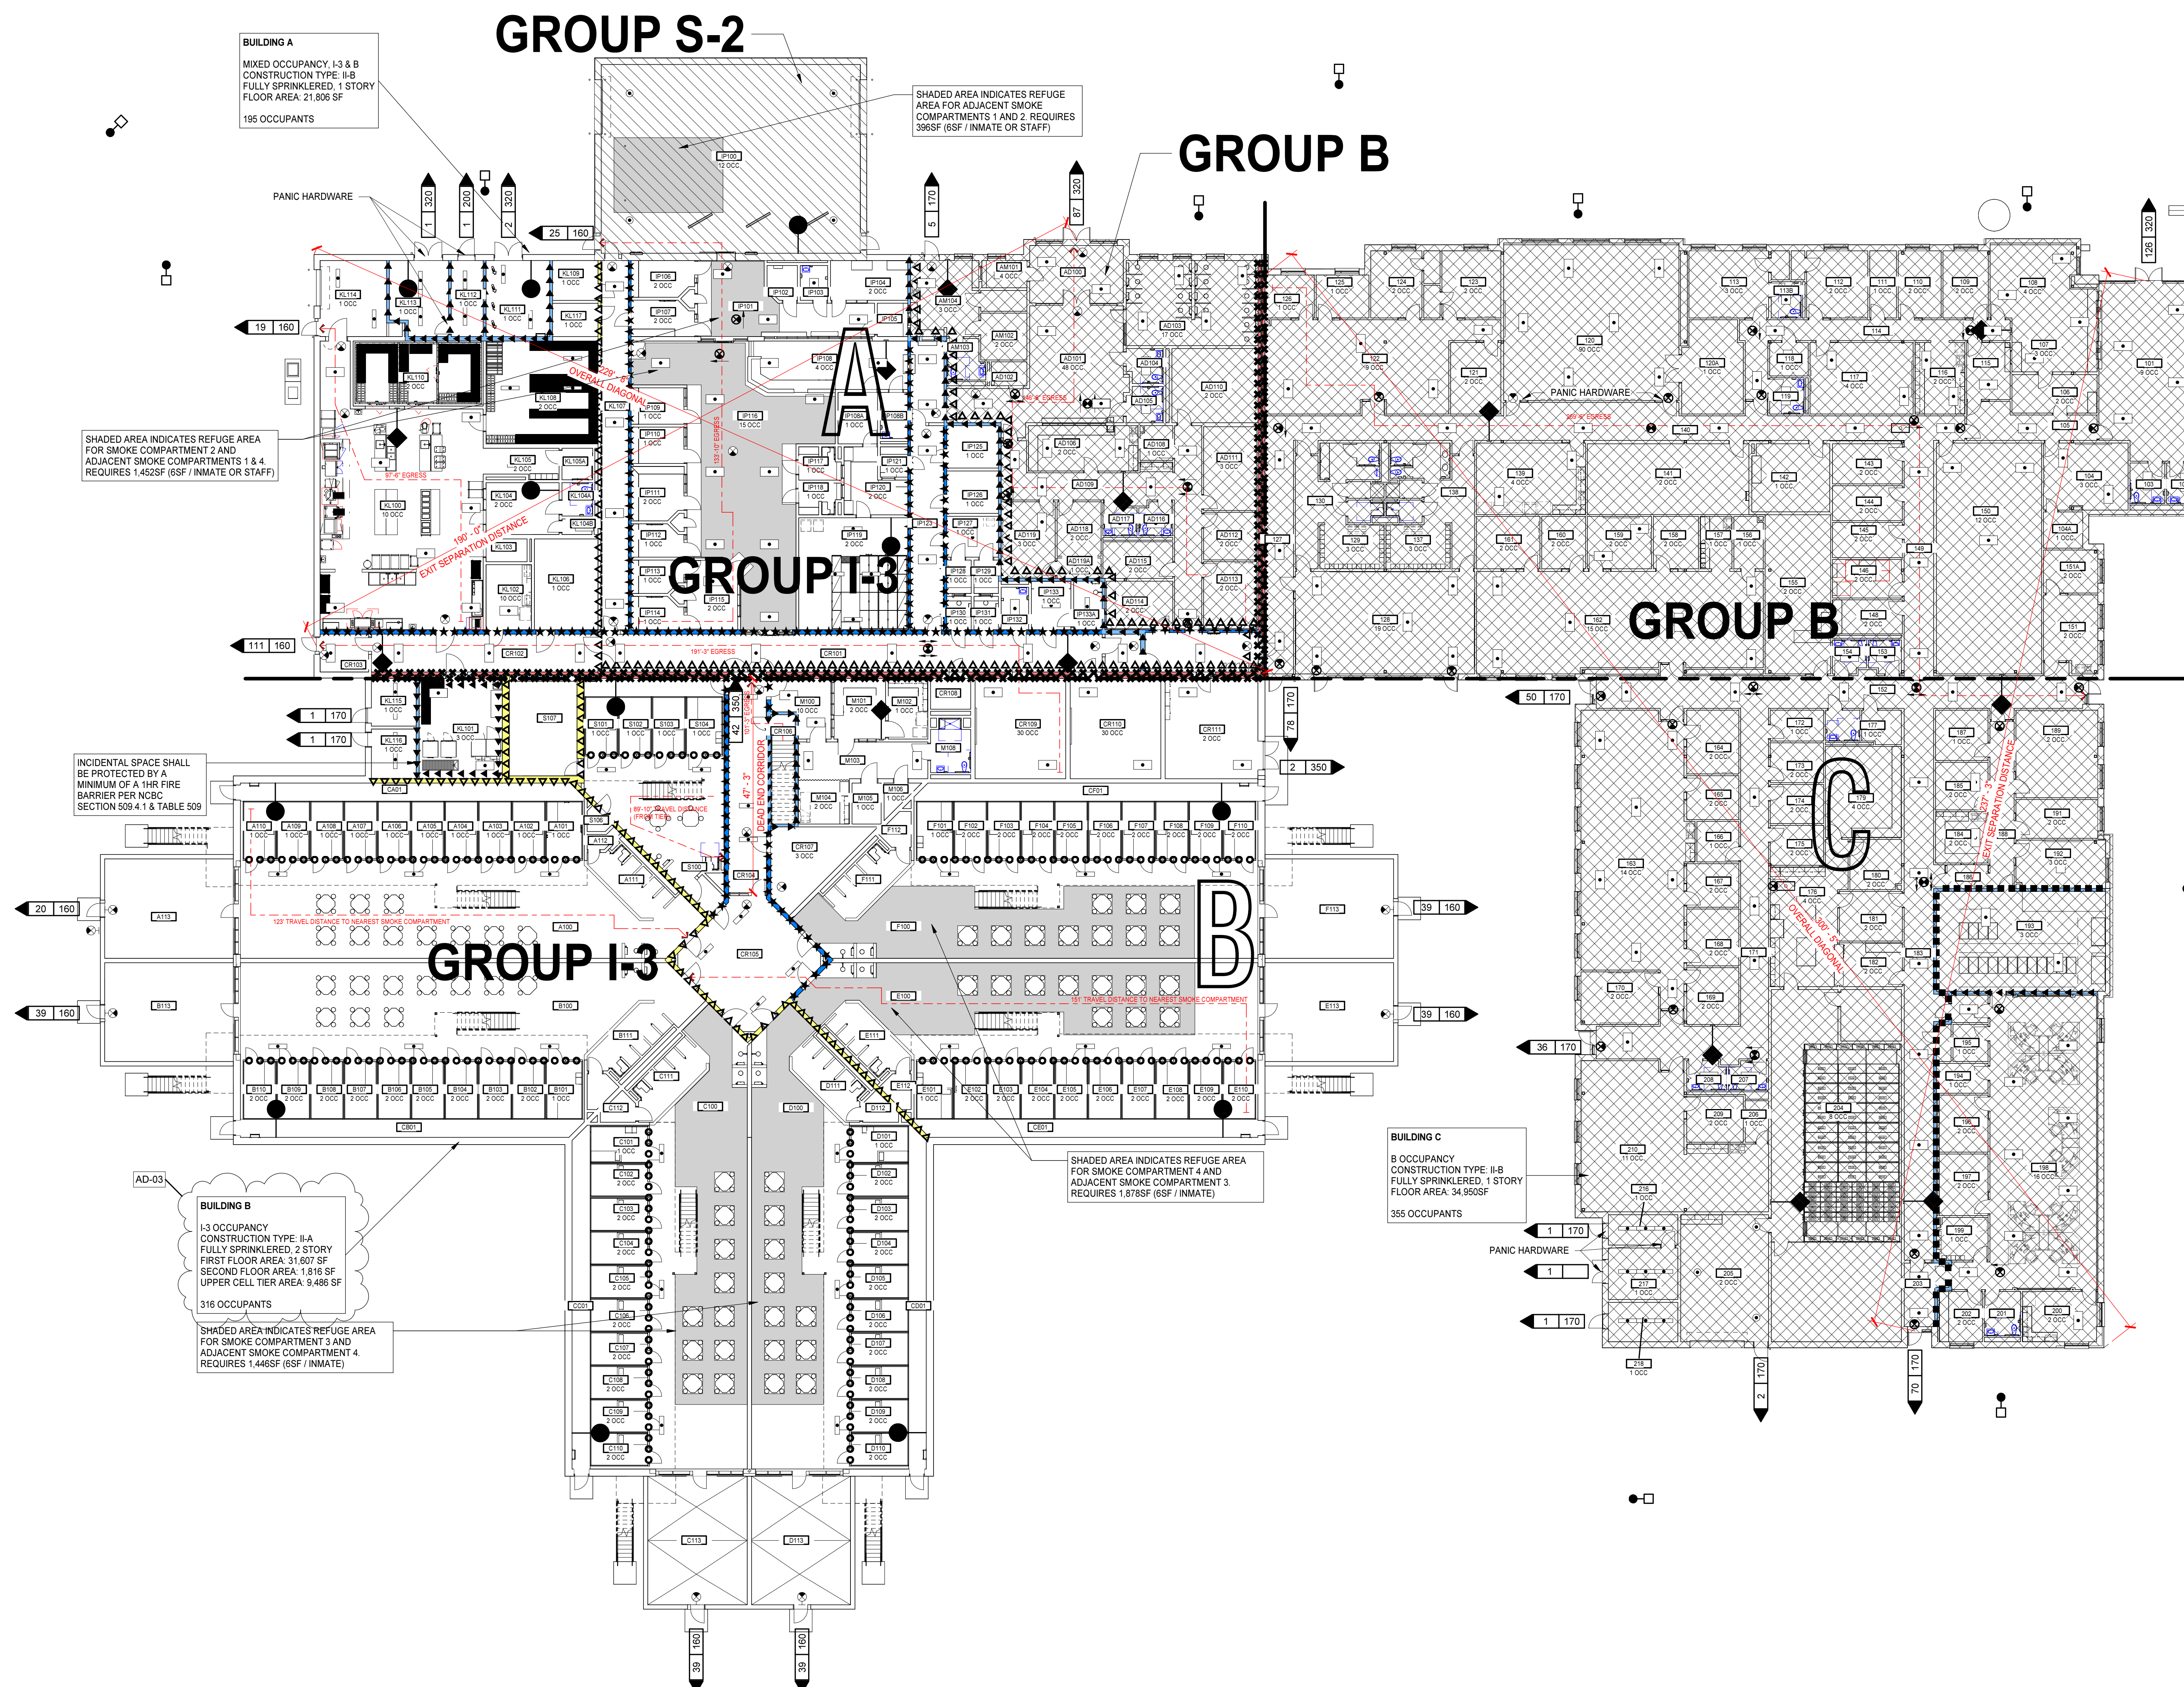

BUILDING A
MIXED OCCUPANCY, I-3 & B
CONSTRUCTION TYPE: II-B
FULLY SPRINKLERED, 1 STORY
FLOOR AREA: 21,806 SF
195 OCCUPANTS

SHADED AREA INDICATES REFUGE
AREA FOR ADJACENT SMOKE
COMPARTMENTS 1 AND 2. REQUIRES
396SF (6SF / INMATE OR STAFF)

SHADED AREA INDICATES REFUGE AREA
FOR SMOKE COMPARTMENT 2 AND
ADJACENT SMOKE COMPARTMENTS 1 & 4.
REQUIRES 1,452SF (6SF / INMATE OR STAFF)

INCIDENTAL SPACE SHALL
BE PROTECTED BY A
MINIMUM OF A 1-HR FIRE
BARRIER PER NBC
SECTION 509.4.1 & TABLE 509



BUILDING B
I-3 OCCUPANCY
CONSTRUCTION TYPE: II-A
FULLY SPRINKLERED, 2 STORY
FIRST FLOOR AREA: 31,607 SF
SECOND FLOOR AREA: 1,816 SF
UPPER CELL TIER AREA: 9,486 SF
316 OCCUPANTS
SHADED AREA INDICATES REFUGE AREA
FOR SMOKE COMPARTMENT 3 AND
ADJACENT SMOKE COMPARTMENT 4.
REQUIRES 1,448SF (6SF / INMATE)

SHADED AREA INDICATES REFUGE AREA
FOR SMOKE COMPARTMENT 4 AND
ADJACENT SMOKE COMPARTMENT 3.
REQUIRES 1,678SF (6SF / INMATE)


BUILDING C
B OCCUPANCY
CONSTRUCTION TYPE: II-B
FULLY SPRINKLERED, 1 STORY
FLOOR AREA: 34,950SF
355 OCCUPANTS

LIFE SAFETY GENERAL NOTES



- SEE SHEET LS2.3 FOR LIFE SAFETY SYMBOL LEGEND AND FIRE RATED ASSEMBLIES LEGEND
- SEE SHEET LS2.3 FOR SMOKE COMPARTMENT KEY PLANS

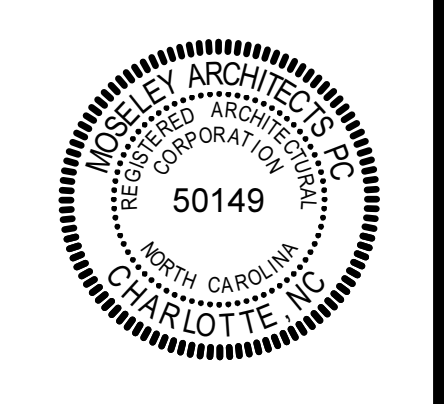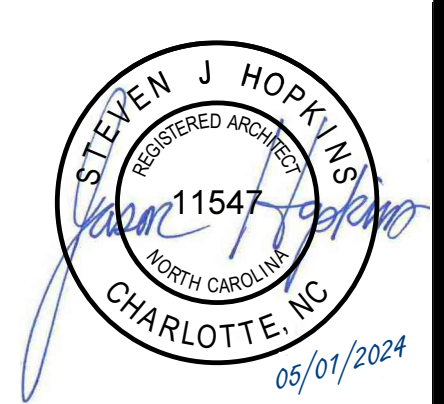


DATE	REVISIONS
06/12/24	AD-03

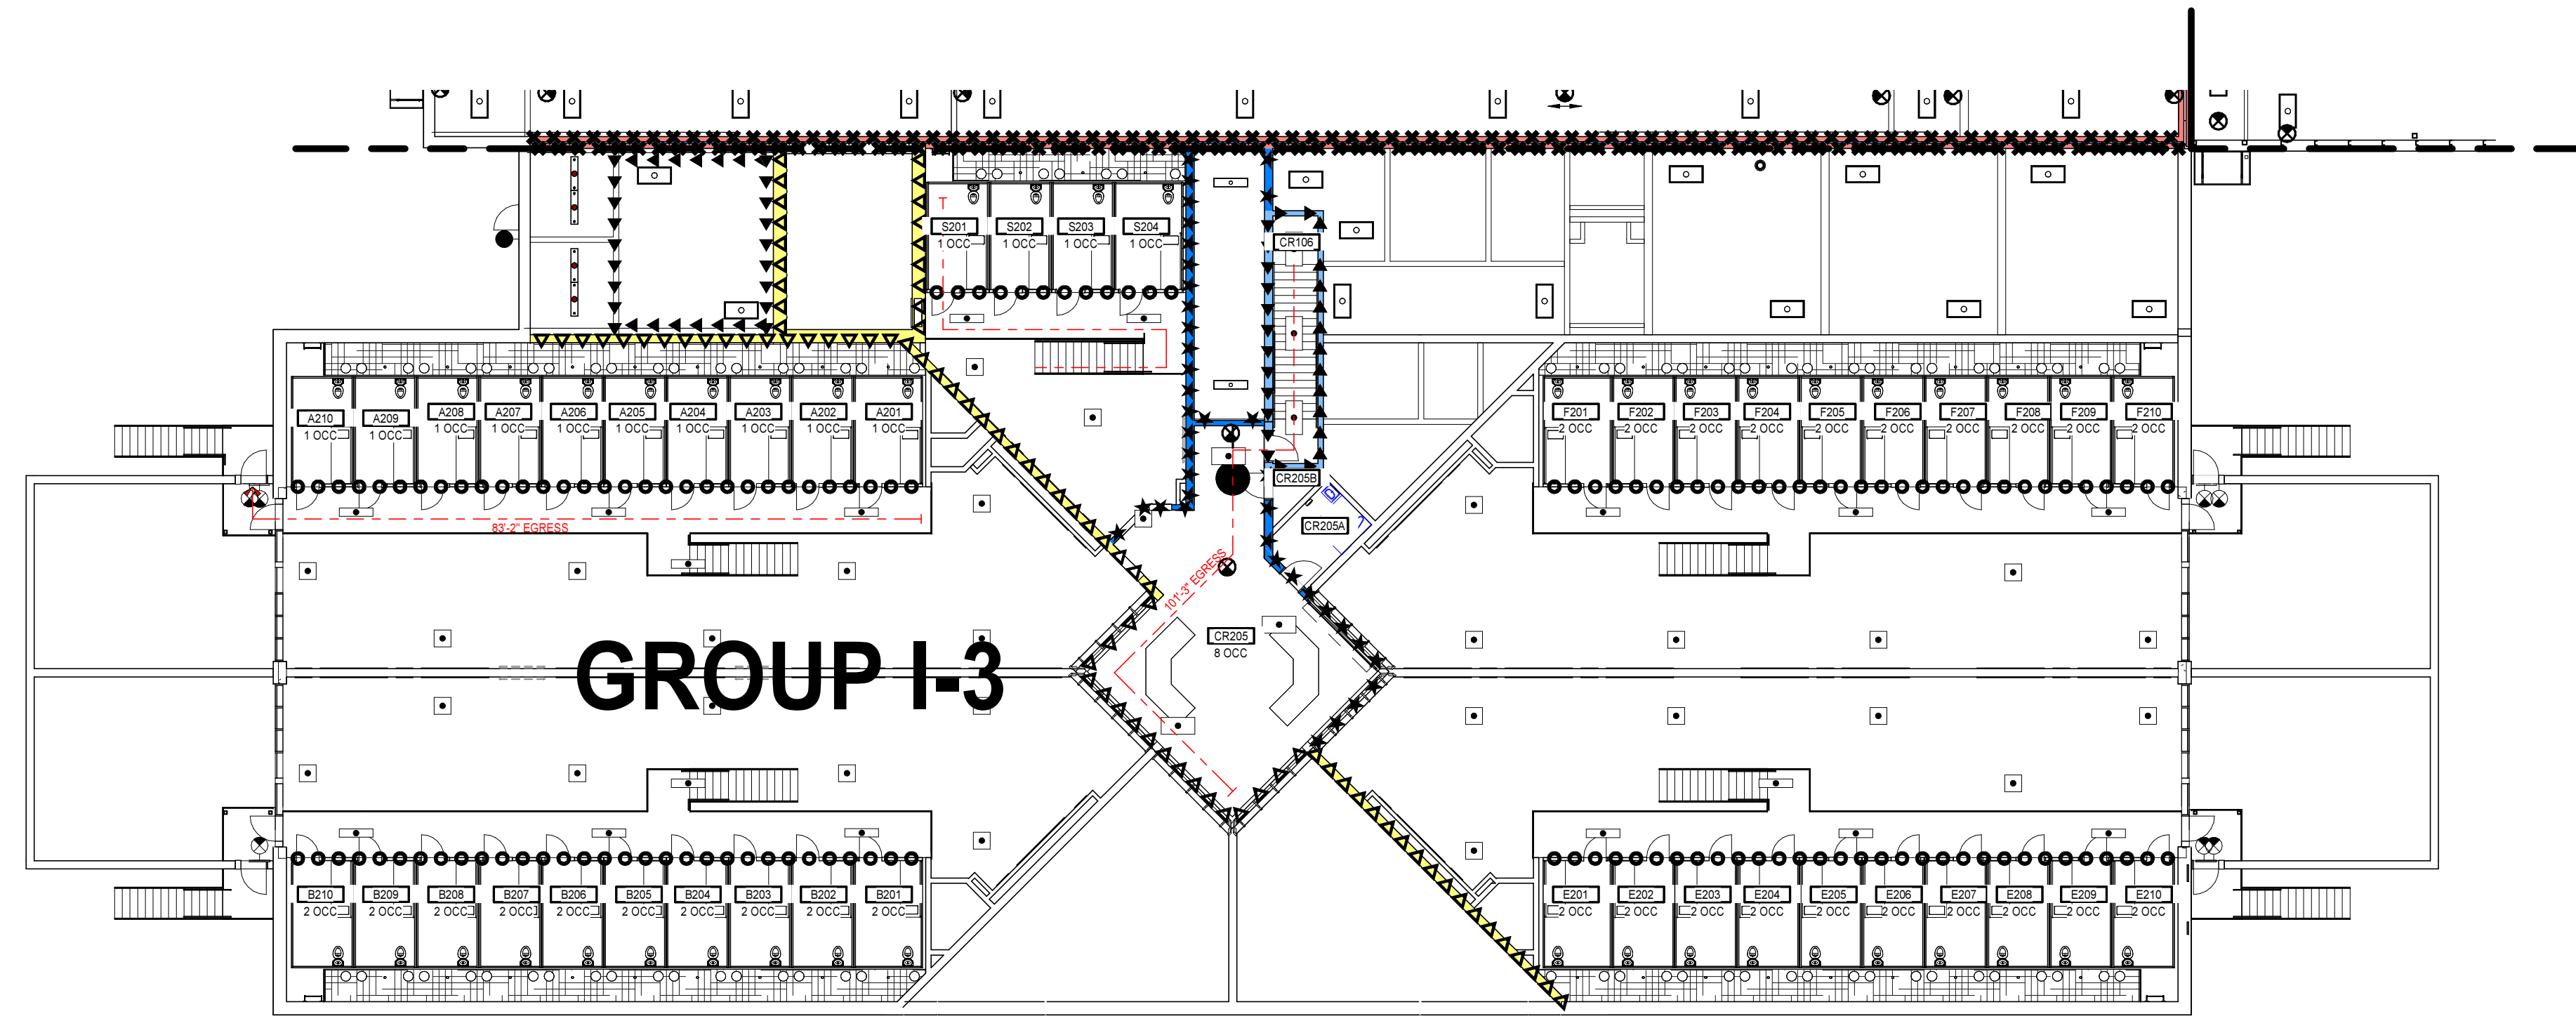

N
LIFE SAFETY FLOOR PLAN - TIER LEVEL - BASE BID
1/16" = 1'-0"

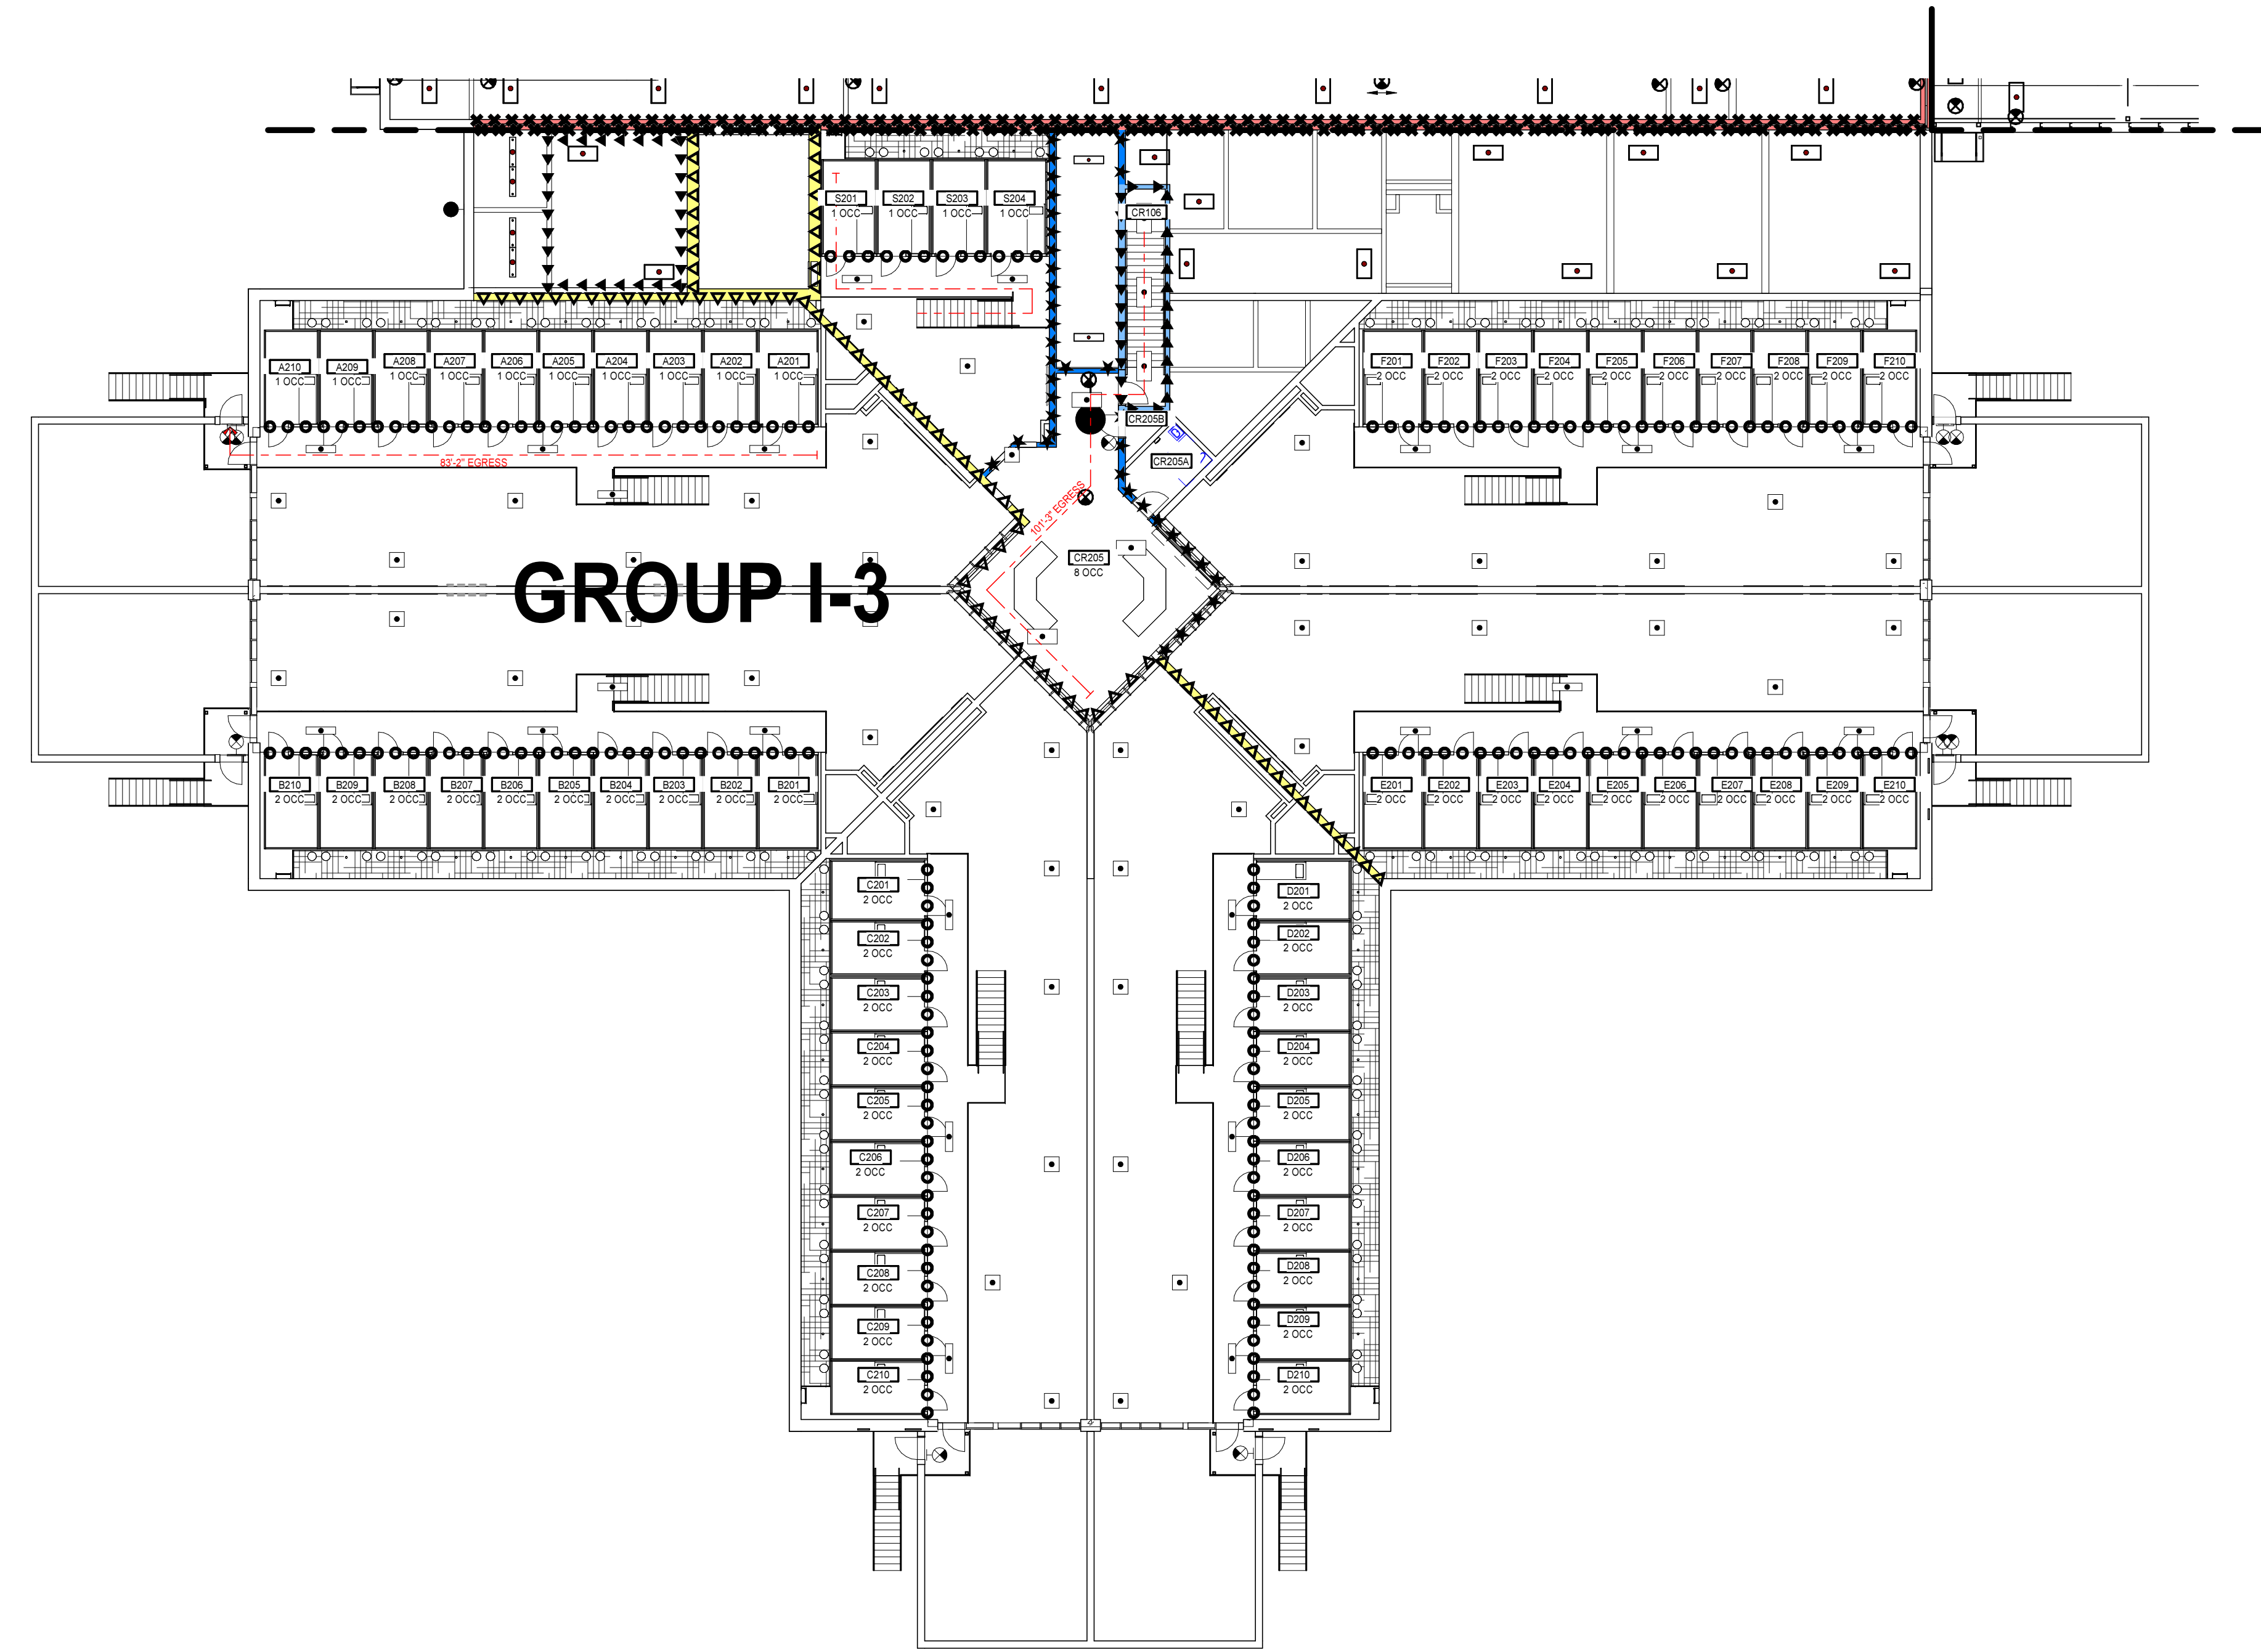
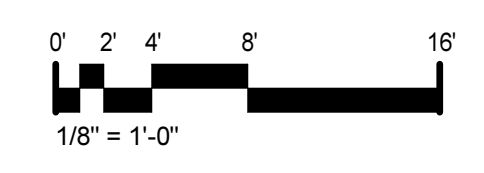


N
LIFE SAFETY FLOOR PLAN - TIER LEVEL - ADD ALTERNATE
1/16" = 1'-0"

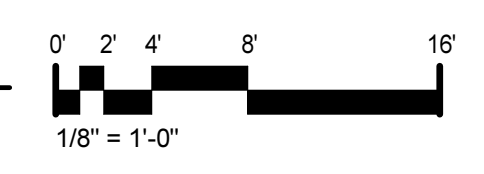


LIFE SAFETY SYMBOL LEGEND					
APPLIES TO LS SERIES OF DRAWINGS ONLY					
DESIGNATOR MATRIX				SYMBOLS	
	WALL	BARRIER	PARTITION		RATED EXT WALL
2 HR FIRE	XXXXXX	■■■■■	■■■■■	■■■■■	1205 ROOM NUMBER 798 1280 DIRECTION OF EGRESS EGRESS LOAD CAPACITY NUMBER OF OCCUPANTS 798 1280 DIRECTION OF EGRESS NUMBER OF OCCUPANTS EGRESS LOAD CAPACITY XXX'-X' MAXIMUM TRAVEL DISTANCE XXX'-X' COMMON PATH OF TRAVEL C/POT FIRE EXTINGUISHER CABINET FIRE EXTINGUISHER BRACKET EXTENT OF SMOKE COMPARTMENT LIGHT FIXTURE ON EMERGENCY POWER, CEILING MOUNT LIGHT FIXTURE ON EMERGENCY POWER, SUSPENDED PENDANT LIGHT FIXTURE ON EMERGENCY POWER, SUSPENDED EXIT SIGNS, REFER TO ELECTRICAL LIGHTING DRAWINGS
1 HR FIRE	■■■■■	■■■■■	■■■■■	■■■■■	
SMOKE	■■■■■	■■■■■	■■■■■	■■■■■	
SMOKE TIGHT	■■■■■	■■■■■	■■■■■	■■■■■	
INCIDENTAL	■■■■■	■■■■■	■■■■■	■■■■■	
RATED WALL COLOR KEY					
SMOKE BARRIER (Yellow) FIRE PARTITION (Blue) FIRE BARRIER (Light Blue) FIRE WALL (Red)					
NOTE: WALL DESIGNATIONS ON THE LS SERIES OF DRAWINGS ARE FOR GRAPHICAL PURPOSES ONLY AND MAY NOT REPRESENT THE ACTUAL WALL/PARTITION CONSTRUCTION. REFER TO THE CONTRACT DOCUMENTS, INCLUDING THE LIFE SAFETY SYMBOLS LEGEND AND A0, A1 AND, A2 SERIES OF DRAWINGS, FOR ACTUAL WALL/PARTITION TYPES AND CONSTRUCTION REQUIREMENTS. 1' = RATING IN HOURS DFW = DOUBLE FIRE WALL NOTE: RATINGS MAY VARY. REFER TO A0.2 FOR ACTUAL RATINGS OF FIRE WALLS COMPOSING THE DOUBLE FIRE WALLS					

FIRE RATED ASSEMBLIES				
REPRESENTED BY (Xn)				
THE ASSEMBLIES REFERENCED ARE BASIS OF DESIGN; EQUIVALENT COMPATIBLE TESTED ASSEMBLIES WILL BE ACCEPTABLE IF APPROVED BY THE LAHJ				
MARK	FIRE RATING	APPLIES TO	REFERENCE	REMARKS
X1	1HR, 2HR	8" & 12" CMU WALLS	U905	--
X2	1HR, 2HR	CMU HEAD OF WALL TERMINATION	HW-D-0030	--
X3	1HR	RATED METAL STUD WALLS	U419	ABOVE CENTRAL CONTROL

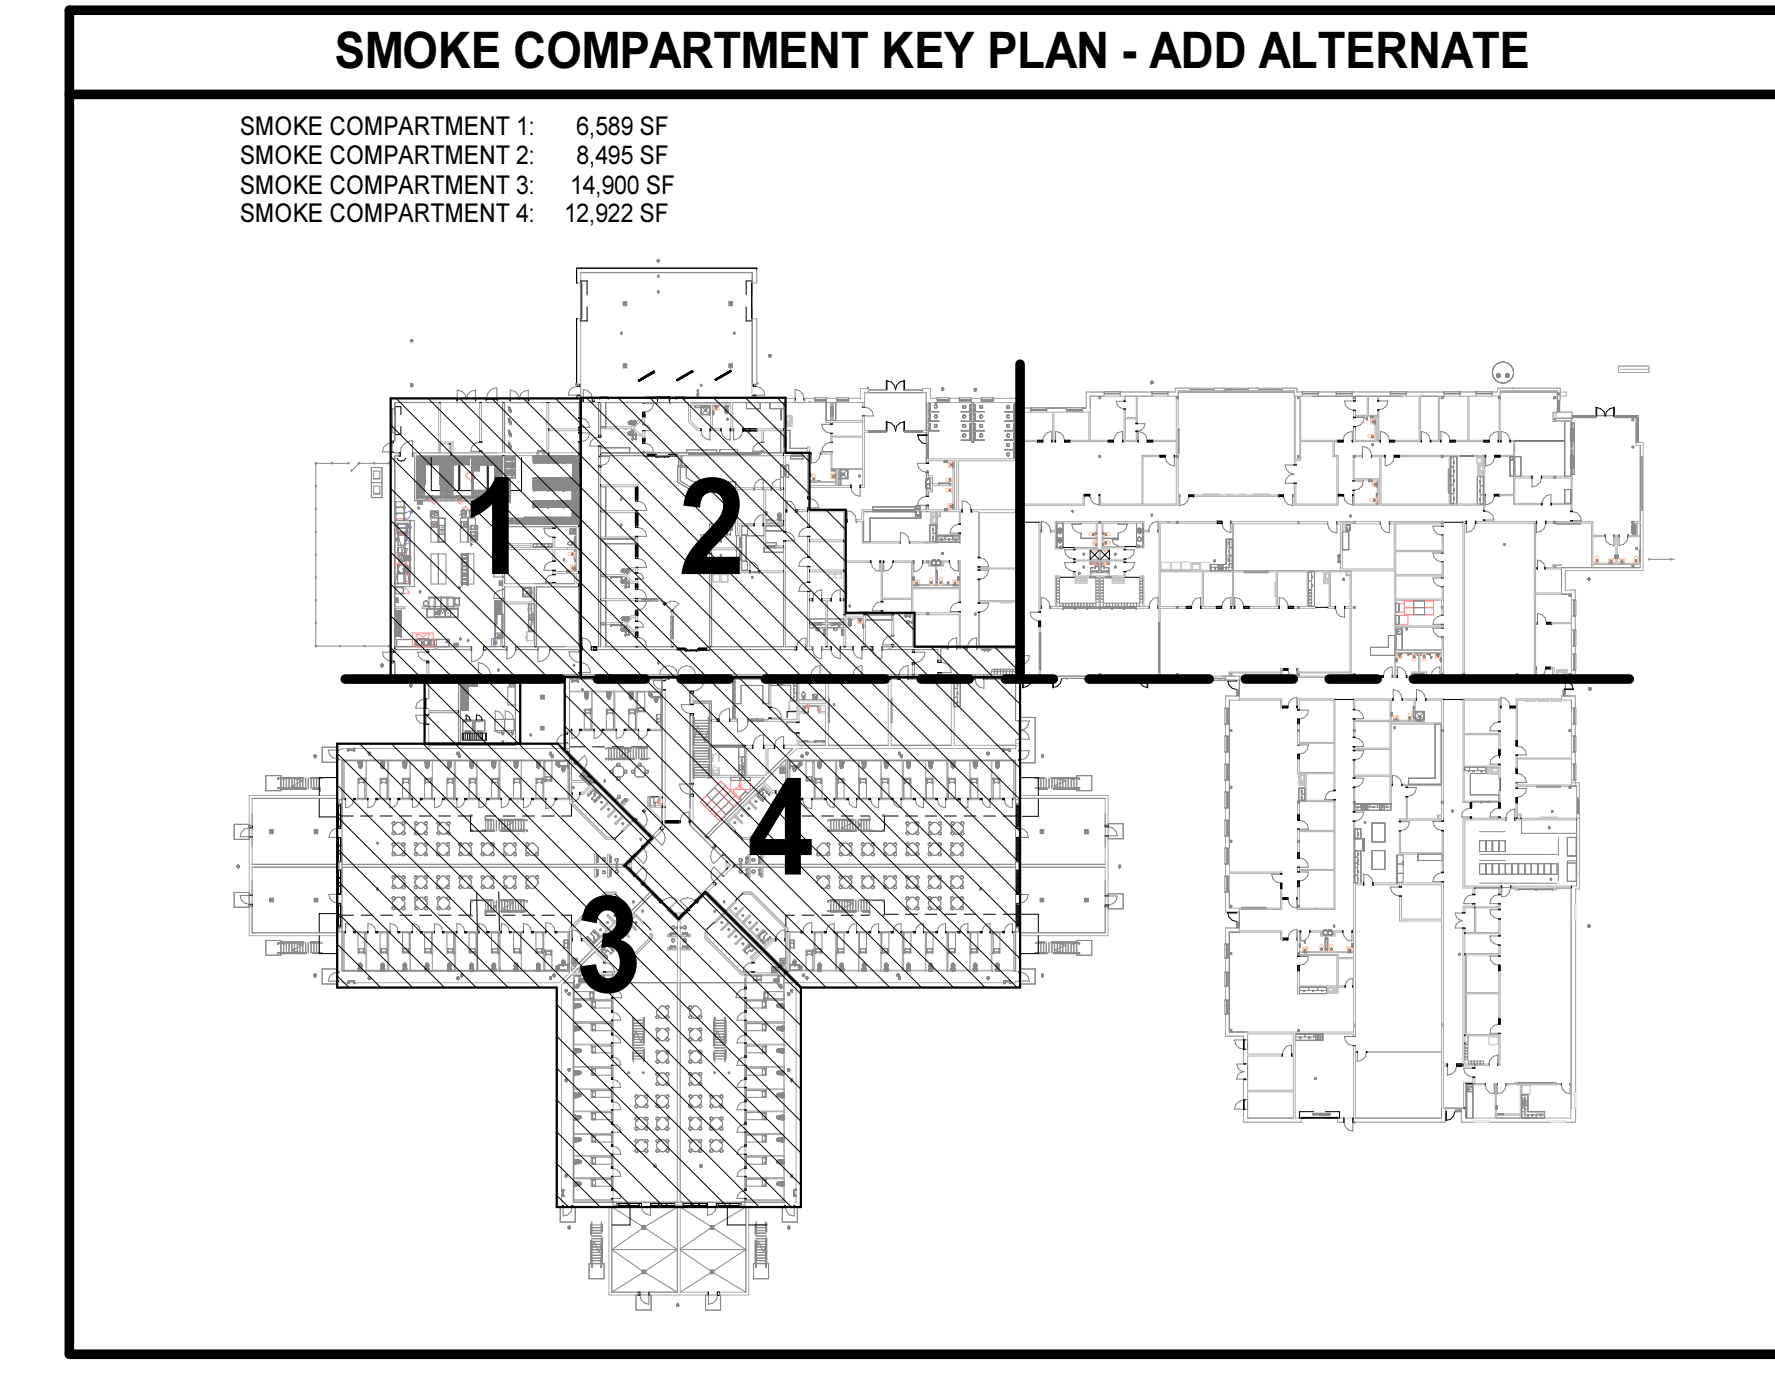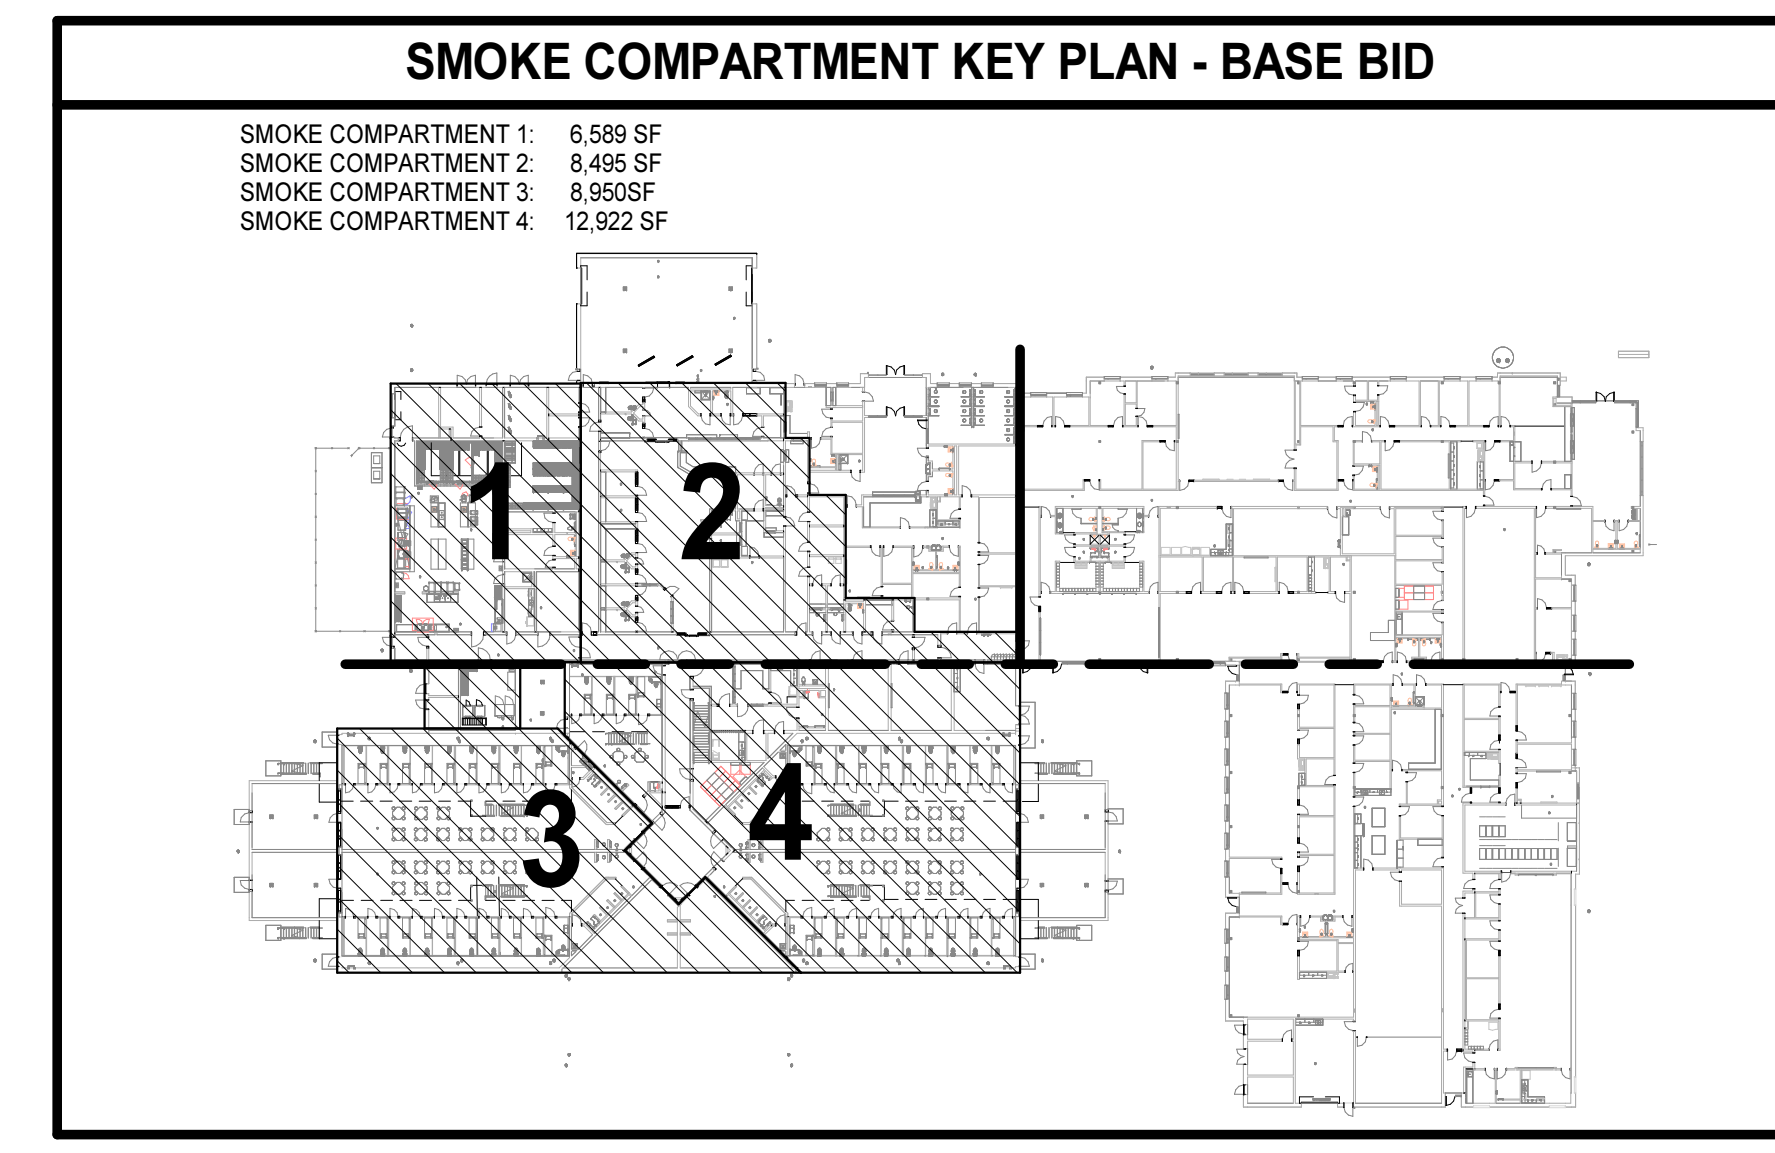

MOSELEYARCHITECTS
 6210 ARDREY KELL ROAD • THE HUB AT WAVERLY, SUITE 425 • CHARLOTTE, NC 28277
 PHONE (704) 545-3755 FAX (704) 545-3754
 MOSELEYARCHITECTS.COM

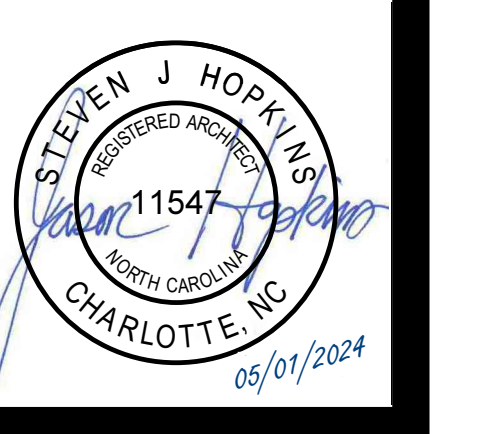

PENDER COUNTY LEC
 DHSR# J-368 / FID# 220537
 PENDER COUNTY, NORTH CAROLINA
 1417 OLD SAVANNAH ROAD BURGAW, NC

PROJECT NO:	611888
DATE:	06/12/24
REVISIONS	
DATE	DESCRIPTION
06/12/24	AD-03

LIFE SAFETY
 INFORMATION - TIER
 LEVEL - BASE BID &
 ADD ALT.

LS2.3


April 14, 2023

Bearing Wall Rating — 2 HR

Nonbearing Wall Rating — 2 HR

This design was evaluated using a load design method other than the Limit States Design Method (e.g., Working Stress Design Method)...

* Indicates such products shall bear the UL or cUL Certification Mark for jurisdictions employing the UL or cUL Certification (such as Canada), respectively.

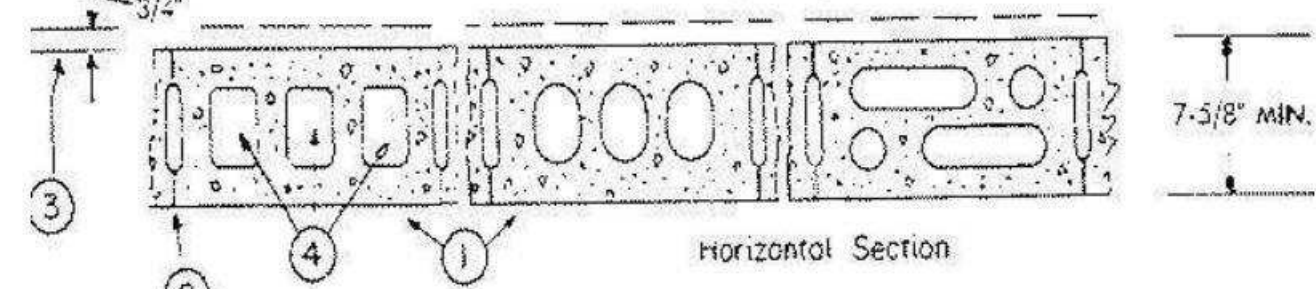

- 1. Concrete Blocks* — Various designs. Classification D-2 (2 hr). See Concrete Blocks category for list of eligible manufacturers.
2. Mortar — Blocks laid in full bed of mortar, nom. 3/8 in. thick...

- 3. Portland Cement Stucco or Gypsum Plaster — Add 1/2 hr to classification if used. Where combustible members are framed in wall, plaster or stucco must be applied on the face opposite framing to achieve a max. Classification of 1-1/2 hr.
4. Loose Masonry Fill — If all core spaces are filled with loose dry expanded slag, expanded dry shale (Rotary Klink Process), water repellent vermiculite masonry fill insulation, or silicone treated perlite loose fill insulation add 2 hr to classification.

- 5. Foamed Plastic* — (Optional-Not Shown) — 1-1/2 in. thick max. 4 ft wide sheathing attached to concrete blocks (Item 1).
ATLAS ROOFING CORP — EnergyShield Pro Wall Insulation, EnergyShield Pro 2 Wall Insulation, EnergyShield CGF Pro, EnergyShield Ply Pro, EnergyShield® CGF, EnergyShield® PanelCast, EnergyShield® and EnergyShield® XR

- DUPONT DE NEMOURS, INC. — Types Thermax Sheathing, Thermax Light Duty Insulation, Thermax Heavy Duty Insulation, Thermax Metal Building Board, Thermax White Finish Insulation, Thermax c Exterior Insulation, Thermax XARMOR c Exterior Insulation, Thermax BI Insulation, Thermax Plus Liner Panel, Thermax Heavy Duty Plus (HDP), TUFF™ c Insulation, Thermax Bulbar Styrofoam Insulation Board and Thermax Morton Heavy Duty Insulation Board
FRESTONE BUILDING PRODUCTS CO L L C — "Evergreen" CI Foil Exterior Wall Insulation and "Evergreen" CI Glass Exterior Wall Insulation

- HUNTER PANELS, A DIVISION OF CARLISLE CONSTRUCTION MATERIALS, LLC — Types "Xci-Class A", "Xci Foil (Class A)", "Xci 286"
RMAX, A BUSINESS UNIT OF SIKA CORPORATION — Types "TSX-8500", "ECOMAXi FR", "TSX-8510", "ECOMAXi FR White", "ECOMAXi", "ECOMAXi FR Air Barrier", "Thermasheath-XP", "Thermasheath", "Durasheath"

- JOHNS MANVILLE — Type "AP Foil-Faced Foam Sheathing"
SA. Building Units* — As an alternate to Items S, min. 1-in thick polyisocyanurate composite foamed plastic insulation boards, nom. 48 by 48 or 96 in.

- ATLAS ROOFING CORP — EnergyShield® Ply
HUNTER PANELS, A DIVISION OF CARLISLE CONSTRUCTION MATERIALS, LLC — "Xci NB", "Xci Ply"
RMAX, A BUSINESS UNIT OF SIKA CORPORATION — "Thermasheath-SF", "ECOBASEc", "Thermabase-CT", "ECOMAXi FR Ply", "ECOMAXi Ry",

* Indicates such products shall bear the UL or cUL Certification Mark for jurisdictions employing the UL or cUL Certification (such as Canada), respectively. Last Updated on 2023-04-14

The appearance of a company's name or product in this database does not in itself assure that products so identified have been manufactured under UL Solutions' Follow-Up Service. Only those products bearing the UL Mark should be considered to be Certified and covered under UL Solutions' Follow-Up Service. Always look for the Mark on the product.

UL Solutions permits the reproduction of the material contained in Product IQ subject to the following conditions: 1. The Guide Information, Assemblies, Constructions, Designs, Systems, and/or Certifications (files) must be presented in their entirety and in a non-misleading manner, without any manipulation of the data (or drawings), 2. The statement "Reprinted from Product IQ with permission from UL Solutions" must appear adjacent to the extracted material. In addition, the reprinted material must include a copyright notice in the following format: "©2024 UL LLC."

System No. HW-D-0030 XHBN.HW-D-0030 Joint Systems

Page Bottom


Design/System/Construction/Assembly Usage Disclaimer
• Authorities Having Jurisdiction should be consulted in all cases as to the particular requirements concerning the installation and use of UL Certified products, equipment, systems, devices, and materials.
• Fire resistance assemblies and products are developed by the design submitter and have been investigated by UL for compliance with applicable requirements. The published information cannot always address every construction nuance encountered in the field.

XHBN - Joint Systems

See General Information for Joint Systems

System No. HW-D-0030 April 22, 2011

Assembly Rating — 2 Hr
L Rating at Ambient — Less than 1 CFM/Lin Ft
L Rating at 400 F — Less than 1 CFM/Lin Ft
Nominal Joint Width — 1 In.
Class II Movement Capabilities — 19% Compression or Extension

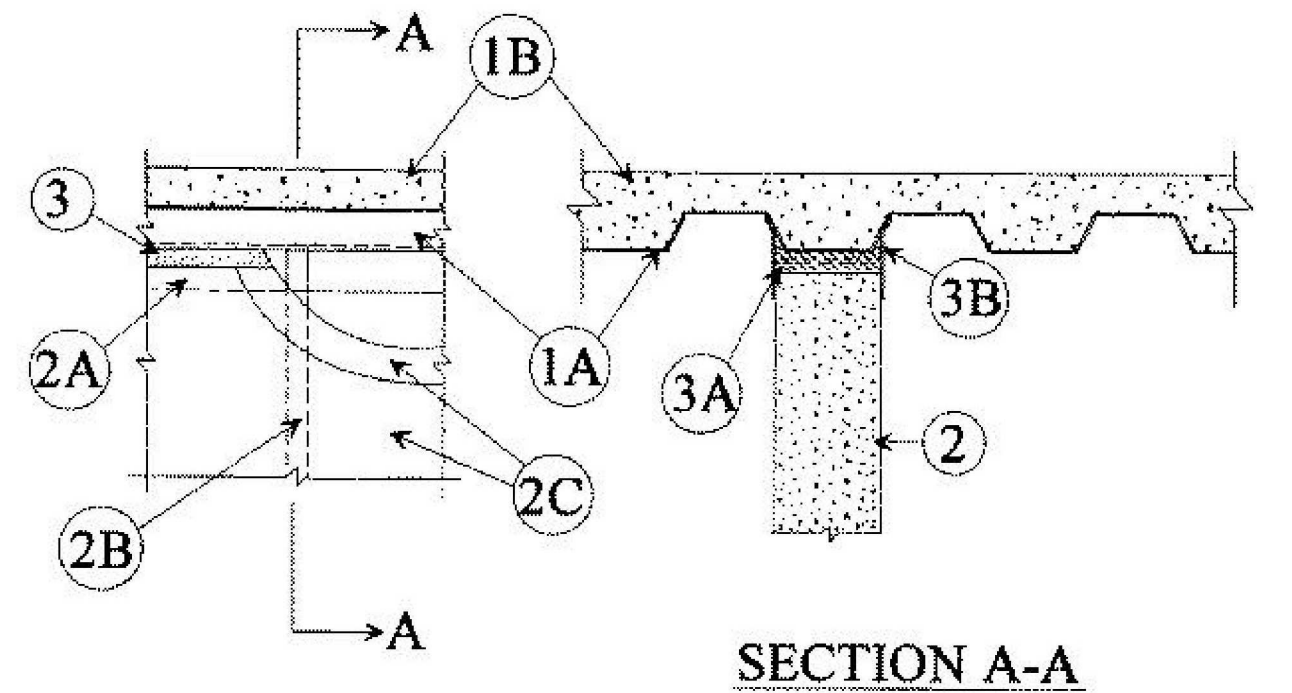

48/2017 XHBN.HW-D-0030 - Joint Systems
1. Floor Assembly — The fire-rated fluted steel deck/concrete floor assembly shall be constructed of the materials and in the manner described in the individual Floor-Ceiling Design in the UL Fire Resistance Directory and shall include the following construction features:

- A. Steel Floor and Form Units* — Max 3 in. (76 mm) deep galv steel fluted floor deck.
A1. Spray Applied Fire Resistive Material* — (Optional, not shown) — Prior to the installation of the Forming Material and Fill, Void or Cavity Materials (Items 3A and 3B), the steel floor units may be sprayed with a min 5/16 in. (8 mm) to max 1 1/16 in. (17 mm) thickness of fire resistive material.
GCP APPLIED TECHNOLOGIES INC — Type MK-6/HY.
B. Concrete — Min 2-1/2 in. (64 mm) thick reinforced concrete, as measured from the top plane of the floor units.

2. Wall Assembly — Min 6-1/8 in. (156 mm) thick steel-reinforced lightweight or normal weight (100-150 pcf or 1600-2400 kg/m³) concrete. Wall may also be constructed of any UL Classified Concrete Blocks*.

See Concrete Blocks (CAET) category in Fire Resistance Directory for names of manufacturers.
3. Joint System — Max separation between bottom of floor or roof and top of wall is 1 in. (25 mm). The joint system is designed to accommodate a max. 19 percent compression or extension from its installed width. The joint system consists of a forming material and a fill material, as follows:

- A. Forming Material* — Min 6-1/2 in. (165 mm) thickness of min 4 pcf (64 kg/m³) density mineral wool batt insulation cut a min of 50 percent wider than the gap between the top of the wall and bottom of the steel floor or roof deck. Mineral wool to be compressed and firmly packed into the gap between the top of the wall and bottom of the steel floor or roof deck.
INDUSTRIAL INSULATION GROUP L L C — MiniWool-1200 Saling
ROCK WOOL MANUFACTURING CO — Delta Board or Delta-B
ROCKWOOL MALAYSIA SDN BHD — Type Safe
ROXUL INC — Type Safe
THERMAFIBER INC — Type SAF
B. Fill, Void or Cavity Material* — Min 1/16 in. (1.6 mm) dry thickness (min 1/8 in. or 3.2 mm wet thickness) of fill material sprayed or brushed on each side of the wall between the top of the wall and bottom of the steel floor or roof deck to completely cover mineral wool and overlap a min of 1/2 in. (13 mm) onto wall and steel floor or roof deck on both sides of wall. When the steel floor or roof deck is coated with spray applied material, the fill material shall overlap min 2 in. (51 mm) onto the spray applied material.
3M COMPANY — FireDam™ Spray 200

48/2017 XHBN.HW-D-0030 - Joint Systems
* Indicates such products shall bear the UL or cUL Certification Mark for jurisdictions employing the UL or cUL Certification (such as Canada), respectively.


Last Updated on 2011-04-22
Questions? Print this page Terms of Use Page Top

© 2017 UL LLC
The appearance of a company's name or product in this database does not in itself assure that products so identified have been manufactured under UL's Follow-Up Service. Only those products bearing the UL Mark should be considered to be Certified and covered under UL's Follow-Up Service. Always look for the Mark on the product.
UL permits the reproduction of the material contained in the Online Certification Directory subject to the following conditions: 1. The Guide Information, Assemblies, Constructions, Designs, Systems, and/or Certifications (files) must be presented in their entirety and in a non-misleading manner, without any manipulation of the data (or drawings), 2. The statement "Reprinted from the Online Certification Directory with permission from UL" must appear adjacent to the extracted material. In addition, the reprinted material must include a copyright notice in the following format: "© 2017 UL LLC."

See General Information for Fire Resistance Ratings - ANSI/UL 263 Certified for United States Design Criteria and Allowable Variations
See General Information for Fire Resistance Ratings - CAN/ULC-S101 Certified for Canada Design Criteria and Allowable Variations

Design No. U419

February 16, 2024
Nonbearing Wall Ratings — 1, 2, 3 or 4 Hr (See Items 4 & 5 through 5J)
* Indicates such products shall bear the UL or cUL Certification Mark for jurisdictions employing the UL or cUL Certification (such as Canada), respectively.

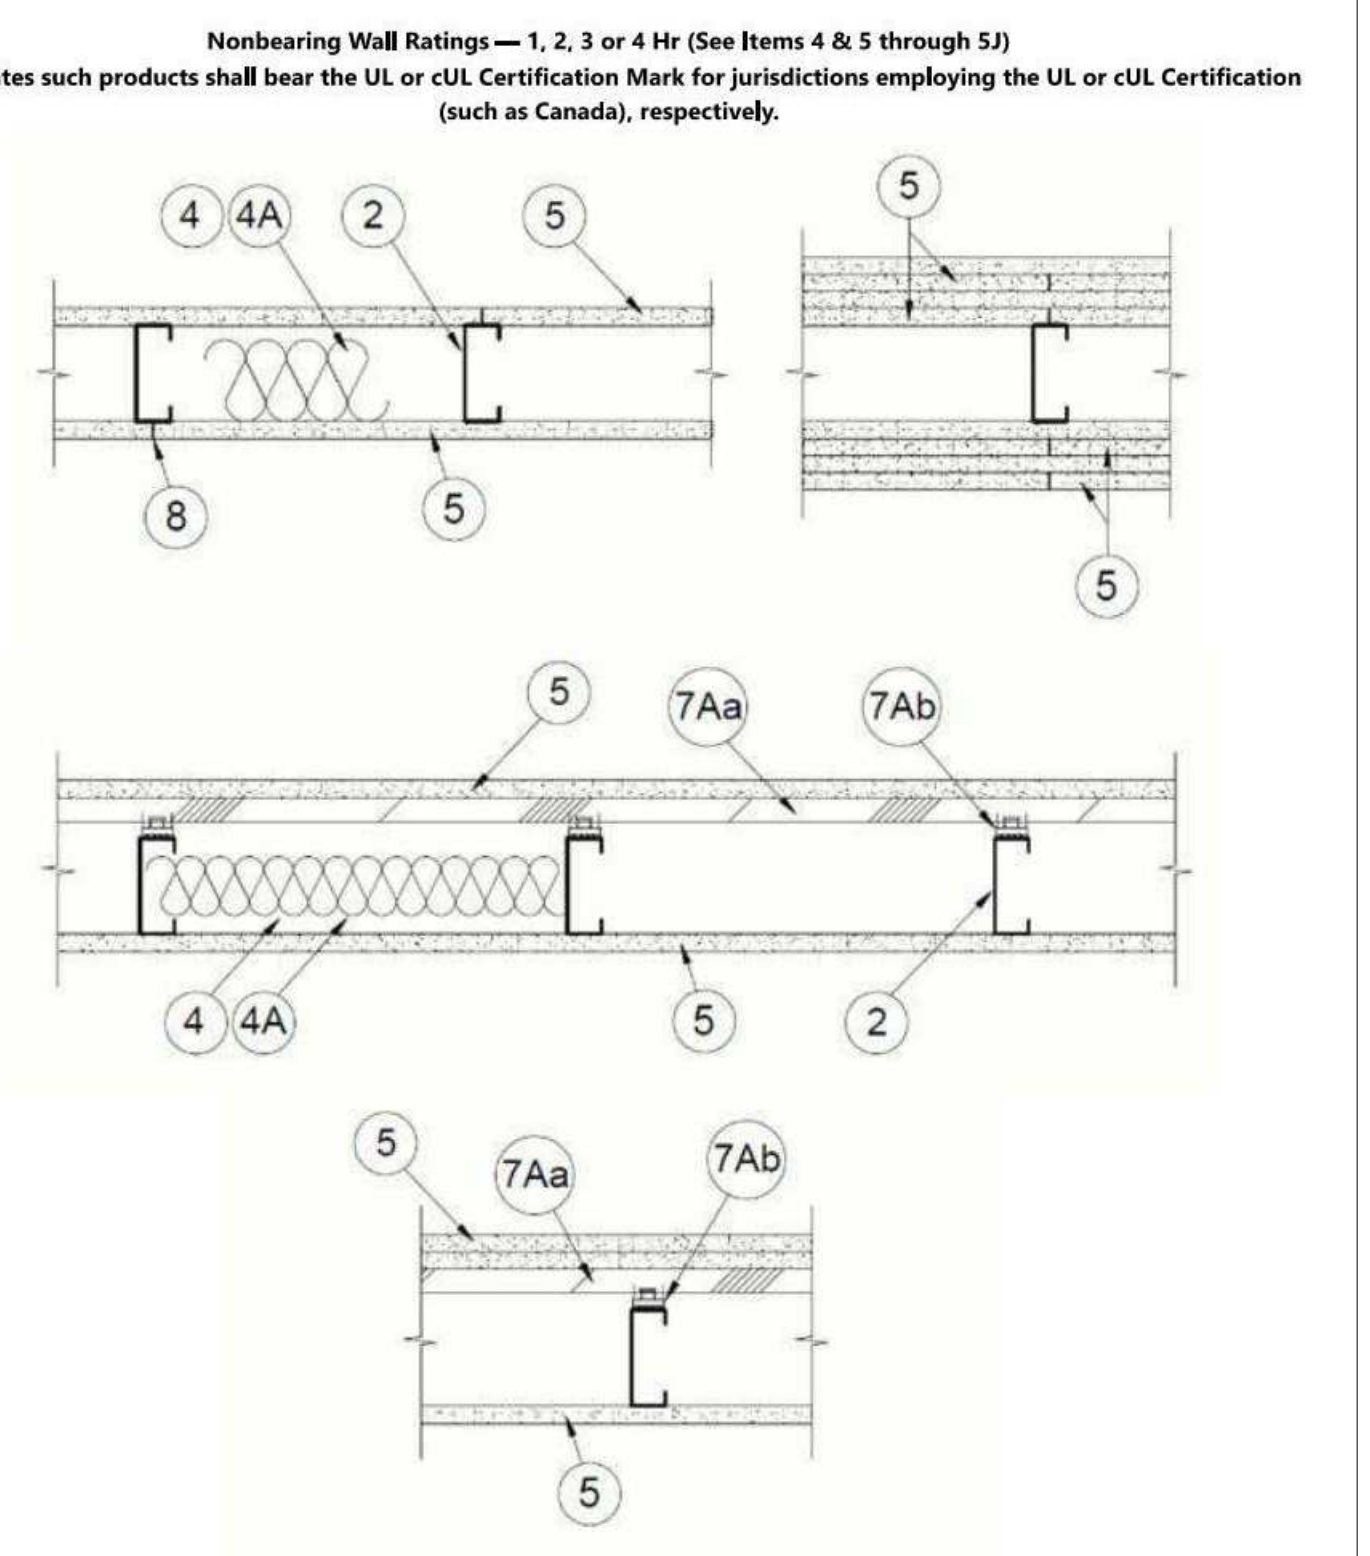

1. Floor and Ceiling Runners — (Not Shown) — For use with Item 2 — Channel shaped, fabricated from min 25 MSG corrosion-protected steel, min depth to accommodate stud size, with min 1-1/4 in. long legs, attached to floor and ceiling with fasteners 24 in. OC max.

1A. Framing Members* — Floor and Ceiling Runner — Not Shown — In lieu of Item 1 — For use with Item 2B, proprietary channel shaped runners, 3-5/8 in. deep attached to floor and ceiling with fasteners 24 in. OC max.
CEMCO, LLC — Viper25™
CRACO MFG INC — SmartStud25™

MARBNO/WARE, DIV OF WARE INDUSTRIES INC — Viper25™ Track
IMPERIAL MANUFACTURING GROUP INC — Viper25™ Track

18. Framing Members* — Floor and Ceiling Runner — Not Shown — In lieu of Item 1 — For use with Item 2C, proprietary channel shaped runners, 1-1/4 in. wide by 3-5/8 in. deep fabricated from min 0.018 in. thick galv steel, attached to floor and ceiling with fasteners spaced 24 in. OC max.
CEMCO, LLC — Viper20™ Track
MARBNO/WARE, DIV OF WARE INDUSTRIES INC — Viper20™ Track
IMPERIAL MANUFACTURING GROUP INC — Viper20™ Track

1C. Framing Members* — Floor and Ceiling Runners — (Not Shown) — In lieu of Item 1 — Channel shaped, attached to floor and ceiling with fasteners 24 in. OC max.
ALLSTEEL & GYPSUM PRODUCTS INC — Type SUPREME D24/30EQD and Type SUPREME D20

CONSOLIDATED FABRICATORS CORP, BUILDING PRODUCTS DIV — Type SUPREME D24/30EQD and Type SUPREME D20
QUAIL RUN BUILDING MATERIALS INC — Type SUPREME D24/30EQD and Type SUPREME D20

SCAFCO STEEL STUD MANUFACTURING CO — Type SUPREME D24/30EQD and Type SUPREME D20
STEEL CONSTRUCTION SYSTEMS INC — Type SUPREME D24/30EQD and Type SUPREME D20
TELLING INDUSTRIES L L C — Type SUPREME D24/30EQD and Type SUPREME D20
UNITED METAL PRODUCTS INC — Type SUPREME D24/30EQD and Type SUPREME D20

1D. Floor and Ceiling Runners — (Not Shown) — For use with Item 2A — Channel shaped, fabricated from min 20 MSG corrosion-protected or galv steel, min depth to accommodate stud size, with min 1 in. long legs, attached to floor and ceiling with fasteners spaced max 24 in. OC.

1E. Framing Members* — Floor and Ceiling Runners — (Not Shown, As an alternate to Item 1) — For use with Items 2E, 5F or 5G or 5I only, channel shaped, fabricated from min. 0.015 in. (min bare metal thickness) galvanized steel, attached to floor and ceiling with fasteners 24 in. OC max.
CLARKDITTRICH BUILDING SYSTEMS — CD ProTRAK

DMFCWBS L L C — ProTRAK
MBA METAL FRAMING — ProTRAK
RAM SALES L L C — Ram ProTRAK
STEEL STRUCTURAL PRODUCTS L L C — Tri-S ProTRAK

1F. Framing Members* — Floor and Ceiling Runner — Not Shown — In lieu of Item 1 — For use with Item 2F, proprietary channel shaped runners, minimum width to accommodate stud size, with 1-1/8 in. long legs fabricated from min 0.015 in. (min bare metal thickness) galv steel, attached to floor and ceiling with fasteners spaced 24 in. OC max.
SUPER STUD BUILDING PRODUCTS — The Edge

1G. Framing Members* — Floor and Ceiling Runner — For use with Item 2G, proprietary channel shaped runners, minimum width to accommodate stud size attached to floor and ceiling with fasteners 24 in. OC max.
STUDDO BUILDING SYSTEMS — CROCKSTUD

1H. Floor and Ceiling Runners — (Not Shown) — Channel shaped, fabricated from min 0.02 in. galv steel, min width to accommodate stud size, with min 1 in. long legs, for use with studs specified below and fabricated from min 0.018 in. galv steel or thicker, attached to floor and ceiling with fasteners spaced max 24 in. OC.
MARBNO/WARE, DIV OF WARE INDUSTRIES INC — Viper20™ Track VT100
IMPERIAL MANUFACTURING GROUP INC — Viper20™ Track VT100

1I. Framing Members* — Floor and Ceiling Runners — (Not Shown, As an alternate to Item 1) — For use with Items 2H, channel shaped, fabricated from min. 0.015 in. (min bare metal thickness) galvanized steel, attached to floor and ceiling with fasteners 24 in. OC max.
TELLING INDUSTRIES L L C — TRUE-TRACK™

1J. Framing Members* — Floor and Ceiling Runner — Not Shown — In lieu of Item 1 — For use with Item 2I, proprietary channel shaped runners, 3-5/8 in. deep attached to floor and ceiling with fasteners 24 in. OC max.

3/8/24, 11:23 AM
1K. Framing Members* — Floor and Ceiling Runner — Not Shown — In lieu of Item 1 — For use with Item 2J, proprietary channel shaped runners, 1-1/4 in. wide by min. 3-1/2 in. deep fabricated from min 0.018 in. thick galv steel, attached to floor and ceiling with fasteners spaced 24 in. OC max.

1L. Framing Members* — Floor and Ceiling Runner — Not Shown — In lieu of Item 1 — For use with Item 2N, proprietary channel shaped runners, 1-1/4 in. wide by min. 3-1/2 in. deep fabricated from min 0.018 in. thick galv steel, attached to floor and ceiling with fasteners spaced 24 in. OC max.
RESCUE METAL FRAMING, L L C — AlphaTRAK

1M. Framing Members* — Floor and Ceiling Runners — Not Shown — As an alternate to Item 1 — For use with Item 2O, proprietary channel shaped runners, min width to accommodate stud size, galv steel, attached to floor and ceiling with fasteners spaced 24 in. OC max.
RONDO BUILDING SERVICES PTY LTD — Rondos Wall Track

1N. Framing Members* — Floor and Ceiling Runners — Not Shown — As an alternate to Item 1 — For use with Item 2P, proprietary channel shaped runners, min width to accommodate stud size, galv steel, attached to floor and ceiling with fasteners spaced 24 in. OC max.
OEG BUILDING MATERIALS — OEG Track

1O. Framing Members* — Floor and Ceiling Runner — Not Shown — In lieu of Item 1 — For use with Item 2Q, proprietary channel shaped runners, min width to accommodate stud size, fabricated from min. 25 MSG (0.018 in. min. bare metal thickness), attached to floor and ceiling with fasteners spaced 24 in. OC max.
CEMCO, LLC — Viper X Track

1P. Framing Members* — Floor and Ceiling Runner — (Not Shown — Alternate to Item 1) — For use with Item 2R, channel shaped runners pre-equipped with proprietary attachment flaps. Min. 3-5/8 in. wide. Legs of top runners minimum 3-1/4 in. wide. Legs of bottom runners minimum 1-1/2 in. wide. Runners attached to floor and ceiling with fasteners 24 in. OC max.

HYPERFRAME INC — Hypertrack

1Q. Framing Members* — Floor and Ceiling Runner — Not Shown — In lieu of Item 1 — For use with Item 2S, proprietary channel shaped runners, min width to accommodate stud size, fabricated from min. 20 EQ/22 mils. (min. 0.0221 in. thick) galvanized steel, attached to floor and ceiling with fasteners spaced 24 in. OC max.
JIC INTERNATIONAL DISTRIBUTORS — Non-structural Tracks 3-5/8" and 6".

2. Steel Studs — Channel shaped, fabricated from min 25 MSG corrosion-protected steel, min depth as indicated under Item 5, spaced a max of 24 in. OC. Studs to be cut 3/8 to 3/4 in. less than assembly height.

2A. Steel Studs — (As an alternate to Item 2, For use with Items 5B, 5E, 5H, 5J or Type ULX) — Channel shaped, fabricated from min 20 MSG corrosion-protected or galv steel, 3-1/2 in. min depth, spaced a max of 16 in. OC. Studs friction-fit into floor and ceiling runners. Studs to be cut 5/8 to 3/4 in. less than assembly height.

2B. Framing Members* - Steel Studs — (As an alternate to Item 2, For use with Items 5C, 5I or Type ULX) — Proprietary channel shaped studs, 3-5/8 in. deep spaced a max of 24 in. OC. Studs to be cut 3/4 in. less than the assembly height and installed with a 1/2 in. gap between the end of the stud and track at the bottom of the wall. For direct attachment of gypsum board only.
CEMCO, LLC — Viper25™
CRACO MFG INC — SmartStud25™

3/8/24, 11:23 AM
MARBNO/WARE, DIV OF WARE INDUSTRIES INC — Viper25™
IMPERIAL MANUFACTURING GROUP INC — Viper25™

2C. Framing Members* — Steel Studs — Not Shown — In lieu of Item 2 — Proprietary channel shaped steel studs, min depth as indicated under Item 5, spaced a max of 24 in. OC. Studs to be cut 3/8 in. to 3/4 in. less in lengths than assembly heights.
CEMCO, LLC — Viper20™
MARBNO/WARE, DIV OF WARE INDUSTRIES INC — Viper20™
IMPERIAL MANUFACTURING GROUP INC — Viper20™

2D. Framing Members* — Steel Studs — In lieu of Item 2 — Channel shaped studs, min depth as indicated under Item 5, spaced a max of 24 in. OC. Studs to be cut 3/4 in. less than assembly height.
ALLSTEEL & GYPSUM PRODUCTS INC — Type SUPREME D24/30EQD and Type SUPREME D20
CONSOLIDATED FABRICATORS CORP, BUILDING PRODUCTS DIV — Type SUPREME D24/30EQD and Type SUPREME D20
QUAIL RUN BUILDING MATERIALS INC — Type SUPREME D24/30EQD and Type SUPREME D20
SCAFCO STEEL STUD MANUFACTURING CO — Type SUPREME D24/30EQD and Type SUPREME D20

STEEL CONSTRUCTION SYSTEMS INC — Type SUPREME D24/30EQD and Type SUPREME D20
TELLING INDUSTRIES L L C — Type SUPREME D24/30EQD and Type SUPREME D20
UNITED METAL PRODUCTS INC — Type SUPREME D24/30EQD and Type SUPREME D20

2E. Framing Members* — Steel Studs — (Not Shown, As an alternate to Item 2) — For use with Items 5F or 5G or 5I or Type ULX only, channel shaped studs, min depth as indicated under Item 5F, 5G or 5I, fabricated from min. 0.015 in. (min bare metal thickness) galvanized steel, spaced a max of 24 in. OC. Studs to be cut 3/4 in. less than assembly height.
CLARKDITTRICH BUILDING SYSTEMS — CD ProSTUD
DMFCWBS L L C — ProSTUD

MBA METAL FRAMING — ProSTUD
RAM SALES L L C — Ram ProSTUD
STEEL STRUCTURAL PRODUCTS L L C — Tri-S ProSTUD


2F. Framing Members* — Steel Studs — Not Shown — In lieu of Item 2 — Proprietary channel shaped steel studs, minimum width indicated under Item 5, 1-1/4 in. deep fabricated from min 0.015 in. (min bare metal thickness) galvanized steel. Studs 3/8 in. to 3/4 in. less in lengths than assembly heights.
SUPER STUD BUILDING PRODUCTS — The Edge

2G. Framing Members* — Steel Studs — Not Shown — In lieu of Item 2 — Proprietary channel shaped studs, minimum width indicated under Item 5, Studs to be cut 3/8 to 3/4 in. less than the assembly height.
STUDDO BUILDING SYSTEMS — CROCKSTUD

2H. Framing Members* — Steel Studs — (Not Shown, As an alternate to Item 2) — Fabricated from min. 0.015 in. (min bare metal thickness) galvanized steel, spaced a max of 24 in. OC. Studs to be cut 3/4 in. less than assembly height.
TELLING INDUSTRIES L L C — TRUE-STUD™

https://iq.ulsolutions.com/en/join/76=14879 5/4

MOSELEY ARCHITECTS
6210 ARDREY KELL ROAD - THE HUB AT WAWERLY, SUITE 425 - CHARLOTTE, NC 28277
PHONE (704) 540-3755 FAX (704) 540-3754
MOSELEYARCHITECTS.COM

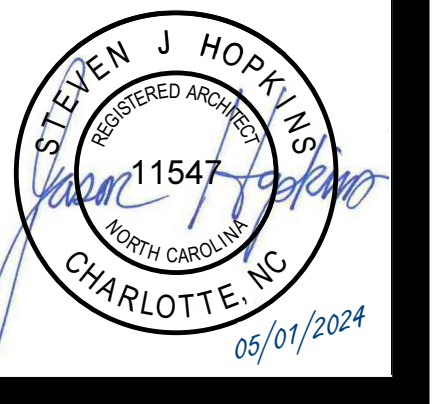

PENDER COUNTY LEC
DHSR# J-368 / FID# 220537
PENDER COUNTY, NORTH CAROLINA
1417 OLD SAVANNAH ROAD BURGAW, NC

Table with 2 columns: DATE, REVISIONS. Includes PROJECT NO: 611888, DATE: 05/01/2024.

Table with 2 columns: DATE, DESCRIPTION. Includes PROJECT NO: 611888, DATE: 05/01/2024.

FIRE RESISTIVE ASSEMBLIES

LS4.1

6/7/2024 2:18:38 PM



2J. Framing Members* — Steel Studs —

2J. Framing Members* — Metal Studs — Not Shown — In lieu of Item 2 — proprietary channel shaped steel studs, min depth as indicated under Item 5, spaced a max of 24 in. OC, fabricated from min 0.018 in. thick galv steel. Studs cut 3/8 in. to 3/4 in. less in lengths than assembly heights

2K. Framing Members* — Steel Studs — As an alternate to Item 2 — For use with Item 1, channel shaped studs, fabricated from min 25 MSG corrosion-protected steel, min depth as indicated under Item 5, spaced a max of 24 in. OC. Studs to be cut 3/8 to 3/4 in. less than assembly height. EB METAL INC — NITROSTUD

2L. Framing Members* — Steel Studs — As an alternate to Item 2 — For use with Item 1, channel shaped studs, fabricated from min 25 MSG corrosion-protected steel, min depth as indicated under Item 5, spaced a max of 24 in. OC. Studs to be cut 3/8 to 3/4 in. less than assembly height. OLMAR SUPPLY INC — PRIMESTUD

2M. Framing Members* — Steel Studs — As an alternate to Item 2 — For use with Item 1, channel shaped studs, fabricated from min 25 MSG corrosion-protected steel, min depth as indicated under Item 5, spaced a max of 24 in. OC. Studs to be cut 3/8 to 3/4 in. less than assembly height. MARINO/WARE, DIV OF WARE INDUSTRIES INC — StudRite™

2N. Framing Members* — Steel Studs — As an alternate to Item 2 — proprietary channel shaped steel studs, min depth 3-1/2 in, and as indicated under Item 5, spaced a max of 24 in. OC, fabricated from min 0.018 in. thick galv steel. Studs cut 3/8 in. to 3/4 in. less in lengths than assembly height. RESCUE METAL FRAMING, L L C — AlphaSTUD

2O. Framing Members* — Steel Studs — As an alternate to Item 2 — proprietary channel shaped steel studs, min width as indicated under Item 5, galv steel. Studs to be cut 3/8 to 3/4 in. less in lengths than assembly height. Spaced 24 in. OC max. RONDO BUILDING SERVICES PVT LTD — Rondo Lipped Wall Stud

2P. Framing Members* — Steel Studs — As an alternate to Item 2 — proprietary channel shaped steel studs, min width as indicated under Item 5, min 25 MSG galv steel. Studs to be cut 3/8 to 3/4 in. less in lengths than assembly height. Spaced 24 in. OC max. OEG BUILDING MATERIALS — OEG Stud

2Q. Framing Members* — Steel Studs — Not Shown — In lieu of Item 2 — For use with Item 10, proprietary channel shaped steel studs, min depth as indicated under Item 5, spaced a max of 24 in. OC, fabricated from min 25 MSG (0.018 in. min. bare metal thickness). Studs cut 3/8 in. to 3/4 in. less in lengths than assembly heights. CEMCO, LLC — Viper X

2R. Framing Members* — Steel Studs — (Not Shown) — Alternate to Item 2, For use with Item 1P) — Channel shaped steel studs with attachment clips at top and bottom, min 3-5/8 in. depth, spaced a max of 24 in. OC. Studs clipped into floor and ceiling runners (Item 1P). Max 2-3/8 in. extension reveal from top stud to inside of ceiling runner. HYPERFRAME INC — Hyperstud

Table with columns: Rating, Hr, Min Stud Depth, In., Item 2E, No. of Layers & Thickness of Panel, Min Thins of Insulation (Item 4)

* This thickness applies when optional Item 12 or 13 are used over 3-1/4 in. light weight concrete topping. ** This thickness applies when optional Item 12 or 13 are used over 3-1/4 in. light weight concrete topping.

When bottom chords consist of 1 by 1 by 0.125 in. thick steel angles, the thickness of spray-applied fire resistive material shall be increased by 1/4 in. on the bottom chord only.

ISOLATEK INTERNATIONAL — Type D-C/E, HP, II or Type II HS. Investigated for exterior use. Type EBS or Type X adhesive/surface sealer optional.

Table with columns: Restrainted Assembly Rating, Unrestrained Beam Rating, Min Thins Applied Resistive Mt. In., W6x9, W6x9, W8x28, W8x28

* This thickness applies when optional Items 12, 13 are used over 3-1/4 in. light weight concrete topping. ISOLATEK INTERNATIONAL — Type 2B0

68. Spray-Applied Fire Resistive Materials* — Alternate to Items 6 and 6A. Prepared by mixing with water. Spray-applied in one or more coats to beam surfaces to a min final thickness as shown in the tables below. Beam surfaces must be clean and free of dirt, loose

https://iq.ulprospector.com/en/profile?en=13878 718



Table with columns: Rating, Hr, Min Stud Depth, In., Item 2E, No. of Layers & Thickness of Panel, Min Thins of Insulation (Item 4)

CGC INC — 1/2 in. thick Type C, IP-X2 or IPC-AR, WRC, 5/8 in. thick Type AR, C, IP-AR, IP-X1, IP-X2, IPC-AR, SCX, SHX, ULIX, WRC or WRC; 3/4 in. thick Types IP-X3 or ULTRACODE

THE SIAM GYPSUM INDUSTRY (SONGKHLA) CO — 1/2 in. thick Type C and 5/8 in. thick Type SCX

UNITED STATES GYPSUM CO — 1/2 in. thick Type C, IP-X2, IPC-AR or WRC, 5/8 in. thick Type SCX, SGX, SHX, ULIX, WRC, IP-X1, AR, C, WRC, FRX-G, IP-AR, IP-X2, IPC-AR, 3/4 in. thick Types IP-X3 or ULTRACODE

USG BORAL DRYWALL SFZ LLC — 1/2 in. thick Type C, 5/8 in. Types C, SCX, SGX, ULTRACODE

USG MEXICO S A DE C V — 1/2 in. thick Type C, IP-X2, IPC-AR or WRC, 5/8 in. thick Type AR, C, IP-AR, IP-X1, IP-X2, IPC-AR, SCX, SHX, WRC, WRC or 3/4 in. thick Types IP-X3 or ULTRACODE

SA. Gypsum Board* — (As an alternate to Item 5) — 5/8 in. thick, 24 to 54 in. wide, applied horizontally as the outer layer to one side of the assembly. Secured as described in Item 6. CGC INC — Type SHX

UNITED STATES GYPSUM CO — Type FRX-G, SHX

USG MEXICO S A DE C V — Type SHX

5B. Gypsum Board* — (Not Shown) — As an alternate to Item 5 when used as the base layer on one or both sides of wall when 5/8 in. or 3/4 in. thick products are specified. For direct attachment only to steel studs Item 2A, (not to be used with Item 3) — Nom 5/8 in. or 3/4 in. may be used as alternate to all 5/8 in. or 3/4 in. shown in Item 5, Wallboard Protection on Each Side of Wall Table. Nom 5/8 in. or 3/4 in. thick lead backed gypsum panels with beveled, square or tapered edges, applied vertically. Vertical joints centered over studs and staggered min 1 stud cavity on opposite sides of studs. Gypsum board secured to 20 MSG steel studs Item 2A with 1-1/4 in. long Type S-12 steel screws spaced 8 in. OC at perimeter and 12 in. OC in the field. To be used with Lead Batten Strips (see Item 1) or Lead Discs or Tabs (see Item 12).

RAY-BAR ENGINEERING CORP — Type RB-LBG

5C. Gypsum Board* — (For Use With Item 2B) — Rating Limited to 1 Hour, 5/8 in. thick, 48 in. wide, Gypsum panels with beveled, square or tapered edges, applied vertically or horizontally. (Vertical Application) - The gypsum board is to be installed on each side of the studs with 1 in. long Type 5 coated steel screws spaced 8 in. OC starting 4 in. from the edge of the board at the vertical edges and 12 in. OC starting 6 in. from the edge of the board at the center of each board. Gypsum boards are to be secured to the top and bottom track with screws spaced 8 in. OC, starting 4 in. from the board edge. Fasteners shall not penetrate through both the stud and the track at the same time. Vertical joints are to be centered over studs and staggered one stud cavity on opposite sides of studs. (Horizontal Application) - The gypsum board is to be installed on each side of the studs with 1 in. long Type 5 coated steel screws spaced 8 in. OC, starting 4 in. from the edge of the board at the vertical edges and 12 in. OC starting 6 in. from the edge of the board at the center of each board. Gypsum boards are to be secured to the top and bottom track with screws spaced 8 in. OC, starting 4 in. from the board edge. Fasteners shall not penetrate through both the stud and the track at the same time. All horizontal joints are to be backed as outlined under section VI of Volume 1 in the Fire Resistive Directory.

CGC INC — Type SCX, ULIX

THE SIAM GYPSUM INDUSTRY (SONGKHLA) CO — Type SCX

UNITED STATES GYPSUM CO — Type SCX, SGX, ULIX

USG BORAL DRYWALL SFZ LLC — Type SCX

USG MEXICO S A DE C V — Type SCX

5D. Gypsum Board* — (As an alternate to Item 5) — 5/8 in. thick, 48 in. wide, applied vertically or horizontally. Secured as described in Item 6. For use with Items 1 and 2 only. CGC INC — Type USGX

UNITED STATES GYPSUM CO — Type USGX

USG BORAL DRYWALL SFZ LLC — Type USGX

USG MEXICO S A DE C V — Type USGX

5E. Gypsum Board* — (Not Shown) — (As an alternate to Item 5) when used as the base layer on one or both sides of wall when 1/2 in. or 5/8 in. thick products are specified. For direct attachment only to steel studs Item 2A, (not to be used with Item 3). Nominal 5/8 in. thick lead backed gypsum panels with beveled, square or tapered edges, applied vertically. Vertical joints centered over studs and staggered min 1 stud cavity on opposite sides of studs. Wallboard secured to studs with 1-1/4 in. long Type S-12 (or No. 6) by 1-1/4 in. long bugle head fire drill steel screws spaced 8 in. OC at perimeter and 12 in. OC in the field. NEW ENGLAND LEAD BURNING CO INC, DBA NIELCO — Nielo

5F. Gypsum Board* — (As an alternate to Item 5) — For use with Items 1E and 2E and limited to 1 Hour Rating only. Gypsum panels with beveled, square or tapered edges, applied vertically, and fastened to the steel studs with 1 in. long Type S screws spaced 8 in. OC along vertical and bottom edges and 12 in. OC in the field. Vertical joints centered over studs and staggered one stud cavity on opposite sides of studs. Stud stud depth shall be a minimum 3-5/8 in.

THE SIAM GYPSUM INDUSTRY (SONGKHLA) CO — Type SCX

UNITED STATES GYPSUM CO — 5/8 in. thick Type SCX, SGX, ULIX

USG BORAL DRYWALL SFZ LLC — 5/8 in. thick Type SCX, SGX

5G. Gypsum Board* — (As an alternate to Item 5) — For use with Items 1E and 2E only. Gypsum panels with beveled, square or tapered edges, applied vertically or horizontally, as specified in the table below and fastened to the steel studs as described in Item 6. Vertical joints centered over studs and staggered one stud cavity on opposite sides of studs. Vertical joints in adjacent layers (multilayer systems) staggered one stud cavity. Horizontal joints need not be backed by steel framing. Horizontal edge joints and horizontal butt joints on opposite sides of studs need not be staggered. Horizontal edge joints and horizontal butt joints in adjacent layers (multilayer systems) staggered a min of 12 in. The thickness and number of layers for the 2 hr, 3 hr and 4 hr ratings are as follows.

https://iq.ulprospector.com/en/profile?en=14979 914



Table with columns: Rating, Hr, Min Stud Depth, In., Item 2E, No. of Layers & Thickness of Panel, Min Thins of Insulation (Item 4)

CGC INC — 1/2 in. thick Type C, IP-X2 or IPC-AR, 5/8 in. thick Type AR, C, IP-AR, IP-X1, IP-X2, IPC-AR, SCX, SHX, ULIX or 3/4 in. thick Types IP-X3 or ULTRACODE

THE SIAM GYPSUM INDUSTRY (SONGKHLA) CO — 1/2 in. thick Types C and 5/8 in. thick SCX

UNITED STATES GYPSUM CO — 1/2 in. thick Type C, IP-X2, IPC-AR or 5/8 in. thick Type SCX, SGX, SHX, IP-X1, AR, C, FRX-G, IP-AR, IP-X2, IPC-AR, ULIX; 3/4 in. thick Types IP-X3 or ULTRACODE

USG BORAL DRYWALL SFZ LLC — 1/2 in. thick Type C, 5/8 in. Types C, SCX, SGX, ULTRACODE

USG MEXICO S A DE C V — 1/2 in. thick Type C, IP-X2, IPC-AR or 5/8 in. thick Type AR, C, IP-AR, IP-X1, IP-X2, IPC-AR, SCX, SHX or 3/4 in. thick Types IP-X3 or ULTRACODE

5H. Gypsum Board* — (Not Shown) — (As an alternate to Item 5) when used as the base layer on one or both sides of wall when 5/8 in. or 3/4 in. thick products are specified. For direct attachment only to steel studs Item 2A, (not to be used with Item 3) - Nom 5/8 in. or 3/4 in. may be used as alternate to all 5/8 in. or 3/4 in. shown in Item 5, Wallboard Protection on Each Side of Wall Table. Nom 5/8 in. or 3/4 in. thick lead backed gypsum panels with beveled, square or tapered edges, applied vertically. Vertical joints centered over 20 MSG steel studs and staggered min 1 stud cavity on opposite sides of studs. Wallboard secured to studs with 1-1/4 in. long Type S-12 steel screws spaced 8 in. OC at perimeter and 12 in. OC in the field. Gypsum board secured to 20 MSG steel studs Item 2B with 1-1/4 in. long Type S-12 steel screws spaced 8 in. OC at perimeter and 12 in. OC in the field. For Joint Compound see Item 5. To be used with Lead Batten Strips (see Item 11A) or Lead Discs (see Item 12A).

MAYCO INDUSTRIES INC — Type X-Ray StudGrip Gypsum

5I. Gypsum Board* — (As an alternate to Item 5) — Nom. 5/8 in. thick gypsum panels with beveled, square or tapered edges installed as described in Item 5. Steel stud minimum depth shall be as indicated in Item 5. CGC INC — Type ULIX, ULX

UNITED STATES GYPSUM CO — Type ULIX, ULX

USG MEXICO S A DE C V — Type ULX

5J. Gypsum Board* — (Not Shown) — (As an alternate to Item 5) when used as the base layer on one or both sides of wall when 1/2 in. or 5/8 in. thick products are specified. For direct attachment only to steel studs Item 2A, not to be used with Item 3). Nom 5/8 in. thick lead backed gypsum panels with beveled, square or tapered edges, applied vertically. Vertical joints centered over studs and staggered min 1 stud cavity on opposite sides of studs. Wallboard secured to studs with 1-1/4 in. long Type S-12 steel screws gypsum panel steel screws spaced 8 in. OC at perimeter and 12 in. OC in the field. Lead batten strips required behind vertical joints of lead backed gypsum wallboard and optional at remaining stud locations. Lead batten strips, min 2 in. wide, max 8 ft long with a max thickness of 0.14 in. placed on the face of studs and attached to the stud with construction adhesive and two 1 in. long Type S-12 pan head steel screws, one at the top of the strip and one at the bottom of the strip. Lead discs, nominal 3/8 in. diam by max 0.085 in.

5K. Gypsum Board* — (As an alternate to Item 5) when Foam Plastic insulation (Items 4C or 4D) is used) — Any 5/8 in. thick, 4 ft. wide, Gypsum Board listed in Item 5 above. Applied vertically with vertical joints centered over studs and staggered one stud cavity on opposite sides of studs. Gypsum panels secured to studs with 1-1/4 in. long Type S steel screws spaced 8 in. OC at perimeter and in the field. For 2 layer assemblies outer layer will be attached to studs over inner layer with the 1-7/8 in. long steel screws spaced 8 in. OC.

6. Fasteners — (Not Shown) — For use with Items 2 and 2F - Type 5 or S-12 steel screws used to attach panels to studs (Item 2) or furring channels (Item 7). Single layer systems: 1 in. long for 1/2 and 5/8 in. thick panels or 1-1/4 in. long for 3/4 in. thick panels, spaced 8 in. OC when panels are applied horizontally, or 8 in. OC along vertical and bottom edges and 12 in. OC in the field when panels are applied vertically. Single layer system with Type ULIX: 1 in. long, spaced 12 in. OC in the field and perimeter, when panels are applied horizontally or vertically. Two layer systems: First layer- 1 in. long for 1/2 and 5/8 in. thick panels or 1-1/4 in. long for 3/4 in. thick panels, spaced 16 in. OC. Second layer- 1-5/8 in. long for 1/2 in., 5/8 in. thick panels or 2-1/4 in. long for 3/4 in. thick panels, spaced 16 in. OC with screws offset 8 in. from first layer. Three-layer systems: First layer- 1 in. long for 1/2 in., 5/8 in. thick panels, spaced 24 in. OC. Second layer- 1-5/8 in. long for 1/2 in., 5/8 in. thick panels, spaced 24 in. OC. Third layer- 2-1/4 in. long for 1/2 in., 5/8 in. thick panels, spaced 24 in. OC. Fourth layer- 2-5/8 in. long for 1/2 in. thick panels or 3 in. long for 5/8 in. thick panels, spaced 12 in. OC. Screws offset min 6 in. from layer below. Four-layer systems: First layer- 1 in. long for 1/2 in., 5/8 in. thick panels, spaced 24 in. OC. Second layer- 1-5/8 in. long for 1/2 in., 5/8 in. thick panels, spaced 24 in. OC. Third layer- 2-1/4 in. long for 1/2 in. thick panels or 2-5/8 in. long for 5/8 in. thick panels, spaced 24 in. OC. Fourth layer- 2-5/8 in. long for 1/2 in. thick panels or 3 in. long for 5/8 in. thick panels, spaced 12 in. OC. Screws offset min 6 in. from layer below.

7. Furring Channels — (Optional, Not Shown, for single or double layer systems) — Resilient furring channels fabricated from min 25 MSG corrosion-protected steel, spaced vertically a max of 24 in. OC. Flange portion attached to each intersecting stud with 1/2 in. long Type S-12 steel screws. Not for use with Item 5A.

7A. Framing Members* — (Optional on one or both sides, not shown, for single or double layer systems) — As an alternate to Item 7, furring channels and Steel Framing Members as described below.

a. Furring Channels — Formed of No. 25 MSG galv steel, 2-9/16 in. by 2-23/32 in. wide by 7/8 in. deep, spaced max 24 in. OC perpendicular to studs. Channels secured to studs as described in Item b. Gypsum board attached to furring channels as described in Item 6. Not for use with Item 5A.

b. Steel Framing Members* — Used to attach furring channels (Item 7Aa) to studs (Item 2). Clips spaced max 48 in. OC, RESILIENTCS secured to studs with No. 8 x 1-1/2 in. minimum self-drilling, S-12 steel screw through the center grommet. Furring channels are friction fitted into clips. PUTEQ INC — Type GLEPCIP

7B. Framing Members* — (Optional, Not Shown) — As an alternate to Item 7, for single or double layer systems, furring channels and Steel Framing Members on only one side of studs as described below.

a. Furring Channels — Formed of No. 25 MSG galv steel, spaced 24 in. OC perpendicular to studs. Channels secured to studs as described in Item b. Batts and Blankets placed in stud cavity as described in Item 5. Two layers of gypsum board attached to furring channels as described in Item 5. Not for use with Item 5A.

b. Steel Framing Members* — Used to attach furring channels (Item 7Ba) to one side of studs (Item 2) only. Clips spaced 48 in. OC, and secured to studs with two No. 8 x 2-1/2 in. coarse drywall screws, one through the hole at each end of the clip. Furring channels are friction fitted into clips. KNETICS NOISE CONTROL INC — Type Ksomax

7C. Framing Members* — (Optional on one or both sides, not shown, for single or double layer systems) — As an alternate to Item 7, furring channels and Steel Framing Members as described below.

a. Furring Channels — Formed of No. 25 MSG galv steel, spaced 24 in. OC perpendicular to studs. Channels secured to studs as described in Item b. Ends of adjoining channels overlapped 6 in. and tied together with double strand of No. 18 AWG galvanized steel wire. Gypsum board attached to furring channels as described in Item 6. Not for use with Item 5A.

b. Steel Framing Members* — Used to attach furring channels (Item 7Ca) to studs (Item 2). Clips spaced max 48 in. OC, GENECLIPS secured to studs with No. 8 x 1-1/2 in. minimum self-drilling, S-12 steel screw through the center grommet. Furring channels are friction fitted into clips. PUTEQ INC — Type GLEPCIP

7D. Steel Framing Members* — (Optional on one or both sides, not shown, for single or double layer systems) — Furring channels and Steel Framing Members as described below.

a. Furring Channels — Formed of No. 25 MSG galv steel, spaced 24 in. OC perpendicular to studs. Channels secured to studs as described in Item b. Ends of adjoining channels overlapped 6 in. and tied together with double strand of No. 18 AWG galvanized steel wire. Gypsum board attached to furring channels as described in Item 6. Not for use with Item 5A.

b. Steel Framing Members* — Used to attach furring channels (Item 7Da) to studs. Clips spaced 48 in. OC, and secured to studs with 2 in. coarse drywall screw with 1 in. diam washer through the center hole. Furring channels are friction fitted into clips. STUDDO BUILDING SYSTEMS — RESILMOUNT Sound Isolation Clips - Type A237 or A237R

7E. Steel Framing Members* — (Optional on one or both sides, not shown, for single or double layer systems) — Furring channels and Steel Framing Members as described below.

a. Furring Channels — Formed of No. 25 MSG galv steel, spaced 24 in. OC perpendicular to studs. Channels secured to studs as described in Item 7Bb. Ends of adjoining channels overlapped 6 in. and tied together with double strand of No. 18 AWG galvanized steel wire. Gypsum board attached to furring channels as described in Item 6. Not for use with Item 5A and 5E.

b. Steel Framing Members* — Used to attach furring channels (Item 7Ea) to studs. Clips spaced 48 in. OC, and secured to studs with No. 8 x 2-1/2 in. coarse drywall screw through the center hole. Furring channels are friction fitted into clips. REGUPOL AMERICA — Type SonusClip

7F. Steel Framing Members* — (Optional on one or both sides, not shown, for single or double layer systems) — Resilient channels and Steel Framing Members as described below.

a. Resilient Channels — Formed of No. 25 MSG galv steel, spaced 24 in. OC, and perpendicular to studs. Channels secured to studs as described in Item 7Bb. Ends of adjoining channels overlapped 6 in. and secured in place with two No. 8 15 x 1/2 in. Phillips Modified Truss screws spaced 2-1/2 in. from the center of the overlap. Gypsum board attached to resilient channels as described in Item 5. Not for use with Item 5A and 5E.

b. Steel Framing Members* — Used to attach resilient channels (Item 7Fa) to studs. Clips spaced 48 in. OC, and secured to studs with No. 8 x 2-1/2 in. coarse drywall screw through the center hole. Resilient channels are secured to clips with one No. 10 x 1/2 in. pan-head self-drilling screw. KEENE BUILDING PRODUCTS CO INC — Type RC+ Assurance Clip



7G. Framing Members* — (Optional on one or both sides, not shown, for single or double layer systems) — As an alternate to Item 7, furring channels and Steel Framing Members as described below.

a. Furring Channels — Formed of No. 25 MSG galv steel, spaced 24 in. OC perpendicular to studs. Channels secured to studs as described in Item b. Ends of adjoining channels overlapped 6 in. and tied together with double strand of No. 18 AWG galvanized steel wire. Gypsum board attached to furring channels as described in Item 6. Not for use with Item 5A.

b. Steel Framing Members* — Used to attach furring channels (Item 7Ga) to studs (Item 2). Clips spaced max 48 in. OC, GENECLIPS secured to studs with No. 8 x 1-1/2 in. minimum self-drilling, S-12 steel screw through the center grommet. Furring channels are friction fitted into clips. PUTEQ INC — Type GLEPCIP

7D. Steel Framing Members* — (Optional on one or both sides, not shown, for single or double layer systems) — Furring channels and Steel Framing Members as described below.

a. Furring Channels — Formed of No. 25 MSG galv steel, spaced 24 in. OC perpendicular to studs. Channels secured to studs as described in Item b. Ends of adjoining channels overlapped 6 in. and tied together with double strand of No. 18 AWG galvanized steel wire. Gypsum board attached to furring channels as described in Item 6. Not for use with Item 5A.

b. Steel Framing Members* — Used to attach furring channels (Item 7Da) to studs. Clips spaced 48 in. OC, and secured to studs with 2 in. coarse drywall screw with 1 in. diam washer through the center hole. Furring channels are friction fitted into clips. STUDDO BUILDING SYSTEMS — RESILMOUNT Sound Isolation Clips - Type A237 or A237R

7E. Steel Framing Members* — (Optional on one or both sides, not shown, for single or double layer systems) — Furring channels and Steel Framing Members as described below.

a. Furring Channels — Formed of No. 25 MSG galv steel, spaced 24 in. OC perpendicular to studs. Channels secured to studs as described in Item 7Bb. Ends of adjoining channels overlapped 6 in. and tied together with double strand of No. 18 AWG galvanized steel wire. Gypsum board attached to furring channels as described in Item 6. Not for use with Item 5A and 5E.

b. Steel Framing Members* — Used to attach furring channels (Item 7Ea) to studs. Clips spaced 48 in. OC, and secured to studs with No. 8 x 2-1/2 in. coarse drywall screw through the center hole. Furring channels are friction fitted into clips. REGUPOL AMERICA — Type SonusClip

7F. Steel Framing Members* — (Optional on one or both sides, not shown, for single or double layer systems) — Resilient channels and Steel Framing Members as described below.

a. Resilient Channels — Formed of No. 25 MSG galv steel, spaced 24 in. OC, and perpendicular to studs. Channels secured to studs as described in Item 7Bb. Ends of adjoining channels overlapped 6 in. and secured in place with two No. 8 15 x 1/2 in. Phillips Modified Truss screws spaced 2-1/2 in. from the center of the overlap. Gypsum board attached to resilient channels as described in Item 5. Not for use with Item 5A and 5E.

b. Steel Framing Members* — Used to attach resilient channels (Item 7Fa) to studs. Clips spaced 48 in. OC, and secured to studs with No. 8 x 2-1/2 in. coarse drywall screw through the center hole. Resilient channels are secured to clips with one No. 10 x 1/2 in. pan-head self-drilling screw. KEENE BUILDING PRODUCTS CO INC — Type RC+ Assurance Clip

7G. Framing Members* — (Optional on one or both sides, not shown, for single or double layer systems) — As an alternate to Item 7, furring channels and Steel Framing Members as described below.

a. Furring Channels — Formed of No. 25 MSG galv steel, 2-23/32 in. wide by 7/8 in. deep, spaced max 24 in. OC perpendicular to studs. Channels secured to studs as described in Item b. Gypsum board attached to furring channels as described in Item 6. Not for use with Item 5A.

b. Steel Framing Members* — Used to attach furring channels (Item 7Ga) to studs (Item 2). Clips spaced max 48 in. OC. Clips secured to studs with No. 8 x 1-1/2 in. minimum self-drilling, S-12 steel screw through the center hole. Furring channels are friction fitted into clips. CLARKDIETRICH BUILDING SYSTEMS — Type ClarkDrilling Sound Clip

8. Joint Tape and Compound — Vinyl or casein, dry or premixed joint compound applied in two coats to joints and screw heads of outer layers. Paper tape, nom 2 in. wide, embedded in first layer of compound over all joints of outer layer panels. Paper tape and joint compound may be omitted when gypsum panels are supplied with a square edge.

9. Siding, Brick or Stucco — (Optional, Not Shown) — Aluminum, vinyl or steel siding, brick veneer or stucco, meeting the requirements of local code agencies, installed over gypsum panels. Brick veneer attached to studs with corrugated metal wall ties attached to each stud with steel screws, not more than each sixth course of brick.

10. Caulking and Sealants* — (Optional, Not Shown) — A bead of acoustical sealant applied around the partition perimeter for sound control. UNITED STATES GYPSUM CO — Type AS

11. Lead Batten Strips — (Not Shown, For Use With Item 5B) — Lead batten strips, min 1-1/2 in. wide, max 10 ft long with a max thickness of 0.125 in. Strips placed on the interior face of studs and attached from the exterior face of the stud with two 1 in. long Type S-12 pan head steel screws, one at the top of the strip and one at the bottom of the strip. Lead batten strips to have a purity of 99.9% meeting the Federal specification QQ-Q-201E, Grade "C". Lead batten strips required behind vertical joints of lead backed gypsum wallboard (Item 5B) and optional at remaining stud locations. Required behind vertical joints.

11A. Lead Batten Strips — (Not Shown, For Use With Item 5H) — Lead batten strips, 2 in. wide, max 10 ft long with a max thickness of 0.140 in. Strips placed on the face of studs and attached to the stud with two min. 1 in. long min. Type S-8 pan head steel screws, one at the top of the strip and one at the bottom of the strip or with one min. 1 in. long min. Type S-8 pan head steel screw at the top of the strip. Lead batten strips to have a purity of 99.9% meeting the Federal specification QQ-Q-201E, Grades "B, C, or D". Lead batten strips required behind vertical joints of lead backed gypsum wallboard and optional at remaining stud locations.


12. Lead Discs or Tabs — (Not Shown, For Use With Item 5B) — Used in lieu of or in addition to the lead batten strips (Item 11) or optional at other locations - Max 3/4 in. diam by max 0.125 in. thick lead discs compression fitted or adhered over steel screw heads or max 1/2 in. by 1-1/4 in. by max 0.125 in. thick lead tabs placed on gypsum boards (Item 5B) underneath screw locations prior to the installation of the strips. Lead discs or tabs to have a purity of 99.9% meeting the Federal specification QQ-Q-201E, Grade "C".

12A. Lead Discs — (Not Shown, for use with Item 5H) — Max 5/16 in. diam by max 0.140 in. thick lead discs compression fitted or adhered over steel screw heads. Lead discs to have a purity of 99.9% meeting the Federal Specification QQ-Q-201E, Grades "B, C, or D".

13. Lead Batten Strips — (Not Shown, For Use With Item 5E) — Lead batten strips, 2 in. wide, max 10 ft long with a max thickness of 0.142 in. Strips placed on the face of studs and attached to the stud with two min. 1 in. long min. Type S-8 pan head steel screws, one at the top of the strip and one at the bottom of the strip or with one min. 1 in. long min. Type S-8 pan head steel screw at the top of the strip. Lead batten strips to have a purity of 99.9% meeting the Federal specification QQ-Q-201E, Grade "C". Lead batten strips required behind vertical joints of lead backed gypsum wallboard (Item 5E) and optional at remaining stud locations.

14. Lead Tabs — (Not Shown, For Use With Item 5E) — 2 in. wide, 5 in. long with a max thickness of 0.142 in. Tabs friction-fit around front face of stud, the stud folded back flange, and the back face of the stud. Tabs required at each location where a screw that secures the gypsum boards, Item 5E will penetrate the steel stud. Lead tabs to have a purity of 99.9% meeting the Federal specification QQ-Q-201E, Grade "C". Lead tabs may be held in place with standard adhesive tape if necessary.

15. Barrier Mesh — (Optional, Not Shown) - Attached to steel studs on one or both sides

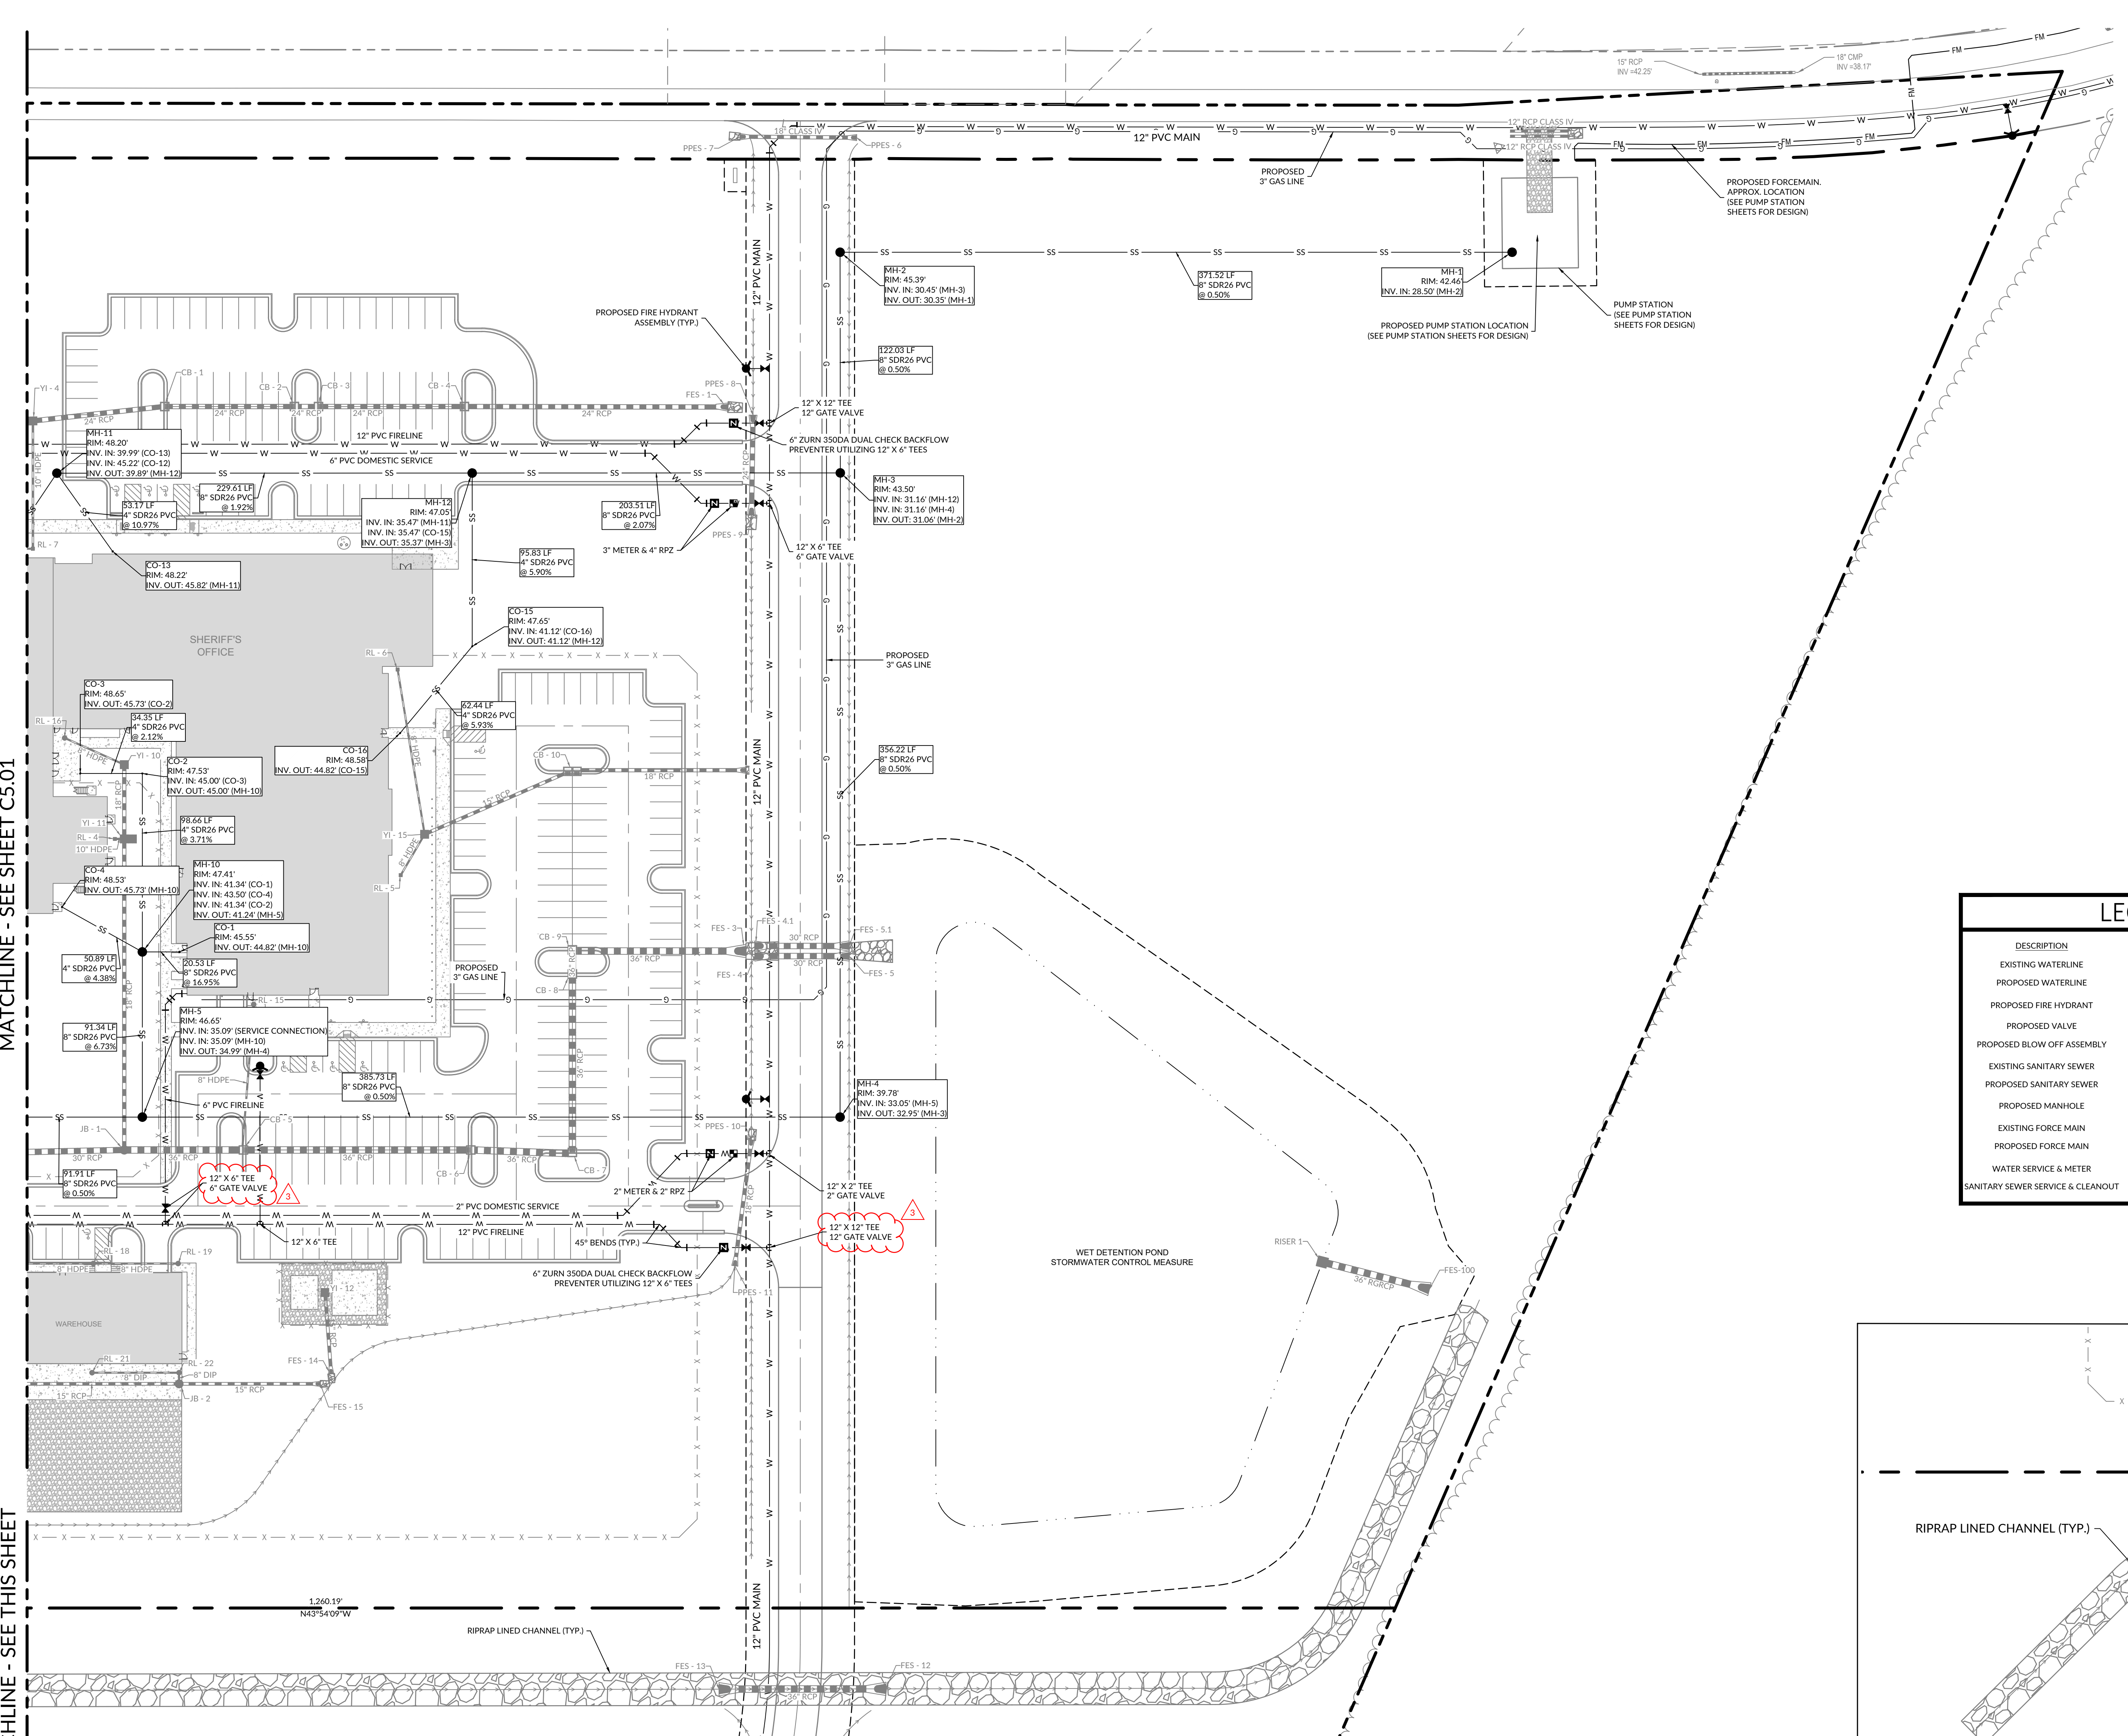


MATCHLINE - SEE SHEET C5.01

MATCHLINE - SEE THIS SHEET

MATCHLINE - SEE SHEET C5.01


LEGEND	
DESCRIPTION	
EXISTING WATERLINE	— W —
PROPOSED WATERLINE	— W — W — W —
PROPOSED FIRE HYDRANT	Y
PROPOSED VALVE	V
PROPOSED BLOW OFF ASSEMBLY	BO
EXISTING SANITARY SEWER	— SS —
PROPOSED SANITARY SEWER	— SS — SS —
PROPOSED MANHOLE	●
EXISTING FORCE MAIN	— FM —
PROPOSED FORCE MAIN	— FM — FM —
WATER SERVICE & METER	W/M
SANITARY SEWER SERVICE & CLEANOUT	S/S

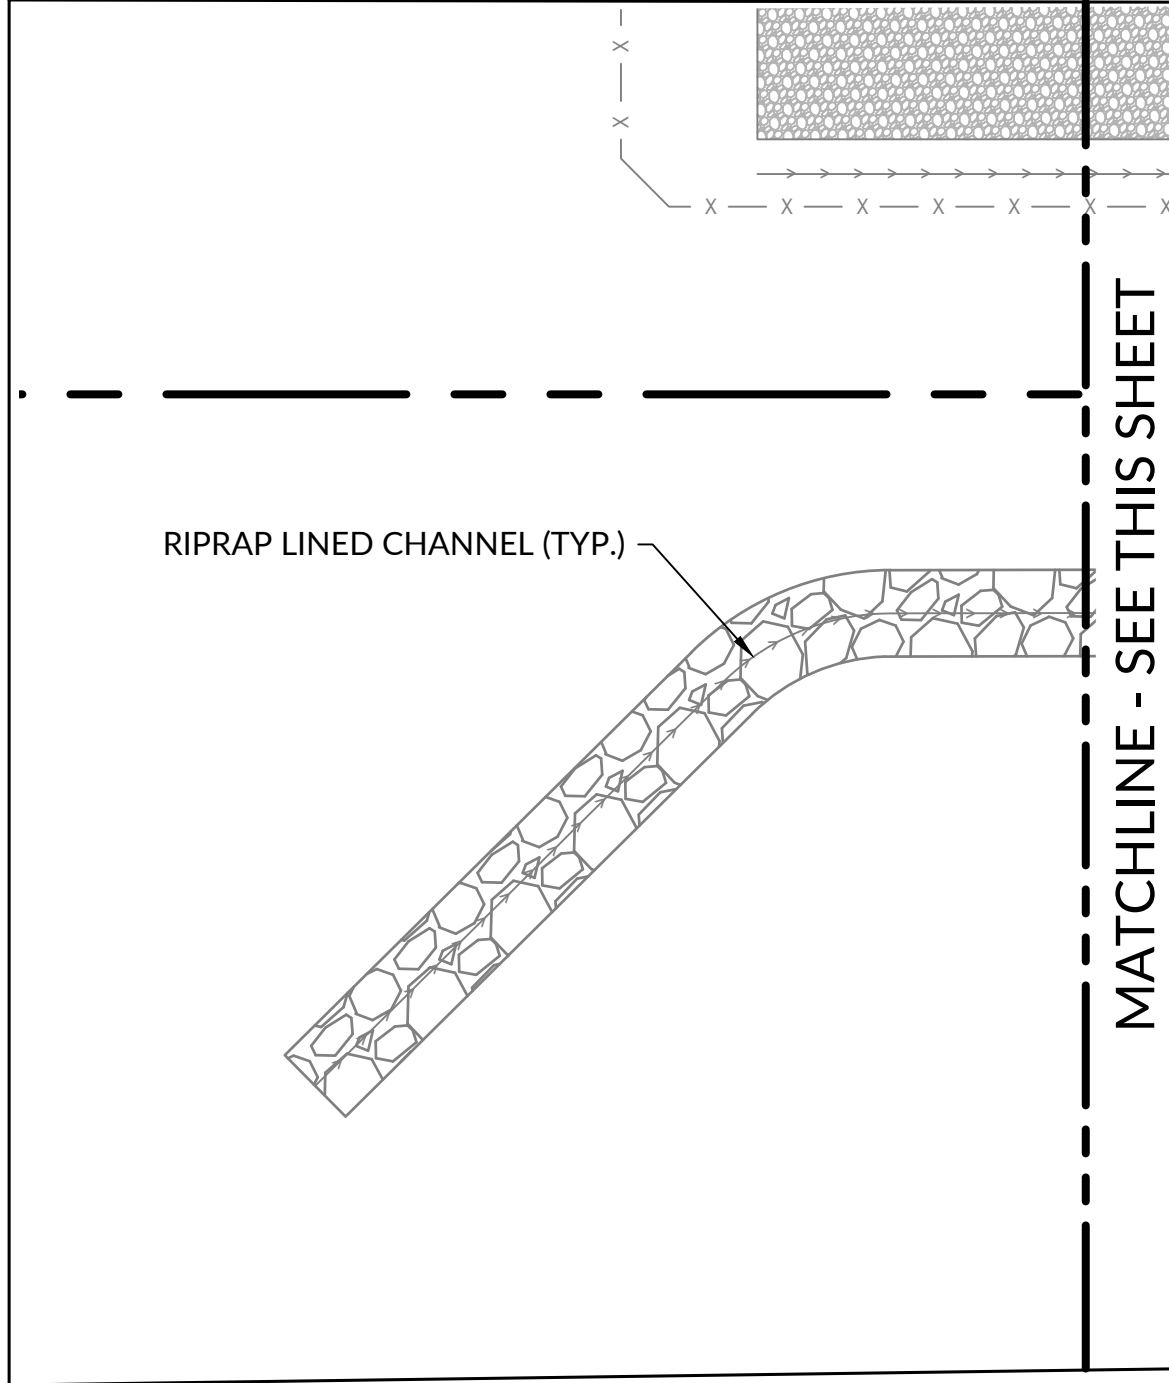

MATCHLINE - SEE THIS SHEET



MOSELEY ARCHITECTS

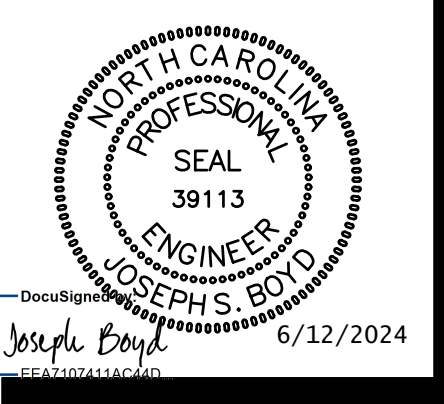


WITHERSRAVENEL
NC CORPORATE
LICENSE # F-1479

PENDER COUNTY LEC
DHSR# J-368 / FID# 220537
PENDER COUNTY, NORTH CAROLINA
1417 OLD SAVANNAH ROAD BURGAW, NC

PROJECT NO:	811888
DATE:	08/1/24
REVISIONS	
DATE	DESCRIPTION
5/24/24	AD 01
6/11/24	AD 03

DETAILED UTILITY PLAN

C5.03

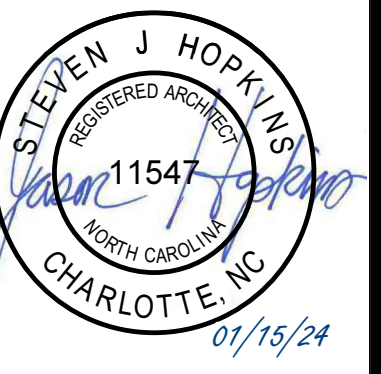

FLOOR PLAN GENERAL NOTES



- A. PROVIDE CONT. SILICONE CAULK AT ALL DOOR FRAMES WHERE GYP. BOARD AND FRAMES MEET BEFORE PAINTING OCCURS.
- B. PROVIDE PAINTED METAL FINISH ON ALL CEILING AND WALL ACCESS PANELS FOR ACCESS TO MECHANICAL, ELECTRICAL, AND PLUMBING SPACES.
- C. "MIN." FOR DIMENSIONS INDICATED MINIMUM ACCEPTABLE DIMENSION. IF "MIN." DIMENSIONS FALL SHORT OF WHAT IS SHOWN ON DRAWINGS, GC IS TO NOTIFY THE ARCHITECT IMMEDIATELY SO AS TO NOT DELAY THE PROJECT.

FLOOR PLAN KEYNOTES



APPLIES TO DRAWINGS A2.1.1 - A2.1.7
 REPRESENTED BY [Symbol]

- 1 CMU LOW WALL PER DETAIL 1/A5.2.1
- 2 DOUBLE TIER METAL LOCKERS 15'x15'x72"
- 3 INMATE PHONE (NIC)
- 4 KIOSK (NIC)
- 5 MIRROR - 48"W X 72"H
- 6 50" MONITOR (NIC) - MOUNT AT 66" AFF TO CENTER OF SCREEN
- 7 FLOOR EXPANSION JOINT
- 8 VIDEO VISITATION STATION
- 9 WALL MOUNTED, STEEL ROOF ACCESS LADDER
- 10 AUTOMATIC FIRE SHUTTER @ THIS LOCATION
- 11 WALL MOUNTED CHASE LADDER
- 12 CHAIN LINK FENCE - EXTEND TO UNDERSIDE OF CEILING
- 13 MECHANICALLY ASSISTED MOBILE STORAGE SHELVING SYSTEM - REFER TO ELEVATION ON A2 DRAWINGS.
- 14 WASHER (NIC)
- 15 DRYER (NIC)
- 16 FOUR-TIER METAL LOCKERS 12'x12'x72"
- 17 DOUBLE-TIER PHENOLIC Z-CONFIGURATION LOCKERS 12'x12'x72"
- 18 DOUBLE TIER METAL LOCKERS 12'x12'x72"
- 19 PACKAGE PASS - REFER TO DETAIL ON A2.1.
- 20 PASS-THRU EVIDENCE LOCKERS
- 21 DASHED LINE INDICATES A PRE-MANUFACTURED PROTECTIVE COVER ABOVE
- 22 REFRIGERATED PASS-THRU LOCKER COMPARTMENT

SHELVING SYSTEM - PROPERTY STORAGE
 1/4" = 1'-0"

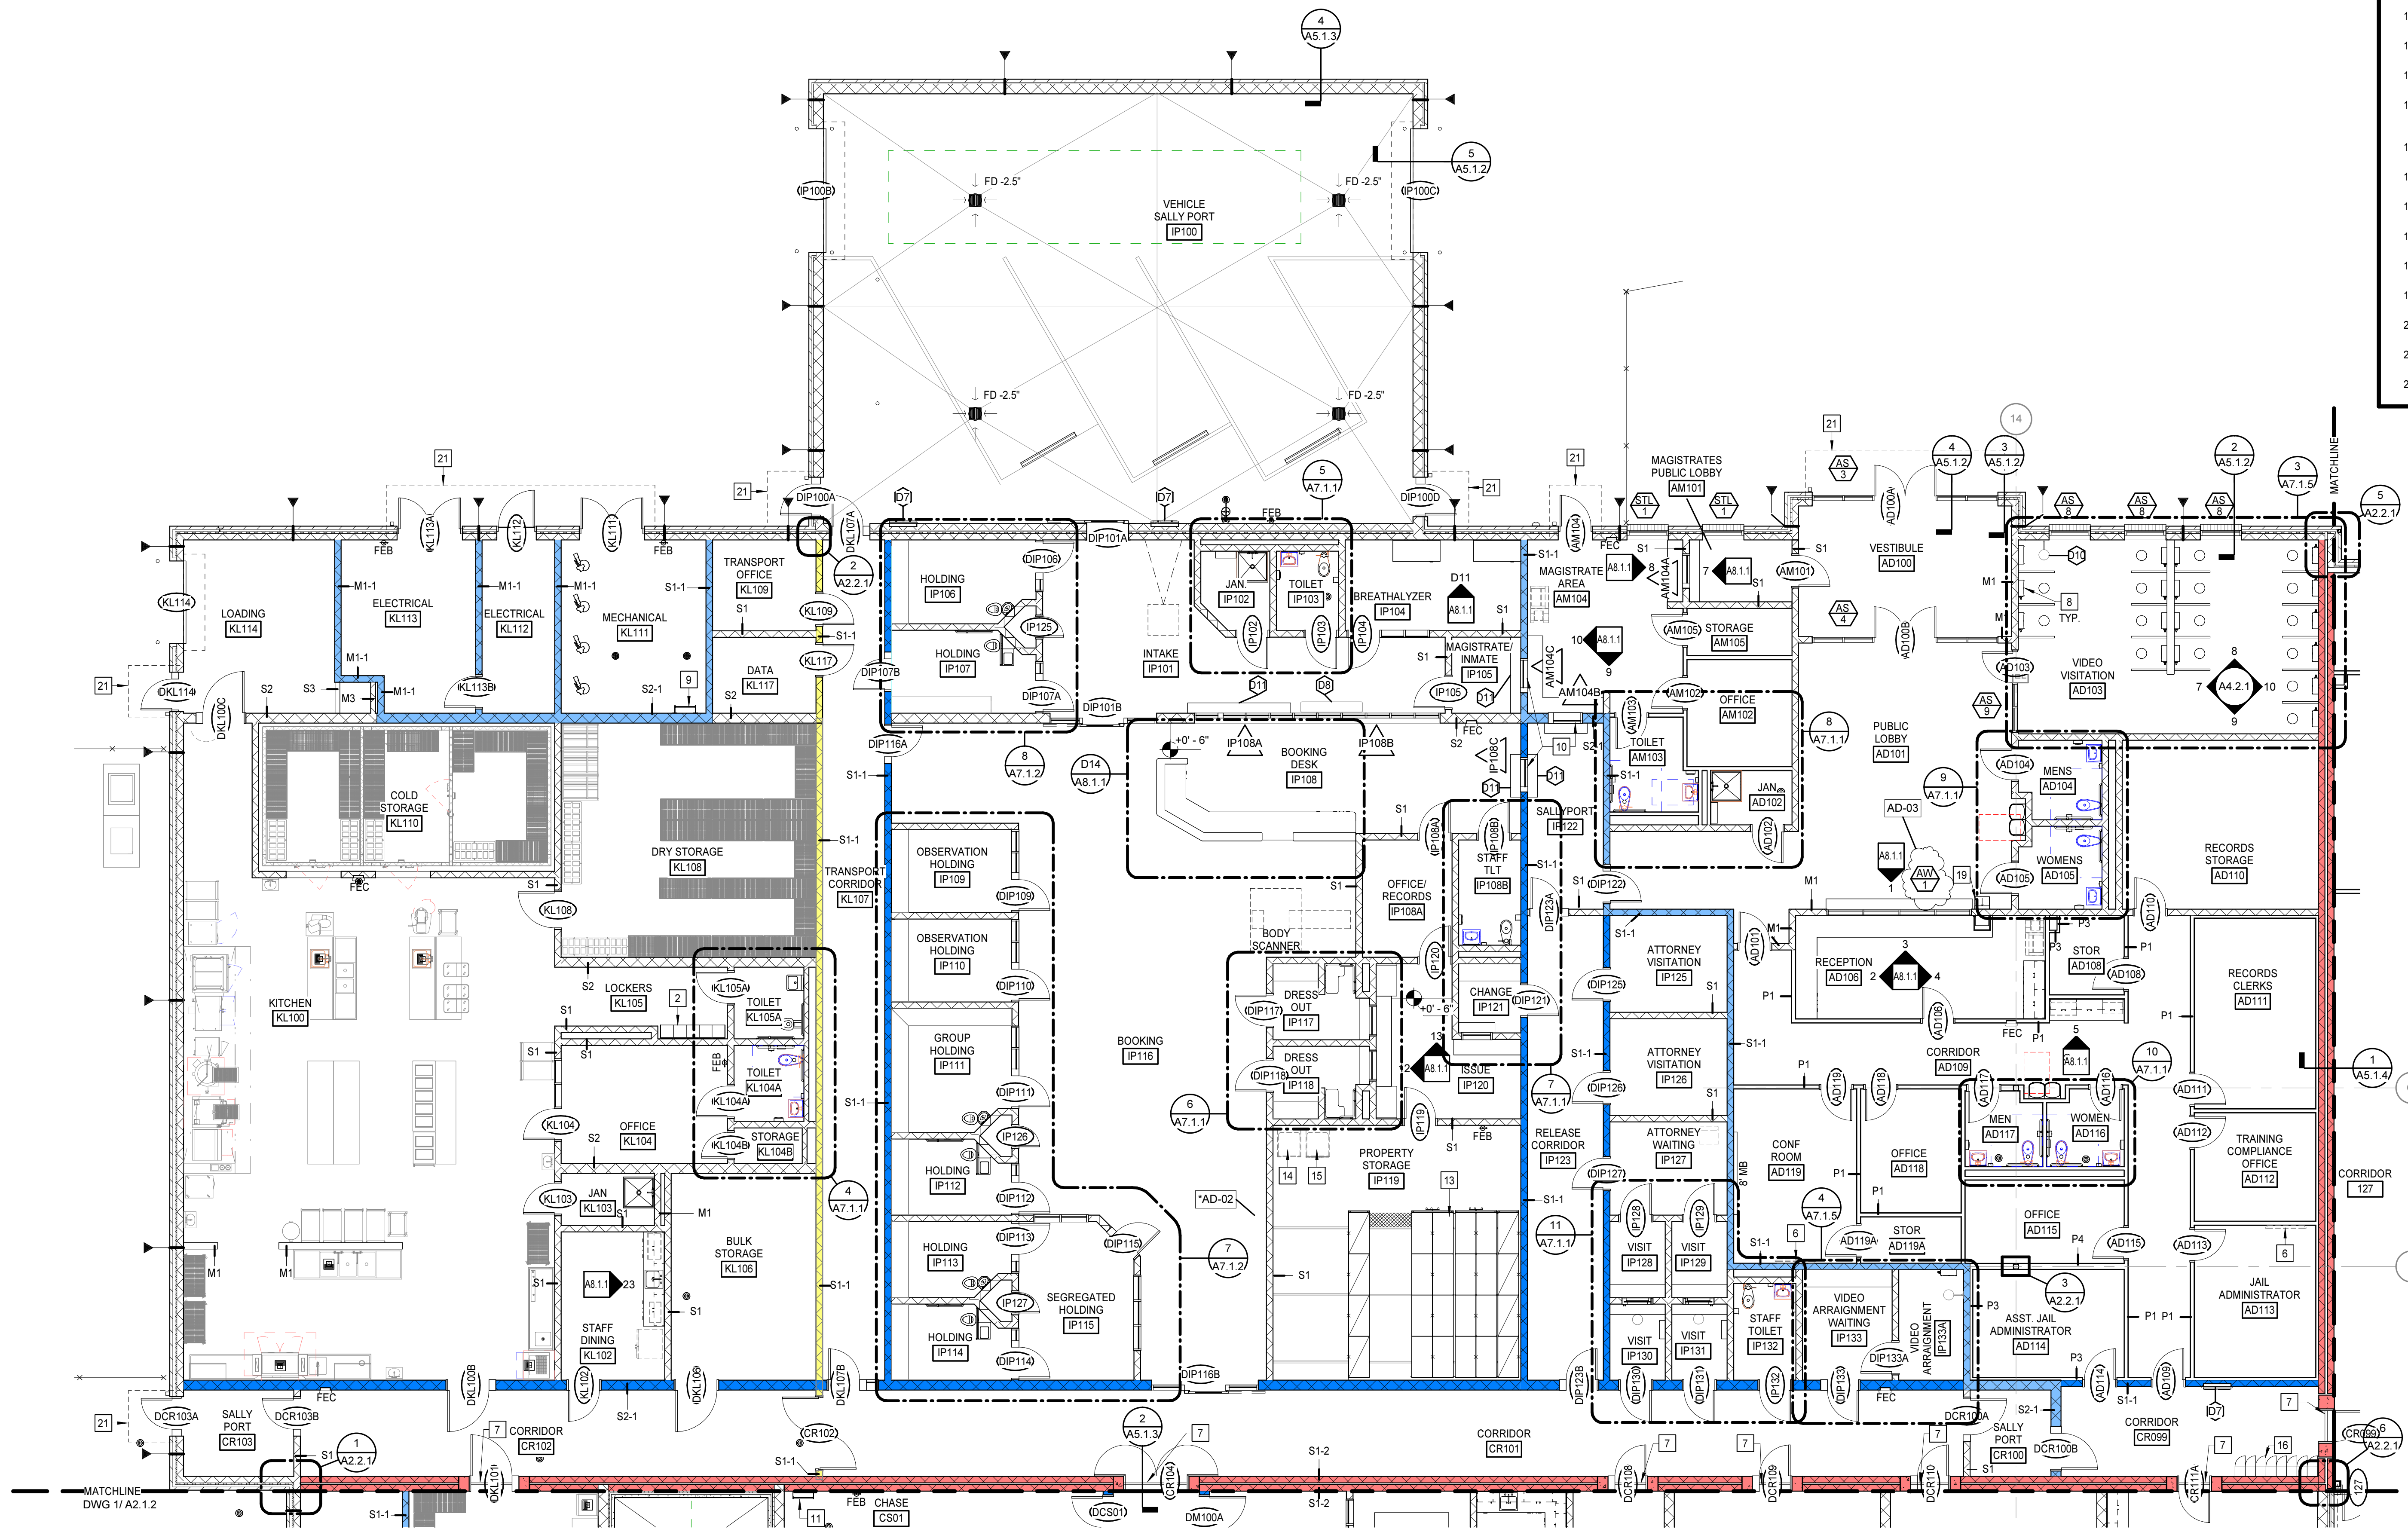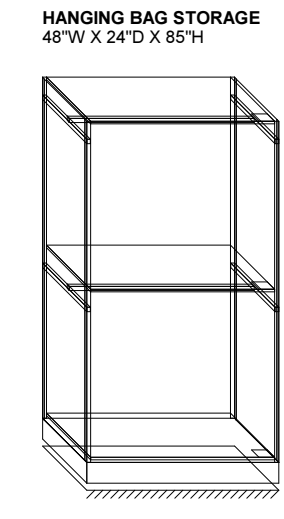

FLOOR PLAN - PART A
 1/8" = 1'-0"


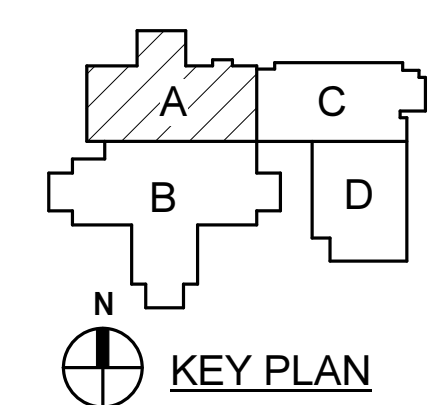
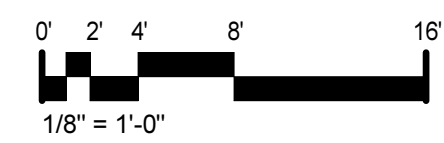


PENDER COUNTY LEC
 DHSR# J-368 / FID# 220537
 PENDER COUNTY, NORTH CAROLINA
 1417 OLD SAVANNAH ROAD BURGAW, NC


PROJECT NO:	611688
DATE:	06/12/24
REVISIONS	
DATE	DESCRIPTION
06/04/24	*AD-02
06/12/24	AD-03

FLOOR PLAN - PART A

A2.1.1

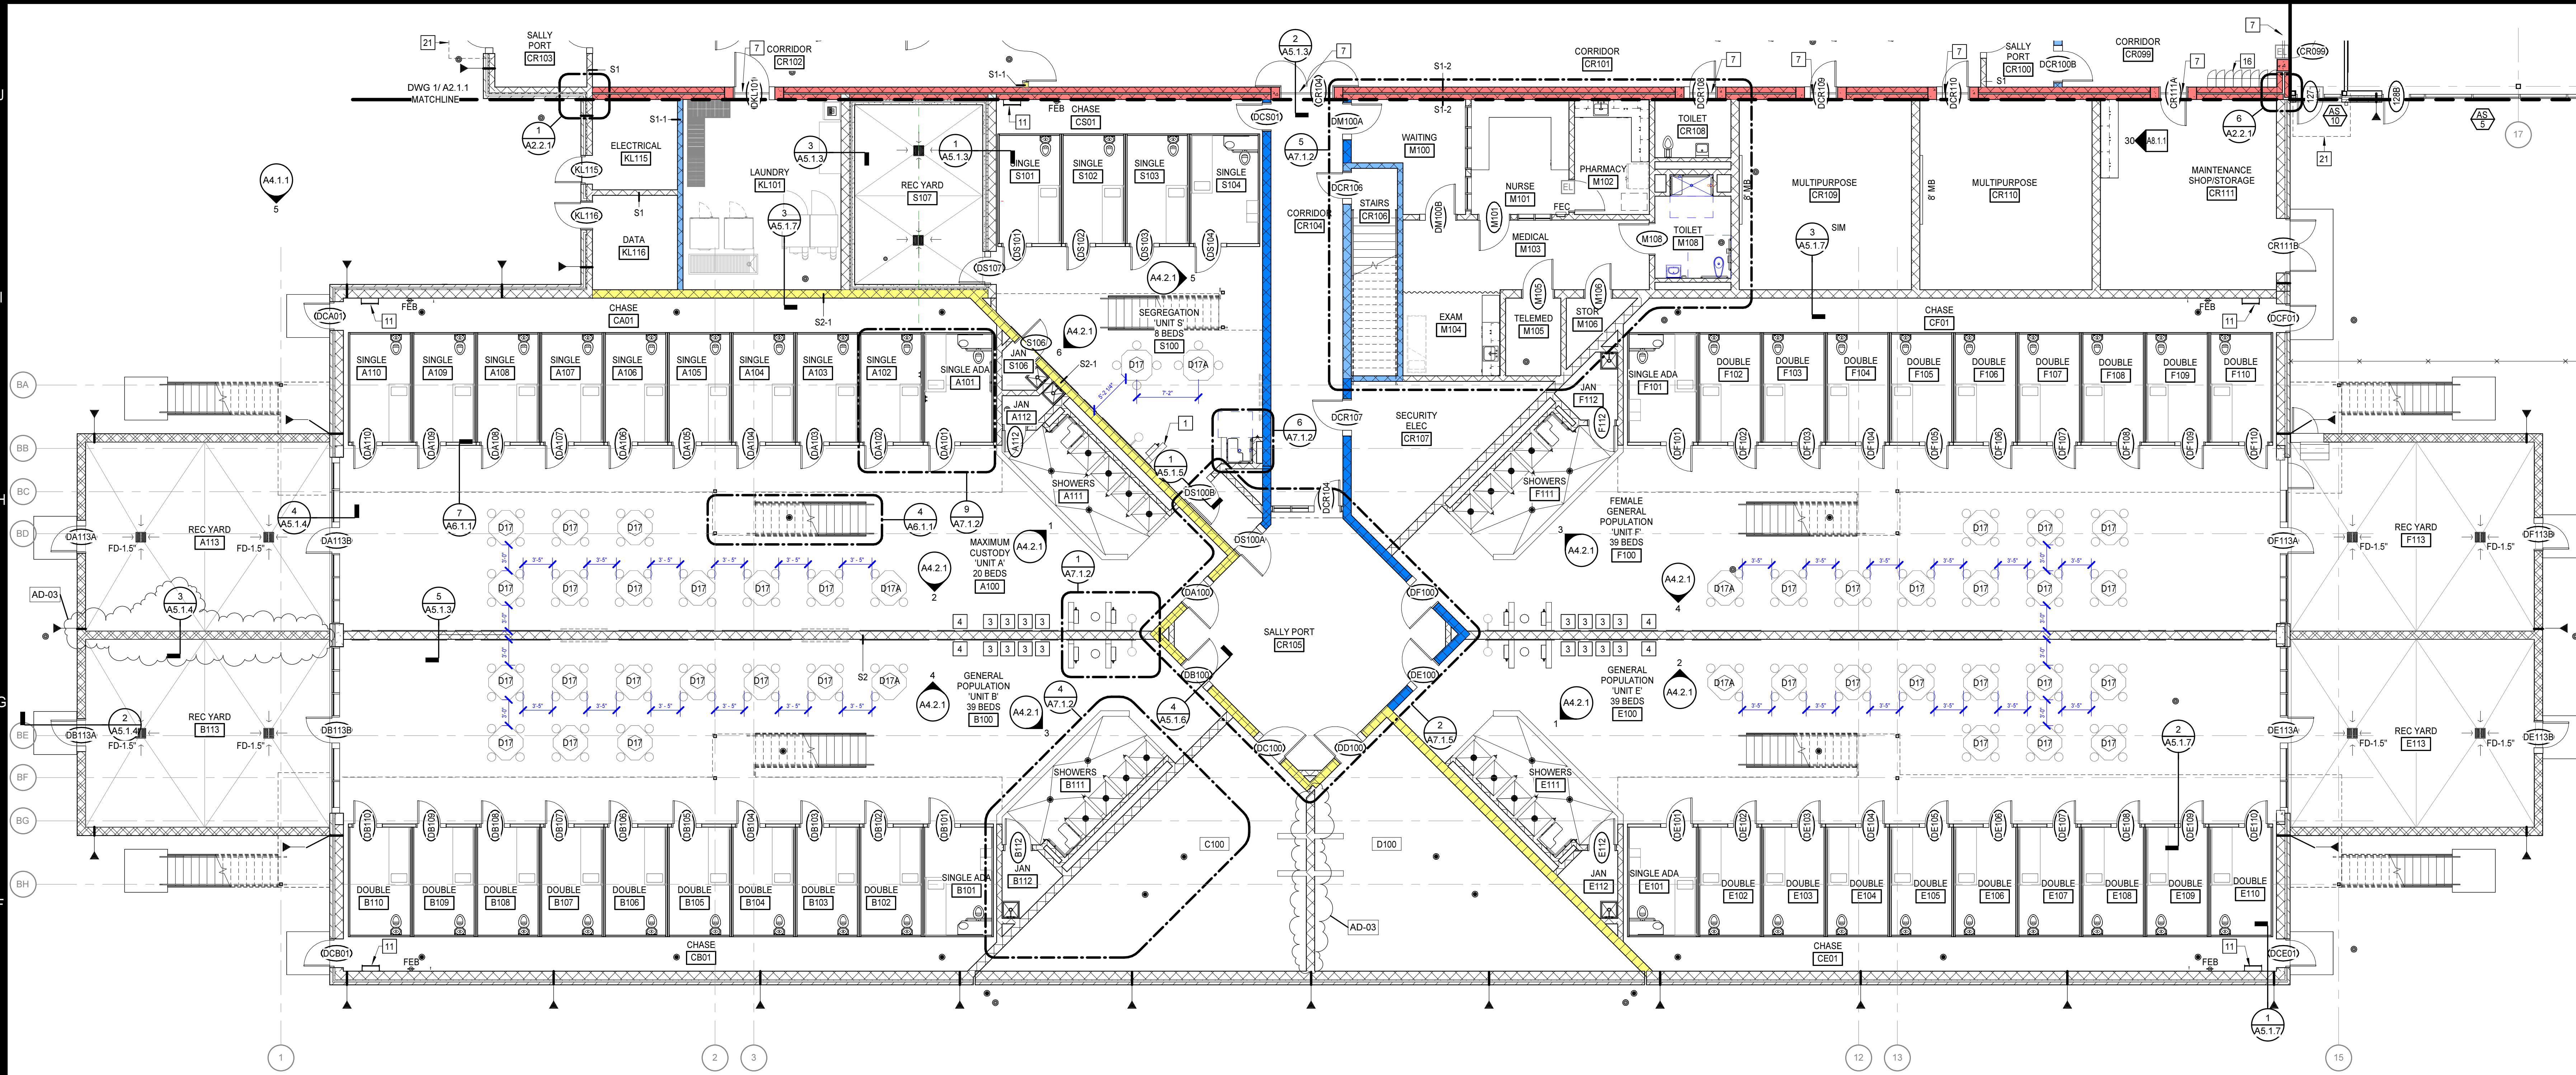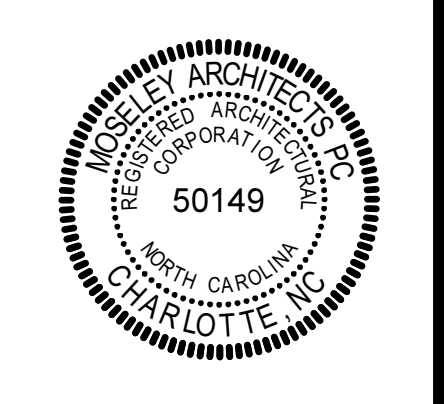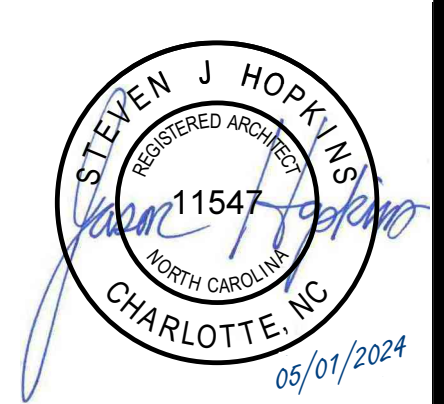


FLOOR PLAN - PART B
 1/8" = 1'-0"

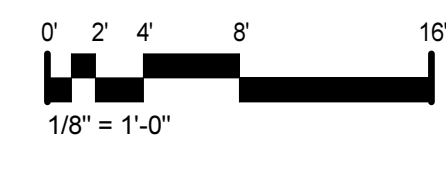

FLOOR PLAN GENERAL NOTES	
A.	PROVIDE CONT. SILICONE CAULK AT ALL DOOR FRAMES WHERE GYP. BOARD AND FRAMES MEET BEFORE PAINTING OCCURS.
B.	PROVIDE PAINTED METAL FINISH ON ALL CEILING AND WALL ACCESS PANELS FOR ACCESS TO MECHANICAL, ELECTRICAL, AND PLUMBING SPACES.
C.	"MIN." FOR DIMENSIONS INDICATED MINIMUM ACCEPTABLE DIMENSION. IF "MIN." DIMENSIONS FALL SHORT OF WHAT IS SHOWN ON DRAWINGS, GC IS TO NOTIFY THE ARCHITECT IMMEDIATELY SO AS TO NOT DELAY THE PROJECT.

FLOOR PLAN KEYNOTES	
APPLIES TO DRAWINGS A2.1.1 - A2.1.7	
REPRESENTED BY [Symbol]	
1	CMU LOW WALL PER DETAIL 1/A5.2.1
2	DOUBLE TIER METAL LOCKERS 15"x15"x72"
3	INMATE PHONE (NIC)
4	KIOSK (NIC)
5	MIRROR - 48"W X 72"H
6	50" MONITOR (NIC) - MOUNT AT 66" AFF TO CENTER OF SCREEN
7	FLOOR EXPANSION JOINT
8	VIDEO VISITATION STATION
9	WALL MOUNTED, STEEL ROOF ACCESS LADDER
10	AUTOMATIC FIRE SHUTTER @ THIS LOCATION
11	WALL MOUNTED CHASE LADDER
12	CHAIN LINK FENCE - EXTEND TO UNDERSIDE OF CEILING
13	MECHANICALLY ASSISTED MOBILE STORAGE SHELVING SYSTEM - REFER TO ELEVATION ON A2 DRAWINGS.
14	WASHER (NIC)
15	DRYER (NIC)
16	FOUR-TIER METAL LOCKERS 12"x12"x72"
17	DOUBLE-TIER PHENOLIC Z-CONFIGURATION LOCKERS 12"x12"x72"
18	DOUBLE TIER METAL LOCKERS 12"x12"x72"
19	PACKAGE PASS - REFER TO DETAIL ON A7.2.1.
20	PASS-THRU EVIDENCE LOCKERS
21	DASHED LINE INDICATES A PRE-MANUFACTURED PROTECTIVE COVER ABOVE
22	REFRIGERATED PASS-THRU LOCKER COMPARTMENT



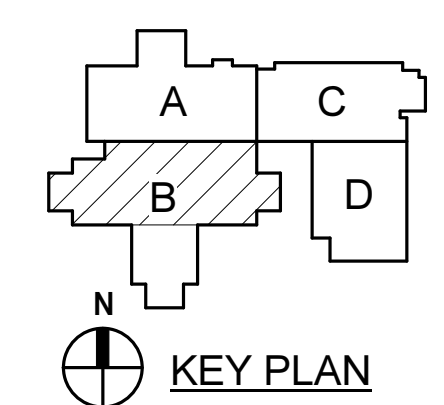


PENDER COUNTY LEC
 DHSR# J-368 / FID# 220537
 PENDER COUNTY, NORTH CAROLINA
 1417 OLD SAVANNAH ROAD BURGAW, NC

DATE	REVISIONS
06/12/24	AD-03

FLOOR PLAN - PART B

A2.1.2

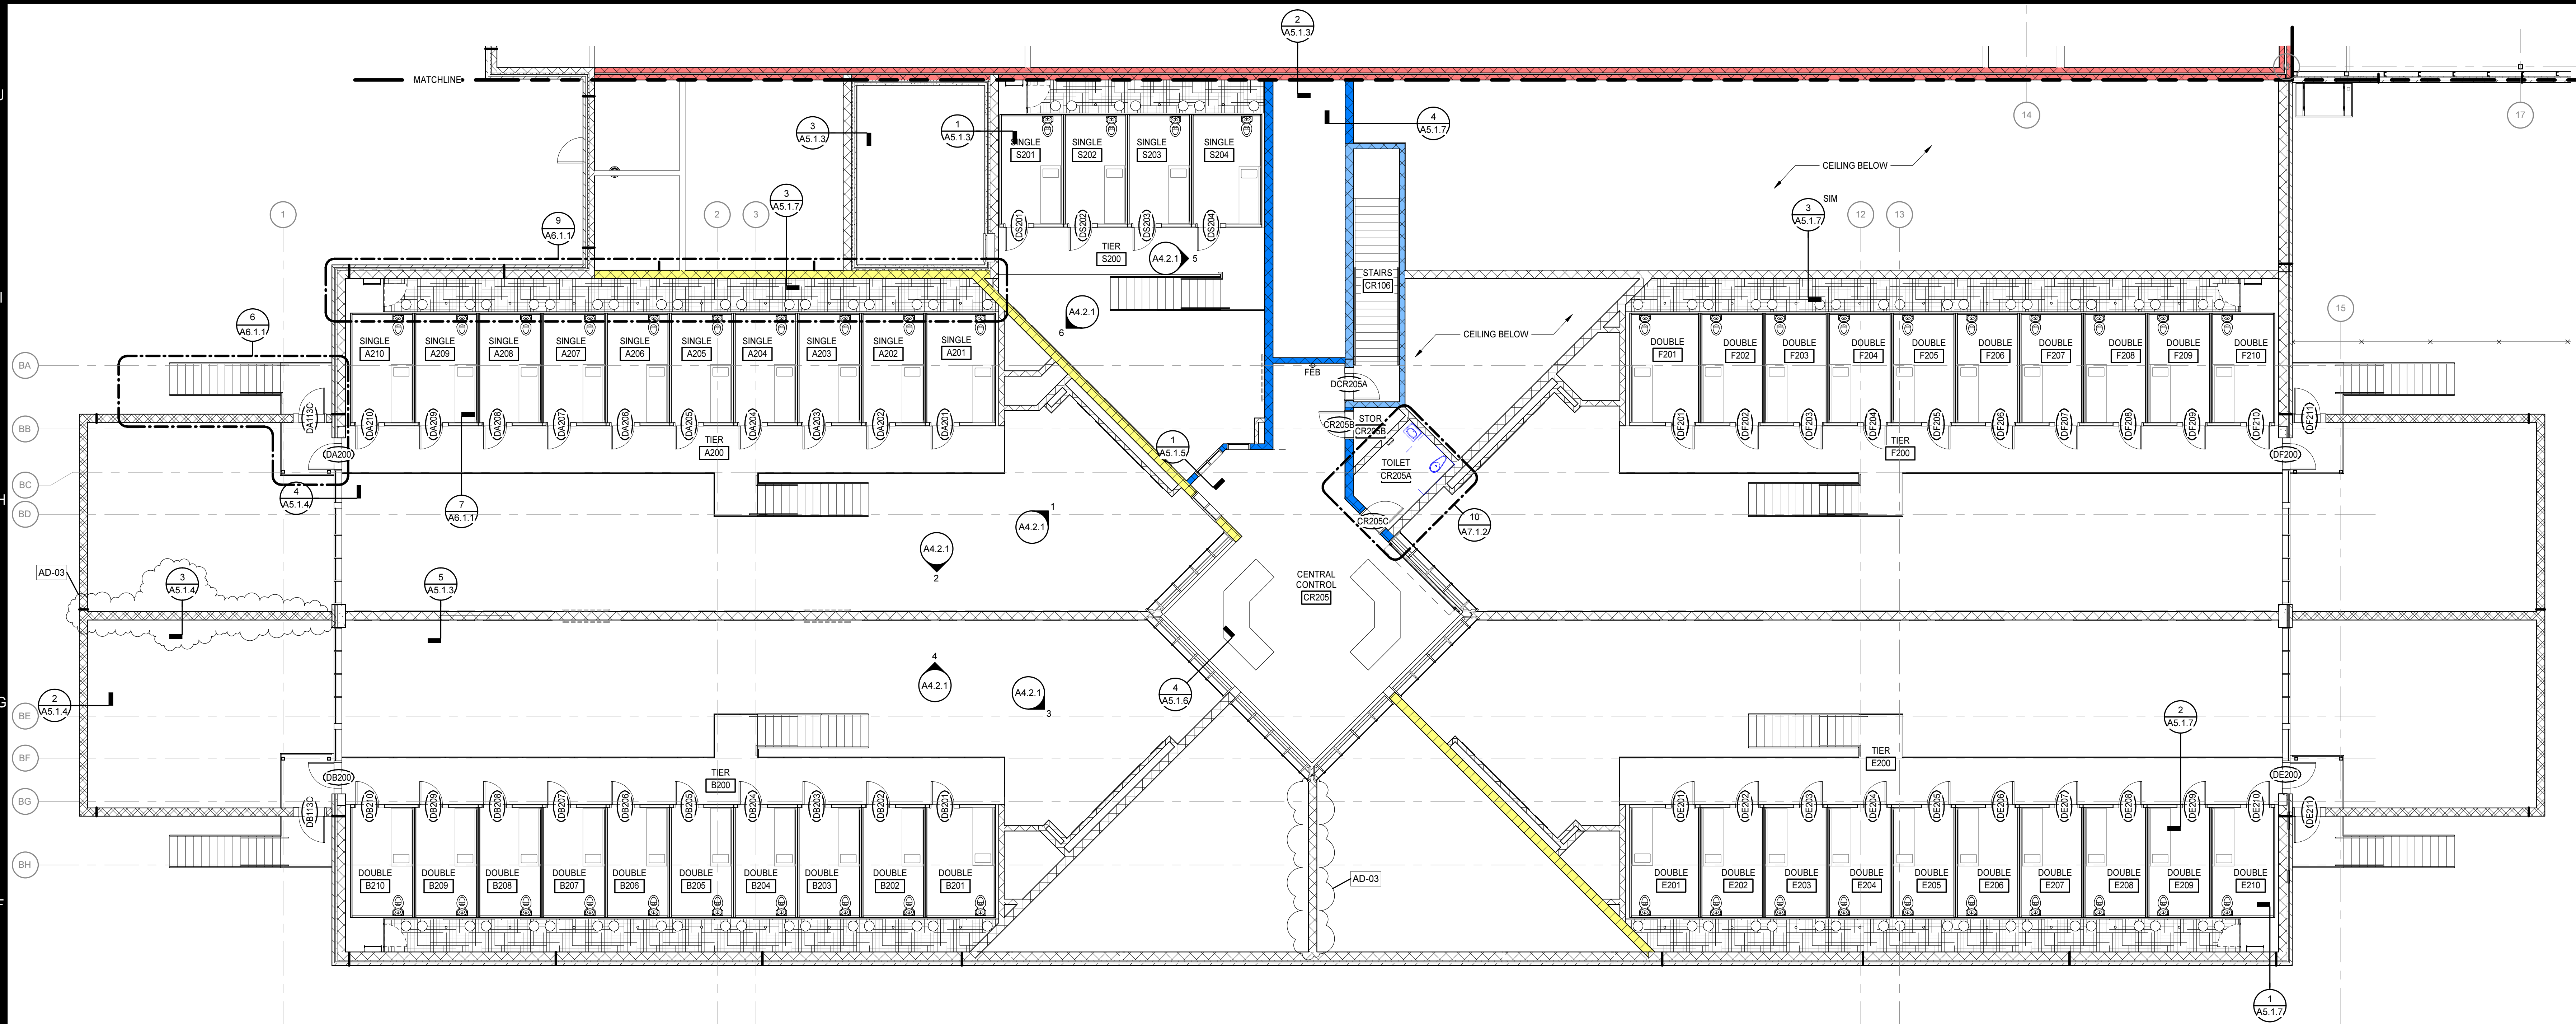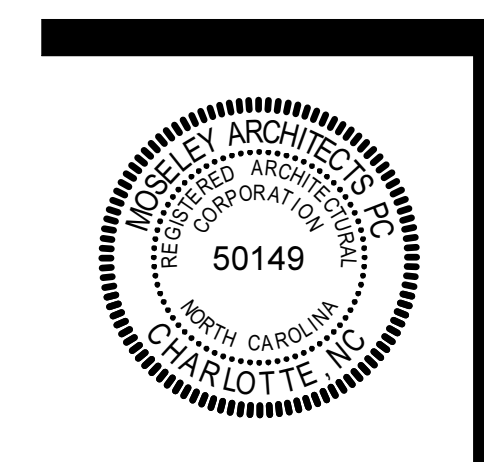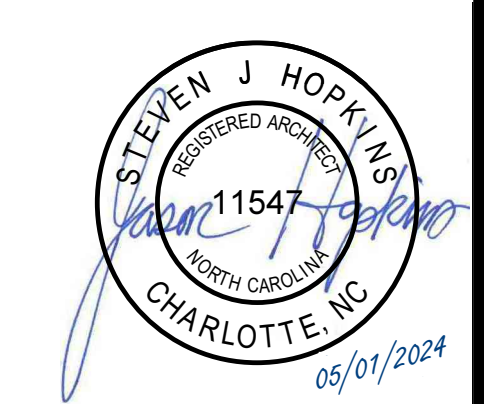


FLOOR PLAN GENERAL NOTES

- A. PROVIDE CONT. SILICONE CAULK AT ALL DOOR FRAMES WHERE GYP. BOARD AND FRAMES MEET BEFORE PAINTING OCCURS.
- B. PROVIDE PAINTED METAL FINISH ON ALL CEILING AND WALL ACCESS PANELS FOR ACCESS TO MECHANICAL, ELECTRICAL, AND PLUMBING SPACES.
- C. "MIN." FOR DIMENSIONS INDICATED MINIMUM ACCEPTABLE DIMENSION. IF "MIN" DIMENSIONS FALL SHORT OF WHAT IS SHOWN ON DRAWINGS, GC IS TO NOTIFY THE ARCHITECT IMMEDIATELY SO AS TO NOT DELAY THE PROJECT.


FLOOR PLAN KEYNOTES

APPLIES TO DRAWINGS A2.1.1 - A2.1.7
 REPRESENTED BY

- 1 CMU LOW WALL PER DETAIL 1/A5.2.1
- 2 DOUBLE TIER METAL LOCKERS 15'x15'x72"
- 3 INMATE PHONE (NIC)
- 4 KIOSK (NIC)
- 5 MIRROR - 48"W X 72"H
- 6 50" MONITOR (NIC) - MOUNT AT 66" AFF TO CENTER OF SCREEN
- 7 FLOOR EXPANSION JOINT
- 8 VIDEO VISITATION STATION
- 9 WALL MOUNTED, STEEL ROOF ACCESS LADDER
- 10 AUTOMATIC FIRE SHUTTER @ THIS LOCATION
- 11 WALL MOUNTED CHASE LADDER
- 12 CHAIN LINK FENCE - EXTEND TO UNDERSIDE OF CEILING
- 13 MECHANICALLY ASSISTED MOBILE STORAGE SHELVING SYSTEM - REFER TO ELEVATION ON A2 DRAWINGS.
- 14 WASHER (NIC)
- 15 DRYER (NIC)
- 16 FOUR-TIER METAL LOCKERS 12'x12'x72"
- 17 DOUBLE-TIER PHENOLIC Z-CONFIGURATION LOCKERS 12'x12'x72"
- 18 DOUBLE TIER METAL LOCKERS 12'x12'x72"
- 19 PACKAGE PASS - REFER TO DETAIL ON A7.2.1.
- 20 PASS-THRU EVIDENCE LOCKERS
- 21 DASHED LINE INDICATES A PRE-MANUFACTURED PROTECTIVE COVER ABOVE
- 22 REFRIGERATED PASS-THRU LOCKER COMPARTMENT

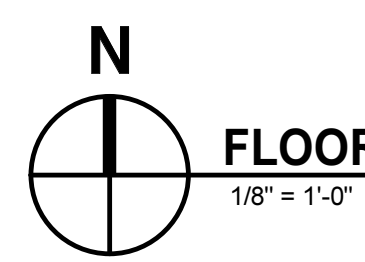

FLOOR PLAN - PART B - TIER LEVEL
 1/8" = 1'-0"



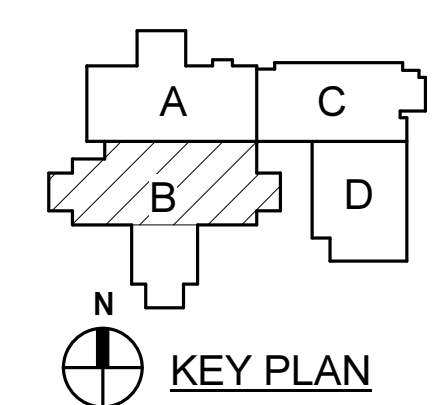


PENDER COUNTY LEC
 DHSR# J-368 / FID# 220537
 PENDER COUNTY, NORTH CAROLINA
 1417 OLD SAVANNAH ROAD BURGAW, NC

DATE	REVISIONS
06/12/24	AD-03

FLOOR PLAN - PART B - TIER LEVEL



A2.1.3

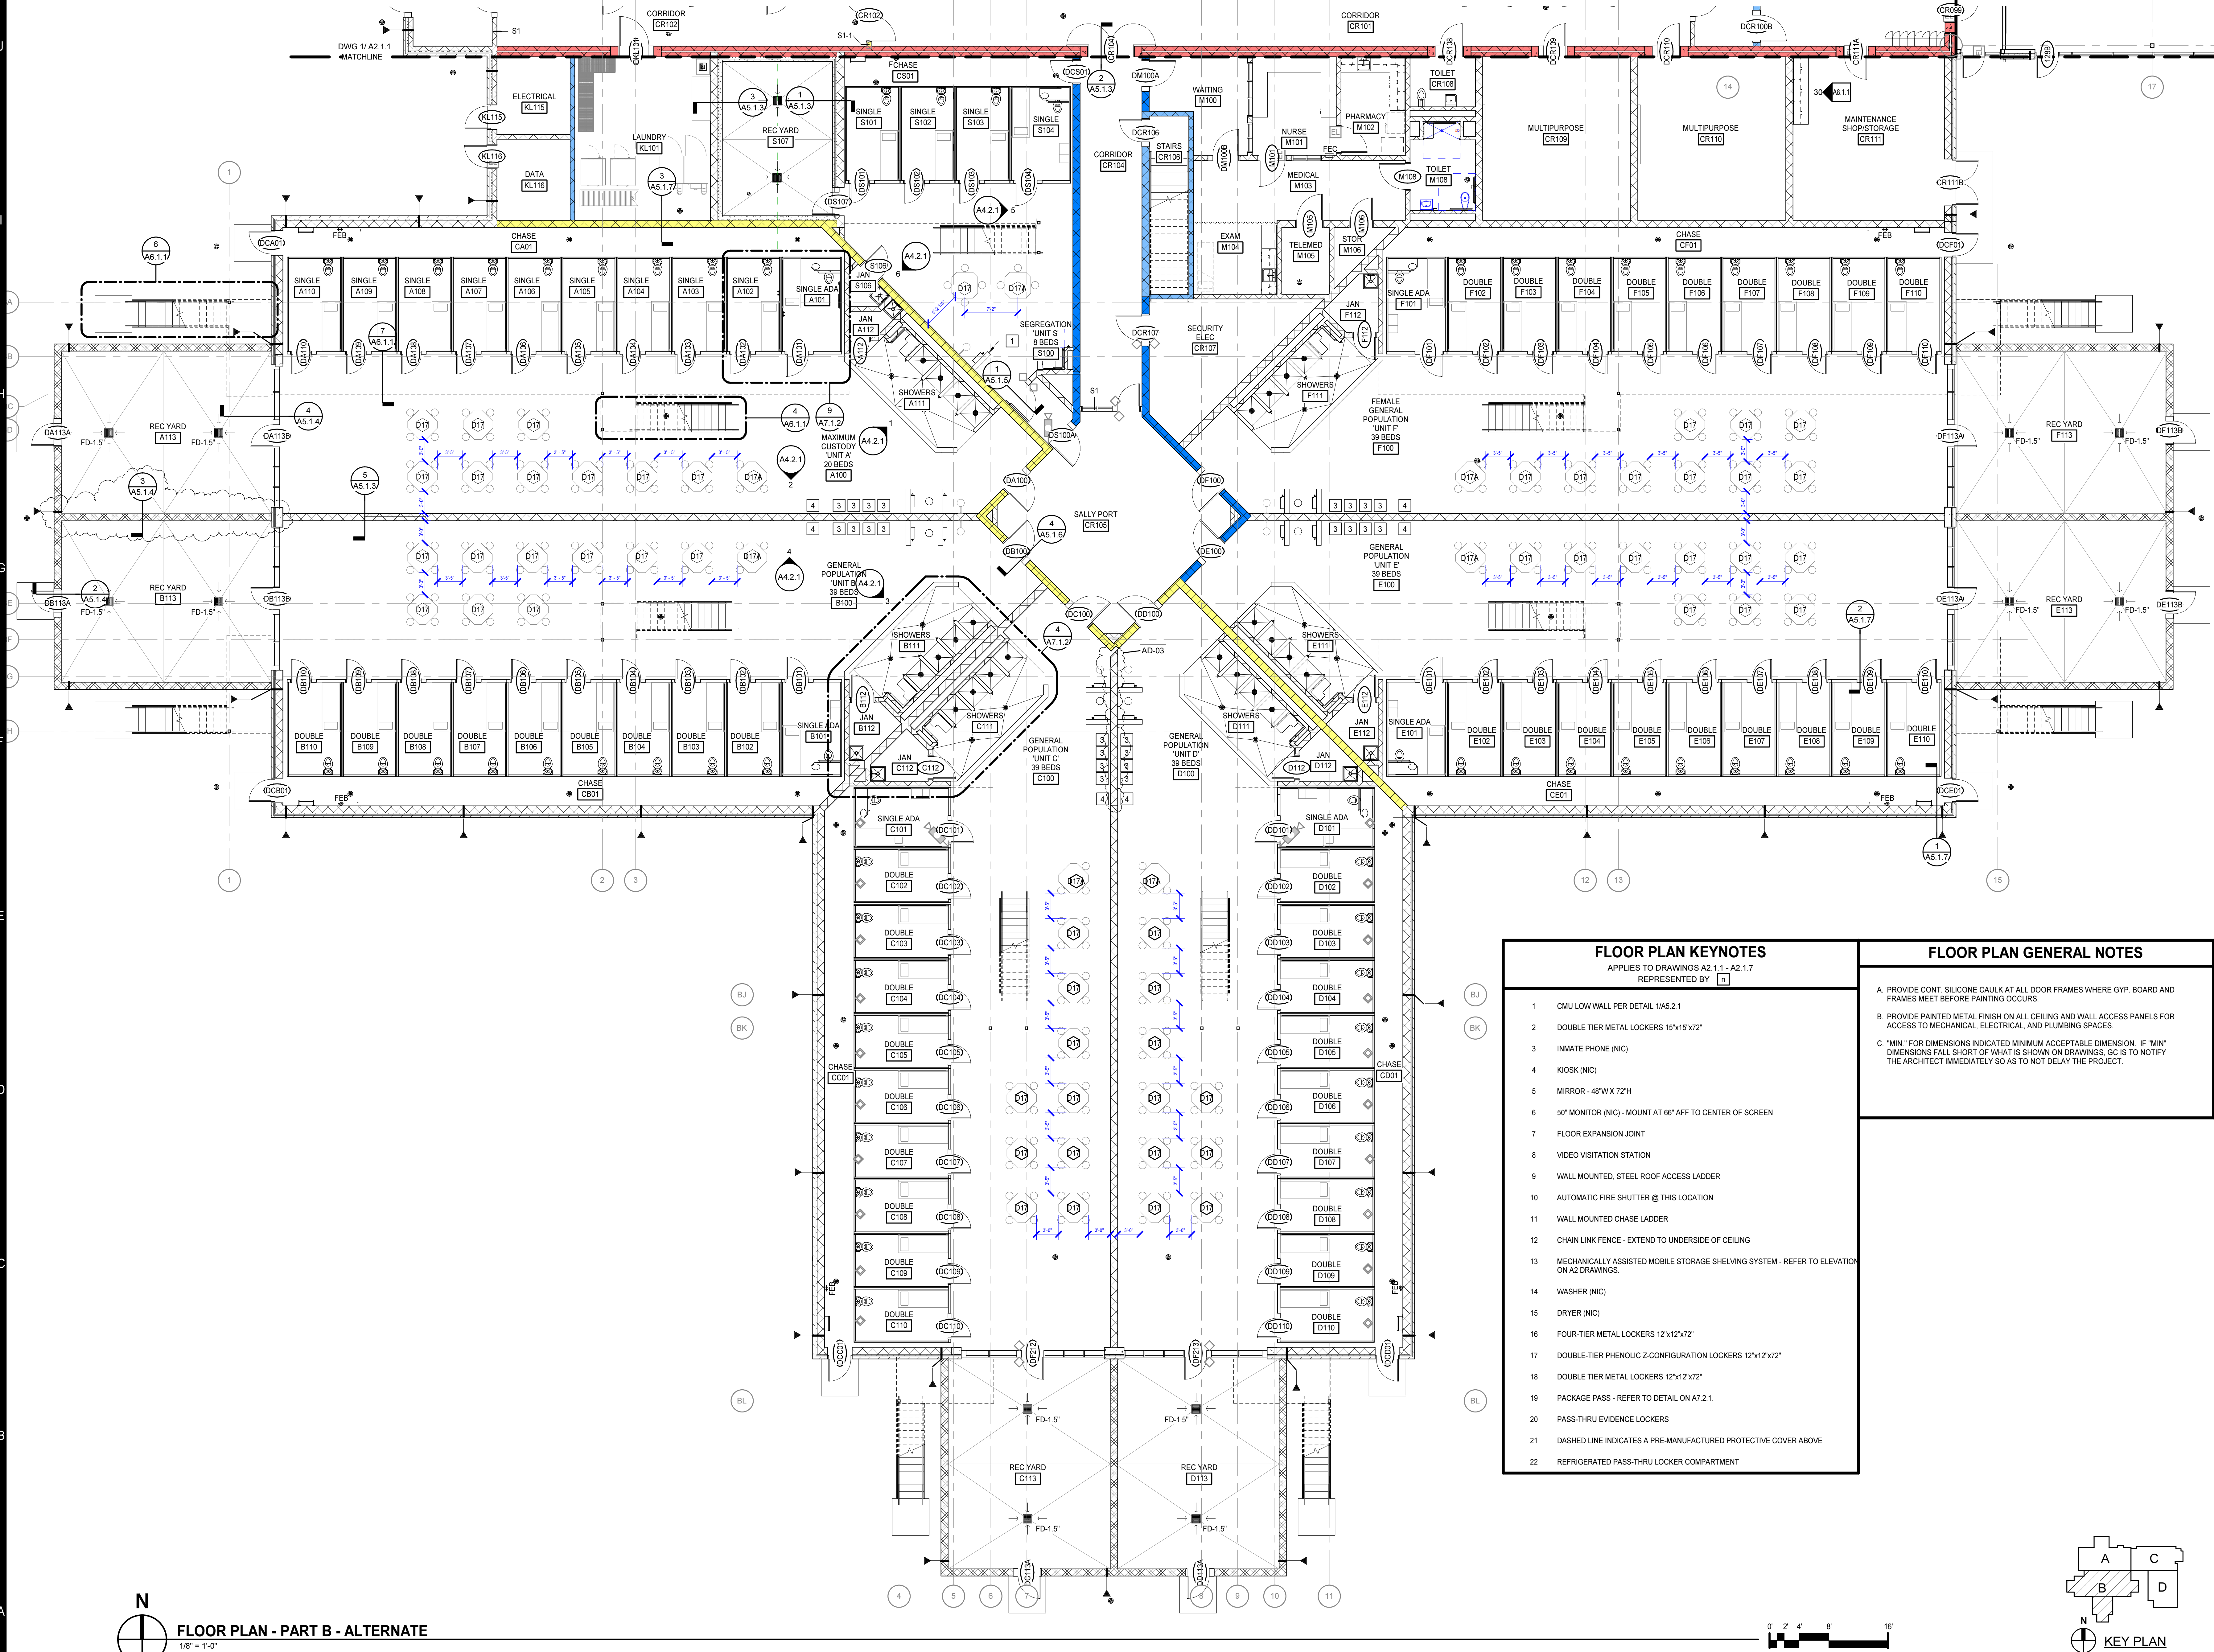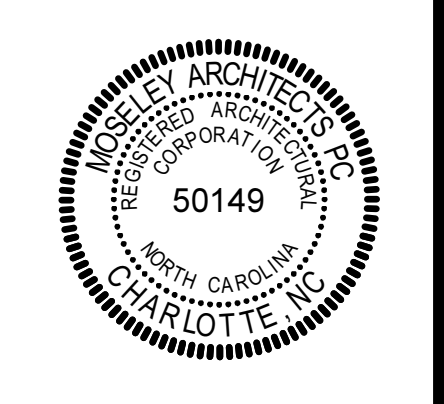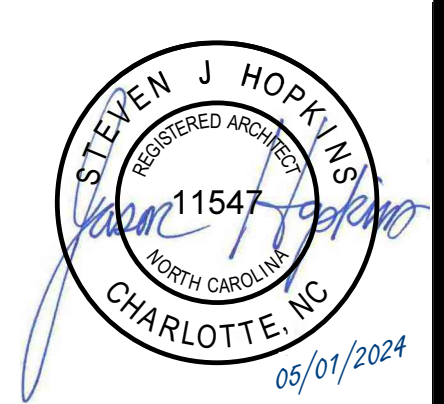

FLOOR PLAN KEYNOTES	
APPLIES TO DRAWINGS A2.1.1 - A2.1.7 REPRESENTED BY [A]	
1	CMU LOW WALL PER DETAIL 1/A5.2.1
2	DOUBLE TIER METAL LOCKERS 15'x15'x72"
3	INMATE PHONE (NIC)
4	KIOSK (NIC)
5	MIRROR - 48"W X 72"H
6	50" MONITOR (NIC) - MOUNT AT 66" AFF TO CENTER OF SCREEN
7	FLOOR EXPANSION JOINT
8	VIDEO VISITATION STATION
9	WALL MOUNTED STEEL ROOF ACCESS LADDER
10	AUTOMATIC FIRE SHUTTER @ THIS LOCATION
11	WALL MOUNTED CHASE LADDER
12	CHAIN LINK FENCE - EXTEND TO UNDERSIDE OF CEILING
13	MECHANICALLY ASSISTED MOBILE STORAGE SHELVING SYSTEM - REFER TO ELEVATION ON A2 DRAWINGS.
14	WASHER (NIC)
15	DRYER (NIC)
16	FOUR-TIER METAL LOCKERS 12'x12'x72"
17	DOUBLE-TIER PHENOLIC Z-CONFIGURATION LOCKERS 12'x12'x72"
18	DOUBLE TIER METAL LOCKERS 12'x12'x72"
19	PACKAGE PASS - REFER TO DETAIL ON A7.2.1
20	PASS-THRU EVIDENCE LOCKERS
21	DASHED LINE INDICATES A PREMANUFACTURED PROTECTIVE COVER ABOVE
22	REFRIGERATED PASS-THRU LOCKER COMPARTMENT

FLOOR PLAN GENERAL NOTES	
A	PROVIDE CONT. SILICONE CAULK AT ALL DOOR FRAMES WHERE GYP. BOARD AND FRAMES MEET BEFORE PAINTING OCCURS.
B	PROVIDE PAINTED METAL FINISH ON ALL CEILING AND WALL ACCESS PANELS FOR ACCESS TO MECHANICAL, ELECTRICAL, AND PLUMBING SPACES.
C	"MIN" FOR DIMENSIONS INDICATED MINIMUM ACCEPTABLE DIMENSION. IF "MIN" DIMENSIONS FALL SHORT OF WHAT IS SHOWN ON DRAWINGS, GC IS TO NOTIFY THE ARCHITECT IMMEDIATELY SO AS TO NOT DELAY THE PROJECT.

FLOOR PLAN - PART B - ALTERNATE
 1/8" = 1'-0"

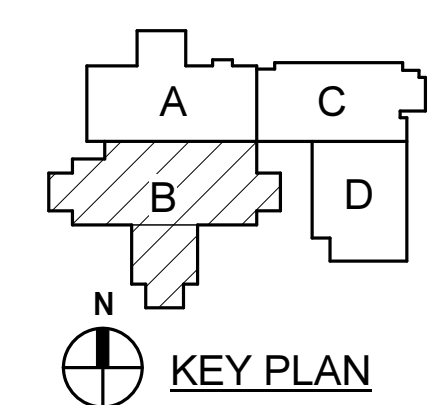
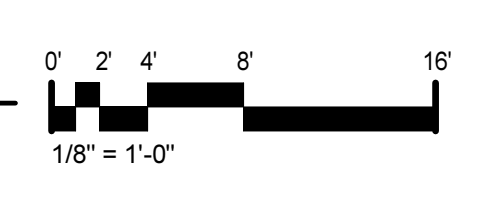


PENDER COUNTY LEC
 DHSR# J-368 / FID# 220537
 PENDER COUNTY, NORTH CAROLINA
 1417 OLD SAVANNAH ROAD BURGAW, NC


DATE	REVISIONS
06/12/24	AD-03

FLOOR PLAN - PART B - ALTERNATE

A2.1.4

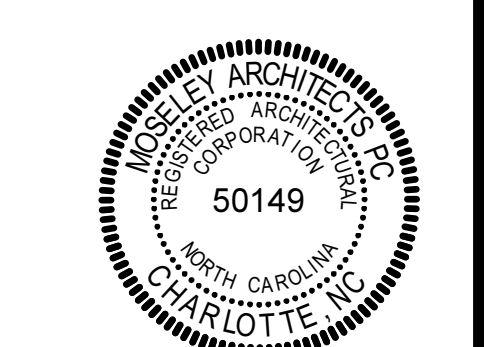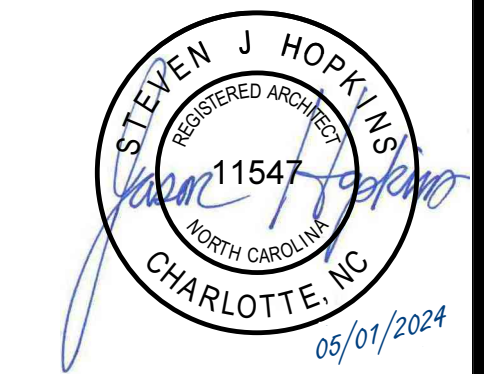

PROJECT NO:	611688
DATE:	05/01/2024
REVISIONS:	
DATE:	DESCRIPTION:
06/12/24	AD-03

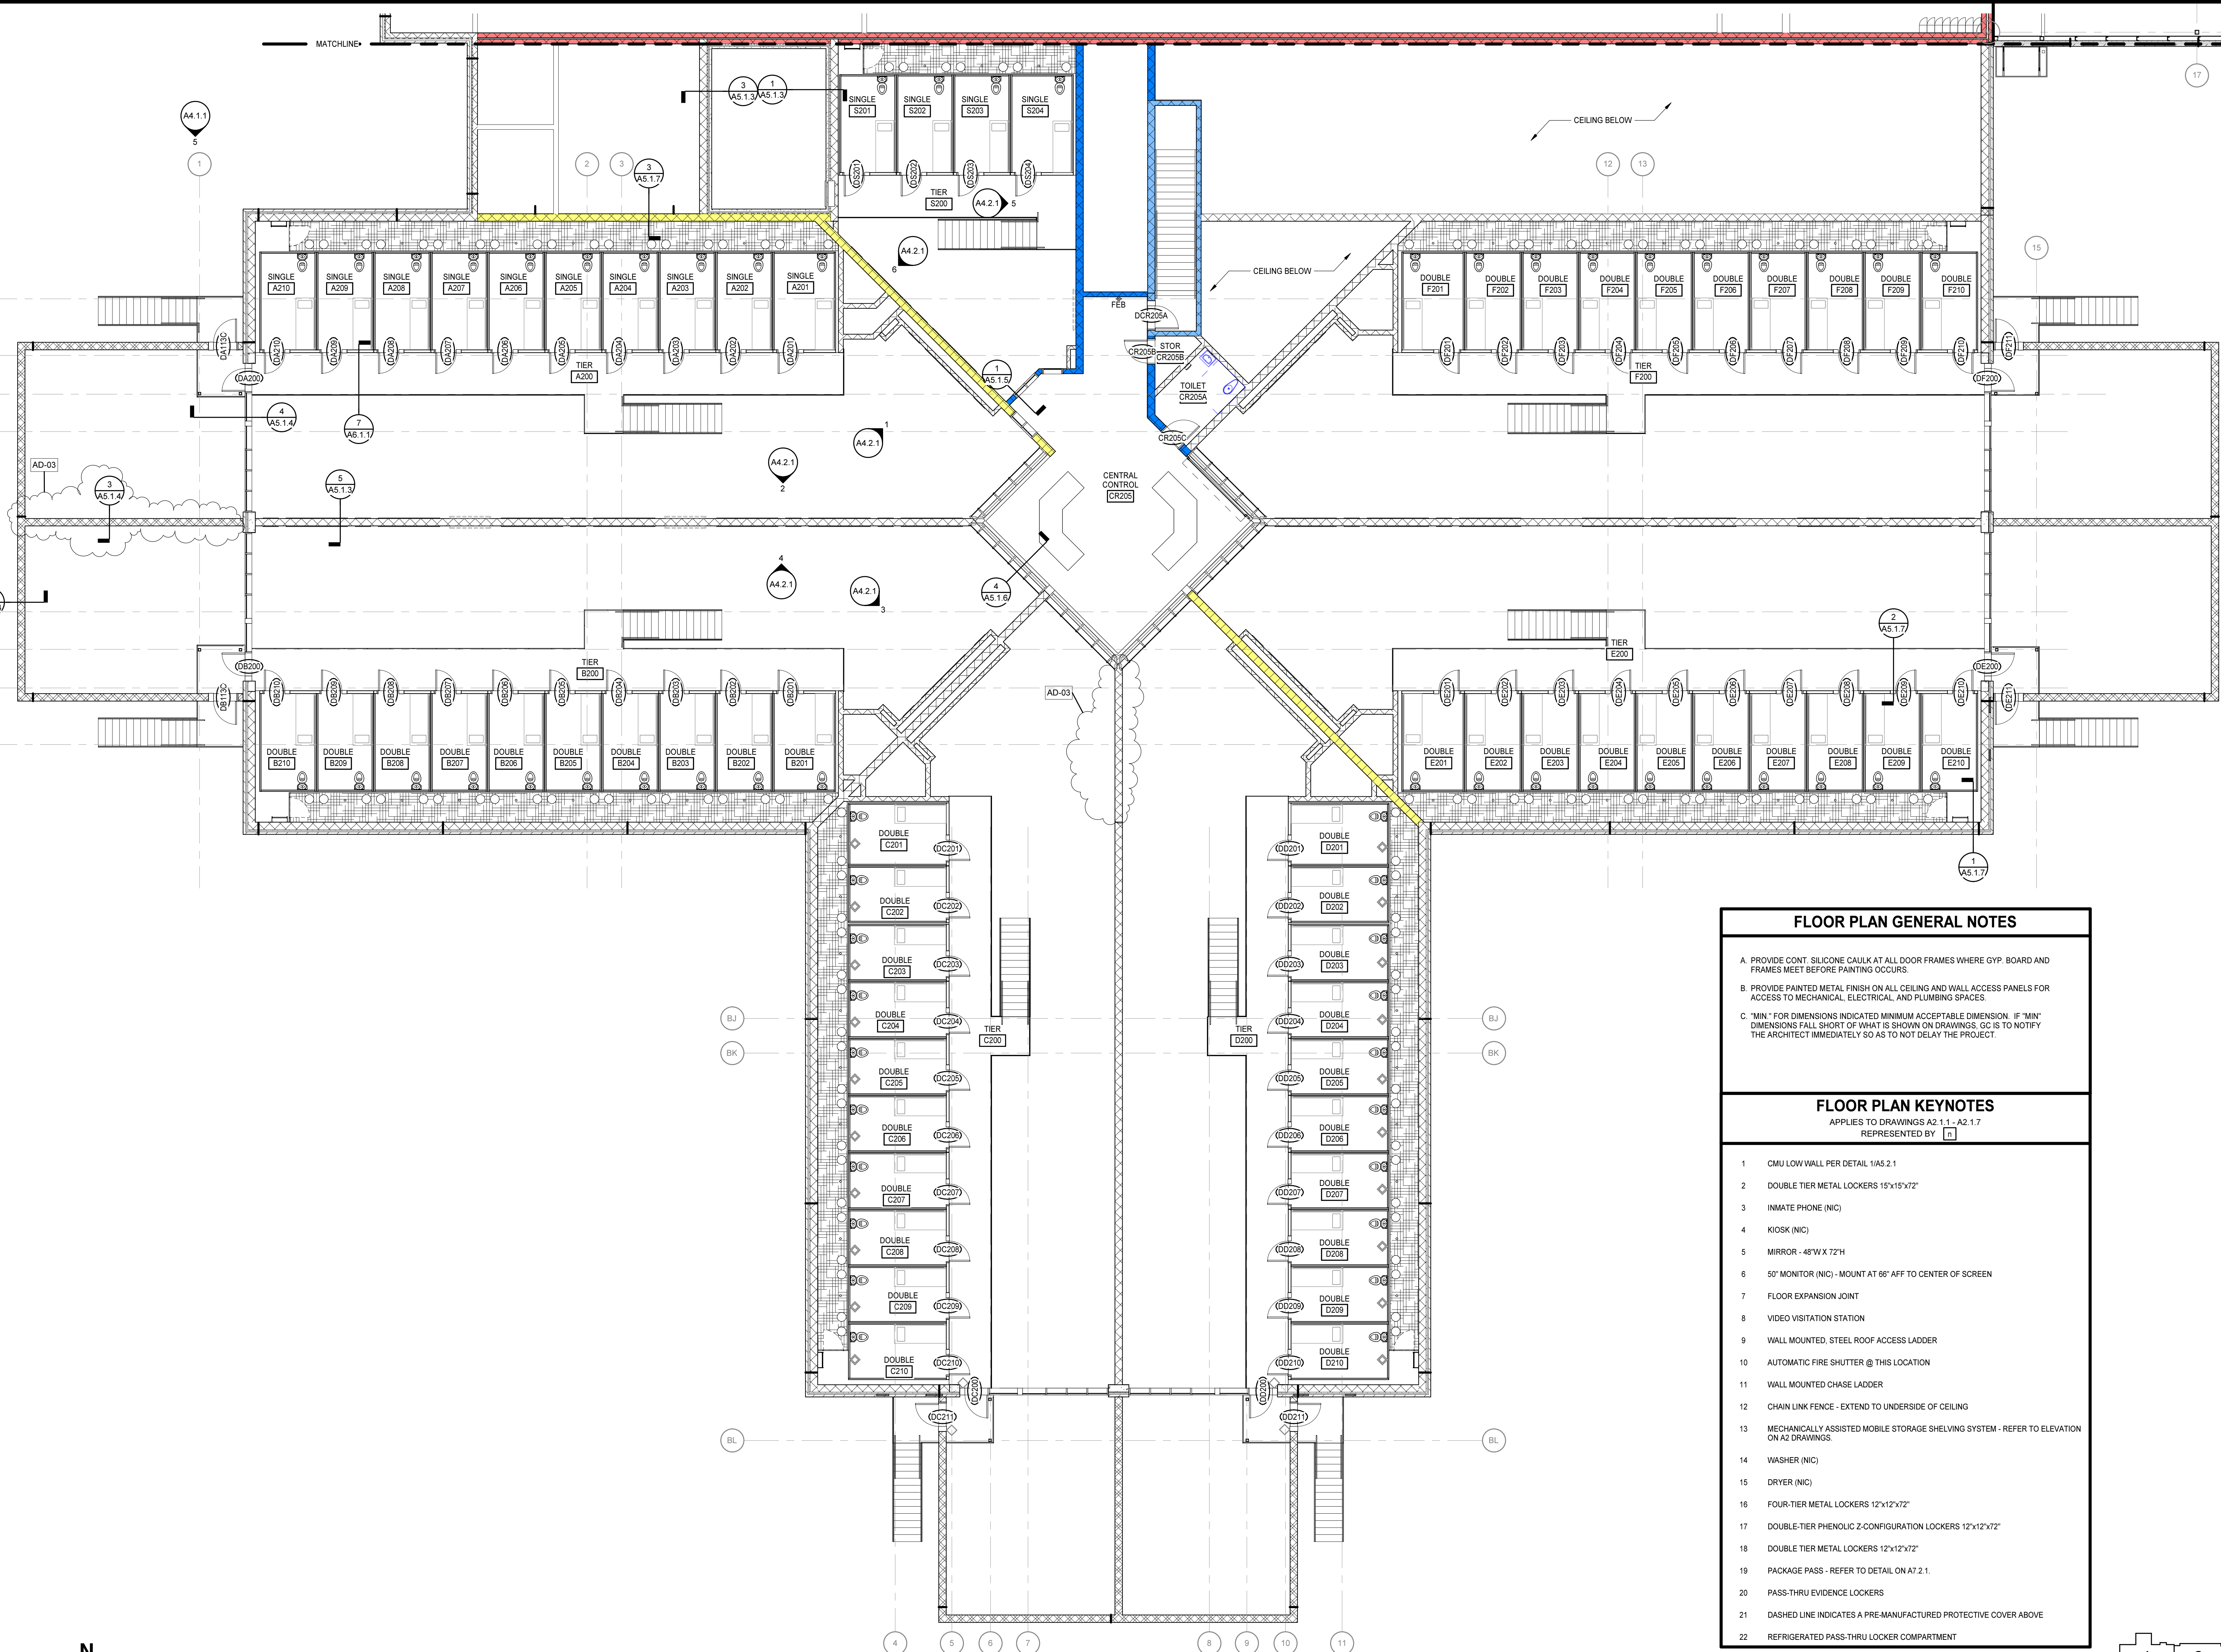

FLOOR PLAN GENERAL NOTES



- A. PROVIDE CONT. SILICONE CAULK AT ALL DOOR FRAMES WHERE GYP. BOARD AND FRAMES MEET BEFORE PAINTING OCCURS.
- B. PROVIDE PAINTED METAL FINISH ON ALL CEILING AND WALL ACCESS PANELS FOR ACCESS TO MECHANICAL, ELECTRICAL, AND PLUMBING SPACES.
- C. "MIN." FOR DIMENSIONS INDICATED MINIMUM ACCEPTABLE DIMENSION. IF "MIN" DIMENSIONS FALL SHORT OF WHAT IS SHOWN ON DRAWINGS, GC IS TO NOTIFY THE ARCHITECT IMMEDIATELY SO AS TO NOT DELAY THE PROJECT.

FLOOR PLAN KEYNOTES

APPLIES TO DRAWINGS A2.1.1 - A2.1.7
 REPRESENTED BY: [Symbol]



- 1 CMU LOW WALL PER DETAIL 1/A5.2.1
- 2 DOUBLE TIER METAL LOCKERS 15'x15'x72"
- 3 INMATE PHONE (NIC)
- 4 KIOSK (NIC)
- 5 MIRROR - 48"W X 72"H
- 6 50" MONITOR (NIC) - MOUNT AT 66" AFF TO CENTER OF SCREEN
- 7 FLOOR EXPANSION JOINT
- 8 VIDEO VISITATION STATION
- 9 WALL MOUNTED, STEEL ROOF ACCESS LADDER
- 10 AUTOMATIC FIRE SHUTTER @ THIS LOCATION
- 11 WALL MOUNTED CHASE LADDER
- 12 CHAIN LINK FENCE - EXTEND TO UNDERSIDE OF CEILING
- 13 MECHANICALLY ASSISTED MOBILE STORAGE SHELVING SYSTEM - REFER TO ELEVATION ON A2 DRAWINGS.
- 14 WASHER (NIC)
- 15 DRYER (NIC)
- 16 FOUR-TIER METAL LOCKERS 12'x12'x72"
- 17 DOUBLE-TIER PHENOLIC Z-CONFIGURATION LOCKERS 12'x12'x72"
- 18 DOUBLE TIER METAL LOCKERS 12'x12'x72"
- 19 PACKAGE PASS - REFER TO DETAIL ON A7.2.1.
- 20 PASS-THRU EVIDENCE LOCKERS
- 21 DASHED LINE INDICATES A PRE-MANUFACTURED PROTECTIVE COVER ABOVE
- 22 REFRIGERATED PASS-THRU LOCKER COMPARTMENT

FLOOR PLAN - PART B - TIER LEVEL
 1/8" = 1'-0"

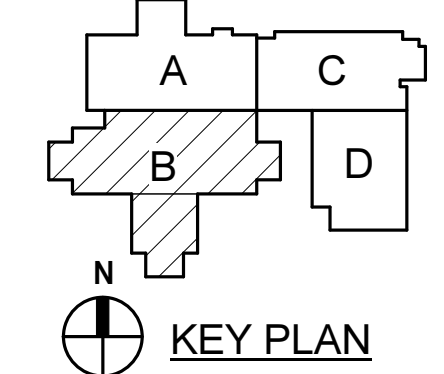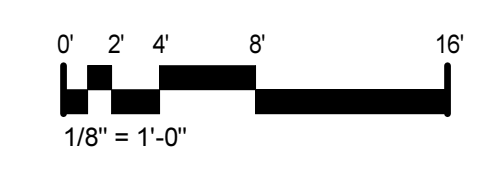


6/7/2024 2:28:56 PM

DIMENSION PLAN - PART B
1/8" = 1'-0"

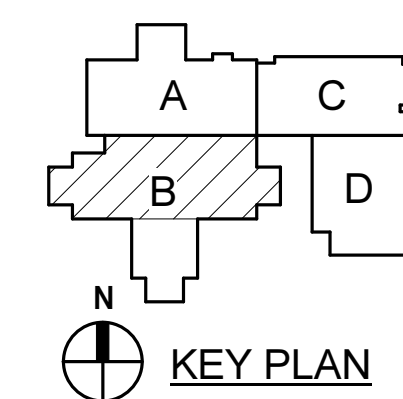
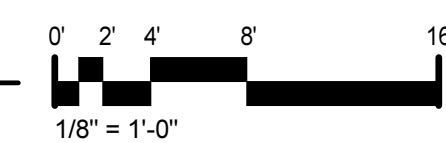


DIMENSION PLAN - PART B

A2.1.12

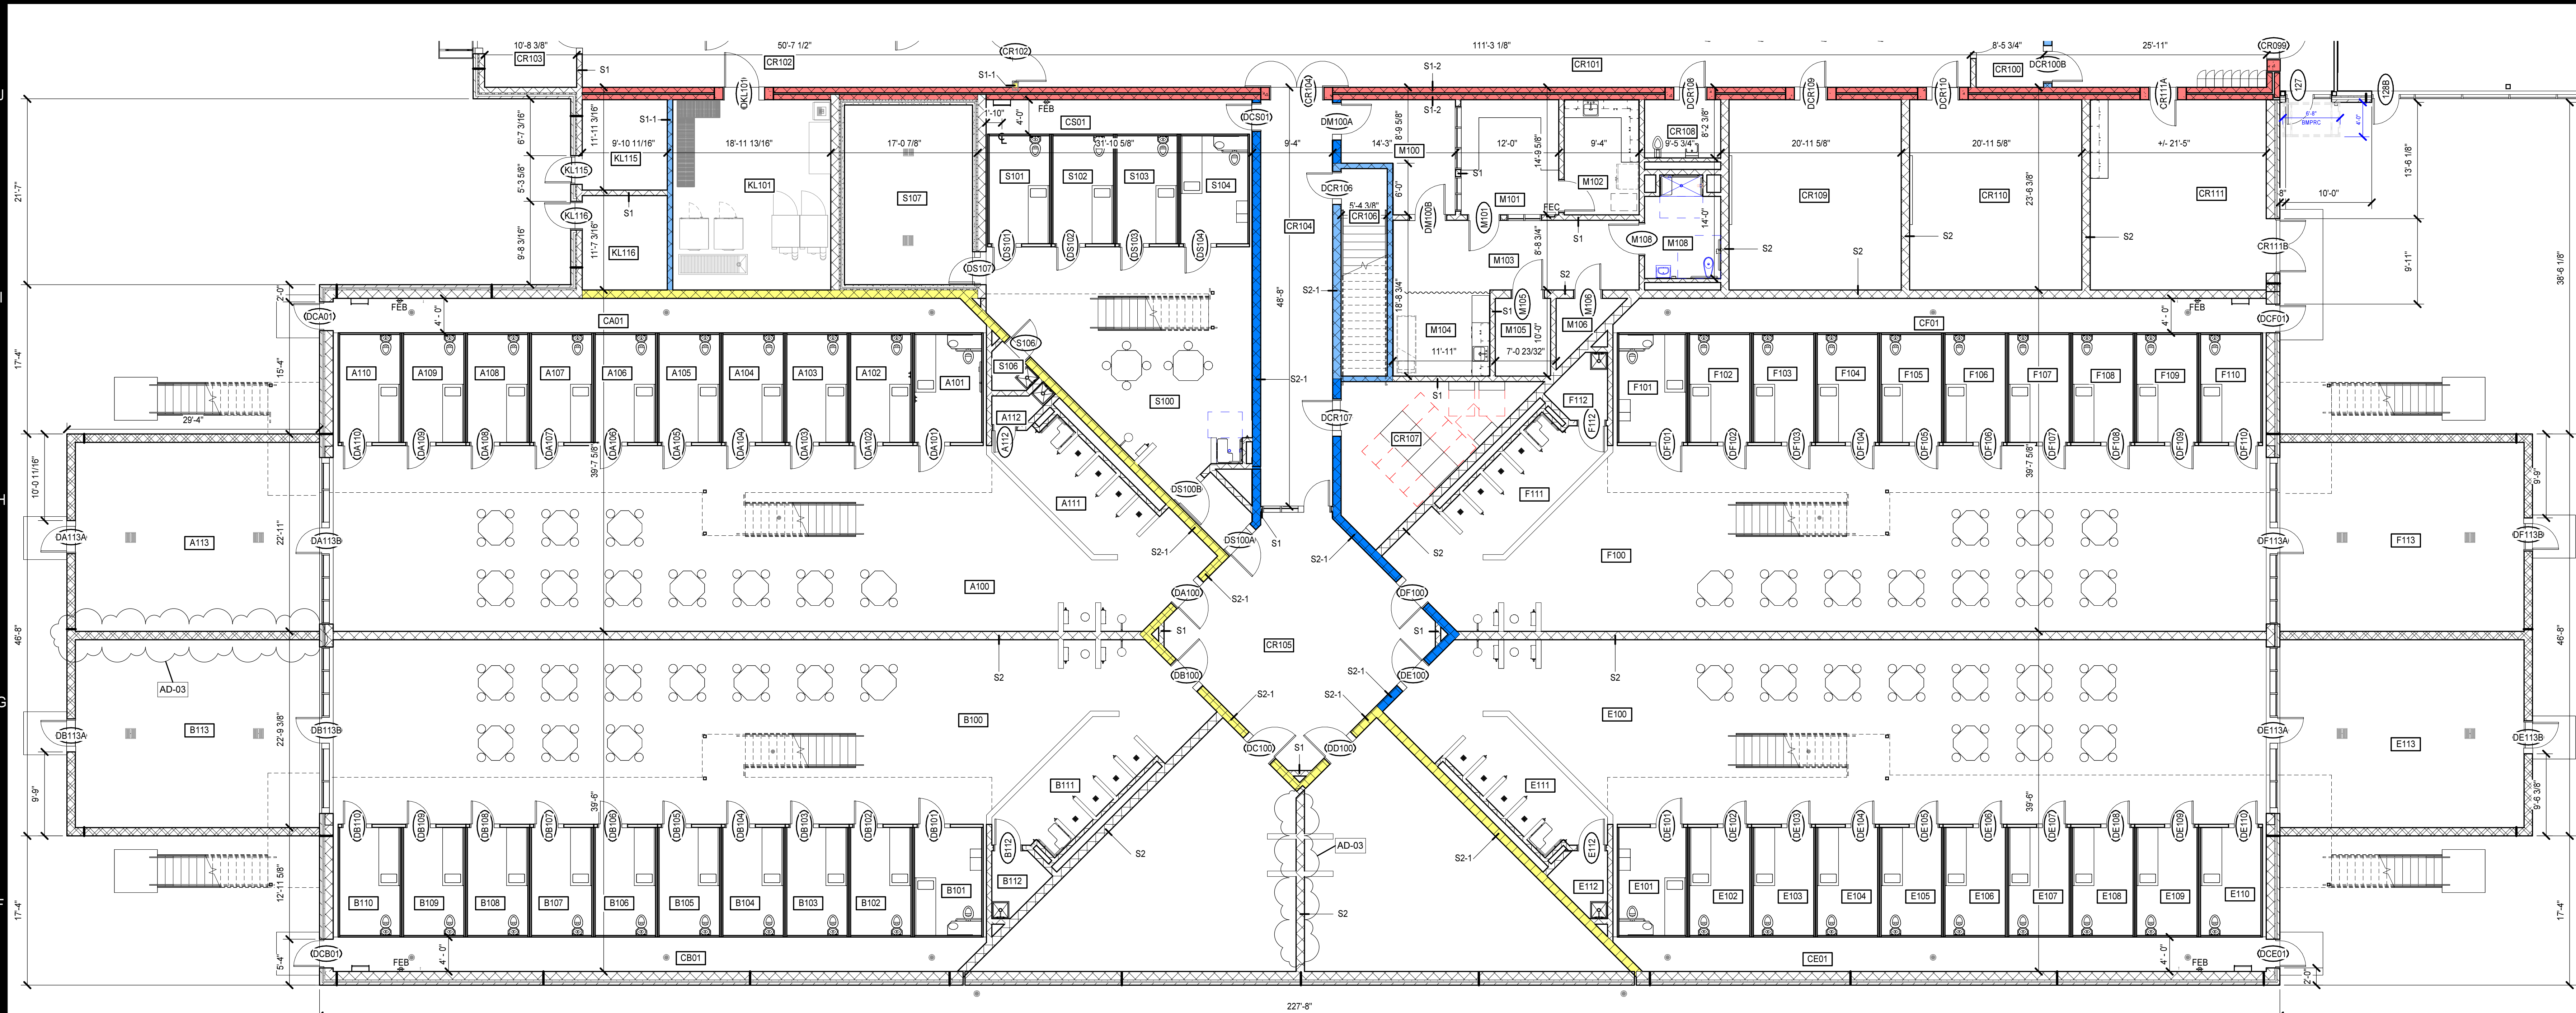


MOSELEY ARCHITECTS
6210 ARDREY KELL ROAD - THE HUB AT WAVERLY, SUITE 425 - CHARLOTTE, NC 28277
PHONE (704) 540-3155 FAX (704) 540-3154
MOSELEYARCHITECTS.COM

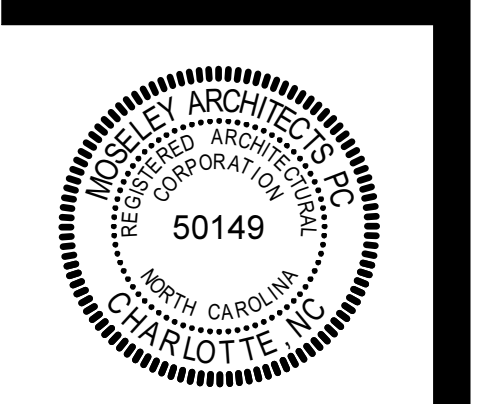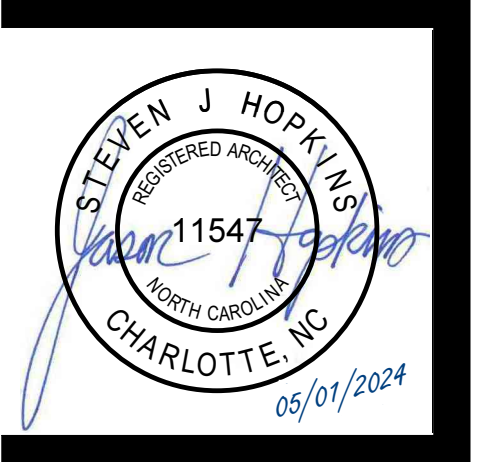

PENDER COUNTY LEC
DHSR# J-368 / FID# 220537
PENDER COUNTY, NORTH CAROLINA
1417 OLD SAVANNAH ROAD BURGAW, NC




PROJECT NO:	611688
DATE:	06/01/2024
REVISIONS:	
DATE:	DESCRIPTION:
06/12/24	AD-03

6/7/2024 2:28:09 PM

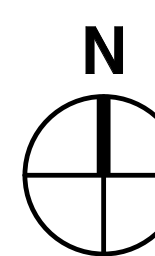



DIMENSION PLAN - PART B - TIER LEVEL

1/8" = 1'-0"

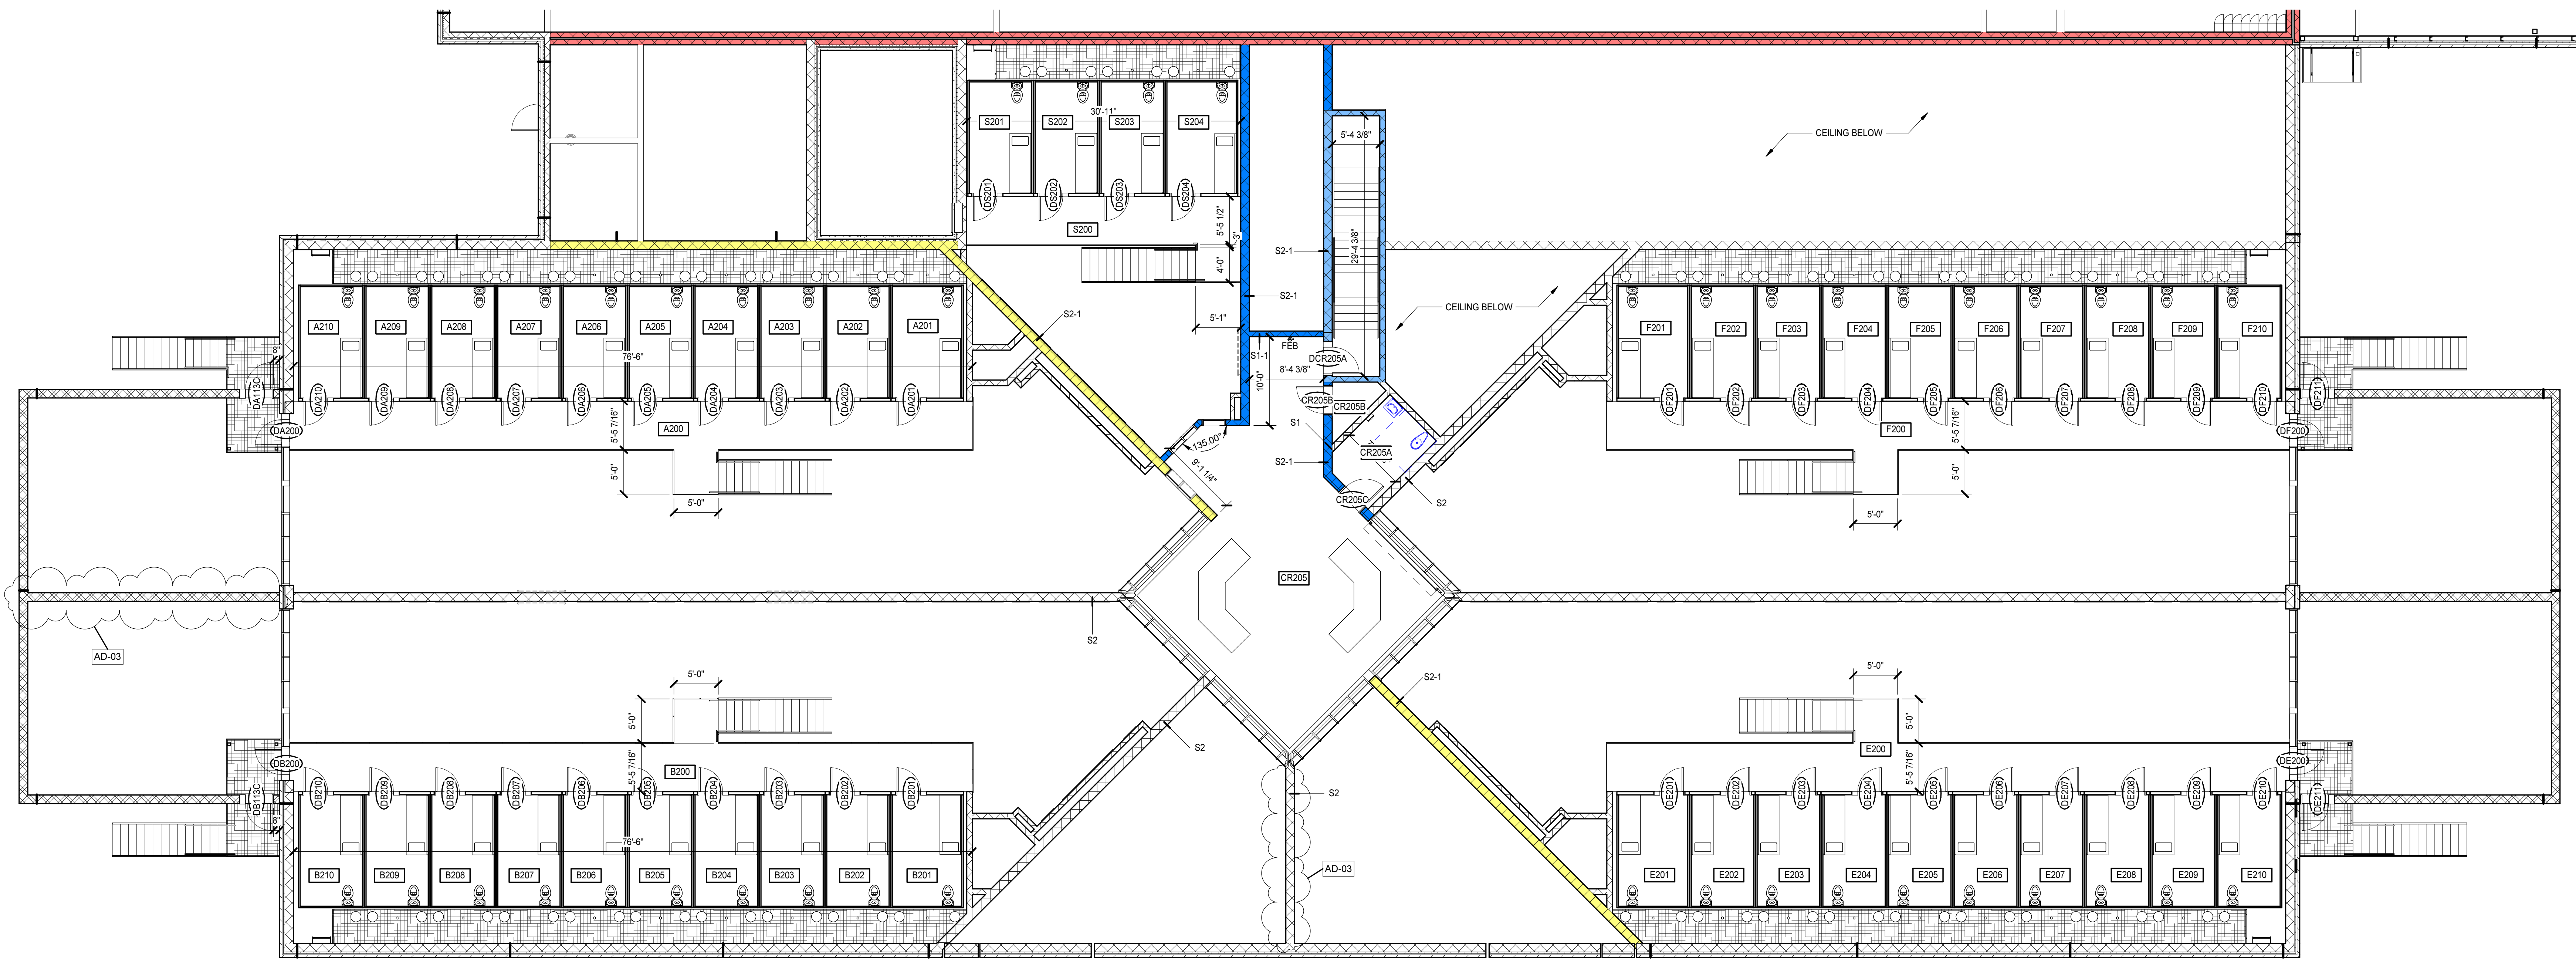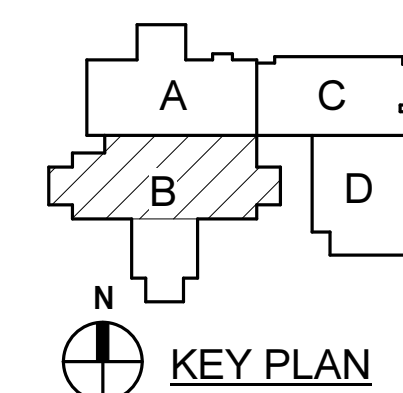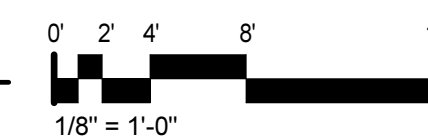

MOSELEYARCHITECTS

6210 ARDREY KELL ROAD - THE HUB AT WAVERLY, SUITE 425 - CHARLOTTE, NC 28277
PHONE (704) 540-3155 FAX (704) 540-3154
MOSELEYARCHITECTS.COM

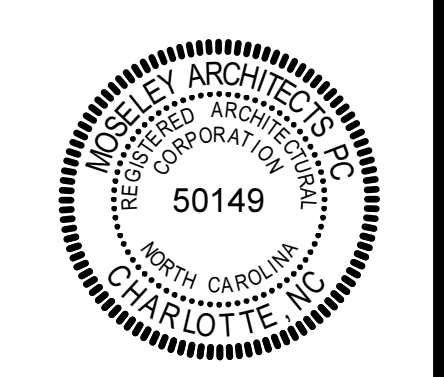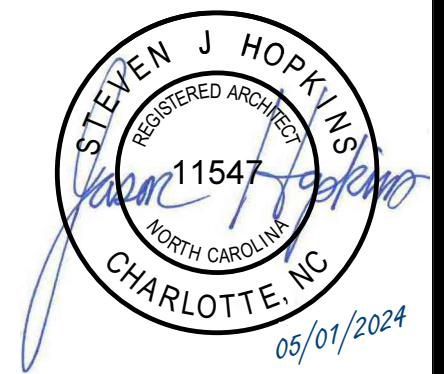

PENDER COUNTY LEC
DHSR# J-368 / FID# 220537
PENDER COUNTY, NORTH CAROLINA
1417 OLD SAVANNAH ROAD BURGAW, NC

PROJECT NO:	611688
DATE:	06/01/2024
REVISIONS	
DATE	DESCRIPTION
06/12/24	AD-03

DIMENSION PLAN - PART B - TIER LEVEL




A2.1.13

6/7/2024 2:29:27 PM





DIMENSION PLAN - PART B - ALTERNATE

1/8" = 1'-0"

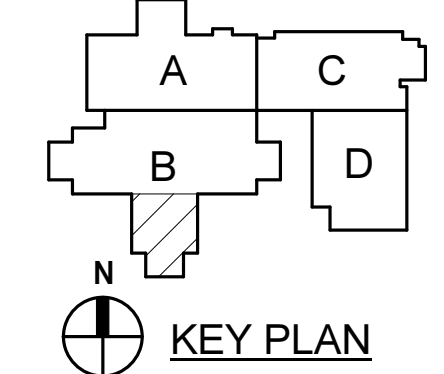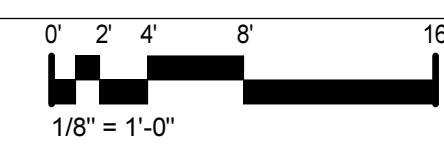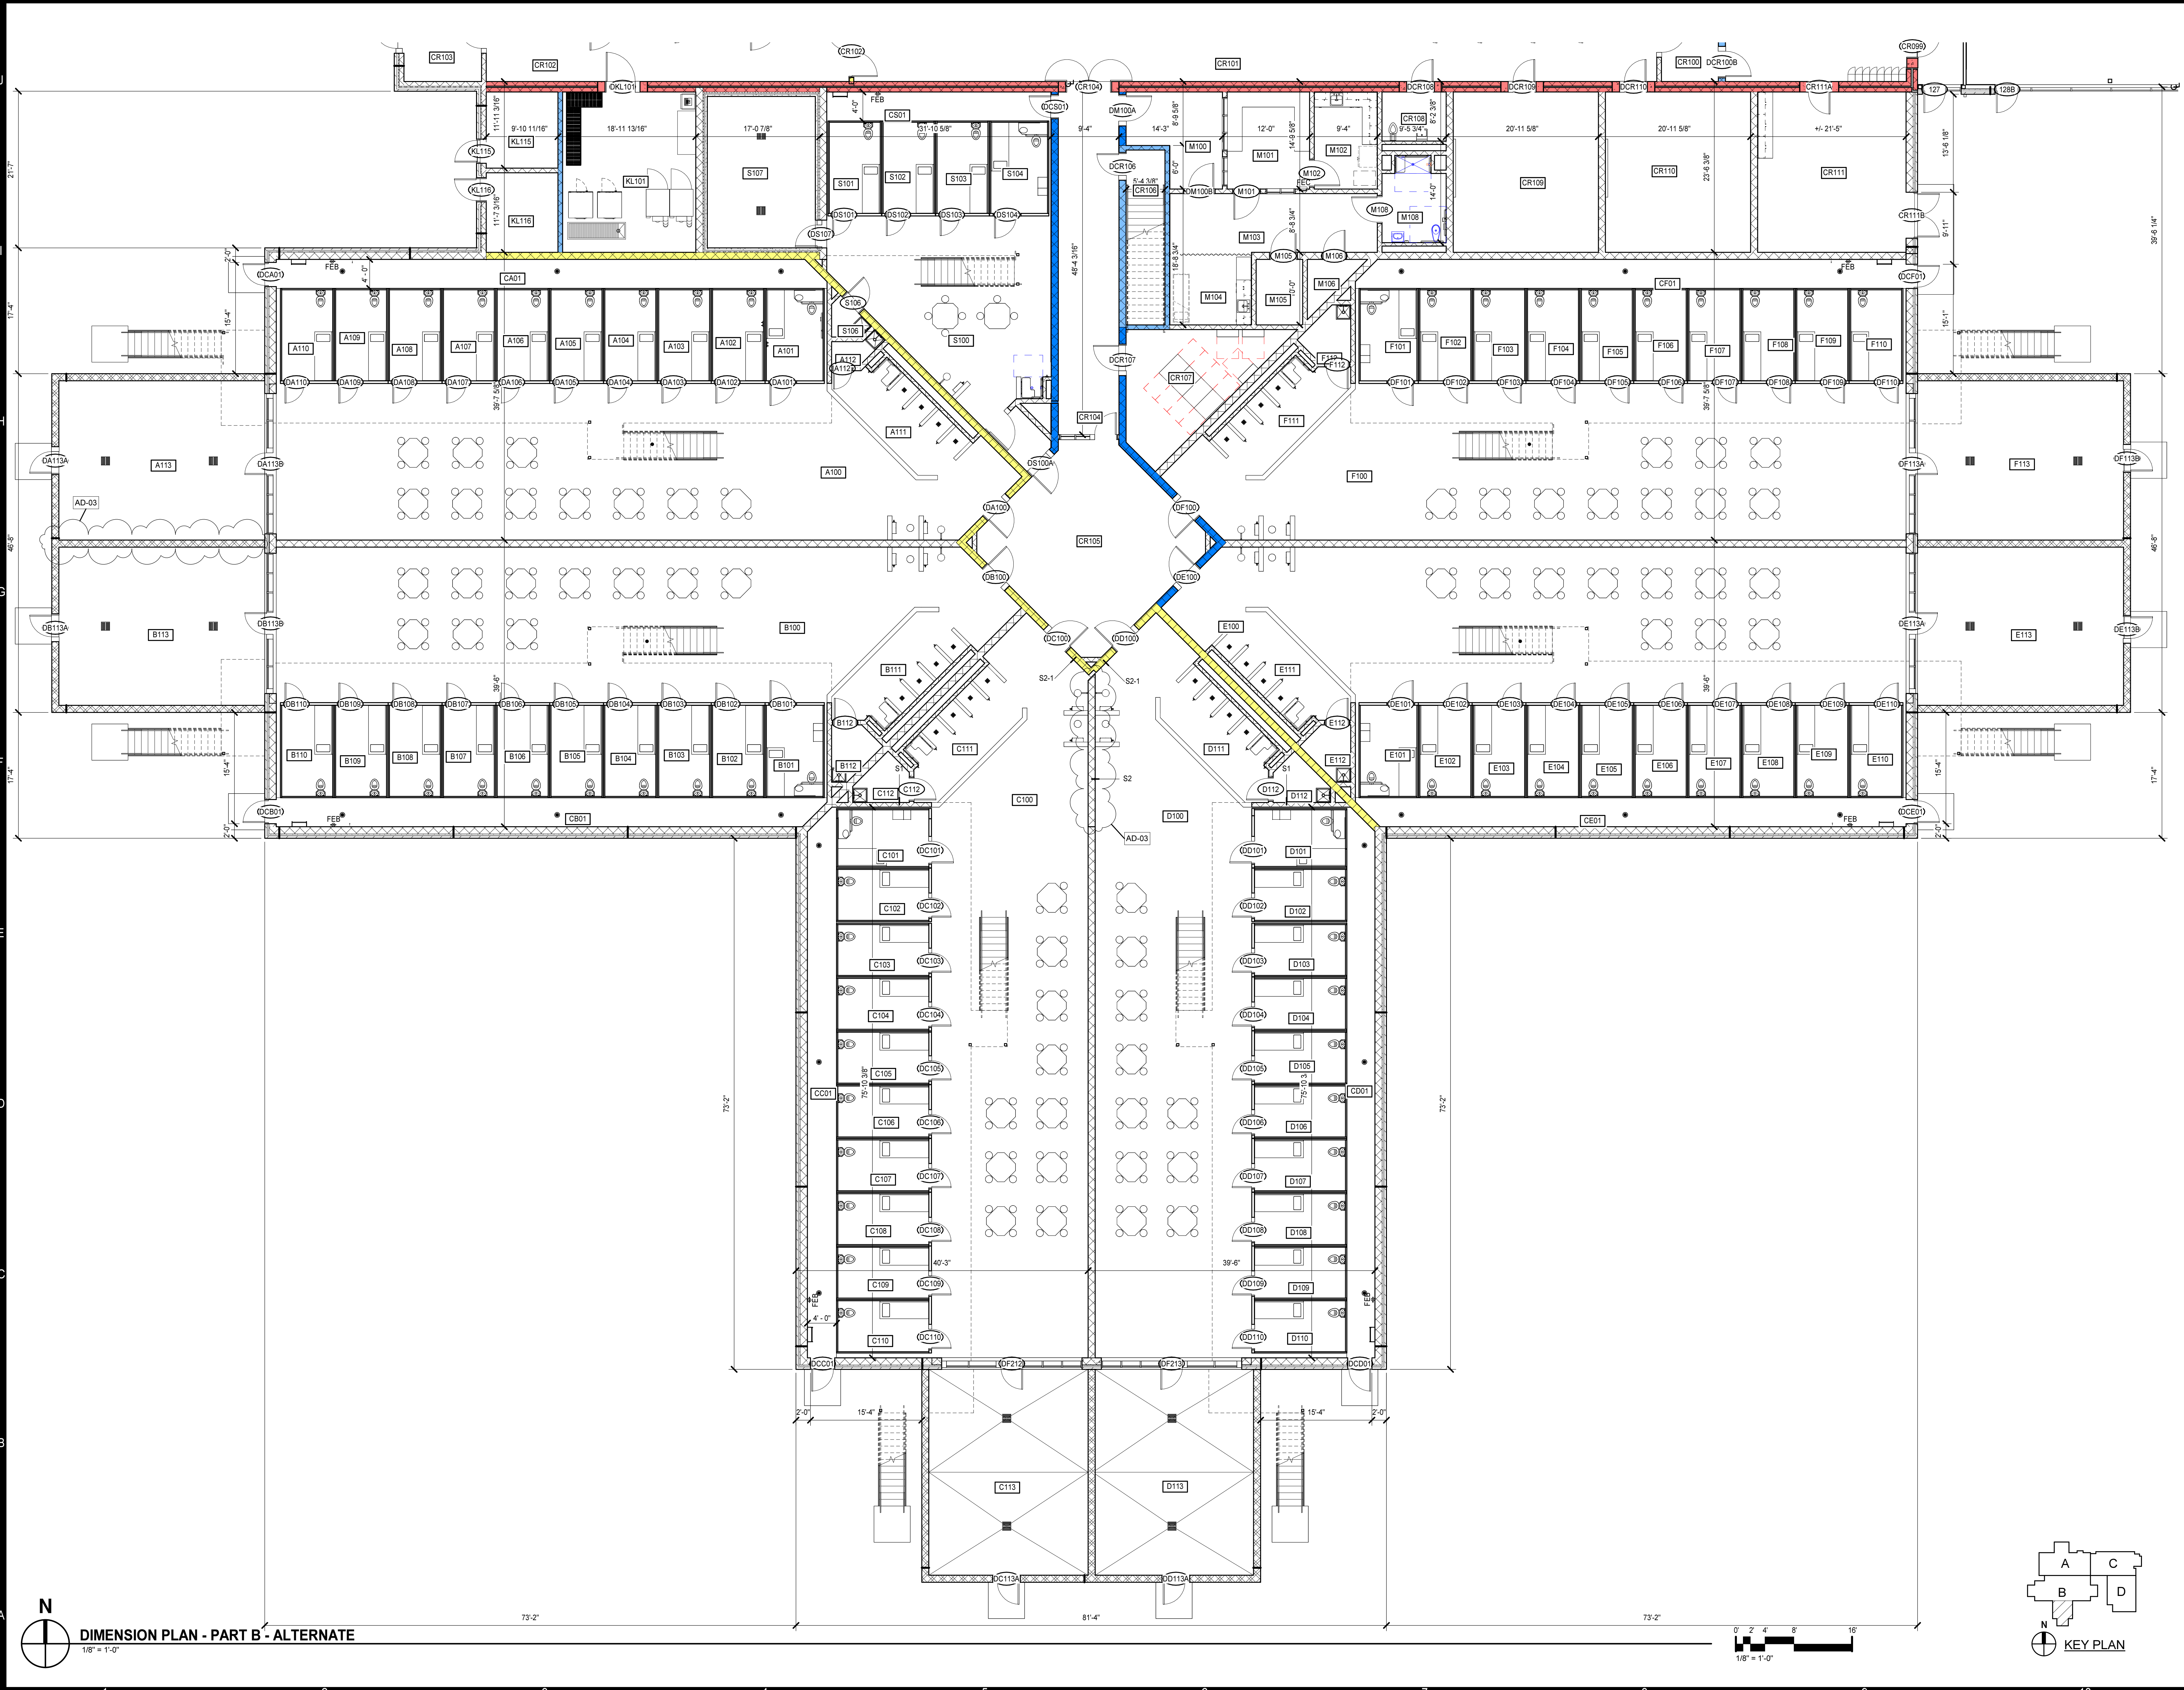

MOSELEY ARCHITECTS
6210 ARDREY KELL ROAD - THE HUB AT WAVERLY, SUITE 425 - CHARLOTTE, NC 28277
PHONE (704) 540-3755 FAX (704) 540-3754
MOSELEYARCHITECTS.COM

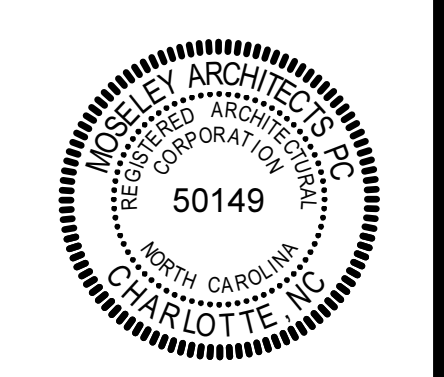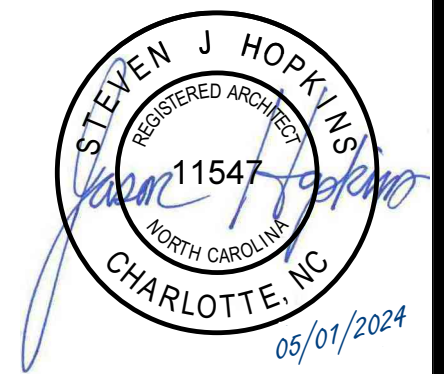

PENDER COUNTY LEC
DHSR# J-368 / FID# 220537
PENDER COUNTY, NORTH CAROLINA
1417 OLD SAVANNAH ROAD BURGAW, NC

PROJECT NO:	611688
DATE:	06/01/2024
REVISIONS	
DATE	DESCRIPTION
06/12/24	AD-03



DIMENSION PLAN - PART B - ALTERNATE

A2.1.14

6/7/2024 2:28:43 PM




DIMENSION PLAN - PART B - TIER LEVEL - ALTERNATE
1/8" = 1'-0"

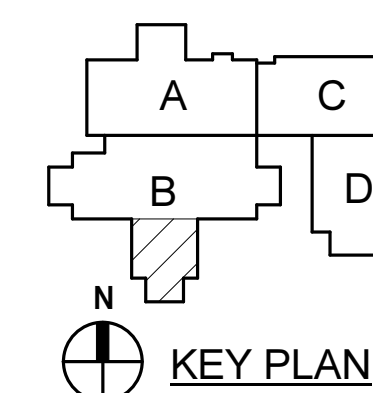
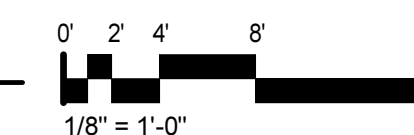


DIMENSION PLAN - PART B - TIER LEVEL - ALTERNATE

A2.1.15

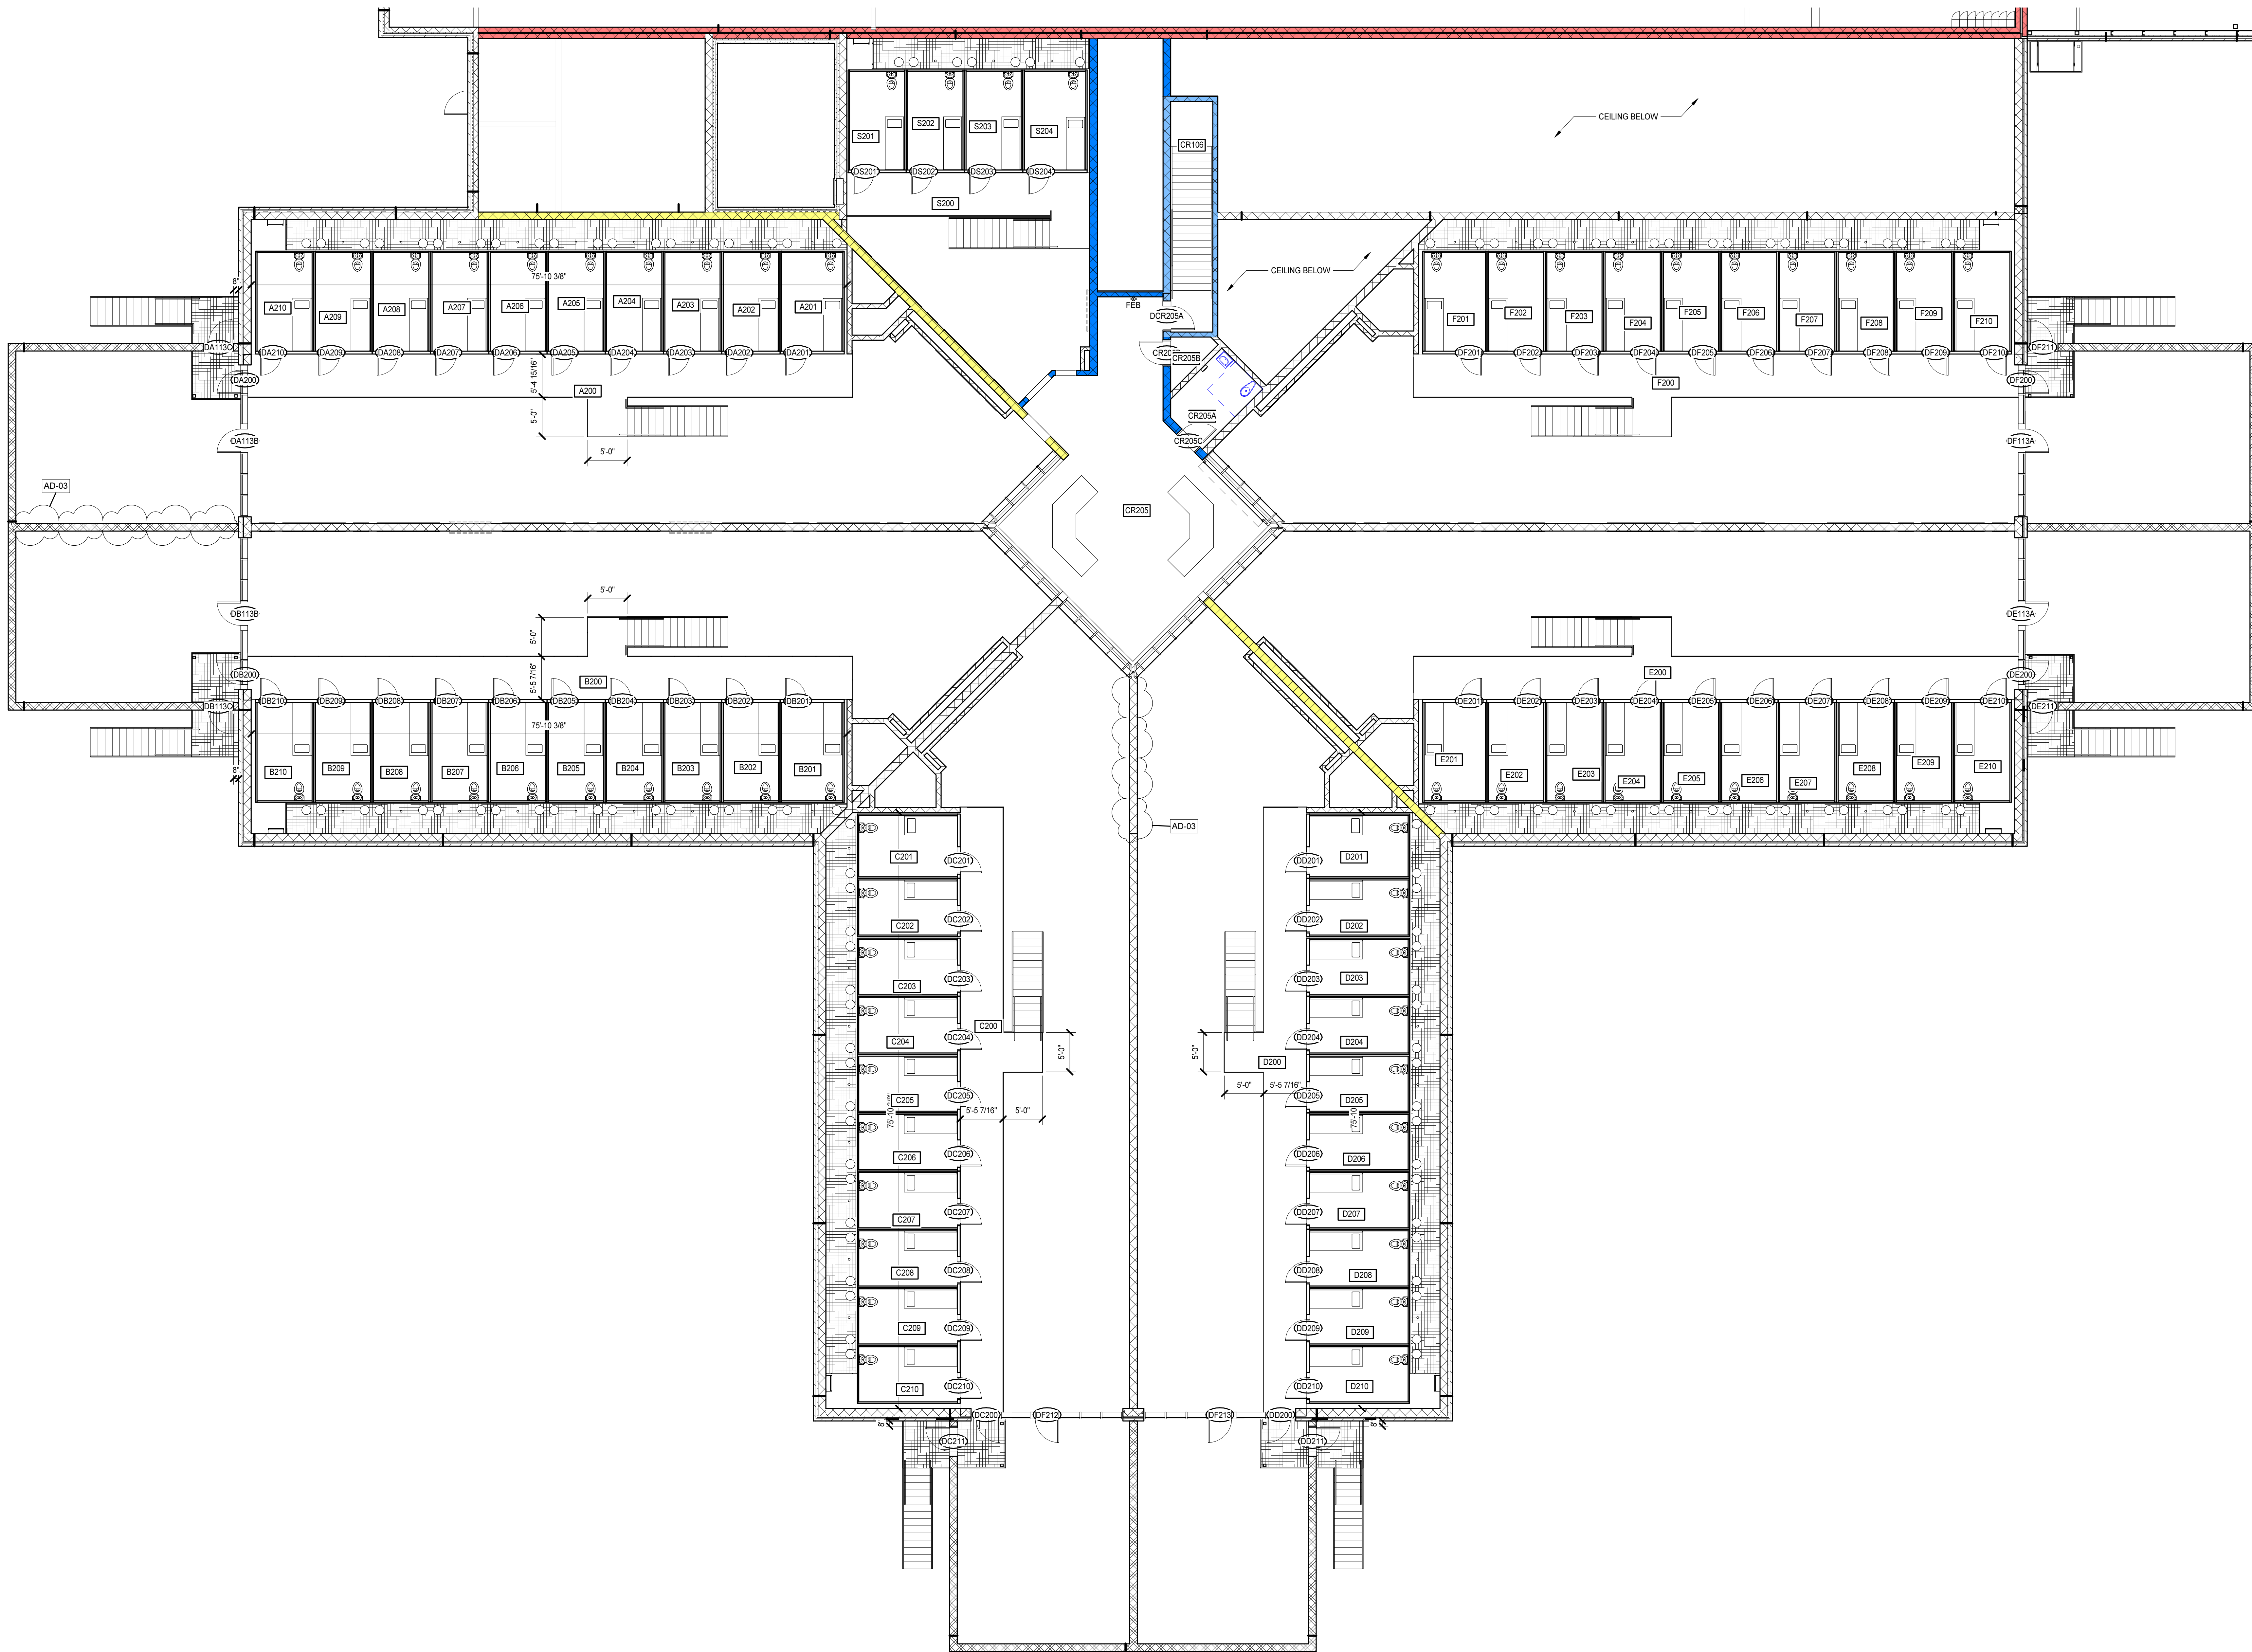


MOSELEY ARCHITECTS
6210 ARDREY KELL ROAD - THE HUB AT WAVERLY, SUITE 425 - CHARLOTTE, NC 28277
PHONE (704) 540-3155 FAX (704) 540-3154
MOSELEYARCHITECTS.COM

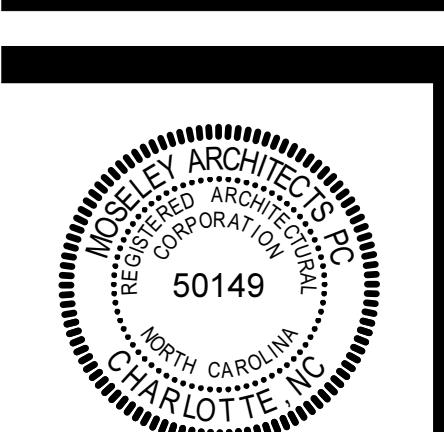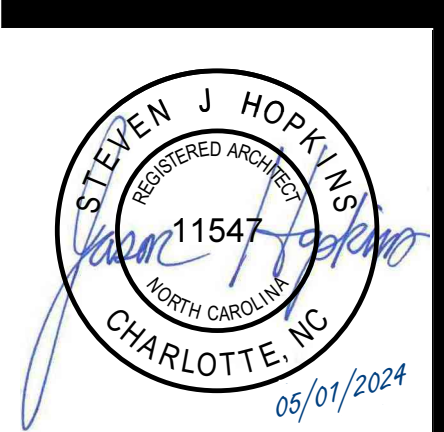

PENDER COUNTY LEC
DHSR# J-368 / FID# 220537
PENDER COUNTY, NORTH CAROLINA
1417 OLD SAVANNAH ROAD BURGAW, NC

PROJECT NO:	611688
DATE:	06/12/2024
REVISIONS	
DATE	DESCRIPTION
06/12/24	AD-03

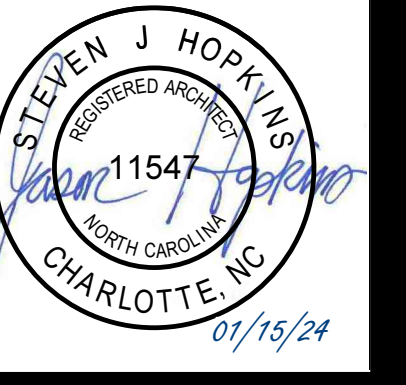


FLOOR PLAN GENERAL NOTES



- A. PROVIDE CONT. SILICONE CAULK AT ALL DOOR FRAMES WHERE GYP. BOARD AND FRAMES MEET BEFORE PAINTING OCCURS.
- B. PROVIDE PAINTED METAL FINISH ON ALL CEILING AND WALL ACCESS PANELS FOR ACCESS TO MECHANICAL, ELECTRICAL, AND PLUMBING SPACES.
- C. "MIN" FOR DIMENSIONS INDICATED MINIMUM ACCEPTABLE DIMENSION. IF "MIN" DIMENSIONS FALL SHORT OF WHAT IS SHOWN ON DRAWINGS, GC IS TO NOTIFY THE ARCHITECT IMMEDIATELY SO AS TO NOT DELAY THE PROJECT.

FLOOR PLAN KEYNOTES

- APPLIES TO DRAWINGS A2.1.1 - A2.1.7
 REPRESENTED BY [a]
- 1 CMU LOW WALL PER DETAIL 1/A5.2.1
 - 2 DOUBLE TIER METAL LOCKERS 15'x15'x72"
 - 3 INMATE PHONE (NIC)
 - 4 KIOSK (NIC)
 - 5 MIRROR - 48"W X 72"H
 - 6 50" MONITOR (NIC) - MOUNT AT 66" AFF TO CENTER OF SCREEN
 - 7 FLOOR EXPANSION JOINT
 - 8 VIDEO VISITATION STATION
 - 9 WALL MOUNTED, STEEL ROOF ACCESS LADDER
 - 10 AUTOMATIC FIRE SHUTTER @ THIS LOCATION
 - 11 WALL MOUNTED CHASE LADDER
 - 12 CHAIN LINK FENCE - EXTEND TO UNDERSIDE OF CEILING
 - 13 MECHANICALLY ASSISTED MOBILE STORAGE SHELVING SYSTEM - REFER TO ELEVATION ON A2 DRAWINGS.
 - 14 WASHER (NIC)
 - 15 DRYER (NIC)
 - 16 FOUR-TIER METAL LOCKERS 12'x12'x72"
 - 17 DOUBLE-TIER PHENOLIC Z-CONFIGURATION LOCKERS 12'x12'x72"
 - 18 DOUBLE TIER METAL LOCKERS 12'x12'x72"
 - 19 PACKAGE PASS - REFER TO DETAIL ON A7.2.1.
 - 20 PASS-THRU EVIDENCE LOCKERS
 - 21 DASHED LINE INDICATES A PRE-MANUFACTURED PROTECTIVE COVER ABOVE
 - 22 REFRIGERATED PASS-THRU LOCKER COMPARTMENT

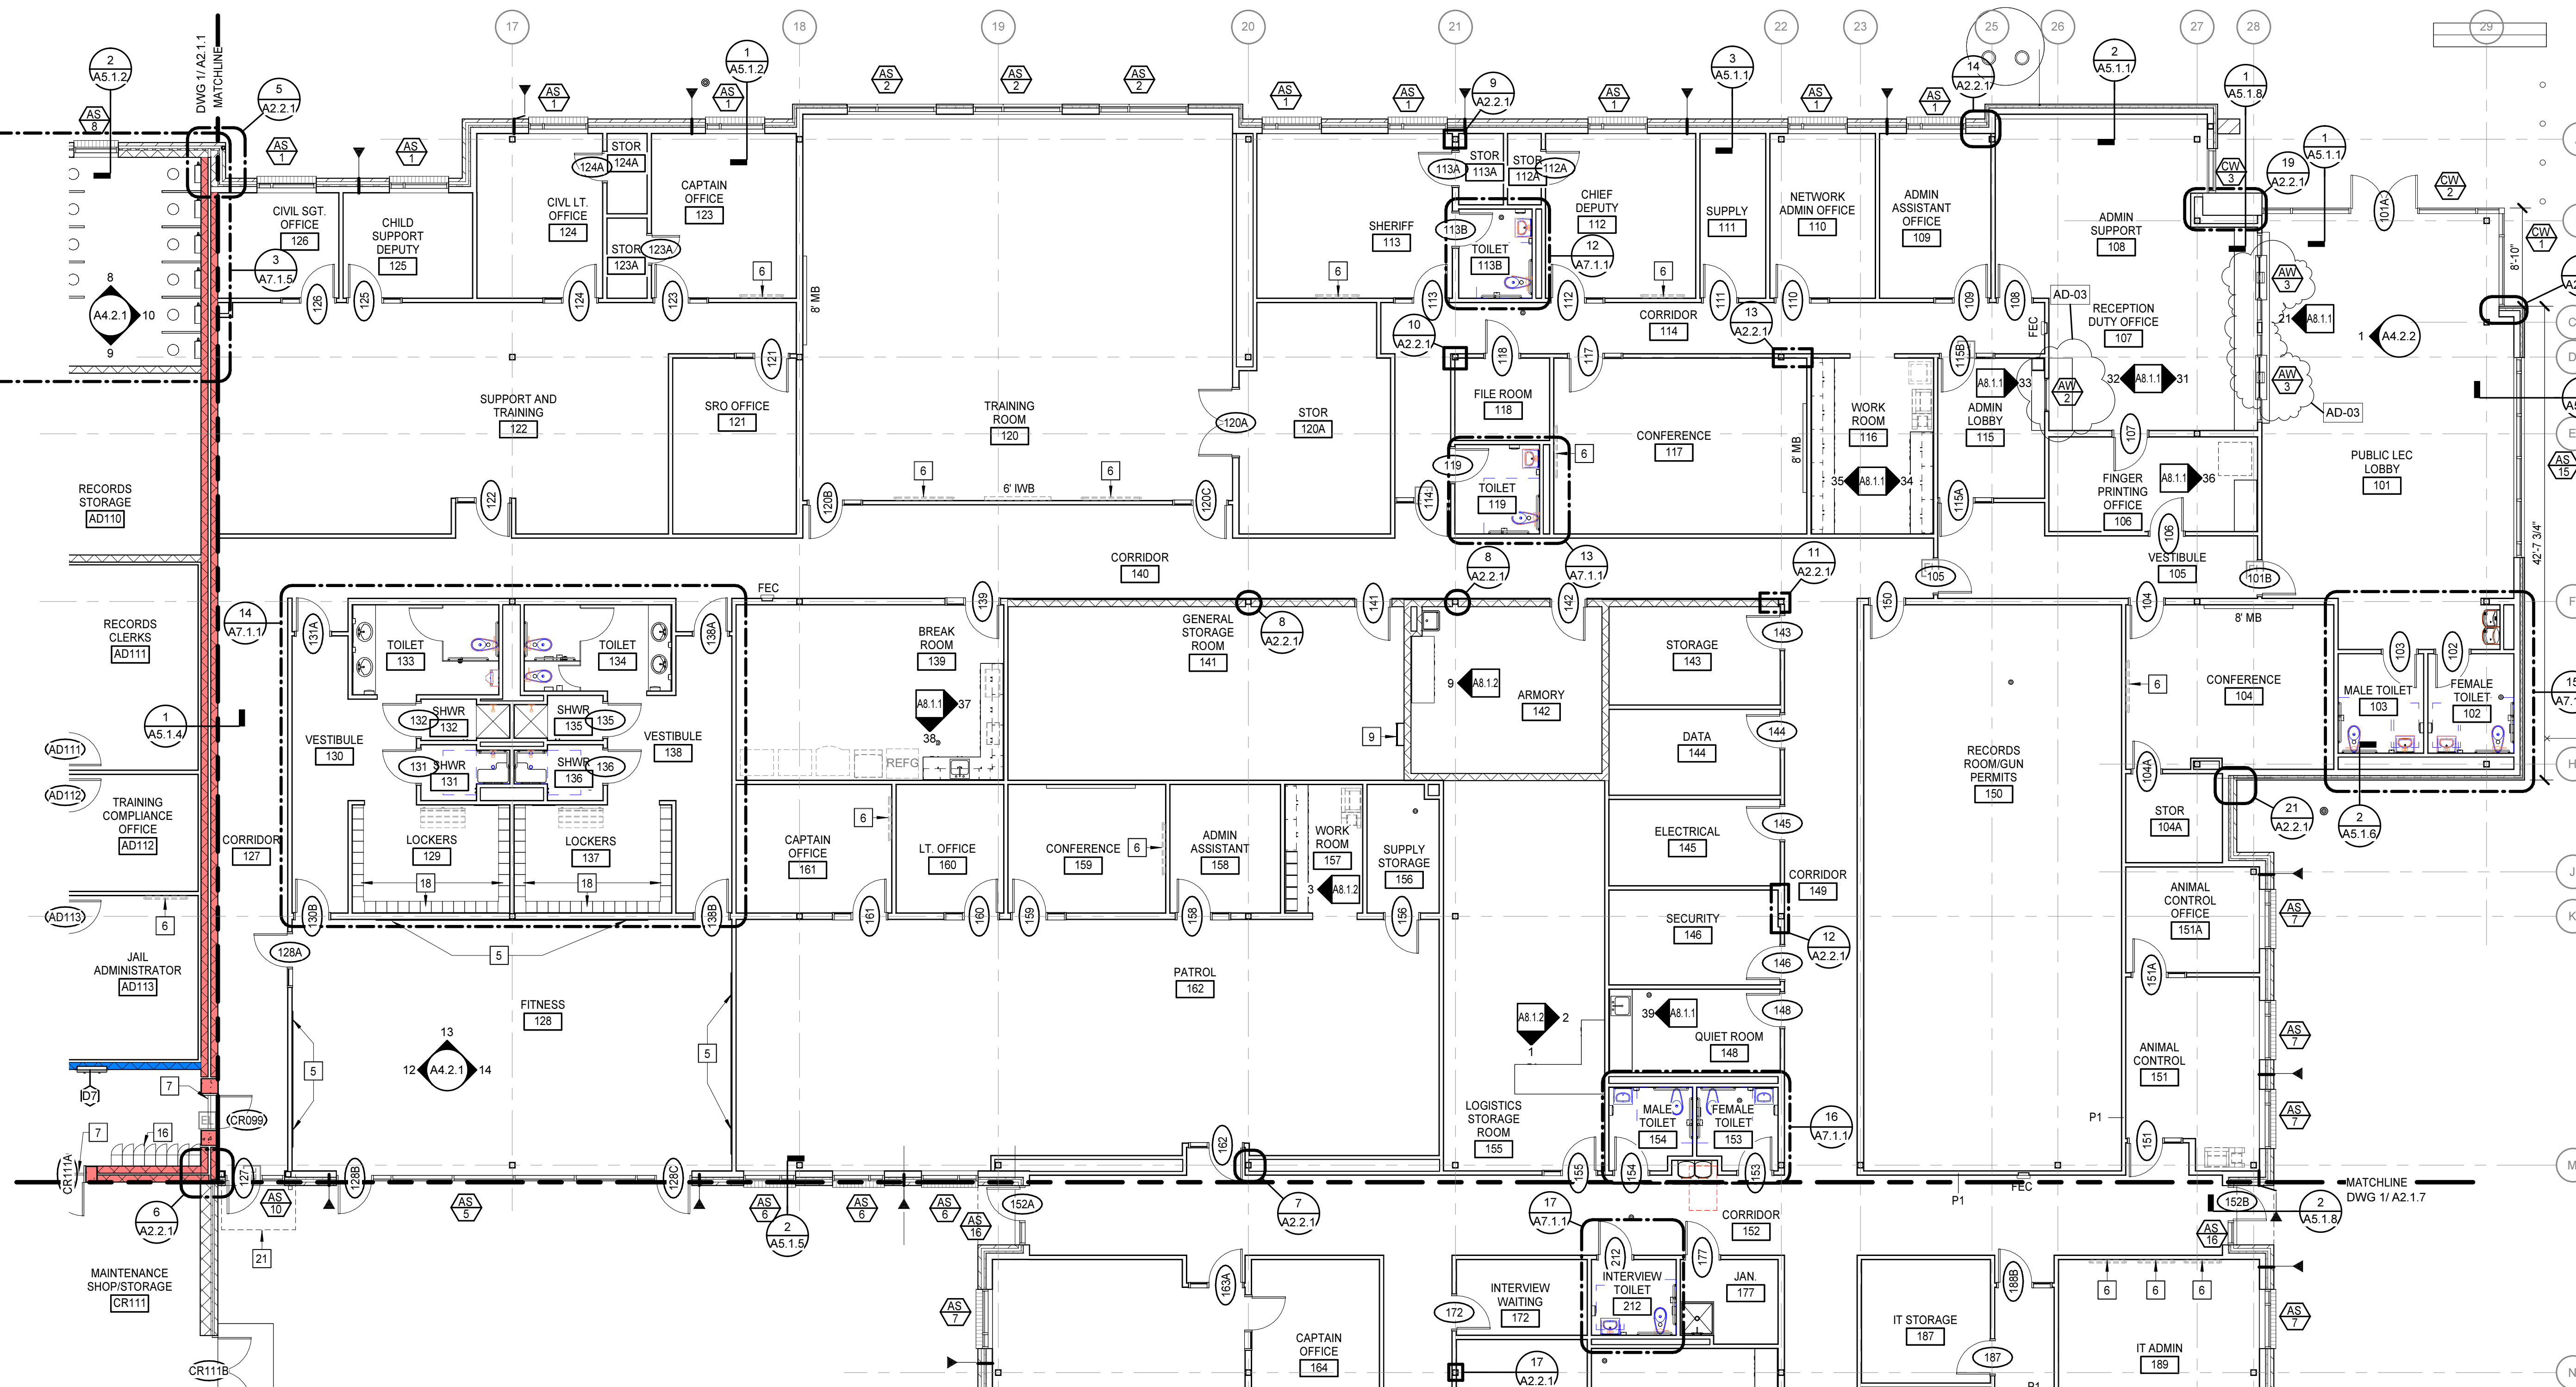

FLOOR PLAN - PART C
 1/8" = 1'-0"

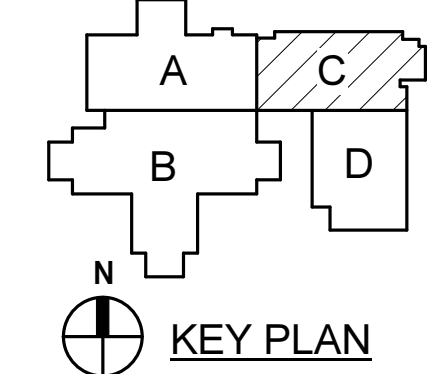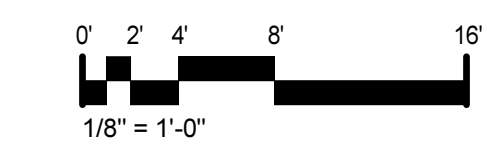

PENDER COUNTY LEC
 DHSR# J-368 / FID# 220537
 PENDER COUNTY, NORTH CAROLINA
 1417 OLD SAVANNAH ROAD BURGAW, NC

PROJECT NO:	611688
DATE:	06/12/24
REVISIONS:	
DATE:	DESCRIPTION
06/12/24	AD-03

FLOOR PLAN - PART C

FINISH SCHEDULE - BASE BID											
NUMBER	NAME	FLOOR	BASE	WALLS				CEILING	NOTES		
				NORTH	EAST	SOUTH	WEST				
101	PUBLIC LEC LOBBY	RES-C	RES-C	EPX PT	EPX PT	EPX PT	EPX PT	ACPA	8		
102	FEMALE TOILET	RES-C	RES-C	EPX PT	EPX PT	EPX PT	EPX PT	ACPA	8		
103	MALE TOILET	RES-C	RES-C	EPX PT	EPX PT	EPX PT	EPX PT	ACPA	8		
104	CONFERENCE	C-TILE-A	RB	PT	PT	PT	PT	ACPA			
104A	STOR	C-TILE-A	RB	PT	PT	PT	PT	ACPA			
105	VESTIBULE	PT	PT	PT	PT	PT	PT	ACPA-SGB-PT	10		
106	FINGER PRINTING OFFICE	RB	PT	PT	PT	PT	PT	ACPA			
107	RECEPTION DUTY OFFICE	C-TILE-A	RB	PT	PT	PT	PT	ACPA			
108	ADMIN SUPPORT	C-TILE-A	RB	PT	PT	PT	PT	ACPA			
109	ADMIN ASSISTANT OFFICE	C-TILE-A	RB	PT	PT	PT	PT	ACPA			
110	NETWORK ADMIN OFFICE	C-TILE-A	RB	PT	PT	PT	PT	ACPA			
111	SUPPLY	QCT	RB	PT	PT	PT	PT	ACPA			
112	CHIEF DEPUTY	C-TILE-A	RB	PT	PT	PT	PT	ACPA			
112A	STOR	C-TILE-A	RB	PT	PT	PT	PT	ACPA			
113	SHERIFF	RB	PT	PT	PT	PT	PT	ACPA			
113A	STOR	C-TILE-A	RB	PT	PT	PT	PT	ACPA			
113B	TOILET	RES-A2	RES-A2	EPX PT	EPX PT	EPX PT	EPX PT	ACPA	8		
114	CORRIDOR	QCT	RB	PT	PT	PT	PT	ACPA			
115	ADMIN LOBBY	QCT	RB	PT	PT	PT	PT	ACPA			
116	WORK ROOM	QCT	RB	PT	PT	PT	PT	ACPA			
117	CONFERENCE	C-TILE-A	RB	PT	PT	PT	PT	ACPA			
118	FILE ROOM	QCT	RB	PT	PT	PT	PT	ACPA			
119	TOILET	RES-A2	RES-A2	EPX PT	EPX PT	EPX PT	EPX PT	ACPA	8		
120	TRAINING ROOM	C-TILE-A	RB	PT	PT	PT	PT	ACPA			
120A	STOR	C-TILE-A	RB	PT	PT	PT	PT	ACPA			
121	SRO OFFICE	C-TILE-A	RB	PT	PT	PT	PT	ACPA			
122	SUPPORT AND TRAINING	C-TILE-A	RB	PT	PT	PT	PT	ACPA			
123	CAPTAIN OFFICE	C-TILE-A	RB	PT	PT	PT	PT	ACPA			
123A	STOR	C-TILE-A	RB	PT	PT	PT	PT	ACPA			
124	CHIEF LT OFFICE	C-TILE-A	RB	PT	PT	PT	PT	ACPA			
124A	STOR	C-TILE-A	RB	PT	PT	PT	PT	ACPA			
125	CHILD SUPPORT DEPUTY	C-TILE-A	RB	PT	PT	PT	PT	ACPA			
126	CIVIL SGT OFFICE	C-TILE-A	RB	PT	PT	PT	PT	ACPA			
127	CORRIDOR	QCT	RB	PT	PT	PT	PT	ACPA	10		
128	FITNESS	RES-A2	RES-A2	EPX PT	EPX PT	EPX PT	EPX PT	ACPA			
129	LOCKERS	RES-A2	RES-A2	EPX PT	EPX PT	EPX PT	EPX PT	ACPA	8		
130	VESTIBULE	RES-A2	RES-A2	EPX PT	EPX PT	EPX PT	EPX PT	ACPA	8		
131	SHWR	RES-A2	RES-A2	RES-B	RES-B	RES-B	RES-B	GB-PT	8		
132	SHWR	RES-A2	RES-A2	RES-B	RES-B	RES-B	RES-B	GB-PT	8		
133	TOILET	RES-A2	RES-A2	EPX PT	EPX PT	EPX PT	EPX PT	ACPA	8		
134	TOILET	RES-A2	RES-A2	EPX PT	EPX PT	EPX PT	EPX PT	ACPA	8		
135	SHWR	RES-A2	RES-A2	RES-B	RES-B	RES-B	RES-B	GB-PT	8		
137	LOCKERS	RES-A2	RES-A2	EPX PT	EPX PT	EPX PT	EPX PT	ACPA	8		
138	VESTIBULE	RES-A2	RES-A2	EPX PT	EPX PT	EPX PT	EPX PT	ACPA	8		
139	BREAK ROOM	QCT	RB	PT	PT	PT	PT	ACPA			
140	CORRIDOR	QCT	RB	PT	PT	PT	PT	ACPA-SGB-PT	10		
141	GENERAL STORAGE ROOM	CONC-SLR	RB	PT	PT	PT	PT	ACPA			
142	ARMORY	CONC-SLR	RB	PT	PT	PT	PT	ACPA			
143	STORAGE	QCT	RB	PT	PT	PT	PT	ACPA			
144	DATA	CONC-SLR	RB	PT	PT	PT	PT	EXPC PT			
145	ELECTRICAL	CONC-SLR	RB	PT	PT	PT	PT	EXPC PT			
146	SECURITY	CONC-SLR	RB	PT	PT	PT	PT	EXPC PT			
148	QUIET ROOM	CONC-SLR	RB	A-PT	PT	PT	PT	ACPA			
149	CORRIDOR	QCT	RB	PT	PT	PT	PT	ACPA-SGB-PT	10		
150	RECORDS ROOM/GUN PERMITS	C-TILE-A	RB	PT	PT	PT	PT	ACPA			
151	ANIMAL CONTROL	C-TILE-A	RB	PT	PT	PT	PT	ACPA			
151A	ANIMAL CONTROL OFFICE	C-TILE-A	RB	PT	PT	PT	PT	ACPA			
152	CORRIDOR	QCT	RB	PT	PT	PT	PT	ACPA-SGB-PT	10		
153	FEMALE TOILET	RES-A2	RES-A2	EPX PT	EPX PT	EPX PT	EPX PT	ACPA	8		
154	MALE TOILET	RES-A2	RES-A2	EPX PT	EPX PT	EPX PT	EPX PT	ACPA	8		
155	LOGISTICS STORAGE ROOM	QCT	RB	PT	PT	PT	PT	ACPA			
156	SUPPLY STORAGE	QCT	RB	PT	PT	PT	PT	ACPA			
157	WORK ROOM	C-TILE-A	RB	PT	PT	PT	PT	ACPA			
158	ADMIN ASSISTANT	C-TILE-A	RB	PT	PT	PT	PT	ACPA			
159	CONFERENCE	C-TILE-A	RB	PT	A-PT	PT	PT	ACPA			
160	LT OFFICE	C-TILE-A	RB	PT	PT	PT	PT	ACPA			
161	CAPTAIN OFFICE	C-TILE-A	RB	PT	PT	PT	PT	ACPA			
162	PATROL	C-TILE-A	RB	PT	PT	PT	PT	ACPA			
163	INVESTIGATIONS	C-TILE-A	RB	PT	PT	PT	PT	ACPA			
164	CAPTAIN OFFICE	C-TILE-A	RB	PT	PT	PT	PT	ACPA			
165	DETECTIVE LT OFFICE	C-TILE-A	RB	PT	PT	PT	PT	ACPA			
166	DATA	CONC-SLR	RB	PT	PT	PT	PT	EXPC PT			
167	DETECTIVE LT OFFICE	C-TILE-A	RB	PT	PT	PT	PT	ACPA			
168	SVU OFFICE	C-TILE-A	RB	PT	PT	PT	PT	ACPA			
169	SVU OFFICE	C-TILE-A	RB	PT	PT	PT	PT	ACPA			
170	CONFERENCE	C-TILE-A	RB	PT	PT	PT	PT	ACPA			
171	CORRIDOR	QCT	RB	PT	PT	PT	PT	ACPA			
172	INTERVIEW WAITING	QCT	RB	EPX PT	EPX PT	EPX PT	EPX PT	ACPA-HDC			
173	INTERVIEW	QCT	RB	EPX PT	EPX PT	EPX PT	EPX PT	ACPA-HDC			
174	INTERVIEW	QCT	RB	EPX PT	EPX PT	EPX PT	EPX PT	ACPA-HDC			
175	INTERVIEW	QCT	RB	EPX PT	EPX PT	EPX PT	EPX PT	ACPA-HDC			
176	CHEMICAL LAB	SV-B	SV-B	EPX PT	EPX PT	EPX PT	EPX PT	ACPA	8		
177	JAN	CONC-SLR	RB	EPX PT	EPX PT	EPX PT	EPX PT	ACPA			
179	COMPUTER FORENSICS ROOM	C-TILE-B	RB	PT	PT	PT	PT	ACPA			
180	OFFICE	QCT	RB	PT	PT	PT	PT	ACPA			
181	EVIDENCE SECURITY OFFICE	C-TILE-A	RB	PT	PT	PT	PT	ACPA			
182	EVIDENCE RECEIVING	QCT	RB	PT	PT	PT	PT	ACPA			
183	CORRIDOR	QCT	RB	PT	PT	PT	PT	ACPA			
184	WORK AREA	QCT	RB	PT	PT	PT	PT	ACPA			
185	OFFICE	C-TILE-A	RB	PT	PT	PT	PT	ACPA			
186	VESTIBULE	QCT	RB	PT	PT	PT	PT	ACPA			
187	IT STORAGE	QCT	RB	PT	PT	PT	PT	ACPA			
188	CORRIDOR	QCT	RB	PT	PT	PT	PT	ACPA			
189	IT ADMIN	C-TILE-A	RB	A-PT	PT	PT	PT	ACPA			
191	SYSTEMS ADMIN OFFICE	C-TILE-A	RB	PT	PT	PT	PT	ACPA			
192	CONFERENCE	C-TILE-A	RB	PT	PT	A-PT	PT	ACPA			
193	SERVER ROOM	RFT	RB	PT	PT	PT	PT	ACPA	11		
194	RECORDS	QCT	RB	PT	PT	PT	PT	ACPA			
195	SUPPLY STORAGE	QCT	RB	PT	PT	PT	PT	ACPA			
196	SUPERVISOR	C-TILE-B	RB	PT	PT	PT	PT	ACPA			
197	911 DIRECTOR	C-TILE-B	RB	PT	PT	PT	PT	ACPA			
198	COMMUNICATIONS/911	C-TILE-B	RB	PTA-PT	PT	PTA-PT	PT	ACPA	11		
199	STORAGE	QCT	RB	PT	PT	PT	PT	ACPA			
200	BREAK ROOM	QCT	RB	PT	PT	PT	PT	ACPA			
201	TOILET	RES-A2	RES-A2	EPX PT	EPX PT	EPX PT	EPX PT	ACPA	8		
202	QUIET ROOM	C-TILE-B	RB	PT	PT	PT	A-PT	ACPA			
203	VESTIBULE	QCT	RB	PT	PT	PT	PT	ACPA			
204	EVIDENCE ROOM	CONC-POL	RB	PT	PT	PT	PT	ACPA			
205	VEHICLE BAY	CONC-LH	EPX PT	EPX PT	EPX PT	EPX PT	EPX PT	EXPC PT			
206	STOR	QCT	RB	PT	PT	PT	PT	ACPA			
207	FEMALE TOILET	RES-A2	RES-A2	EPX PT	EPX PT	EPX PT	EPX PT	ACPA	8		
208	MALE TOILET	RES-A2	RES-A2	EPX PT	EPX PT	EPX PT	EPX PT	ACPA	8		
209	NARCOTICS OFFICE	C-TILE-A	RB	PT	PT	PT	PT	ACPA			
210	NARCOTICS	C-TILE-A	RB	PT	PT	PT	PT	ACPA			
211	VESTIBULE	C-TILE-B	RB	PT	PT	PT	PT	ACPA			
212	INTERVIEW TOILET	RES-A2	RES-A2	EPX-PT	EPX-PT	EPX-PT	EPX-PT	ACPA	8		
213	PRE-ACTION	CONC-SLR	RB	PT	PT	PT	PT	EXPC PT			
215	DRUG STORAGE	CONC-POL	EPX PT	PT	PT	PT	PT	ACPA			
216	LS/ELC	CONC-SLR	PT	PT	PT	PT	PT	EXPC PT			
217	ELEC	CONC-SLR	PT	PT	PT	PT	PT	EXPC PT			
218	MECH	CONC-SLR	PT	PT	PT	PT	PT	EXPC PT			
A100	MAXIMUM CUSTODY UNIT A	CONC-POL	EPX PT	EPX PT	EPX PT	EPX PT	EPX PT	ACPA-HDC/SGB PT			
A101	SINGLE ADA	CONC-POL	PT	PER MFR	PER MFR	PER MFR	PER MFR	PER MFR			
A102	SINGLE	CONC-POL	PT	PER MFR	PER MFR	PER MFR	PER MFR	PER MFR			
A103	SINGLE	CONC-POL	PT	PER MFR	PER MFR	PER MFR	PER MFR	PER MFR			
A104	SINGLE	CONC-POL	PT	PER MFR	PER MFR	PER MFR	PER MFR	PER MFR			
A105	SINGLE	CONC-POL	PT	PER MFR	PER MFR	PER MFR	PER MFR	PER MFR			
A106	SINGLE	CONC-POL	PT	PER MFR	PER MFR	PER MFR	PER MFR	PER MFR			
A107	SINGLE	CONC-POL	PT	PER MFR	PER MFR	PER MFR	PER MFR	PER MFR			
A108	SINGLE	CONC-POL	PT	PER MFR	PER MFR	PER MFR	PER MFR	PER MFR			
A109	SINGLE	CONC-POL	PT	PER MFR	PER MFR	PER MFR	PER MFR	PER MFR			
A110	SINGLE	CONC-POL	PT	PER MFR	PER MFR	PER MFR	PER MFR	PER MFR			
A111	SHOWERS	RES-A1	RES-A1	RES-B	RES-B	RES-B	RES-B	GB-PT	4, 5, 9		
A112	JAN	RES-A1	RES-A1	RES-B	RES-B	RES-B	RES-B	GB-PT	4, 5, 9		
A113	REC YARD	CONC-SLR	PT	PT	PT	PT	PT	MESH	5		
AD100	VESTIBULE	RES-C	RES-C	EPX PT	EPX PT	EPX PT	EPX PT	EXPC PT	1		
AD101	PUBLIC LOBBY	RES-C	RES-C	EPX PT	EPX PT	EPX PT	EPX PT	ACPA	8		
AD102	JAN	CONC-SLR	RB	PT	PT	PT	PT	ACPA			
AD103	VIDEO VISITATION	QCT	RB	PT	PT	PT	PT	ACPA			
AD104	MENS	RES-C	RES-C	EPX PT	EPX PT	EPX PT	EPX PT	ACPA	8		
AD105	WOMENS	RES-C	RES-C	EPX PT	EPX PT	EPX PT	EPX PT	ACPA	8		
AD106	RECEPTION	C-TILE-A	RB	PT	PT	A-PT	PT	ACPA			
AD108	STOR	QCT	RB	PT	PT	PT	PT	ACPA			
AD109	CORRIDOR	QCT	RB	PT	PT	PT	PT	ACPA			
AD110	RECORDS STORAGE	QCT	RB	PT	PT	PT	PT	ACPA			
AD111	RECORDS CLERKS	C-TILE-A	RB	PT	PT	PT	PT	ACPA			
AD112	TRAINING COMPLIANCE OFFICE	C-TILE-A	RB	PT	PT	PT	PT	ACPA			
AD113	JAIL ADMINISTRATOR	C-TILE-A	RB	PT	PT	PT	PT	ACPA			
AD114	ASST JAIL ADMINISTRATOR	C-TILE-A	RB	PT	PT	PT	PT	ACPA			
AD115	OFFICE	C-TILE-A	RB	PT	PT	PT	PT	ACPA			
AD116	WOMEN	RES-A2	RES-A2	EPX PT	EPX PT	EPX PT	EPX PT	ACPA	8		
AD117	MEN	RES-A2	RES-A2	EPX PT	EPX PT	EPX PT	EPX PT	ACPA	8		



FINISH SCHEDULE - BASE BID										
NUMBER	NAME	FLOOR	BASE	NORTH	EAST	SOUTH	WEST	CEILING	NOTES	
AD118	OFFICE	C-TILE-A	RB	PT	PT	PT	PT	ACPA		
AD119	CONF ROOM	C-TILE-A	RB	PT	PT	PT	PT	ACPA		
AD119A	STOR									

WALL SECTION KEYNOTES

APPLIES TO DRAWINGS A5.1.1 - A5.1.2
 REPRESENTED BY []

1 CEILING PER A9 SERIES	17 STEEL GRATING ELEVATED SERVICE WALKWAY
2 ACOUSTICAL WALL PANEL	18 WALL MOUNTED LADDER
3 OVERHEAD COILING DOOR	19 CHASE LIGHT FIXTURE, SEE E-SERIES
4 5/8" PROJECTED SOLDIER COURSE	20 EXTERIOR LIGHT FIXTURE - SEE E-SERIES
5 ALUMINUM CURTAINWALL SYSTEM	21 ARCHITECTURALLY EXPOSED STRUCTURAL STEEL FRAMING
6 PREMANUFACTURED PROTECTIVE COVER	22 ALUMINUM COMPOSITE METAL PANEL
7 5/8" PROJECTED SOLDIER COURSE - 2 COURSE	23 5/8" RECESSED SOLDIER COURSE
8 STRUCTURAL STEEL PER S-SERIES	24 5/8" RECESSED BRICK COURSE
9 SECURITY BARRIER MESH, 1/4" X 6" BATTEN PLATE AND THRU-BOLTS @ 12" O.C.	25 RAISED ACCESS FLOORING SYSTEM
10 CONCRETE FRAME - REFER TO S-SERIES	26 DEPRESSED SLAB - SEE S-SERIES
11 DETENTION HOLLOW METAL FRAME - REFER TO DETENTION FRAME SCHEDULE	27 DIMENSIONAL CHARACTERS - REFER TO DIVISION 10 SECTION "SIGNAGE"
12 SECURITY SEALANT	28 CONCEALED FASTENER METAL WALL PANEL
13 REC. YARD SLAB RECESSED 1/4"	29 REFER TO SHEET A0.1 FOR RATED TOP OF WALL TERMINATION NOTES
14 VAPOR BARRIER	30 NOT USED
15 STEEL CELL PER DIVISION 13	31 CONC. SPLASH BLOCK
16 3'-6" HIGH, 1-1/4" DIA. STEEL PIPE GUARDRAIL & GATE	32 FIRE RATED, PICK RESISTANT, COMPRESSIBLE WALL SEAL

AD-03
 30 NOT USED

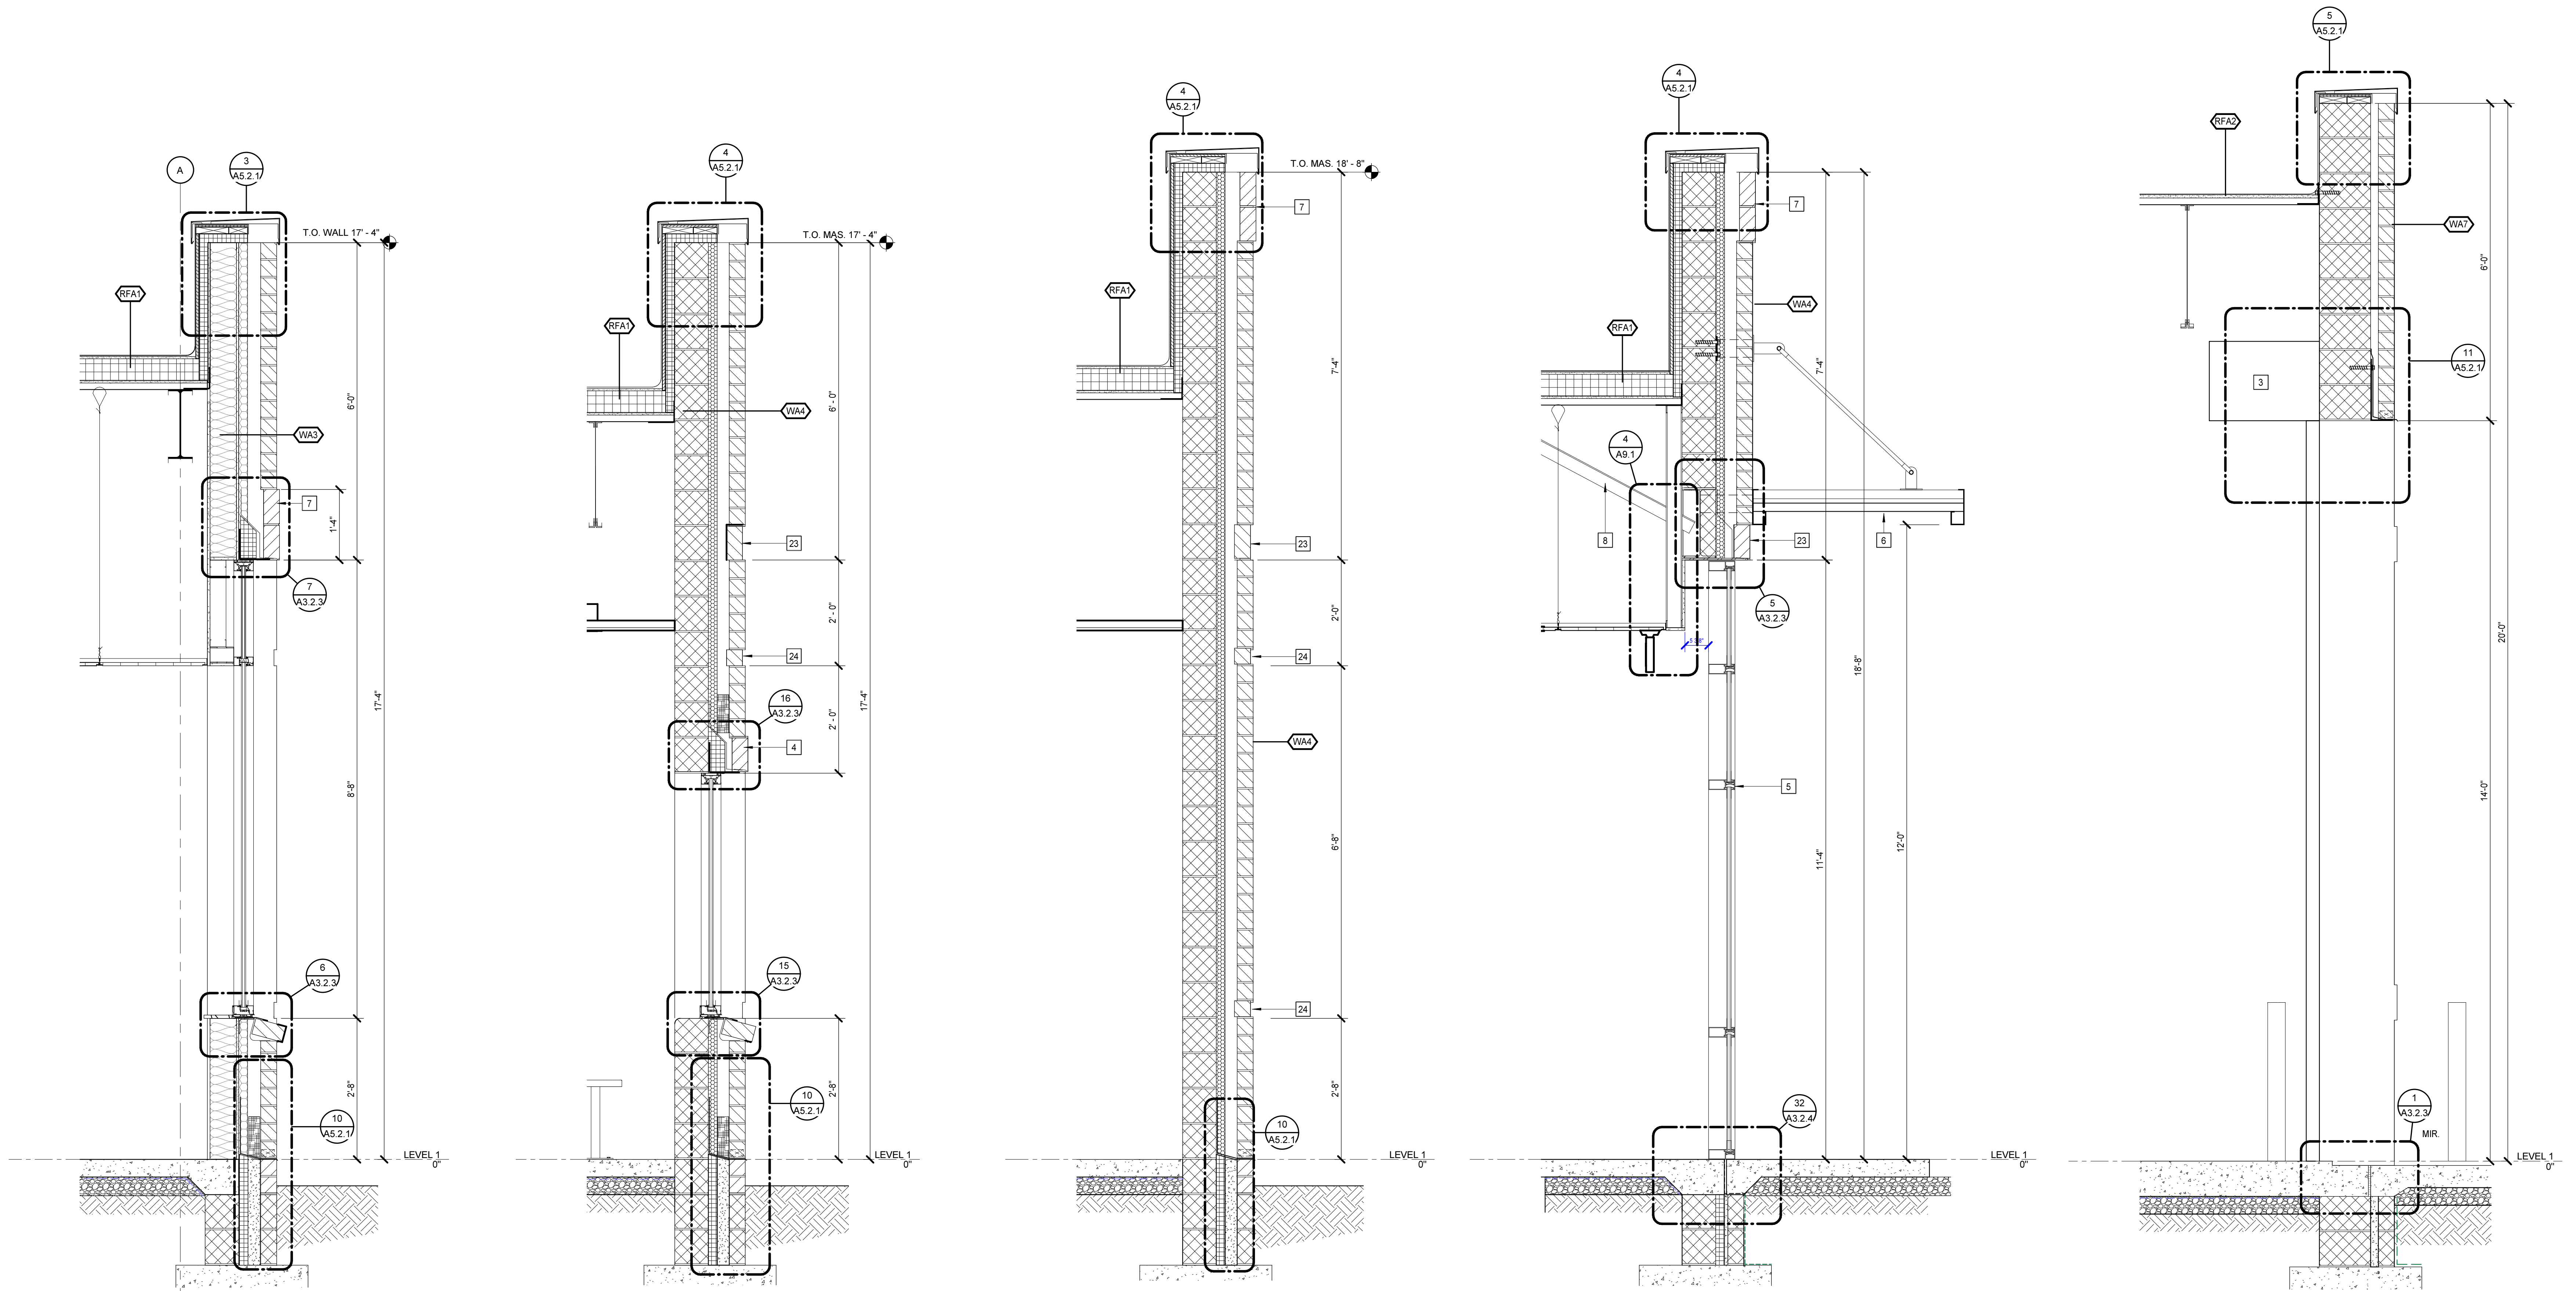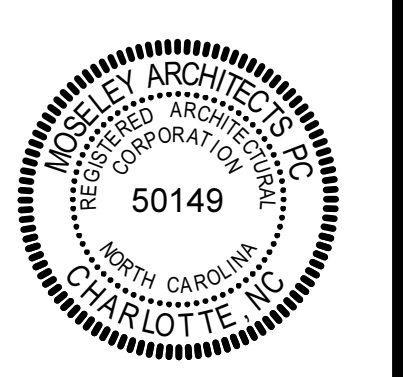

1 WALL SECTION
 A2.1.1, A5.1.2 3/4" = 1'-0"

2 WALL SECTION
 A2.1.1, A5.1.2 3/4" = 1'-0"

3 WALL SECTION
 A2.1.1, A5.1.2 3/4" = 1'-0"

4 WALL SECTION
 A2.1.1, A5.1.2 3/4" = 1'-0"

5 WALL SECTION
 A2.1.1, A5.1.2 3/4" = 1'-0"


PENDER COUNTY LEC
 DHSR# J-368 / FID# 220537
 PENDER COUNTY, NORTH CAROLINA
 1417 OLD SAVANNAH ROAD BURGAW, NC

PROJECT NO:	611688
DATE:	05/01/2024
REVISIONS	
DATE	DESCRIPTION
06/12/24	AD-03


WALL SECTIONS

A5.1.2


6/7/2024 2:22:45 PM

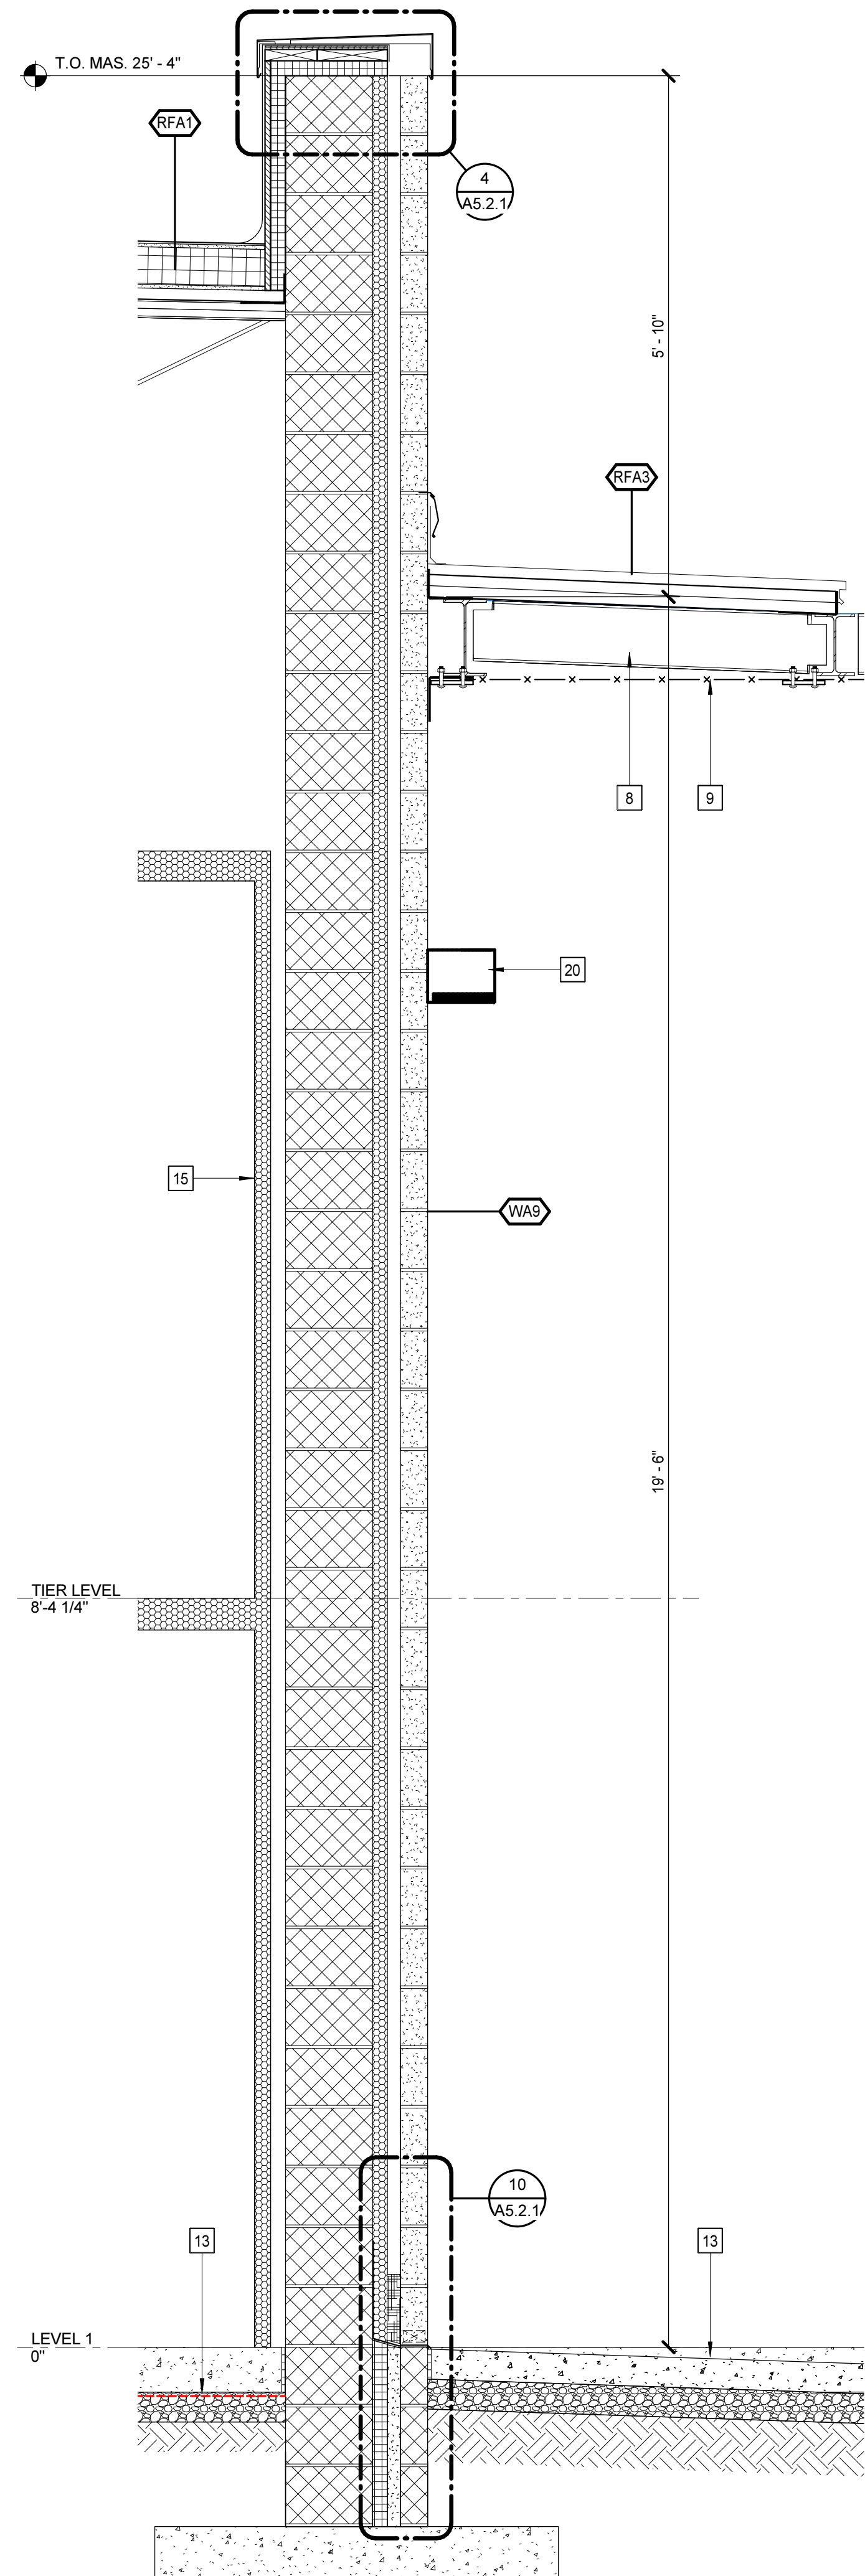


1 WALL SECTION
A2.1.2 | A5.1.3 | 3/4" = 1'-0"

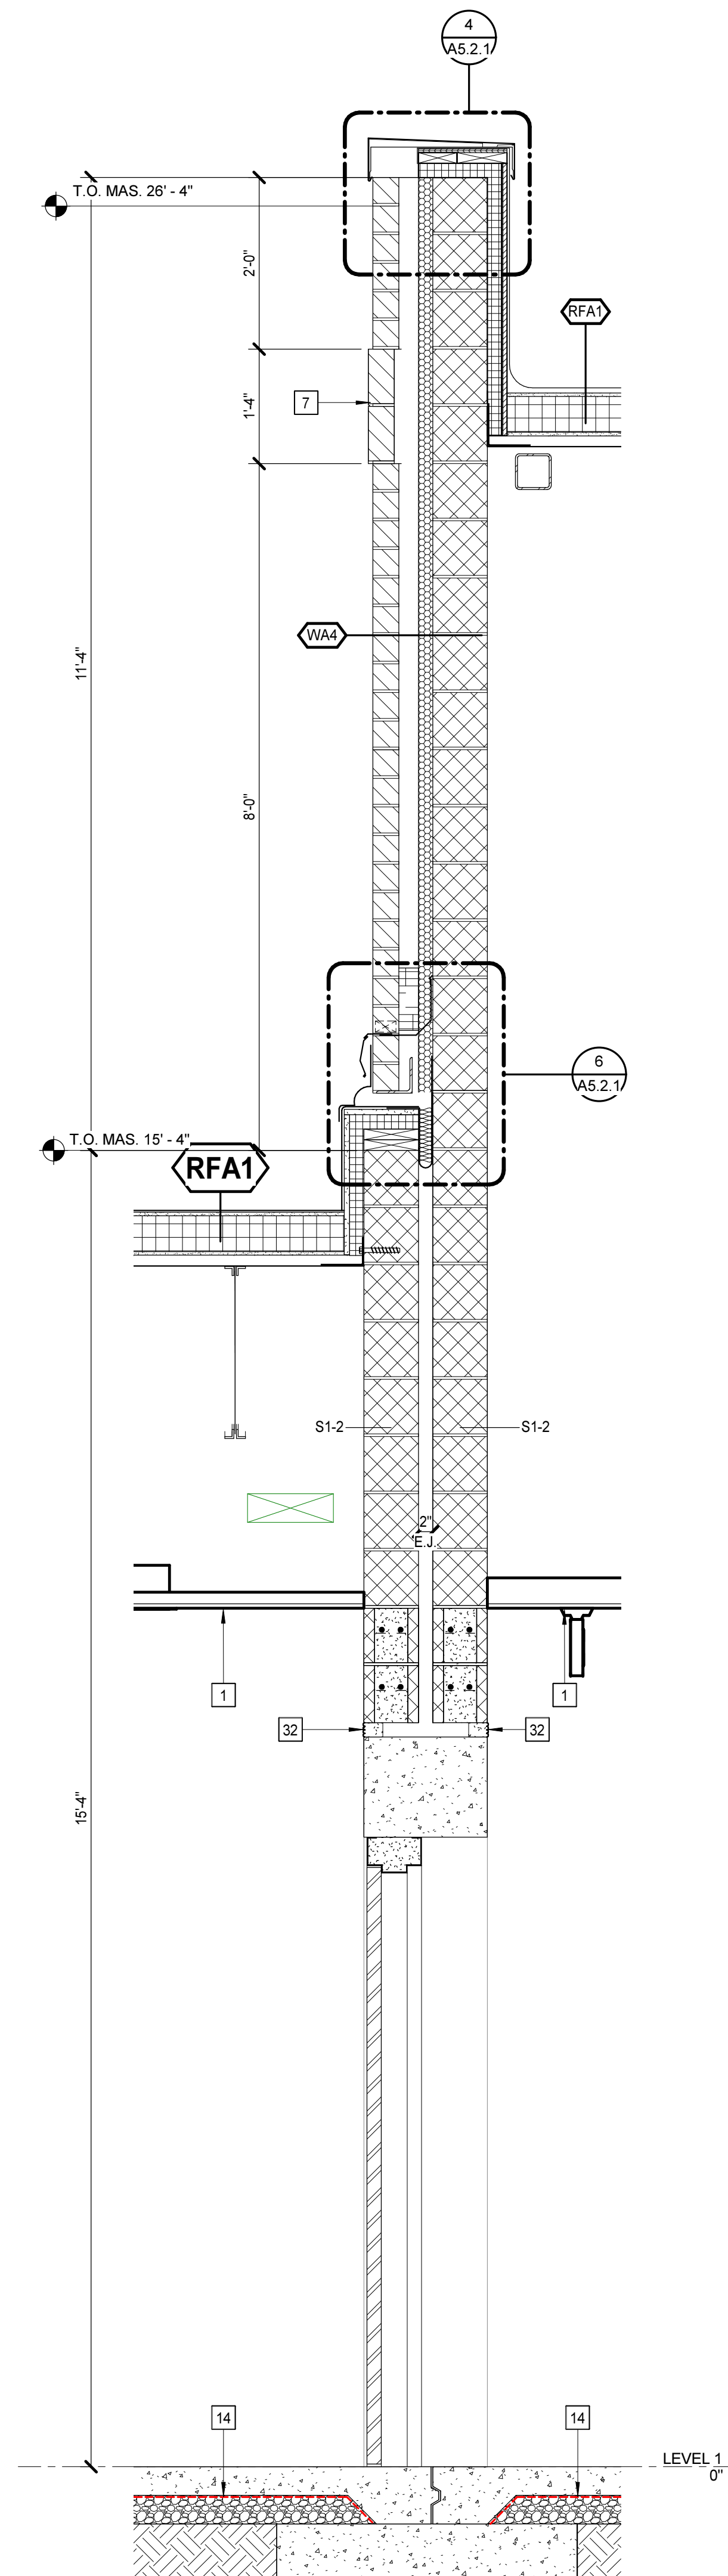


2 WALL SECTION
A2.1.1 | A5.1.3 | 3/4" = 1'-0"

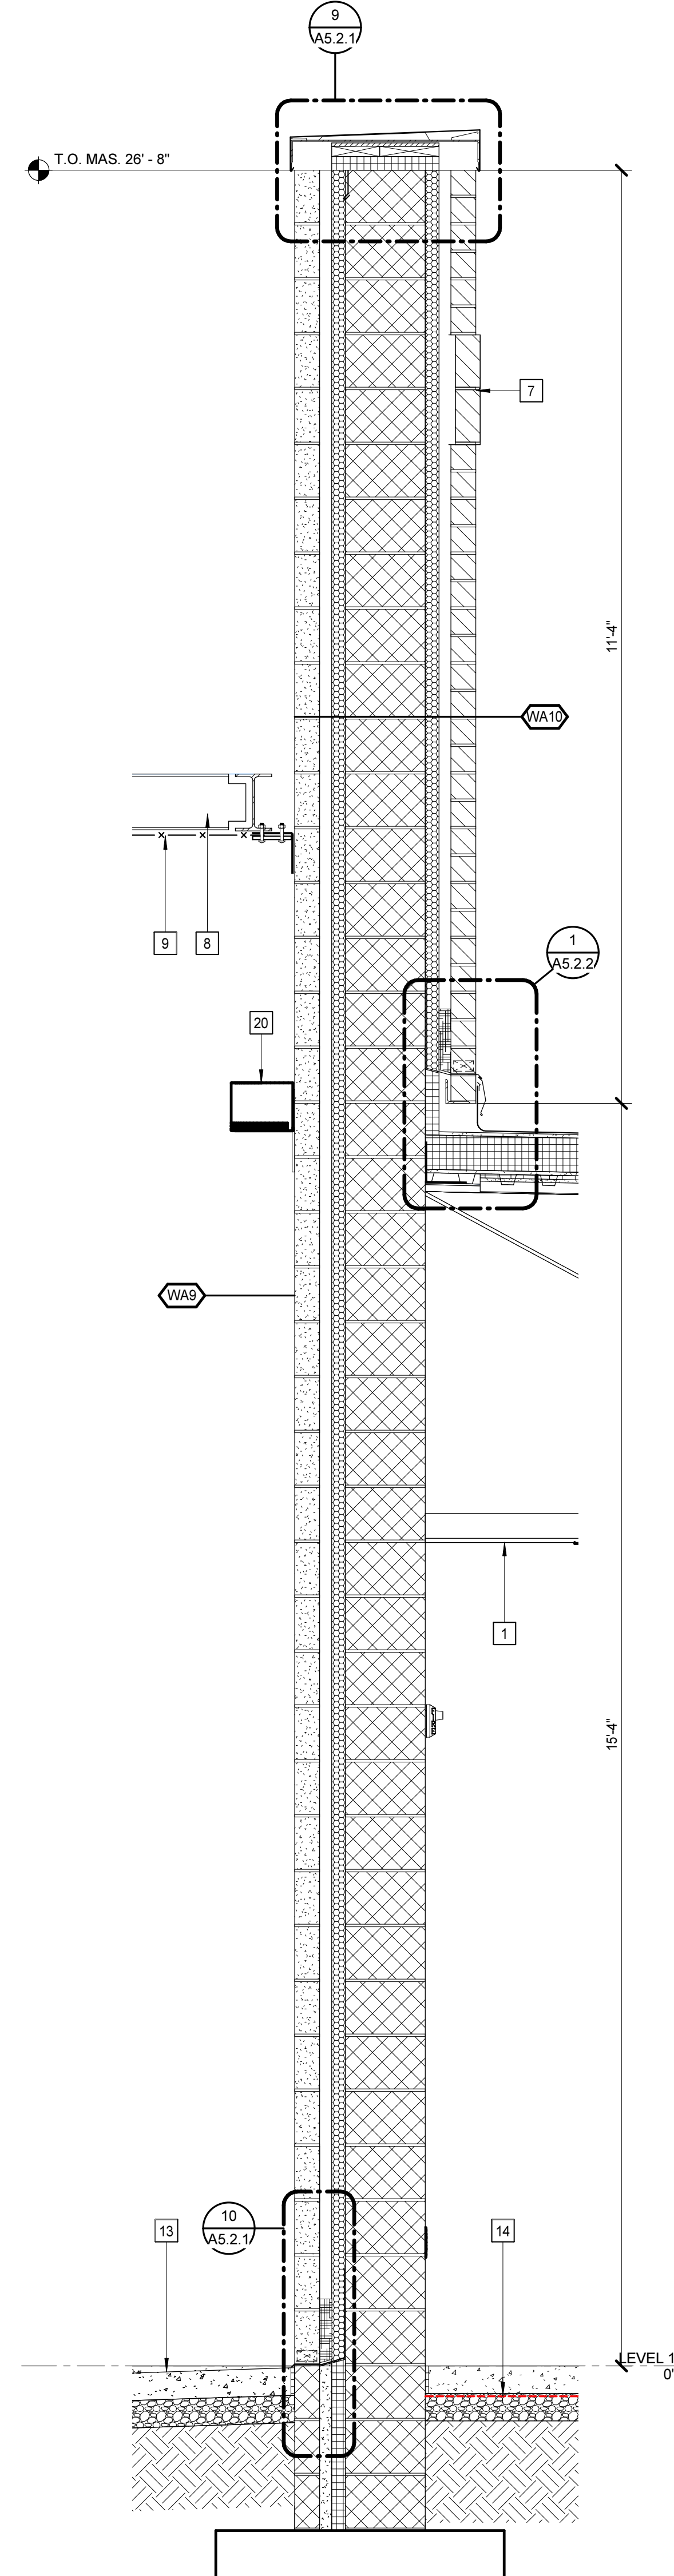

3 WALL SECTION
A2.1.1 | A5.1.3 | 3/4" = 1'-0"

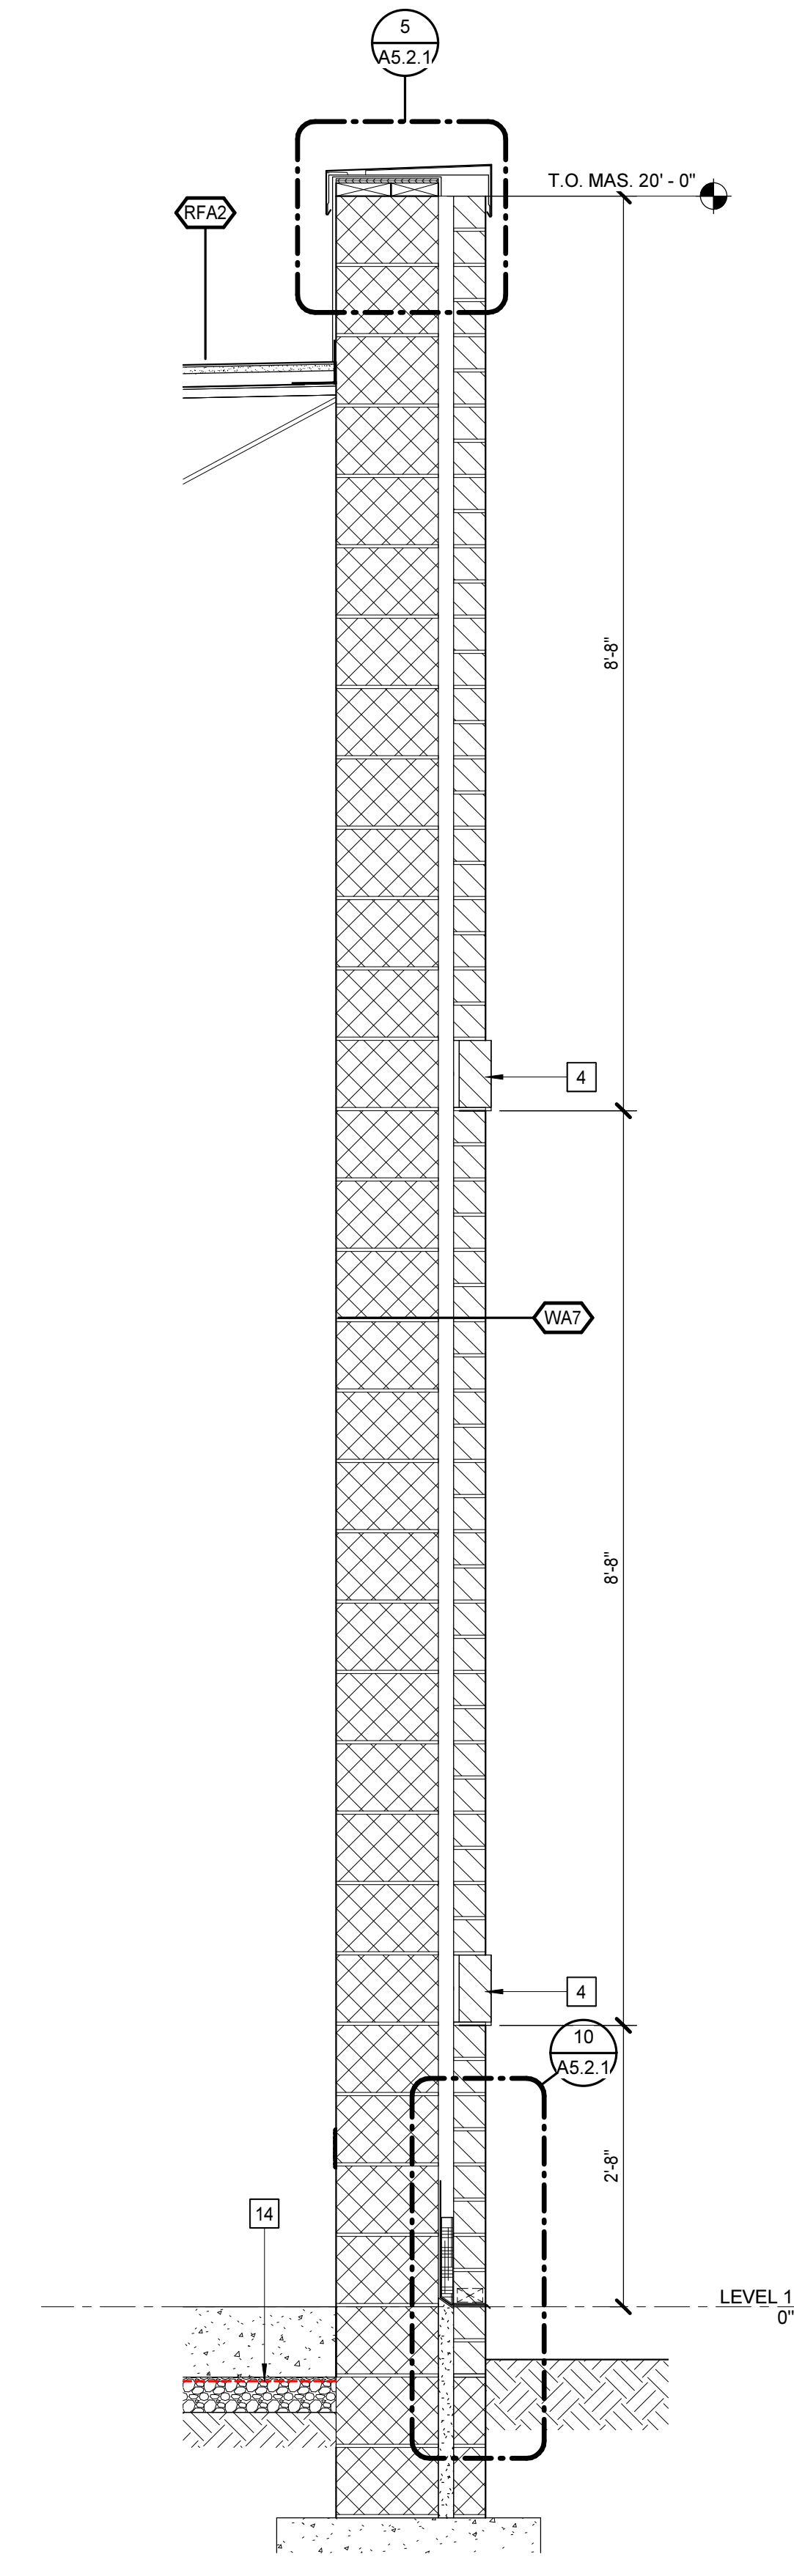

4 WALL SECTION
A2.1.1 | A5.1.3 | 3/4" = 1'-0"

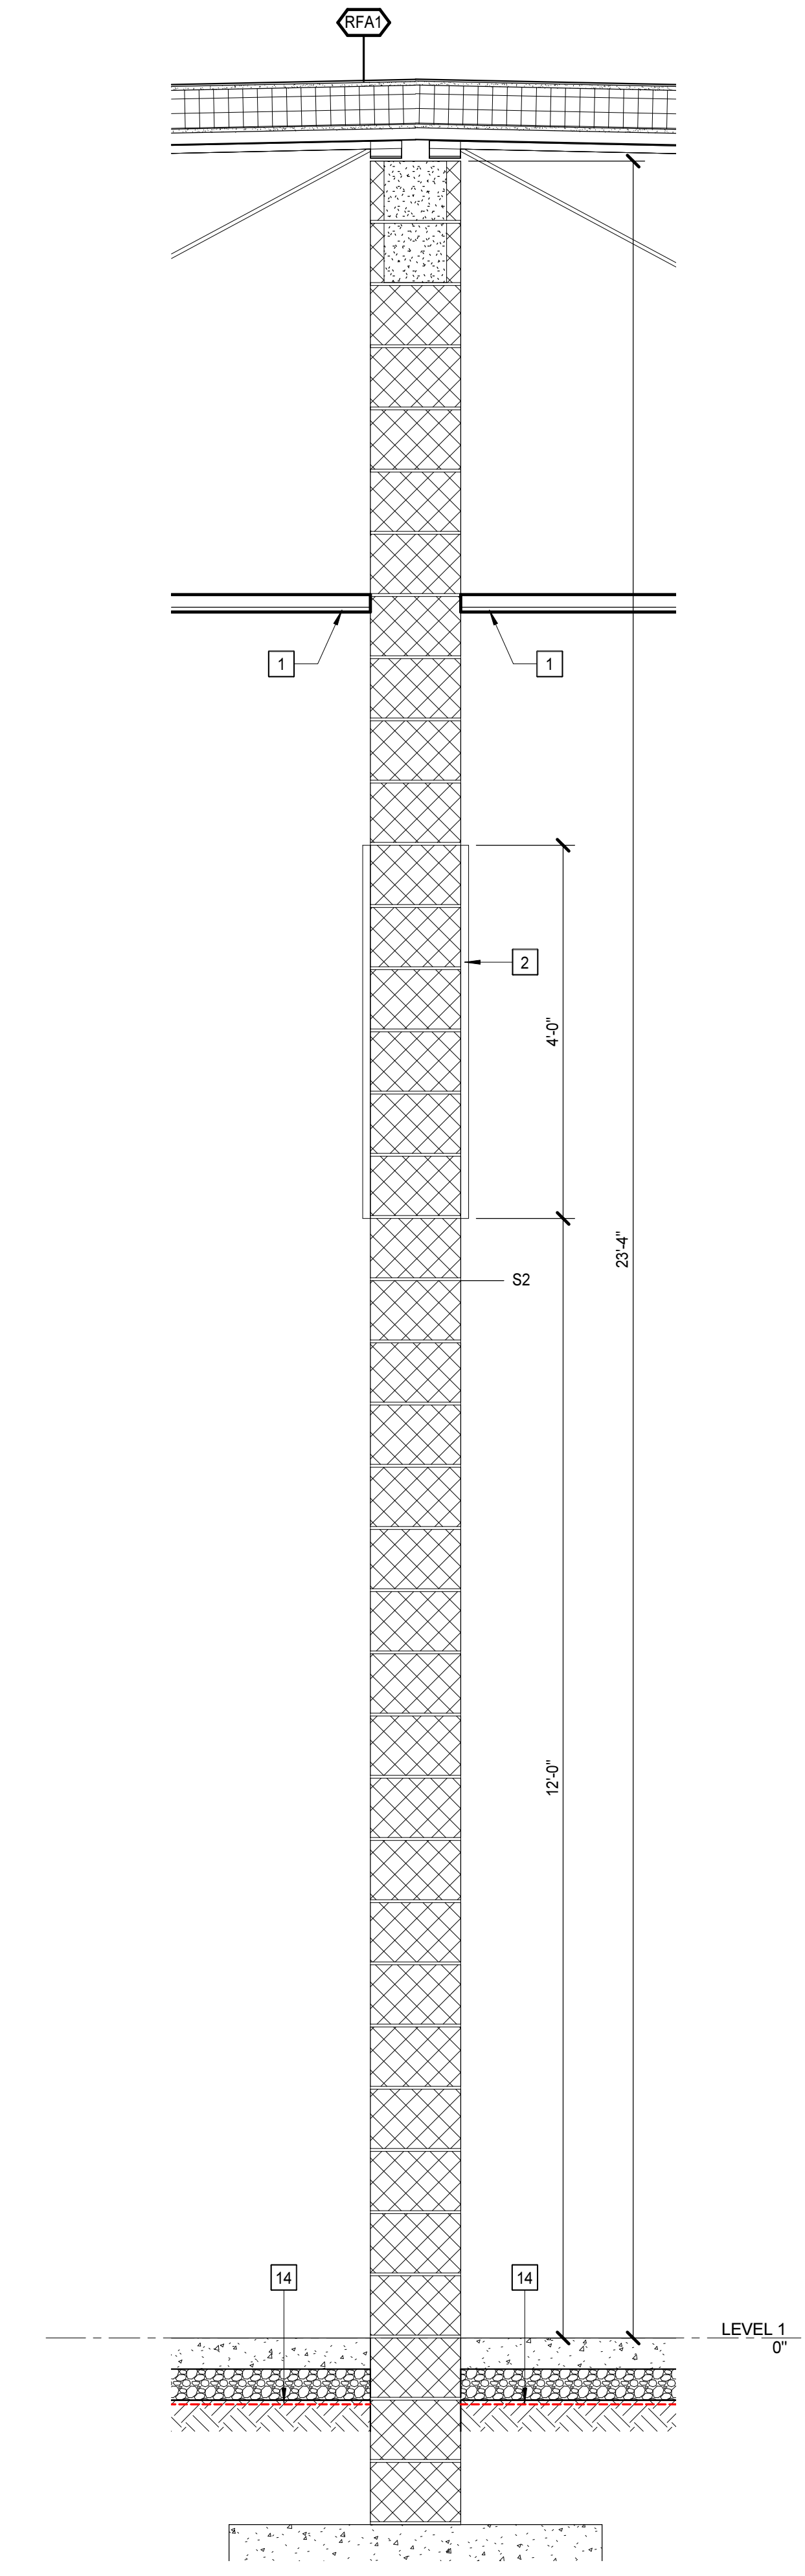


5 WALL SECTION
A2.1.2 | A5.1.3 | 3/4" = 1'-0"

WALL SECTION KEYNOTES

APPLIES TO DRAWINGS A5.1.1 - A5.1.n
REPRESENTED BY [n]

1 CEILING PER A9 SERIES	17 STEEL GRATING ELEVATED SERVICE WALKWAY
2 ACOUSTICAL WALL PANEL	18 WALL MOUNTED LADDER
3 OVERHEAD COILING DOOR	19 CHASE LIGHT FIXTURE - SEE E-SERIES
4 5/8" PROJECTED SOLDIER COURSE	20 EXTERIOR LIGHT FIXTURE - SEE E-SERIES
5 ALUMINUM CURTAINWALL SYSTEM	21 ARCHITECTURALLY EXPOSED STRUCTURAL STEEL FRAMING
6 PREMANUFACTURED PROTECTIVE COVER	22 ALUMINUM COMPOSITE METAL PANEL
7 5/8" PROJECTED SOLDIER COURSE - 2 COURSE	23 5/8" RECESSED SOLDIER COURSE
8 STRUCTURAL STEEL PER S-SERIES	24 5/8" RECESSED BRICK COURSE
9 SECURITY BARRIER MESH, 1/4" X 6" BATTEN PLATE AND THRU-BOLTS @ 12" O.C.	25 RAISED ACCESS FLOORING SYSTEM
10 CONCRETE FRAME - REFER TO S-SERIES	26 DEPRESSED SLAB - SEE S-SERIES
11 DETENTION HOLLOW METAL FRAME - REFER TO DETENTION FRAME SCHEDULE	27 DIMENSIONAL CHARACTERS - REFER TO DIVISION 10 SECTION "SIGNAGE"
12 SECURITY SEALANT	28 CONCEALED FASTENER METAL WALL PANEL
13 REC. YARD SLAB RECESSED 1/4"	29 REFER TO SHEET A0.1 FOR RATED TOP OF WALL TERMINATION NOTES
14 VAPOR BARRIER	30 NOT USED
15 STEEL CELL PER DIVISION 13	31 CONC. SPLASH BLOCK
16 3'-6" HIGH, 1-1/4" DIA. STEEL PIPE GUARDRAIL & GATE	32 FIRE RATED, PICK RESISTANT, COMPRESSIBLE WALL SEAL

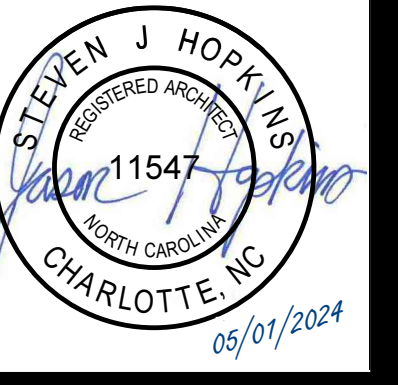

PENDER COUNTY LEC

DHSR# J-368 / FID# 220537
PENDER COUNTY, NORTH CAROLINA
1417 OLD SAVANNAH ROAD BURGAW, NC

PROJECT NO:	611688
DATE:	06/11/2024
REVISIONS	
DATE	DESCRIPTION
06/12/24	AD-03



WALL SECTIONS

A5.1.3


WALL SECTION KEYNOTES

APPLIES TO DRAWINGS A5.1.1 - A5.1.n
REPRESENTED BY [Symbol]


1 CEILING PER A6 SERIES	17 STEEL GRATING ELEVATED SERVICE WALKWAY
2 ACOUSTICAL WALL PANEL	18 WALL MOUNTED LADDER
3 OVERHEAD COILING DOOR	19 CHASE LIGHT FIXTURE, SEE E-SERIES
4 5/8" PROJECTED SOLDIER COURSE	20 EXTERIOR LIGHT FIXTURE - SEE E-SERIES
5 ALUMINUM CURTAINWALL SYSTEM	21 ARCHITECTURALLY EXPOSED STRUCTURAL STEEL FRAMING
6 PREMANUFACTURED PROTECTIVE COVER	22 ALUMINUM COMPOSITE METAL PANEL
7 5/8" PROJECTED SOLDIER COURSE - 2 COURSE	23 5/8" RECESSED SOLDIER COURSE
8 STRUCTURAL STEEL PER S-SERIES	24 5/8" RECESSED BRICK COURSE
9 SECURITY BARRIER MESH, 1/4" X 6" BATTEN PLATE AND THRU-BOLTS @ 12" O.C.	25 RAISED ACCESS FLOORING SYSTEM
10 CONCRETE FRAME - REFER TO S-SERIES	26 DEPRESSED SLAB - SEE S-SERIES
11 DETENTION HOLLOW METAL FRAME - REFER TO DETENTION FRAME SCHEDULE	27 DIMENSIONAL CHARACTERS - REFER TO DIVISION 10 SECTION "SIGNAGE"
12 SECURITY SEALANT	28 CONCEALED FASTENER METAL WALL PANEL
13 REC. YARD SLAB RECESSED 1/4"	29 REFER TO SHEET A0.1 FOR RATED TOP OF WALL TERMINATION NOTES
14 VAPOR BARRIER	30 NOT USED
15 STEEL CELL PER DIVISION 13	31 CONC. SPLASH BLOCK
16 3'-6" HIGH, 1-1/4" DIA. STEEL PIPE GUARDRAIL & GATE	32 FIRE RATED, PICK RESISTANT, COMPRESSIBLE WALL SEAL

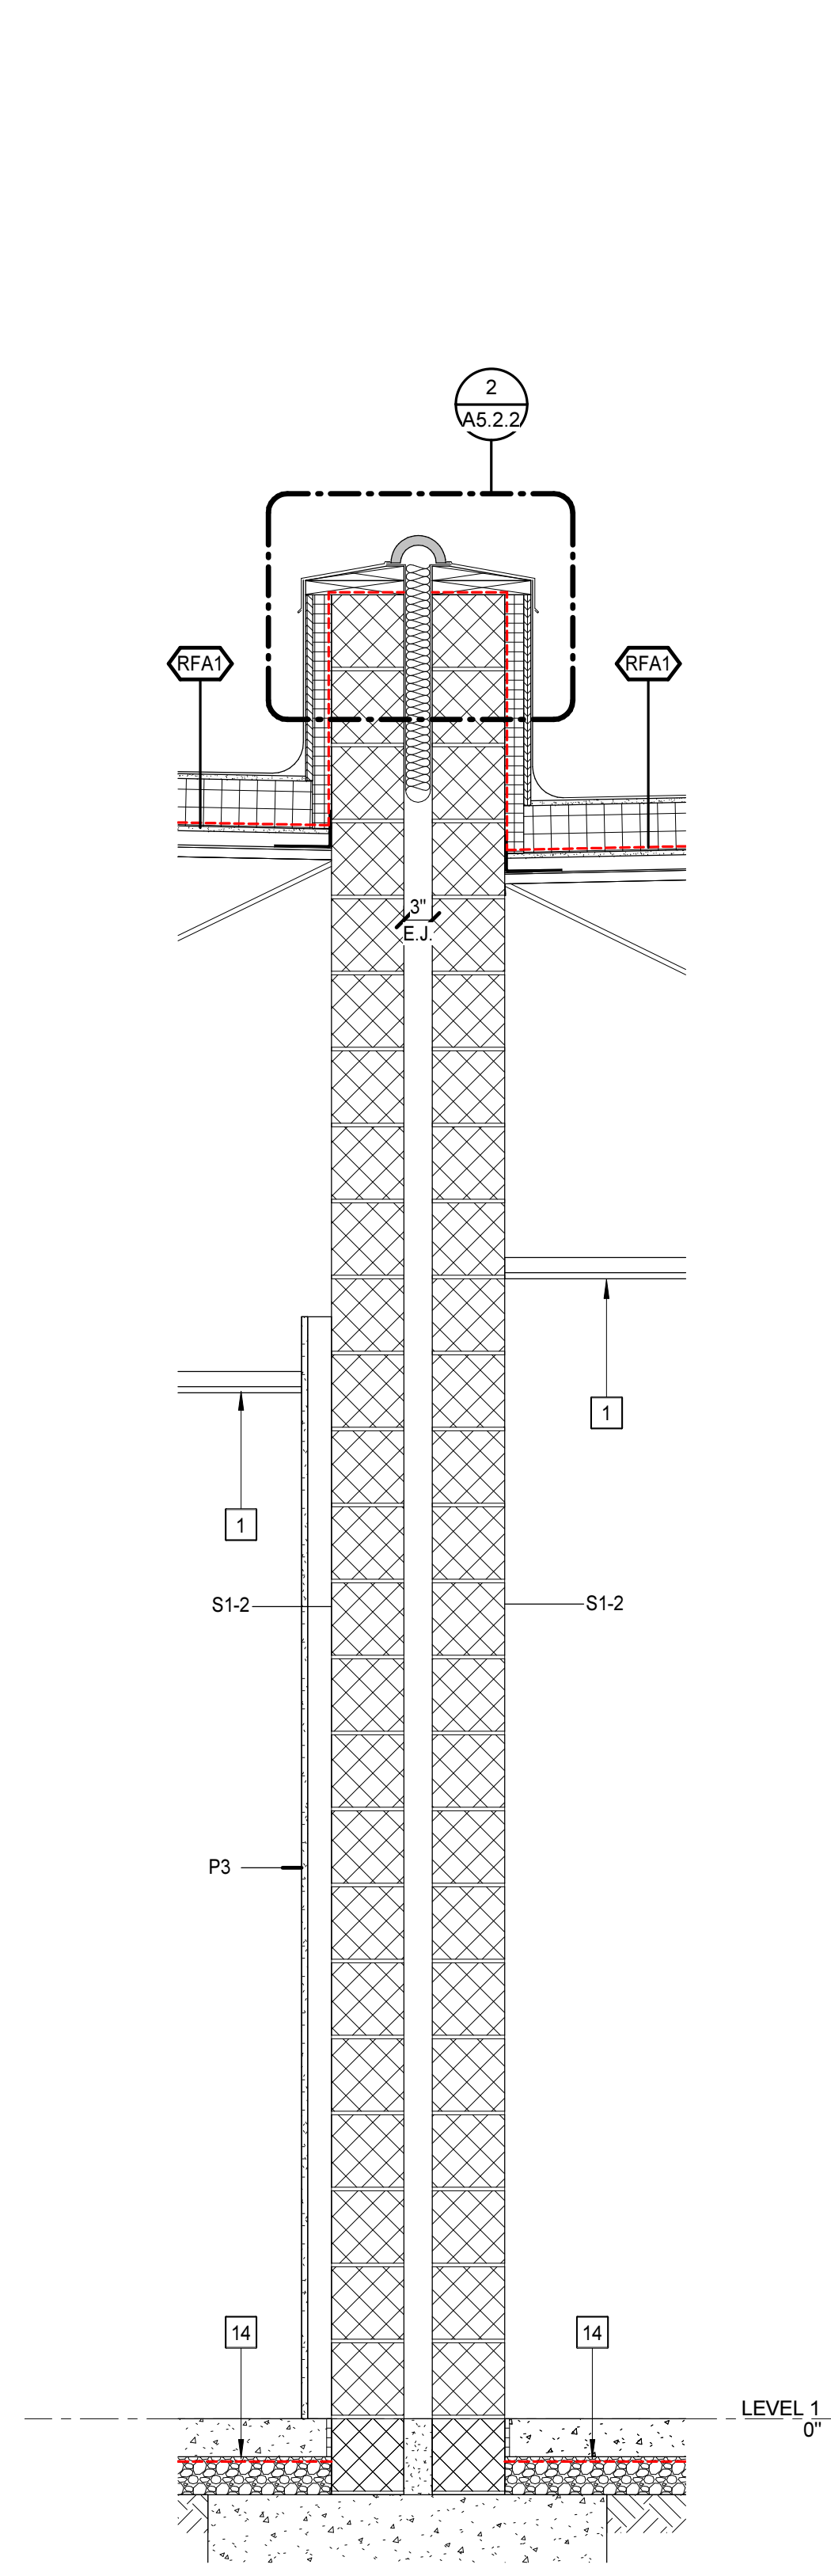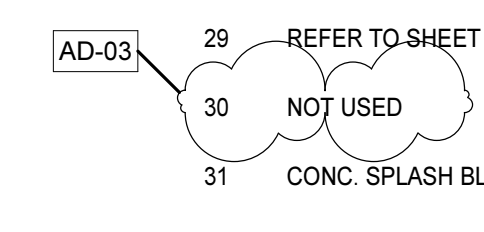


1 WALL SECTION
A2.1.1 A5.1.4 3/4" = 1'-0"

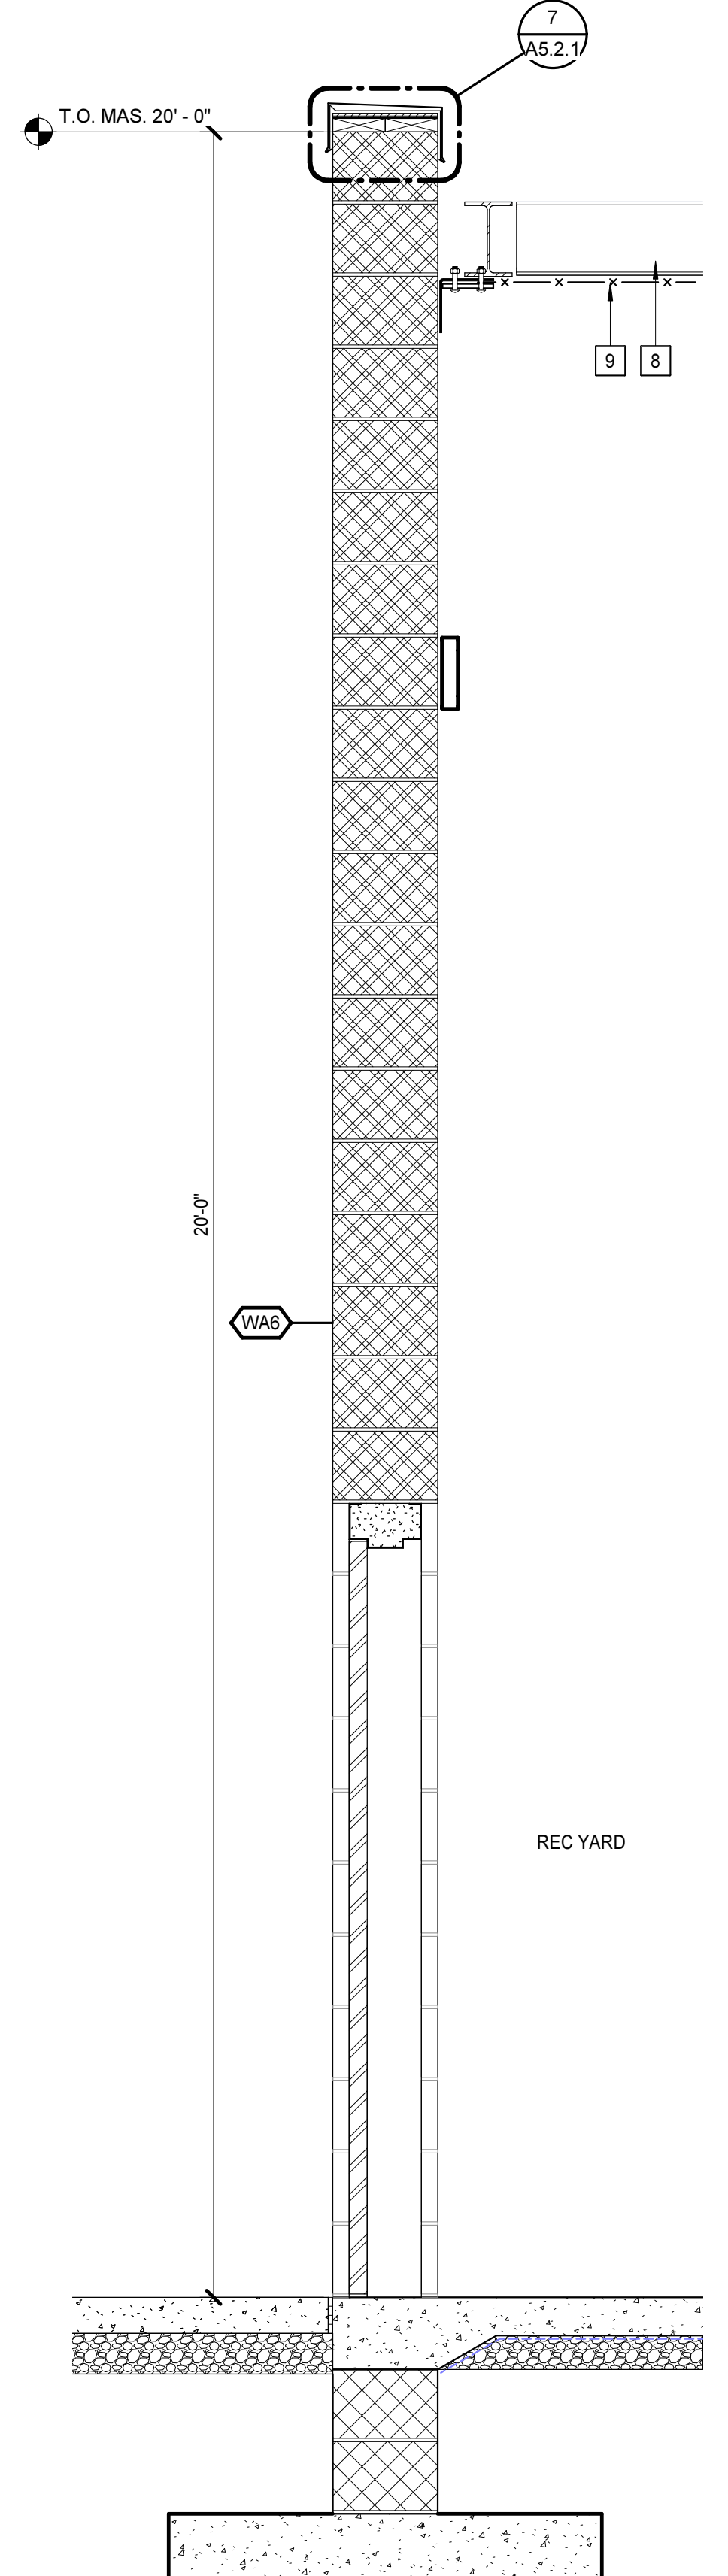


2 WALL SECTION
A2.1.2 A5.1.4 3/4" = 1'-0"

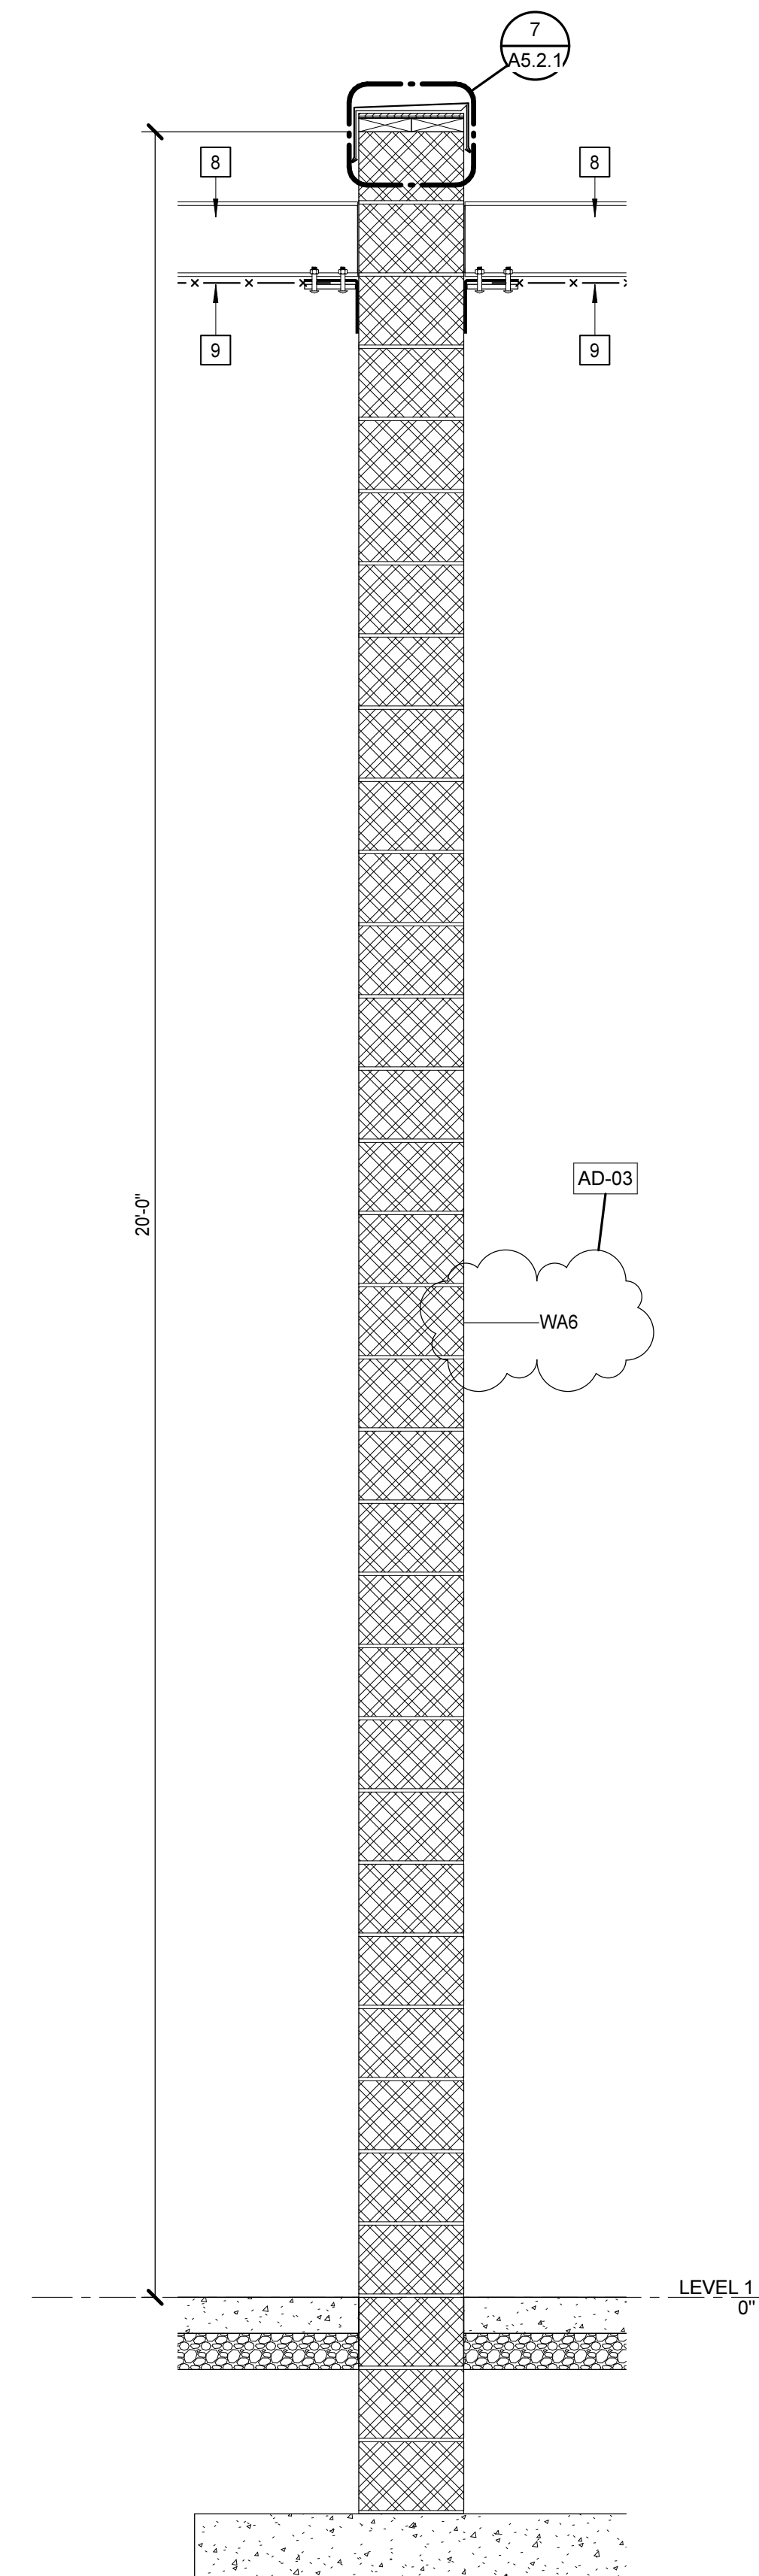

3 WALL SECTION
A2.1.2 A5.1.4 3/4" = 1'-0"

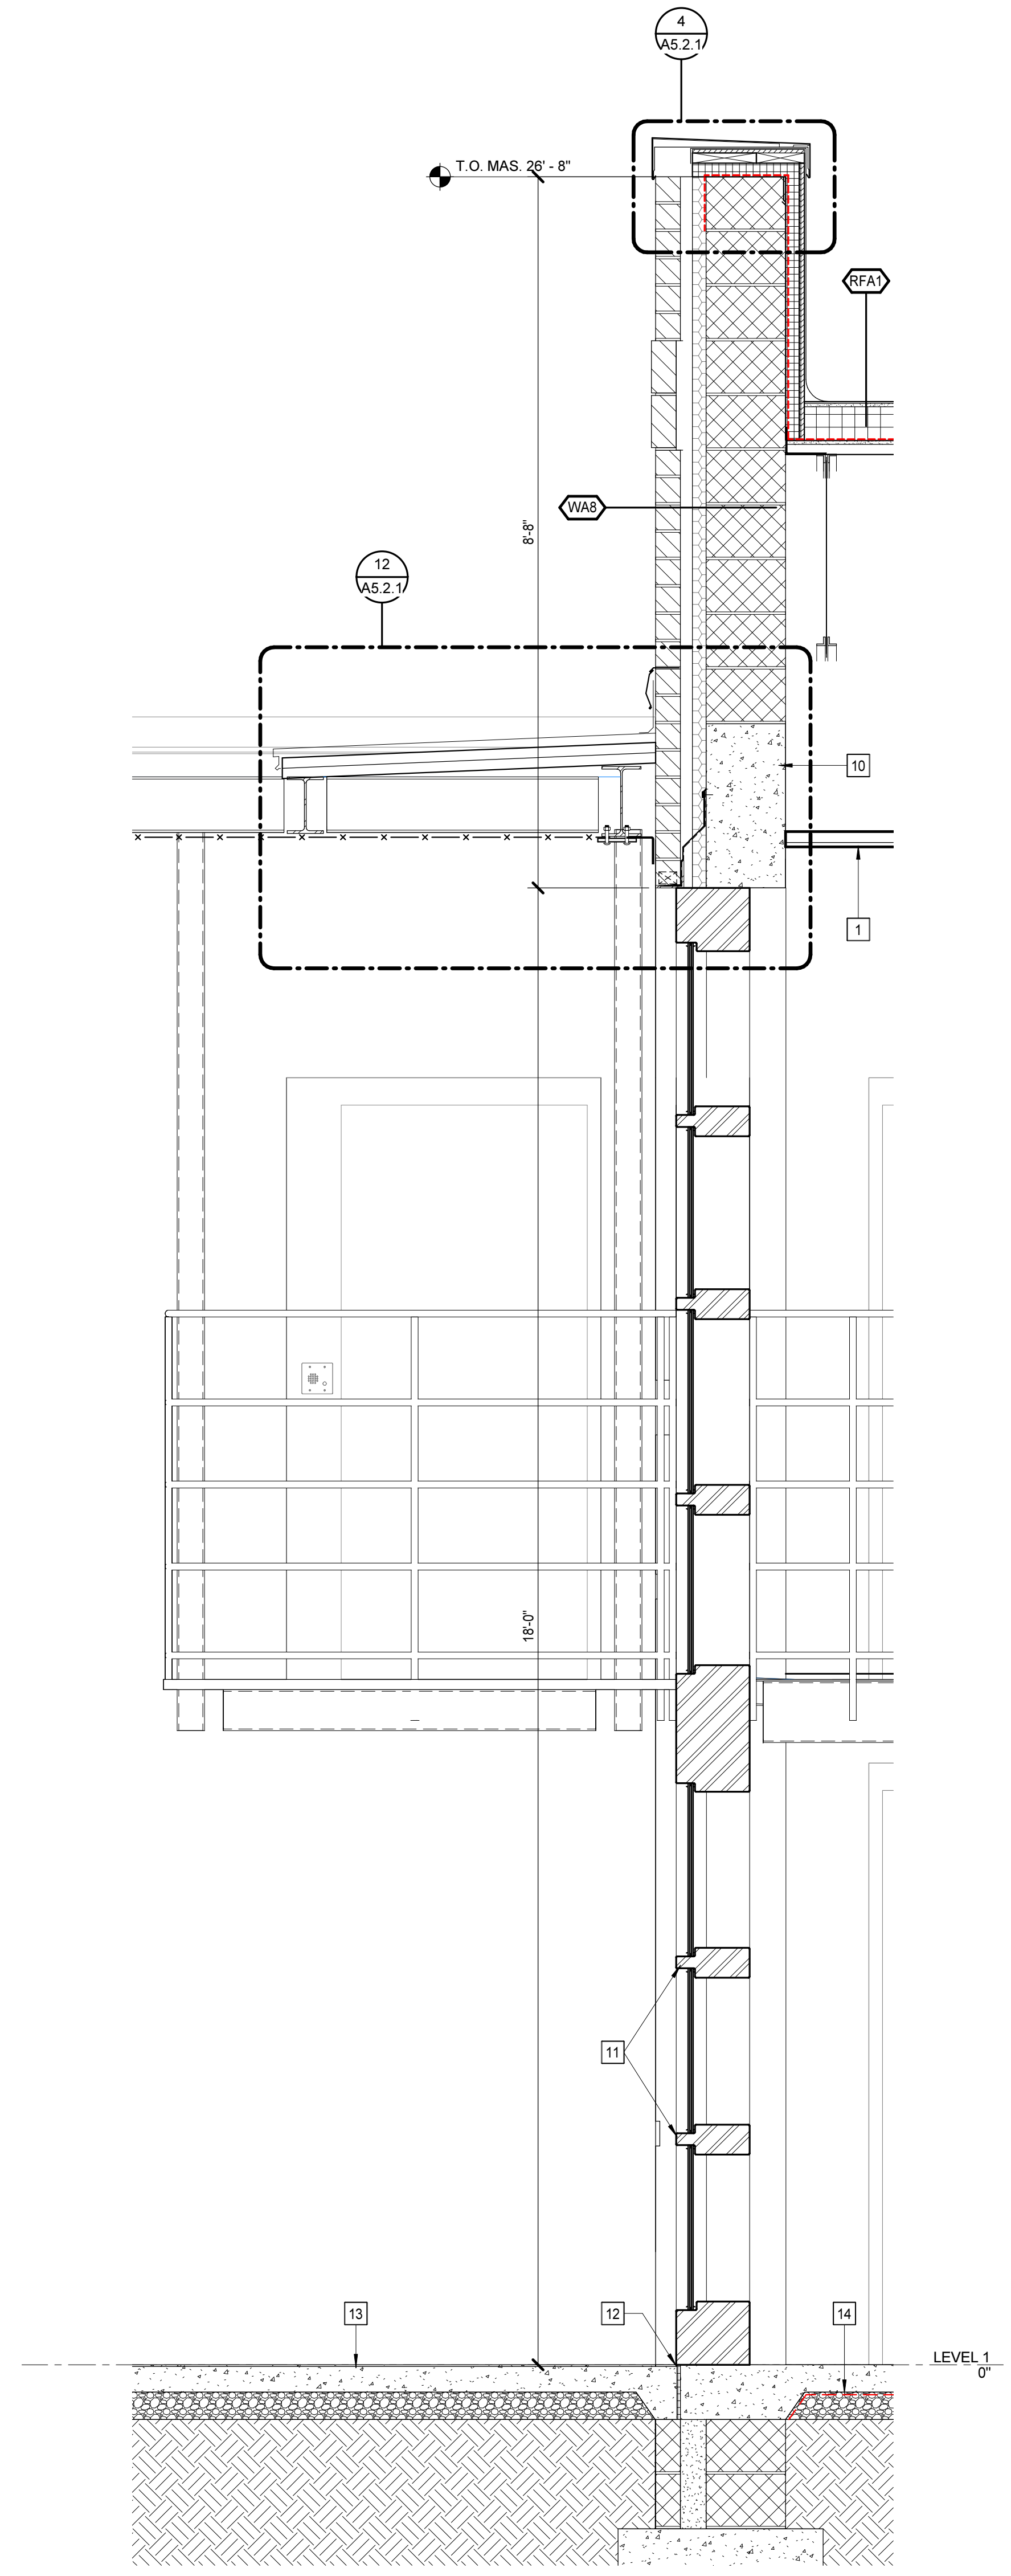

4 WALL SECTION
A2.1.2 A5.1.4 3/4" = 1'-0"

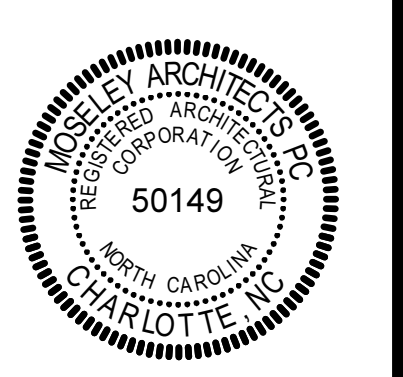


PENDER COUNTY LEC
DHSR# J-368 / FID# 220537
PENDER COUNTY, NORTH CAROLINA
1417 OLD SAVANNAH ROAD BURGAW, NC

PROJECT NO:	611688
DATE:	06/12/24
REVISIONS	
DATE	DESCRIPTION
06/12/24	AD-03

WALL SECTIONS


6/7/2024 2:22:47 PM

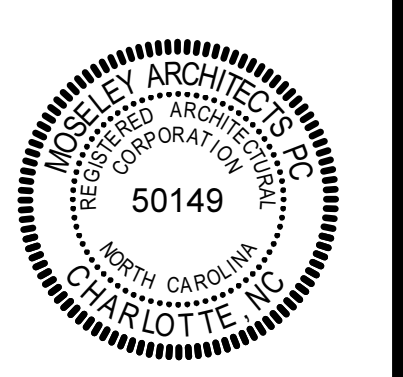


WALL SECTION KEYNOTES

APPLIES TO DRAWINGS A5.1.1 - A5.1.6
 REPRESENTED BY [M]


1 CEILING PER A9 SERIES	17 STEEL GRATING ELEVATED SERVICE WALKWAY
2 ACOUSTICAL WALL PANEL	18 WALL MOUNTED LADDER
3 OVERHEAD COILING DOOR	19 CHASE LIGHT FIXTURE. SEE E-SERIES
4 5/8" PROJECTED SOLDIER COURSE	20 EXTERIOR LIGHT FIXTURE - SEE E-SERIES
5 ALUMINUM CURTAINWALL SYSTEM	21 ARCHITECTURALLY EXPOSED STRUCTURAL STEEL FRAMING
6 PREMANUFACTURED PROTECTIVE COVER	22 ALUMINUM COMPOSITE METAL PANEL
7 5/8" PROJECTED SOLDIER COURSE - 2 COURSE	23 5/8" RECESSED SOLDIER COURSE
8 STRUCTURAL STEEL PER S-SERIES	24 5/8" RECESSED BRICK COURSE
9 SECURITY BARRIER MESH, 1/4" X 6" BATTEN PLATE AND THRU-BOLTS @ 12" O.C.	25 RAISED ACCESS FLOORING SYSTEM
10 CONCRETE FRAME - REFER TO S-SERIES	26 DEPRESSED SLAB - SEE S-SERIES
11 DETENTION HOLLOW METAL FRAME - REFER TO DETENTION FRAME SCHEDULE	27 DIMENSIONAL CHARACTERS - REFER TO DIVISION 10 SECTION "SIGNAGE"
12 SECURITY SEALANT	28 CONCEALED FASTENER METAL WALL PANEL
13 REC. YARD SLAB RECESSED 1/4"	29 REFER TO SHEET A0.1 FOR RATED TOP OF WALL TERMINATION NOTES
14 VAPOR BARRIER	30 NOT USED
15 STEEL CELL PER DIVISION 13	31 CONC. SPLASH BLOCK
16 3'-6" HIGH, 1-1/4" DIA. STEEL PIPE GUARDRAIL & GATE	32 FIRE RATED, PICK RESISTANT, COMPRESSIBLE WALL SEAL

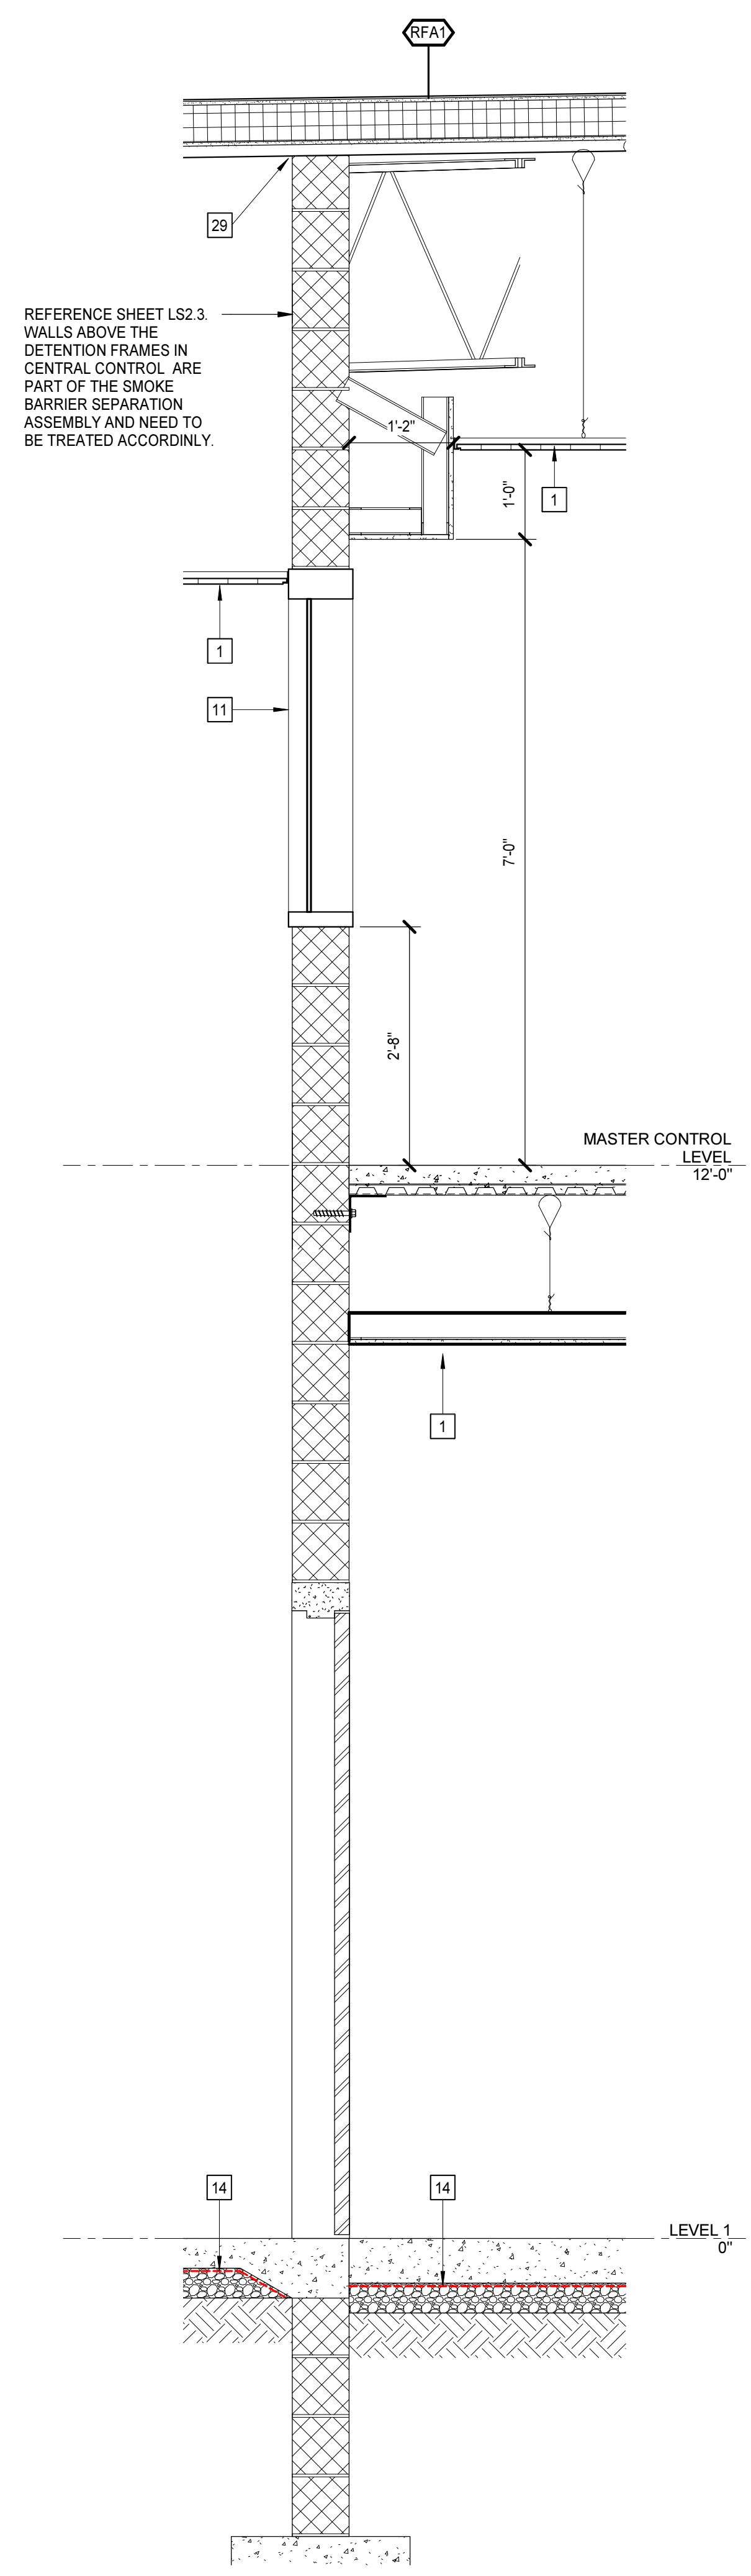


1 WALL SECTION
 A2.1.2 | A5.1.5 | 3/4" = 1'-0"

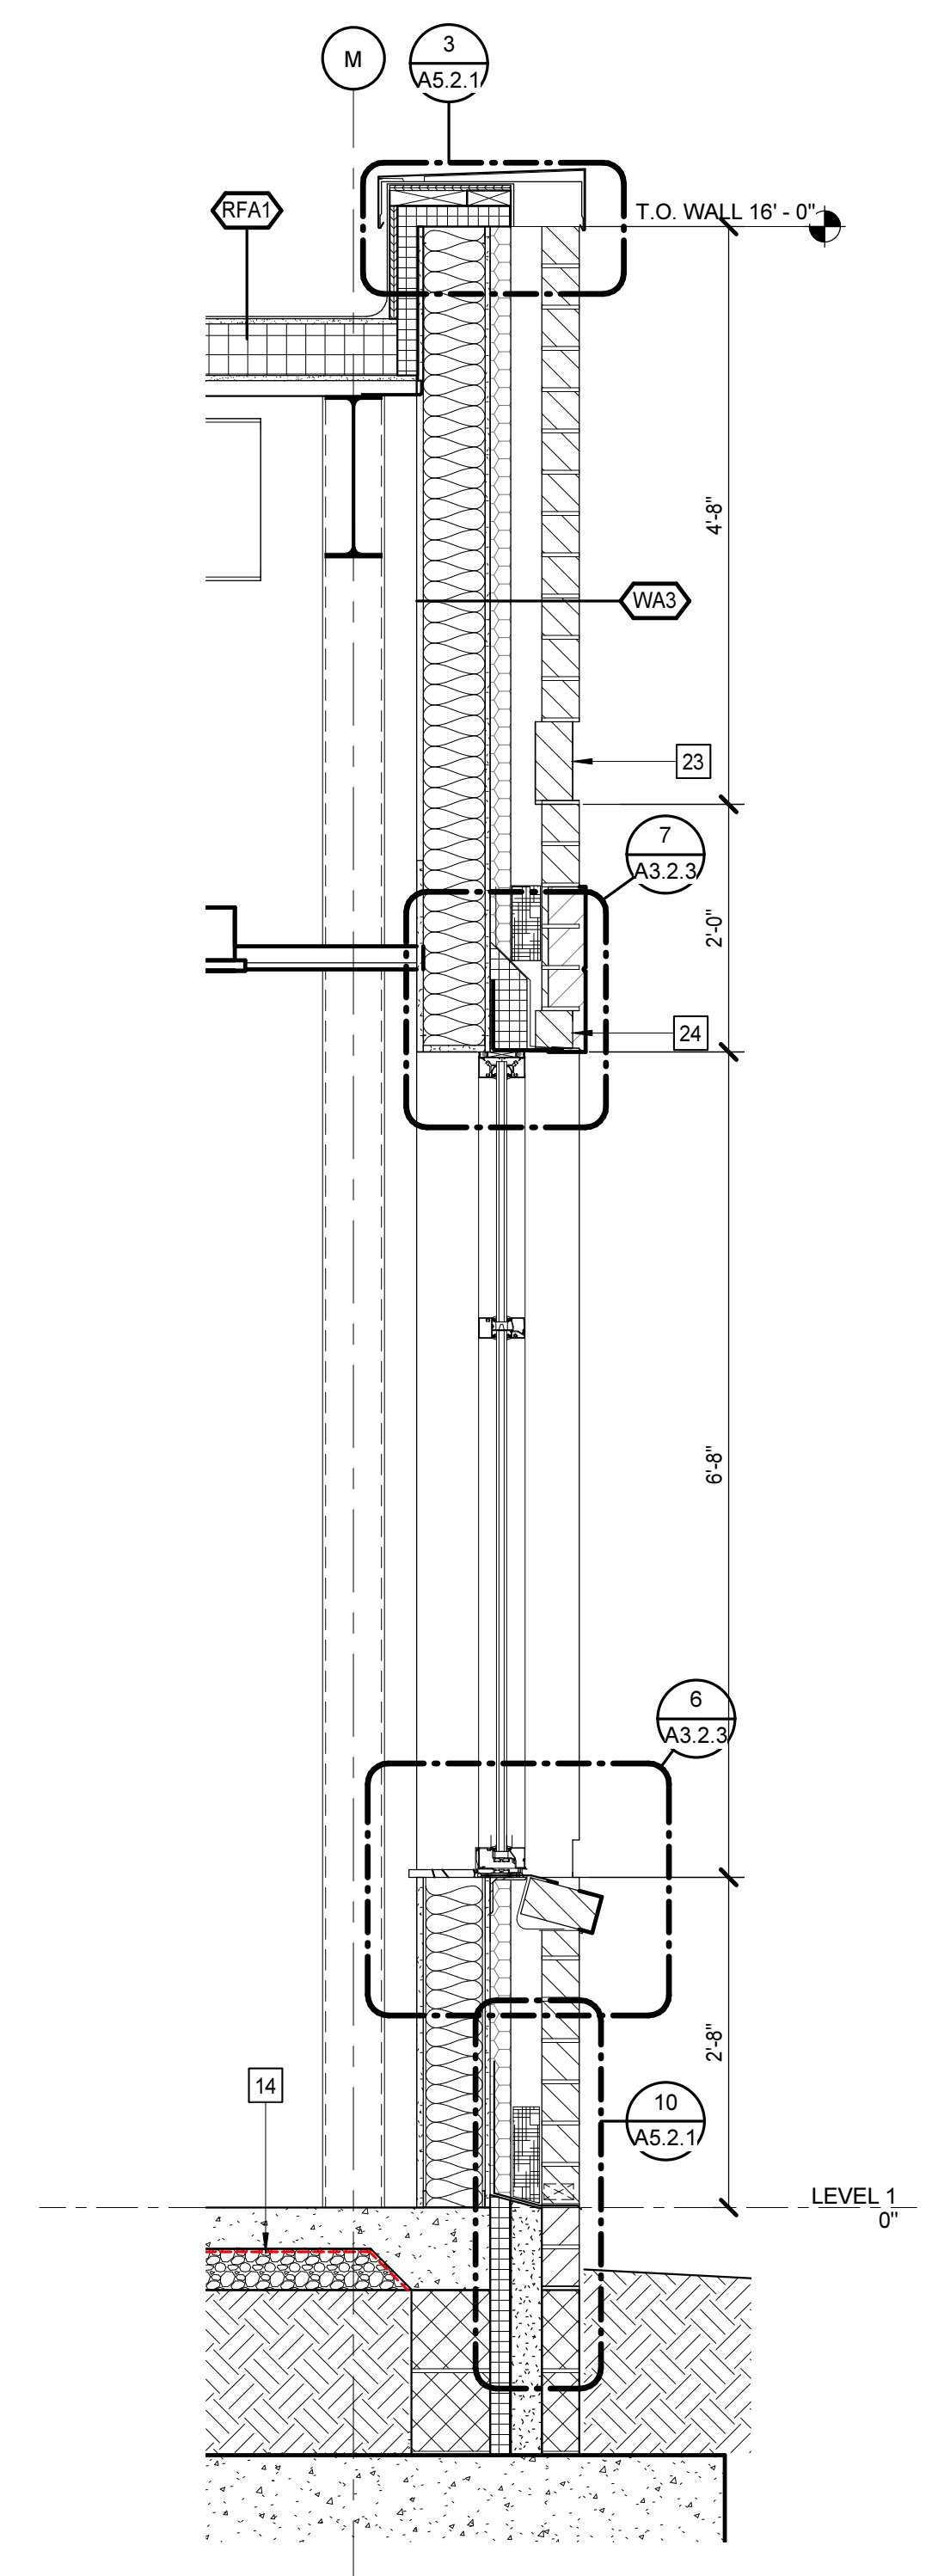


2 WALL SECTION
 A2.1.4 | A5.1.5 | 3/4" = 1'-0"

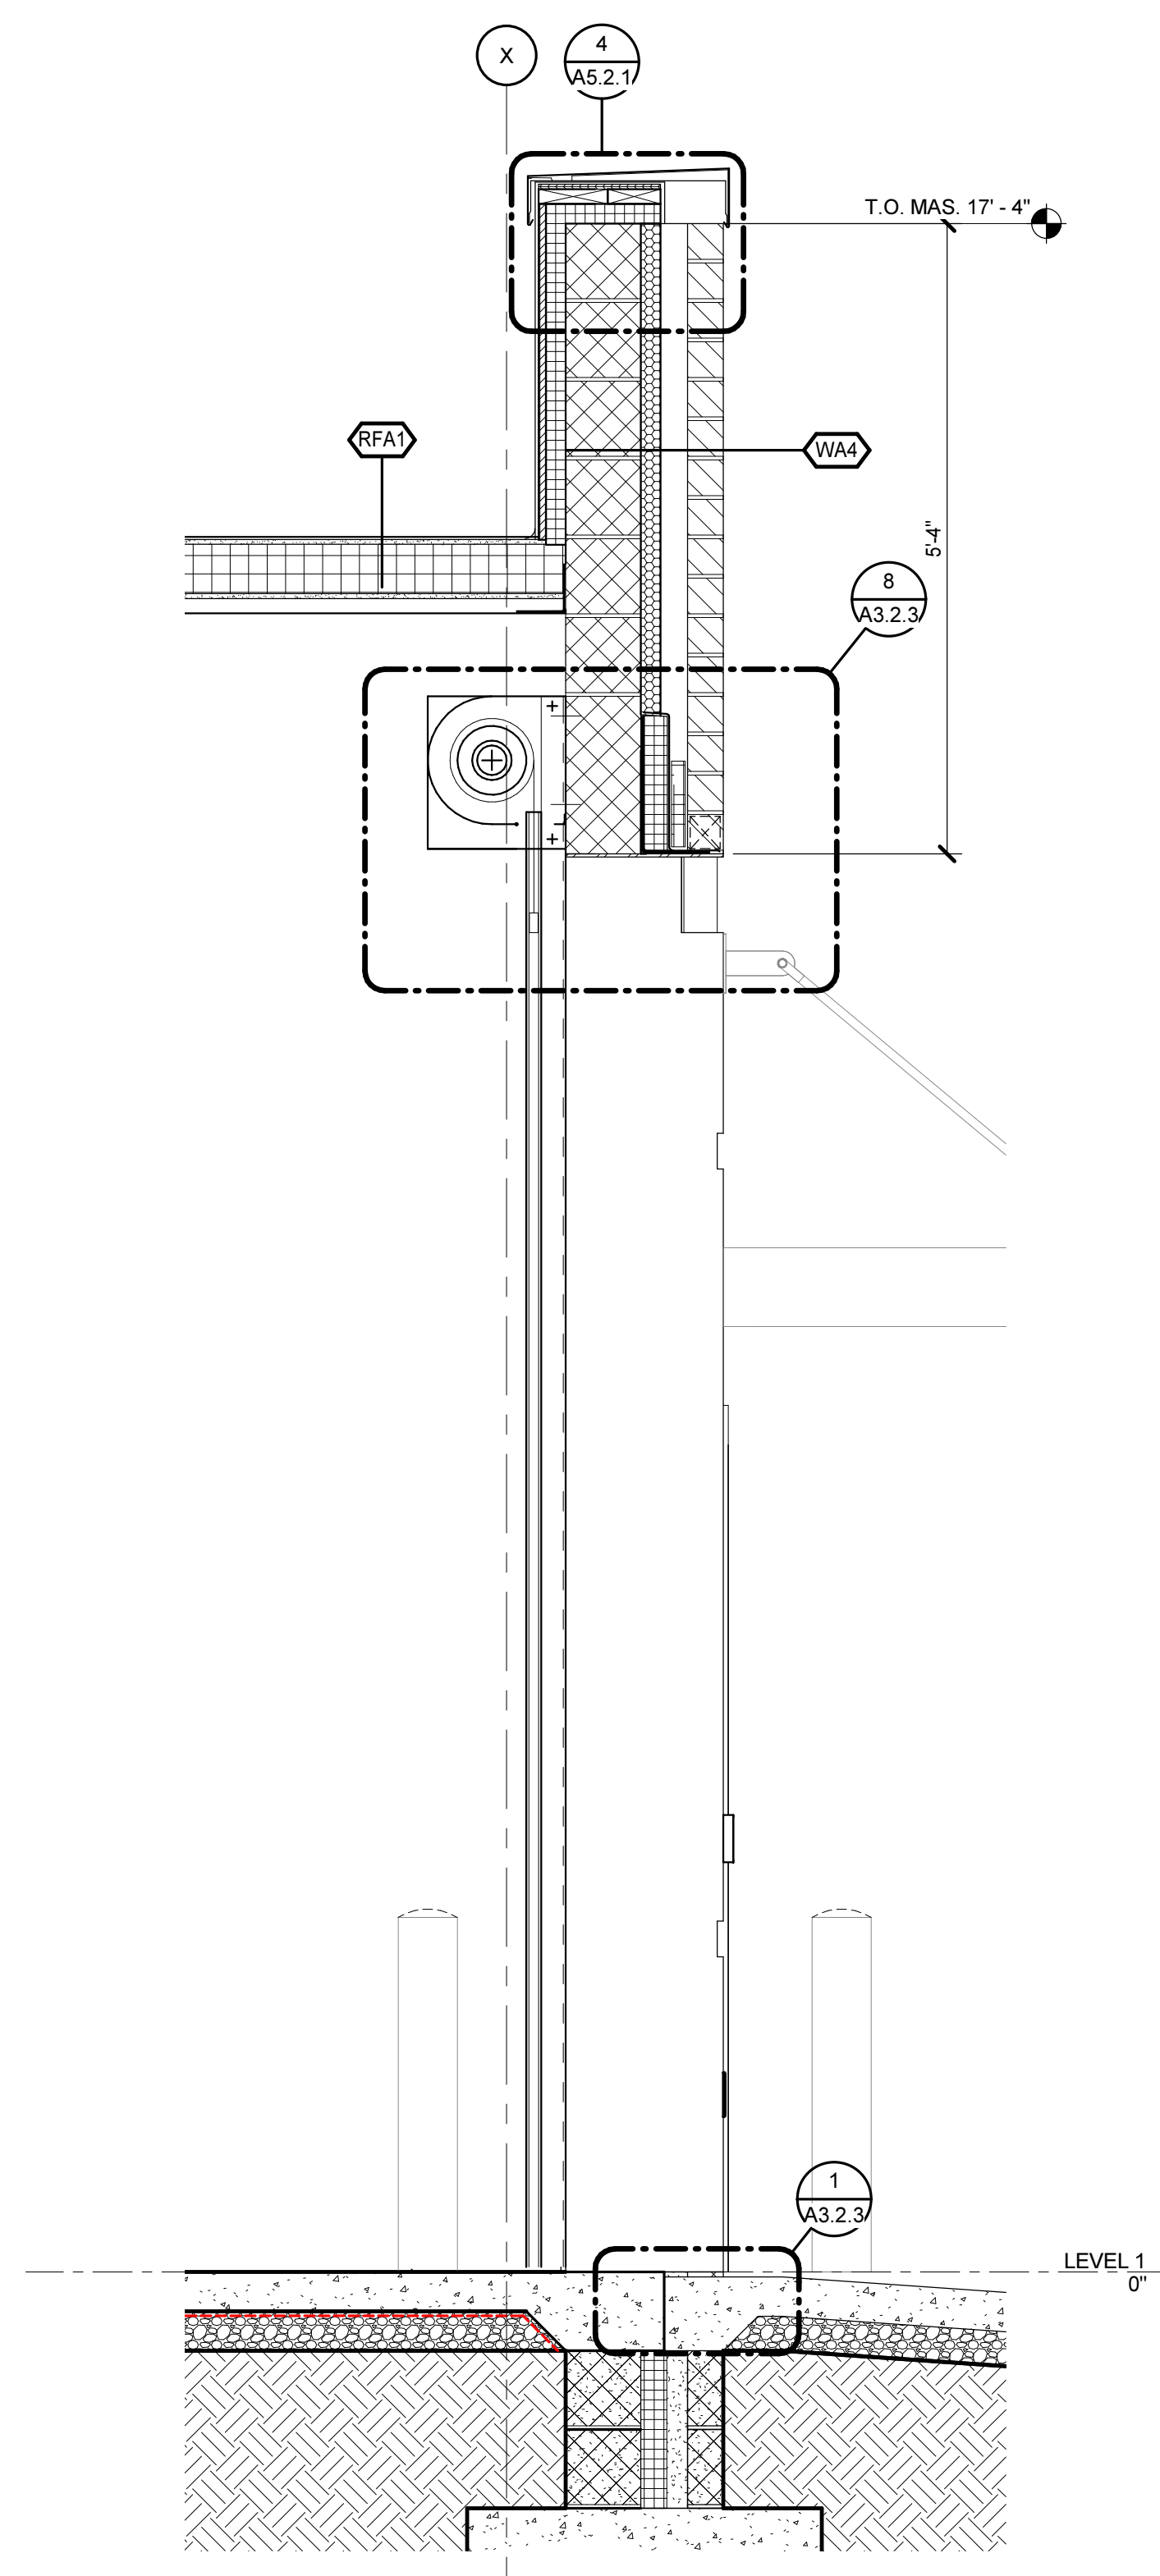

3 WALL SECTION
 A2.1.4 | A5.1.5 | 3/4" = 1'-0"

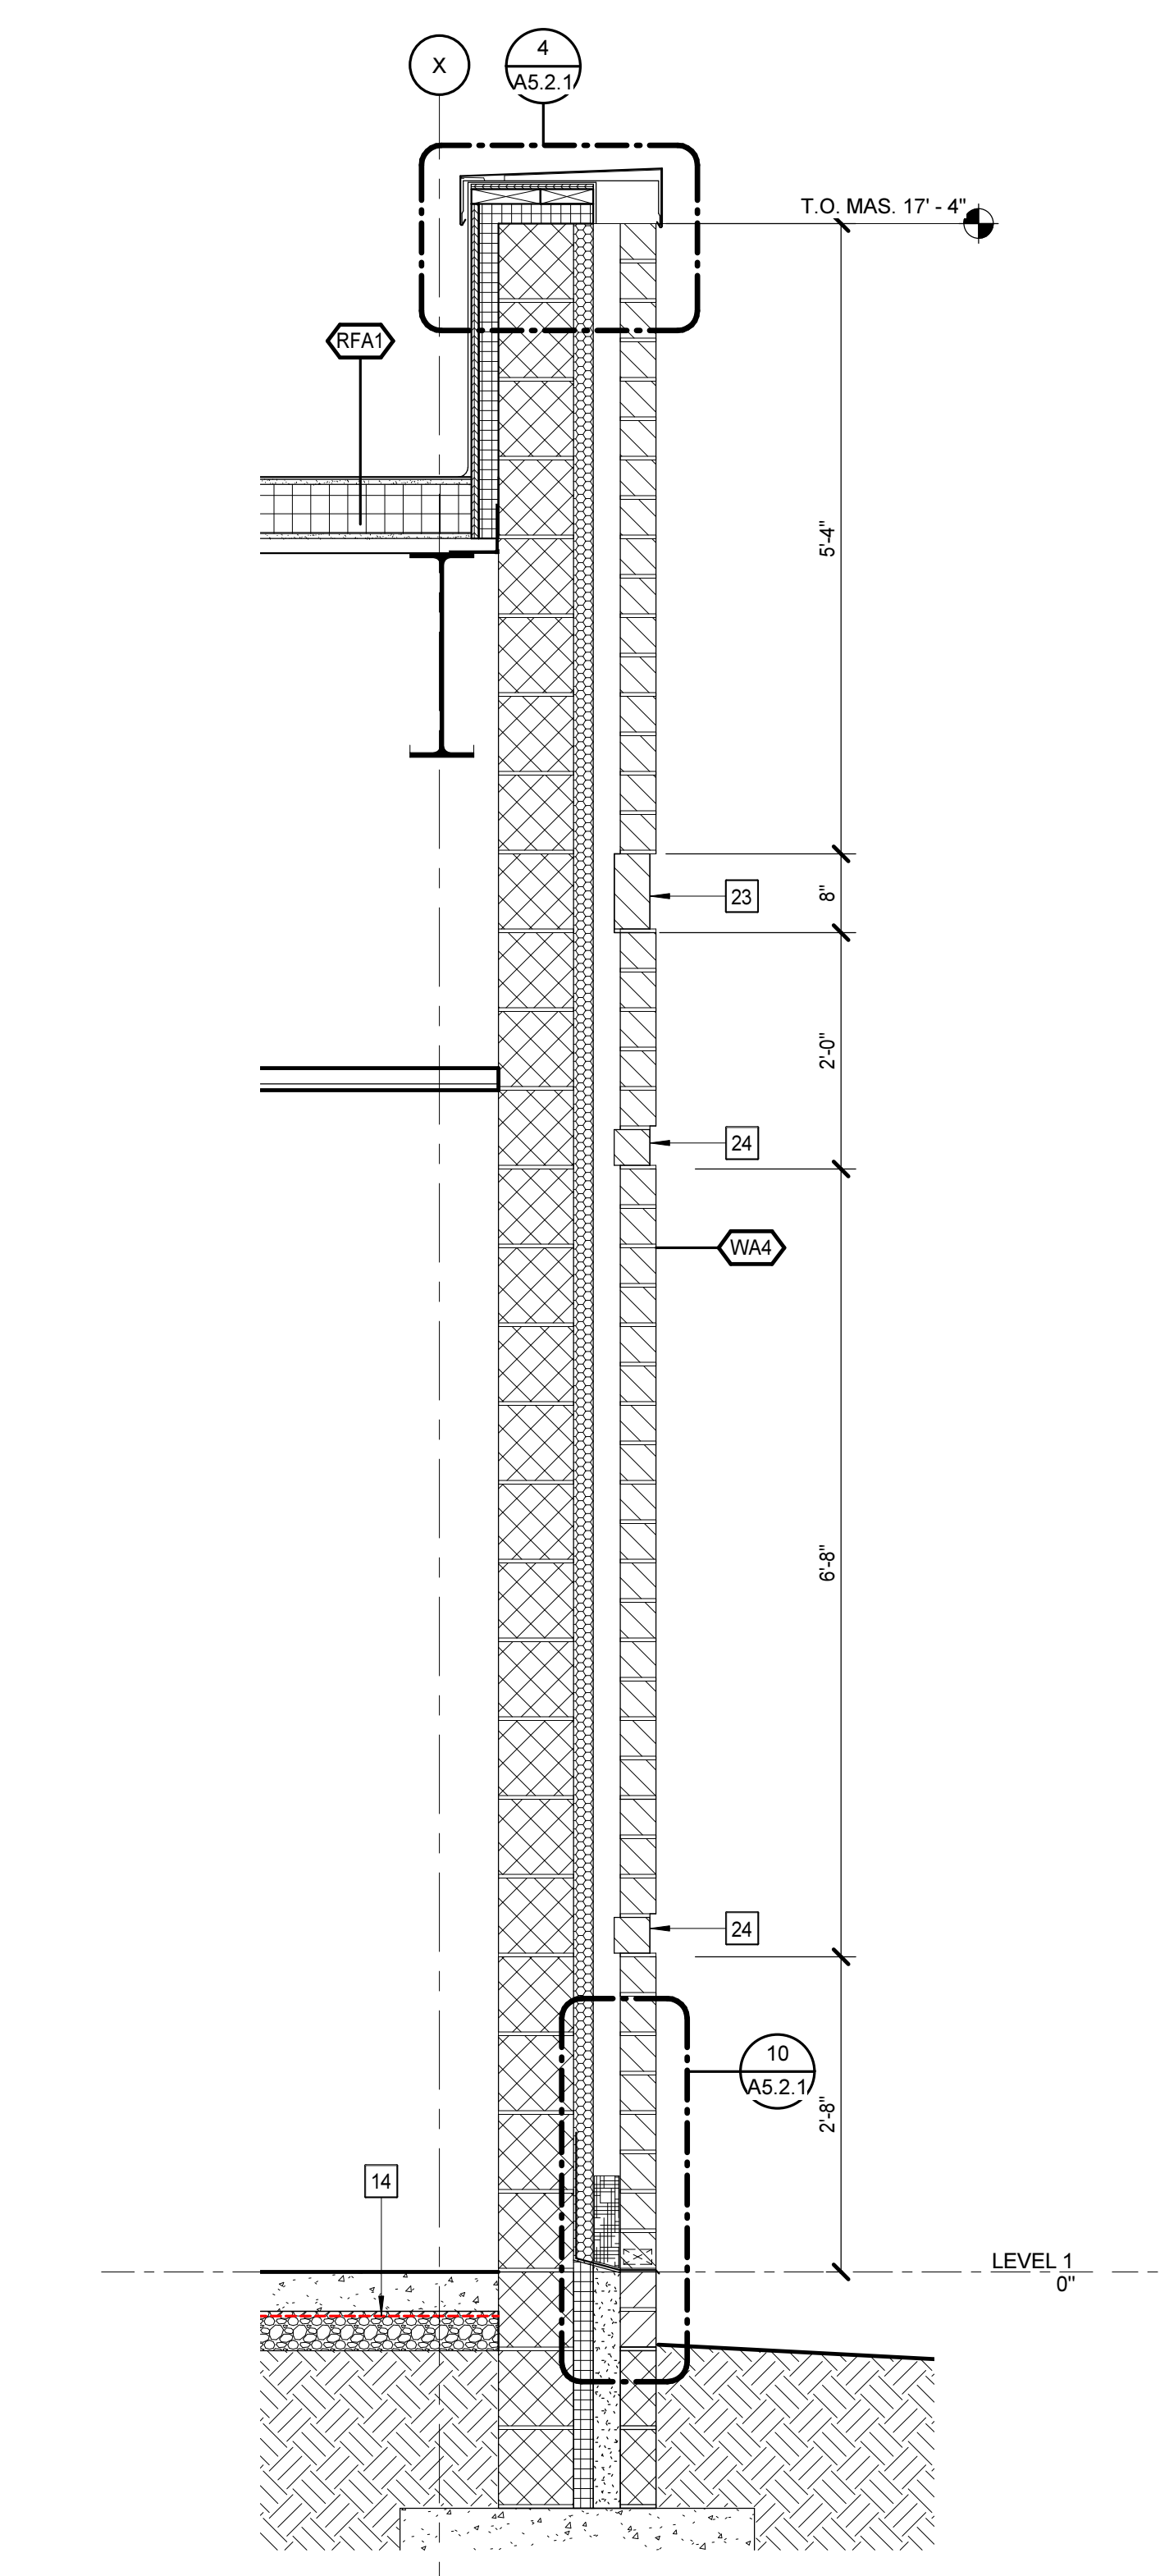

4 WALL SECTION
 A2.1.4 | A5.1.5 | 3/4" = 1'-0"

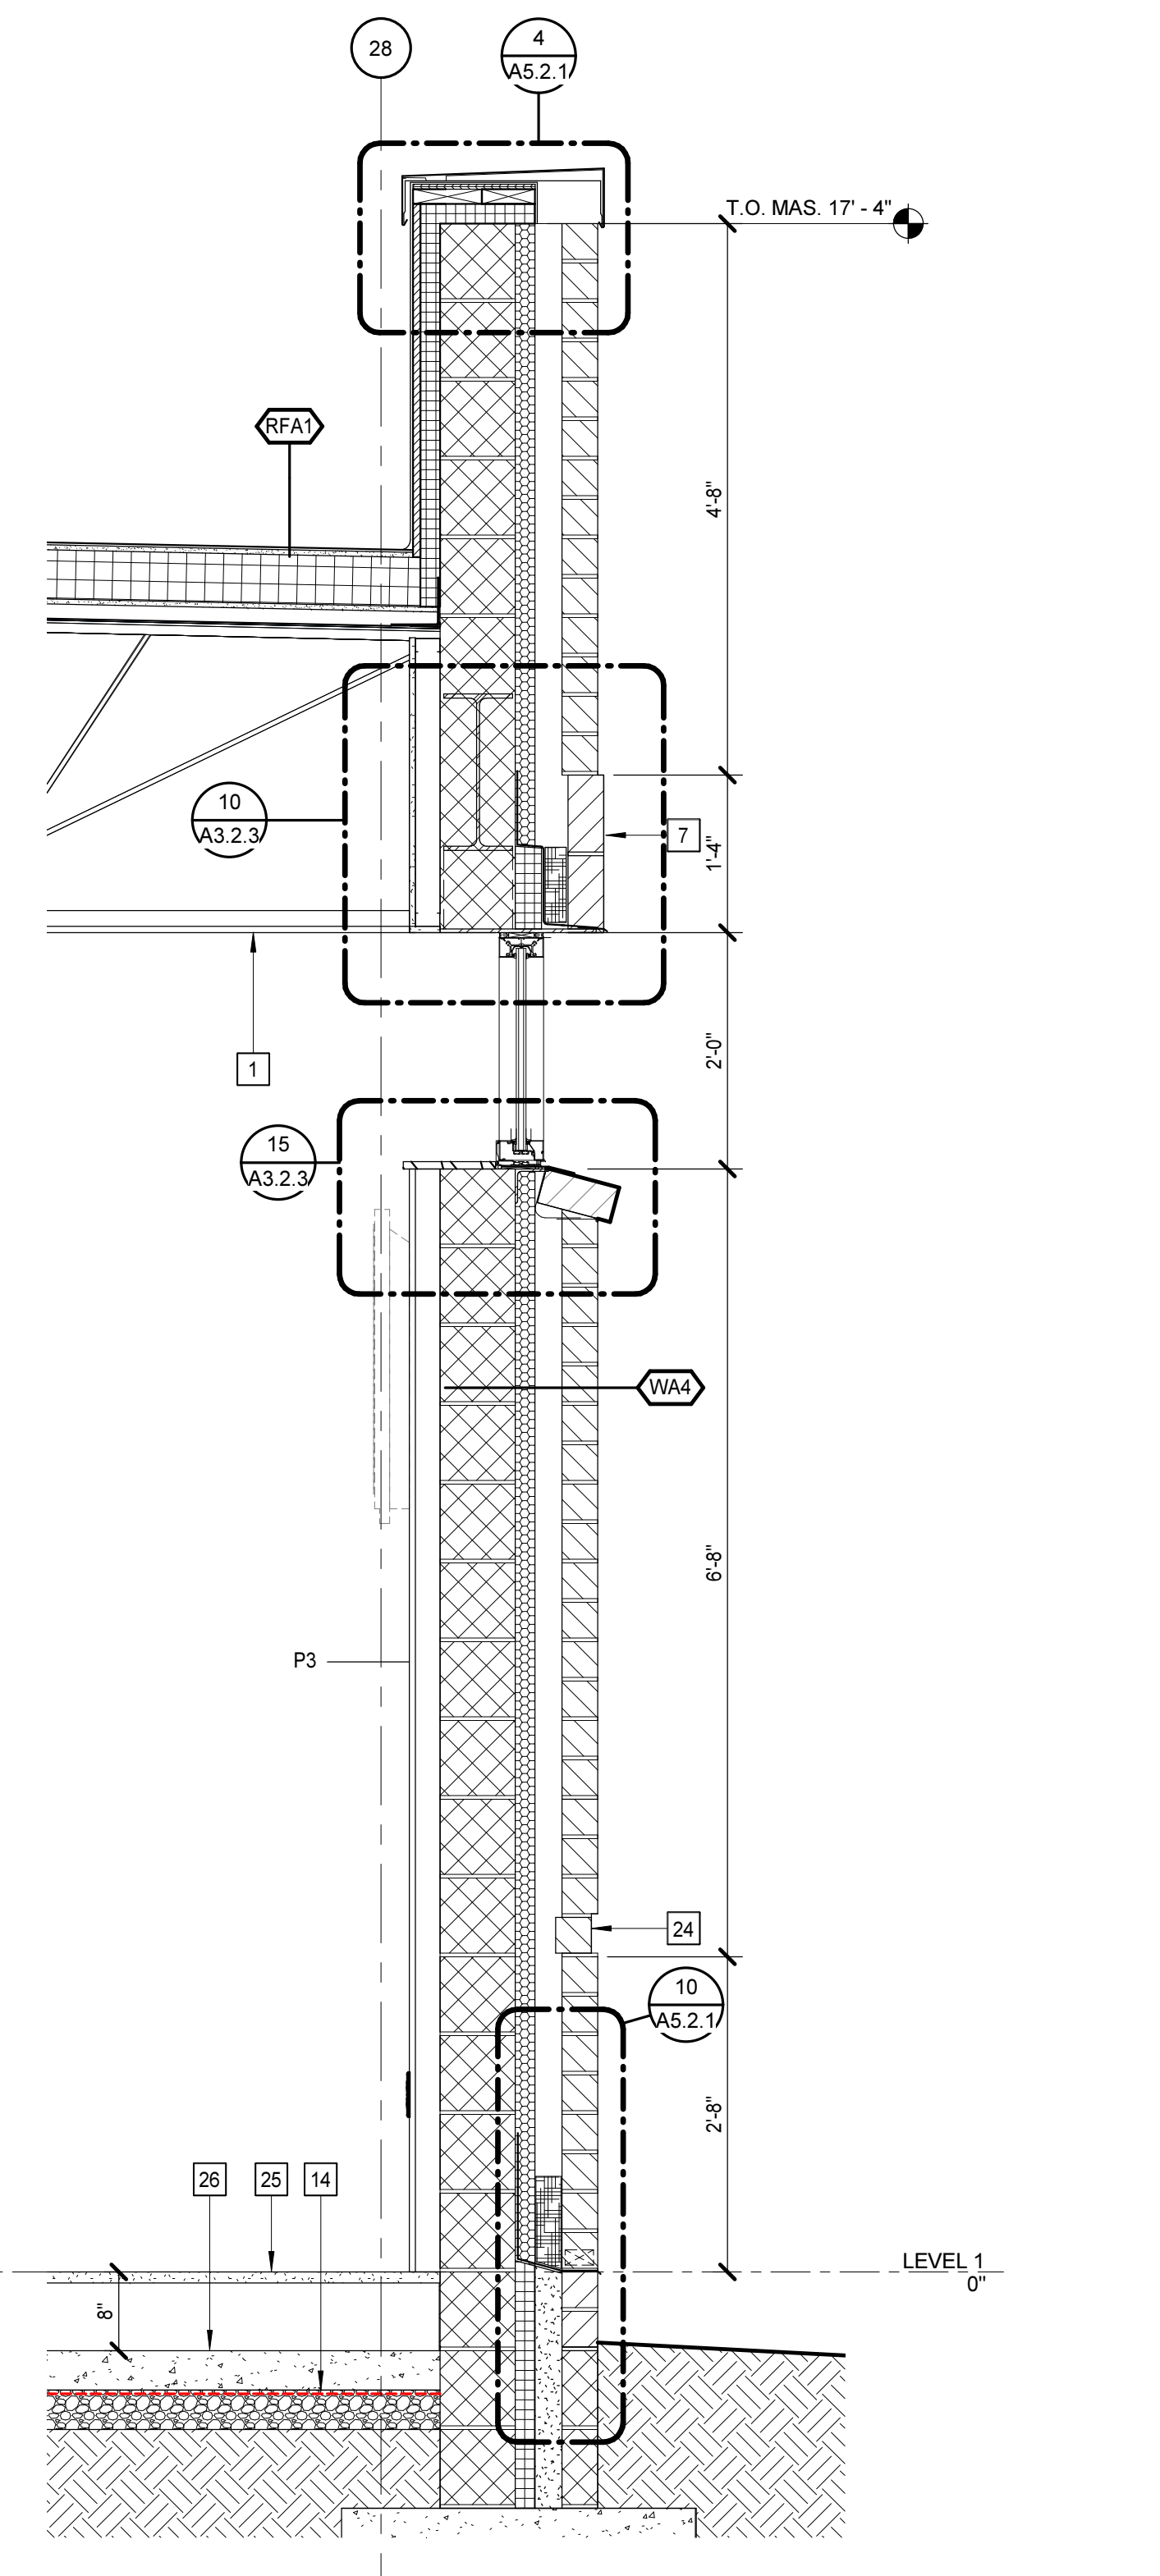


5 WALL SECTION
 A2.1.4 | A5.1.5 | 3/4" = 1'-0"

PENDER COUNTY LEC
 DHSR# J-368 / FID# 220537
 PENDER COUNTY, NORTH CAROLINA
 1417 OLD SAVANNAH ROAD BURGAW, NC

PROJECT NO:	611888
DATE:	06/11/2024
REVISIONS:	
DATE:	06/12/24
DESCRIPTION:	AD-03

WALL SECTIONS


A5.1.5

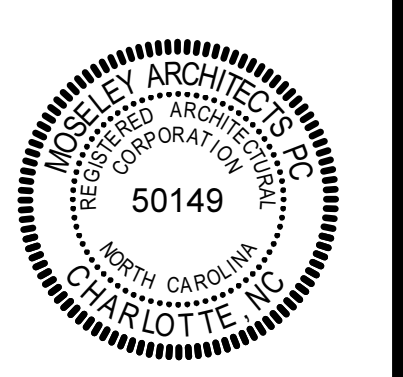


WALL SECTION KEYNOTES

APPLIES TO DRAWINGS A5.1.1 - A5.1.n
 REPRESENTED BY [n]


1 CEILING PER A9 SERIES	17 STEEL GRATING ELEVATED SERVICE WALKWAY
2 ACOUSTICAL WALL PANEL	18 WALL MOUNTED LADDER
3 OVERHEAD COILING DOOR	19 CHASE LIGHT FIXTURE - SEE E-SERIES
4 5/8" PROJECTED SOLDIER COURSE	20 EXTERIOR LIGHT FIXTURE - SEE E-SERIES
5 ALUMINUM CURTAINWALL SYSTEM	21 ARCHITECTURALLY EXPOSED STRUCTURAL STEEL FRAMING
6 PREMANUFACTURED PROTECTIVE COVER	22 ALUMINUM COMPOSITE METAL PANEL
7 5/8" PROJECTED SOLDIER COURSE - 2 COURSE	23 5/8" RECESSED SOLDIER COURSE
8 STRUCTURAL STEEL PER S-SERIES	24 5/8" RECESSED BRICK COURSE
9 SECURITY BARRIER MESH, 1/4" X 6" BATTEN PLATE AND THRU-BOLTS @ 12" O.C.	25 RAISED ACCESS FLOORING SYSTEM
10 CONCRETE FRAME - REFER TO S-SERIES	26 DEPRESSED SLAB - SEE S-SERIES
11 DETENTION HOLLOW METAL FRAME - REFER TO DETENTION FRAME SCHEDULE	27 DIMENSIONAL CHARACTERS - REFER TO DIVISION 10 SECTION "SIGNAGE"
12 SECURITY SEALANT	28 CONCEALED FASTENER METAL WALL PANEL
13 REC. YARD SLAB RECESSED 1/4"	29 REFER TO SHEET AD.1 FOR RATED TOP OF WALL TERMINATION NOTES
14 VAPOR BARRIER	30 NOT USED
15 STEEL CELL PER DIVISION 13	31 CONC. SPLASH BLOCK
16 3'-6" HIGH, 1-1/4" DIA. STEEL PIPE GUARDRAIL & GATE	32 FIRE RATED, PICK RESISTANT, COMPRESSIBLE WALL SEAL

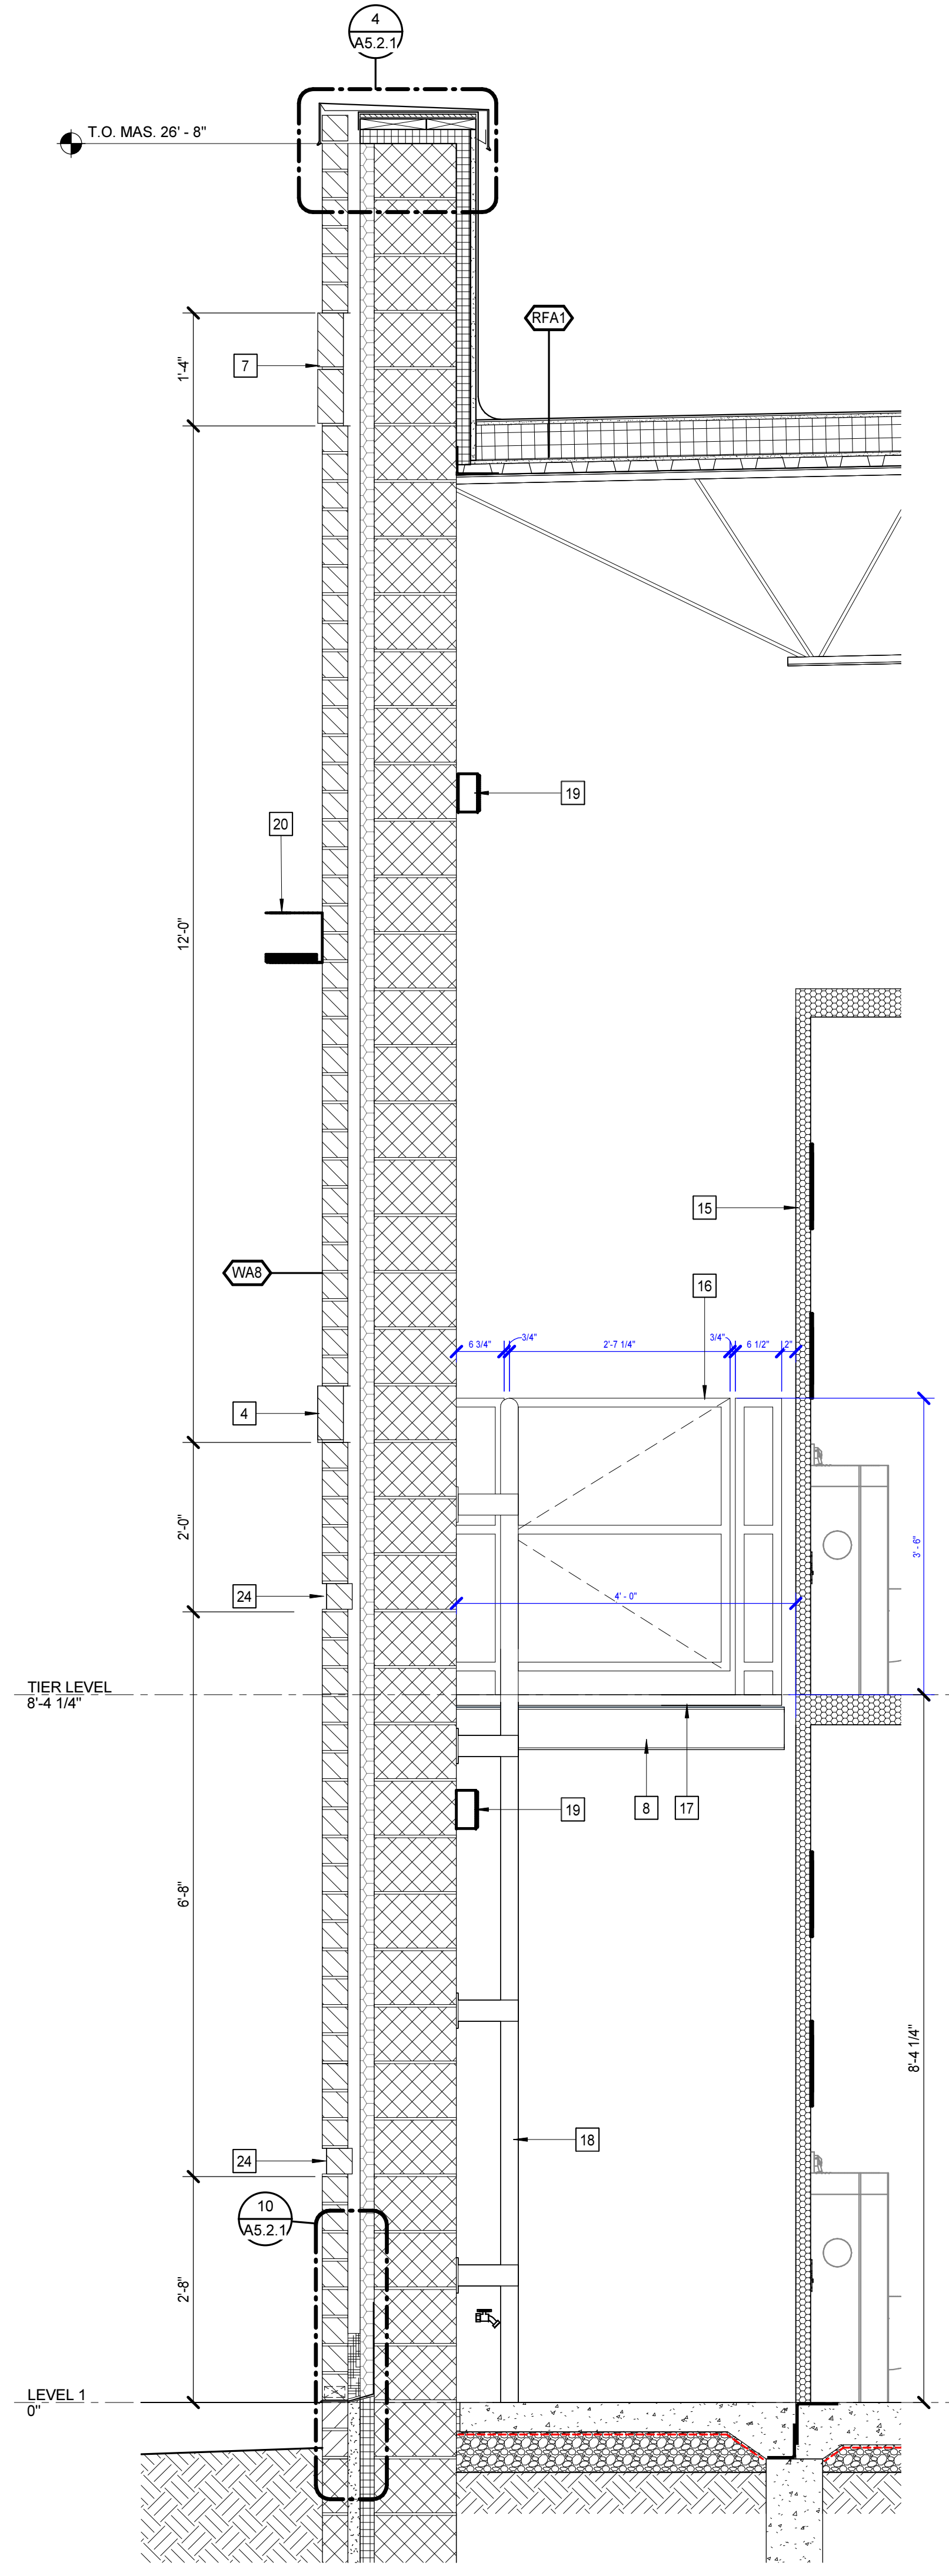


1 WALL SECTION
 A2.1.2 A5.1.7 3/4" = 1'-0"

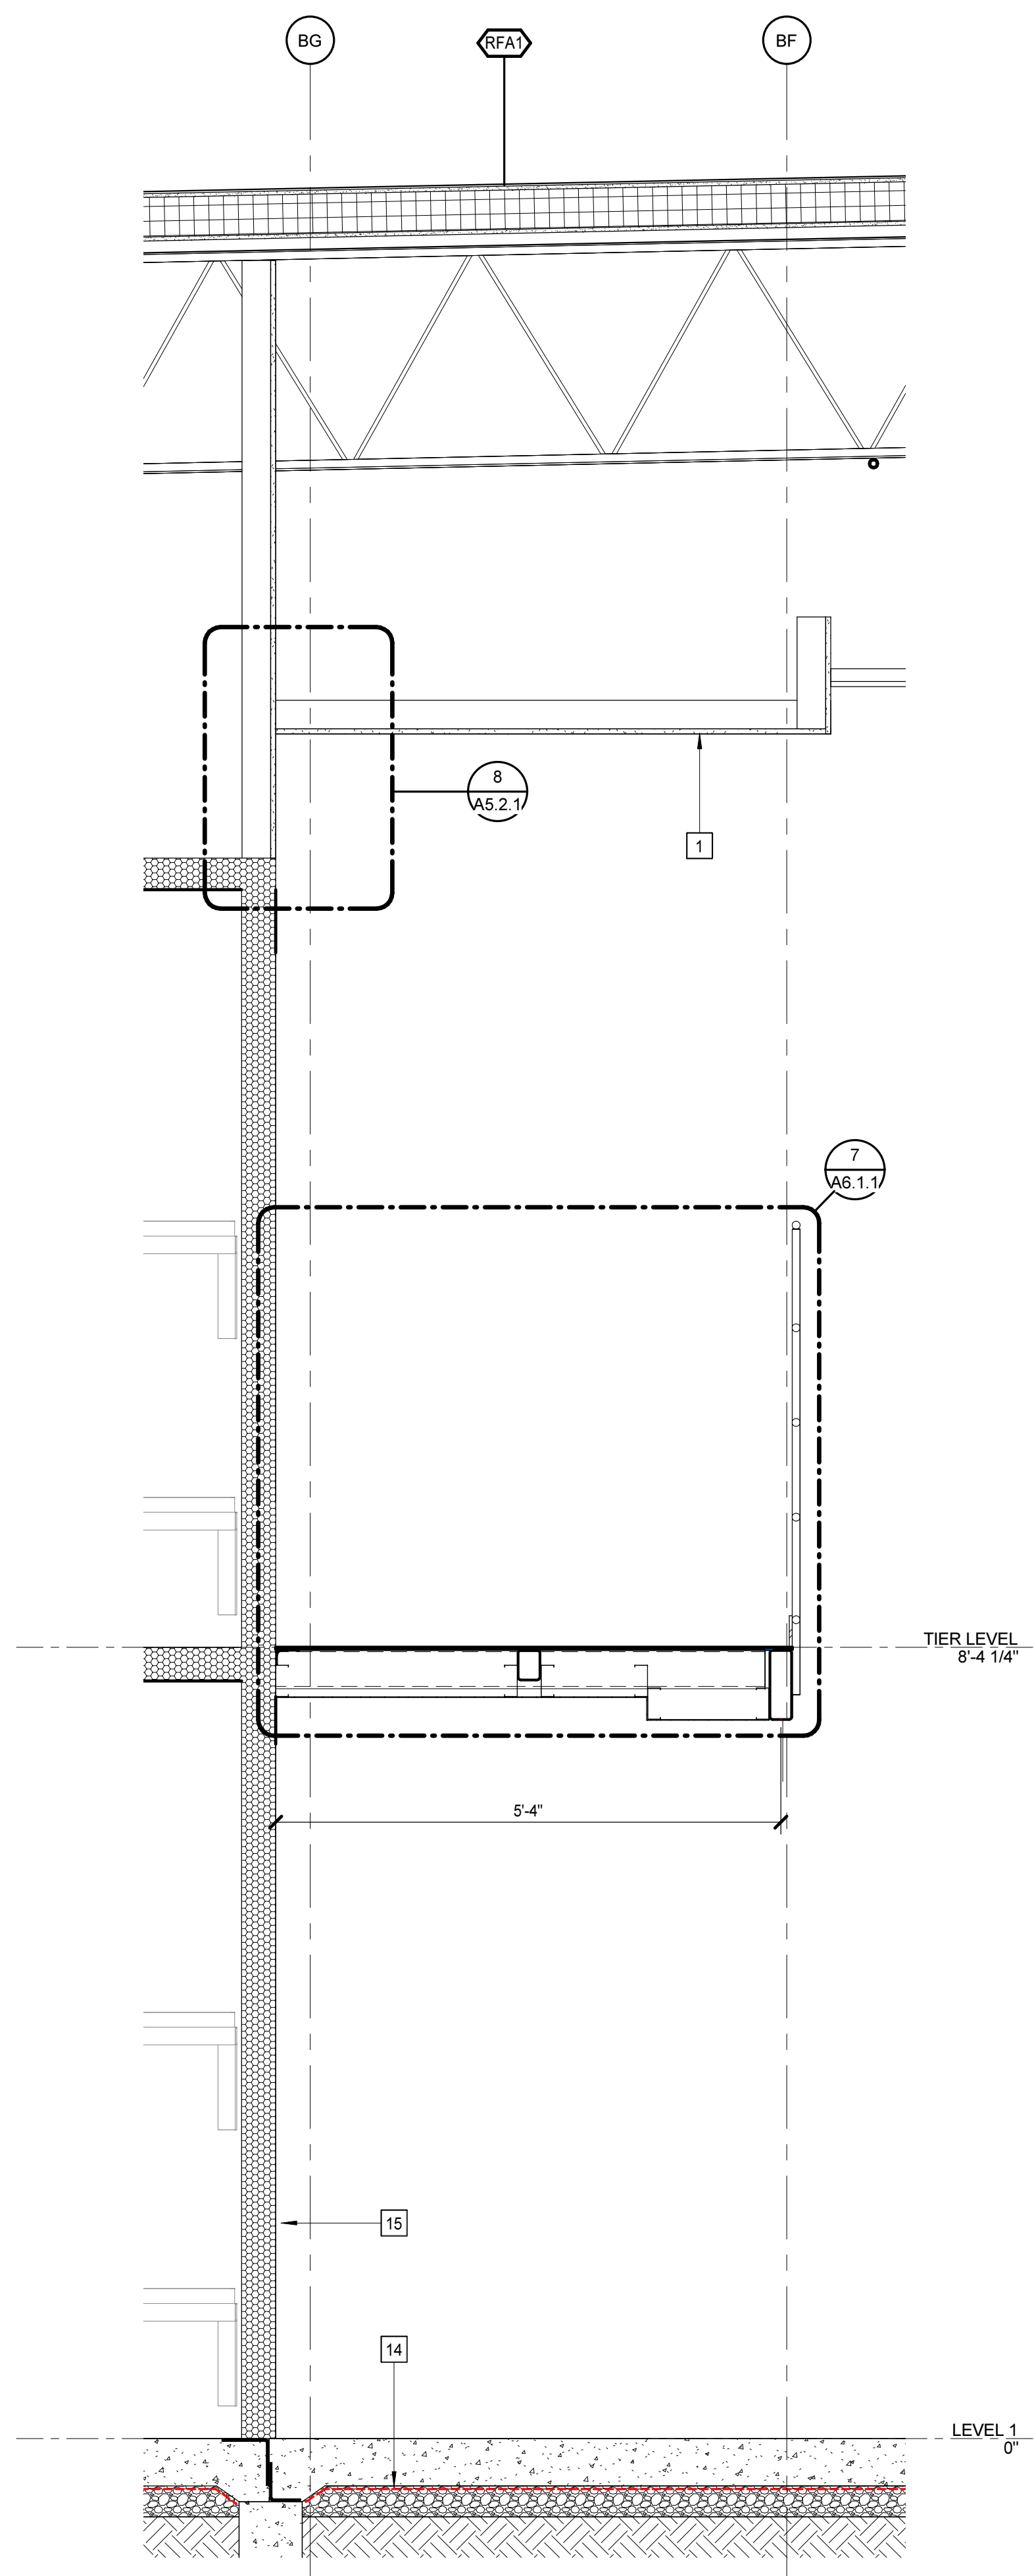

2 WALL SECTION
 A2.1.2 A5.1.7 3/4" = 1'-0"

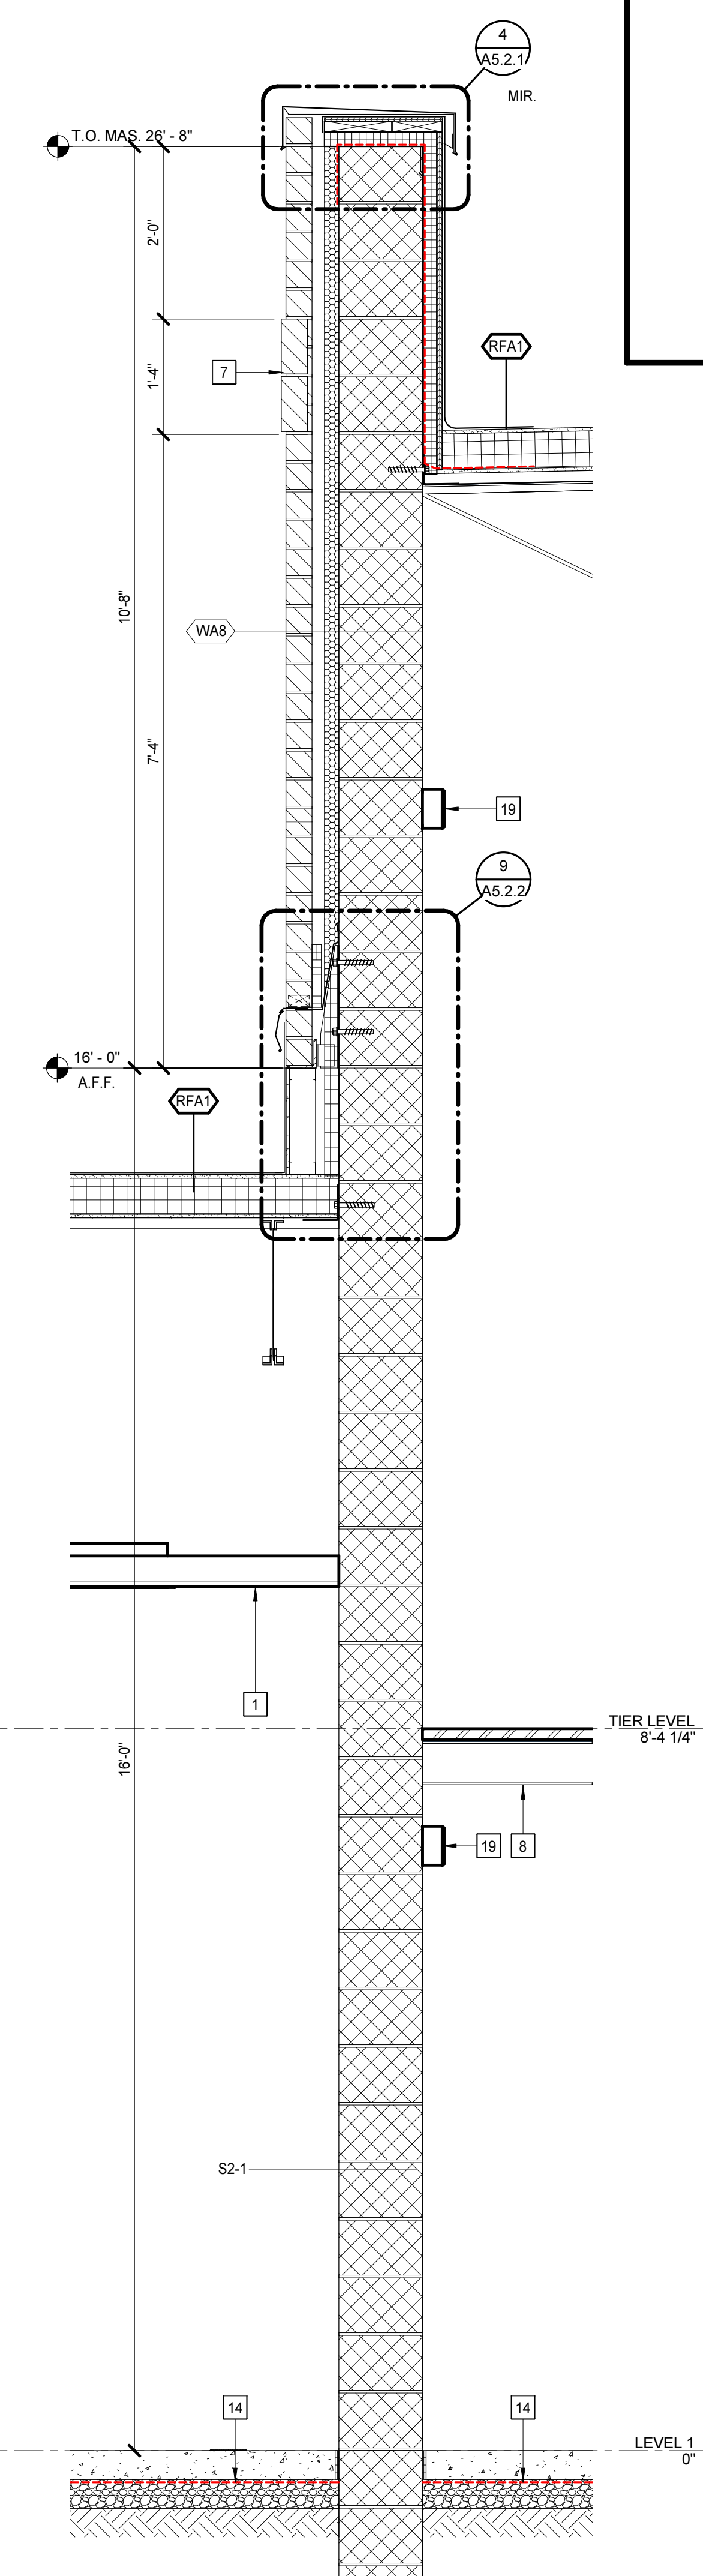

3 WALL SECTION
 A2.1.1 A5.1.7 3/4" = 1'-0"

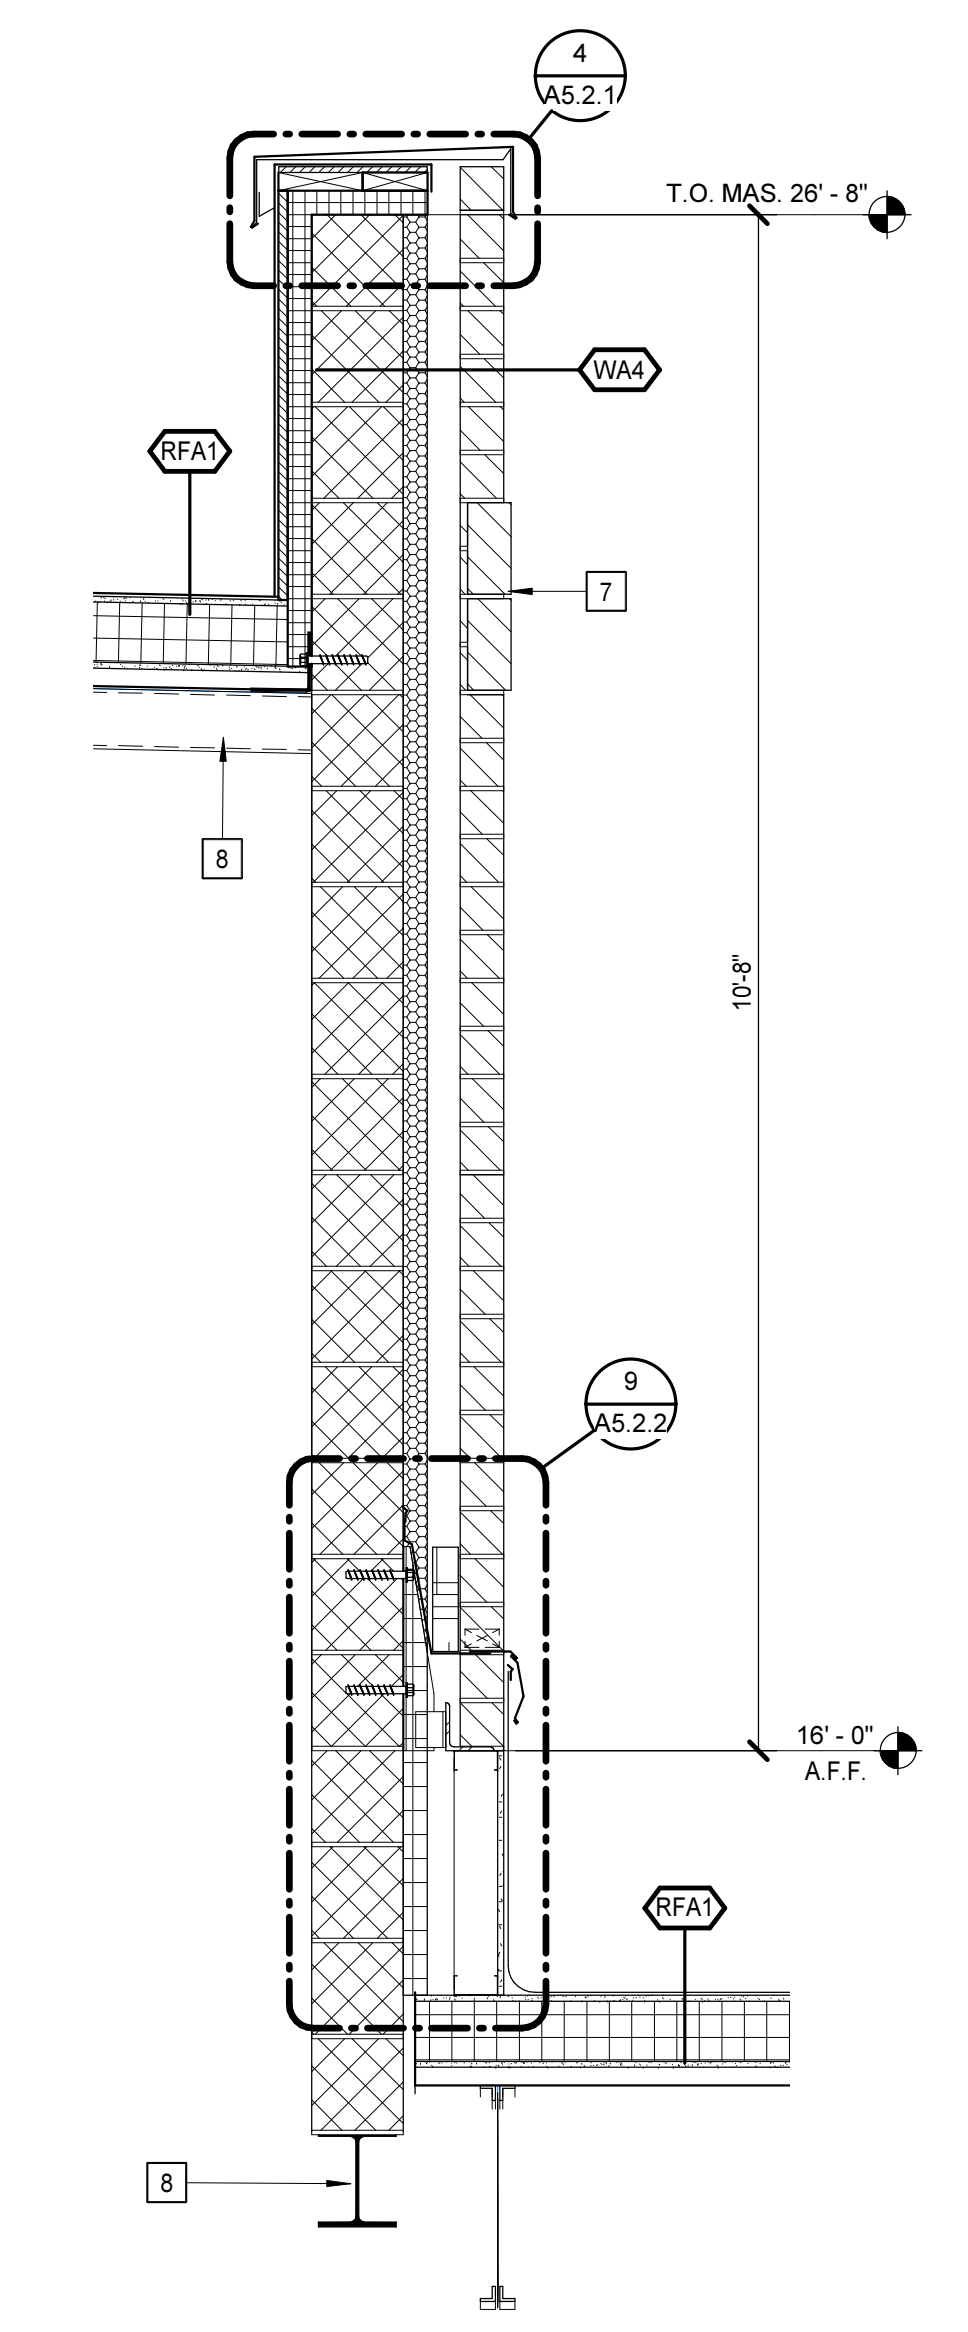


4 WALL SECTION
 A2.1.3 A5.1.7 3/4" = 1'-0"


PROJECT NO:	611688
DATE:	05/01/2024
REVISIONS	
DATE	DESCRIPTION
06/12/24	AD-03

6/7/2024 2:23:33 PM

1 WALL SECTION
A2.1.4 | A5.1.8 3/4" = 1'-0"

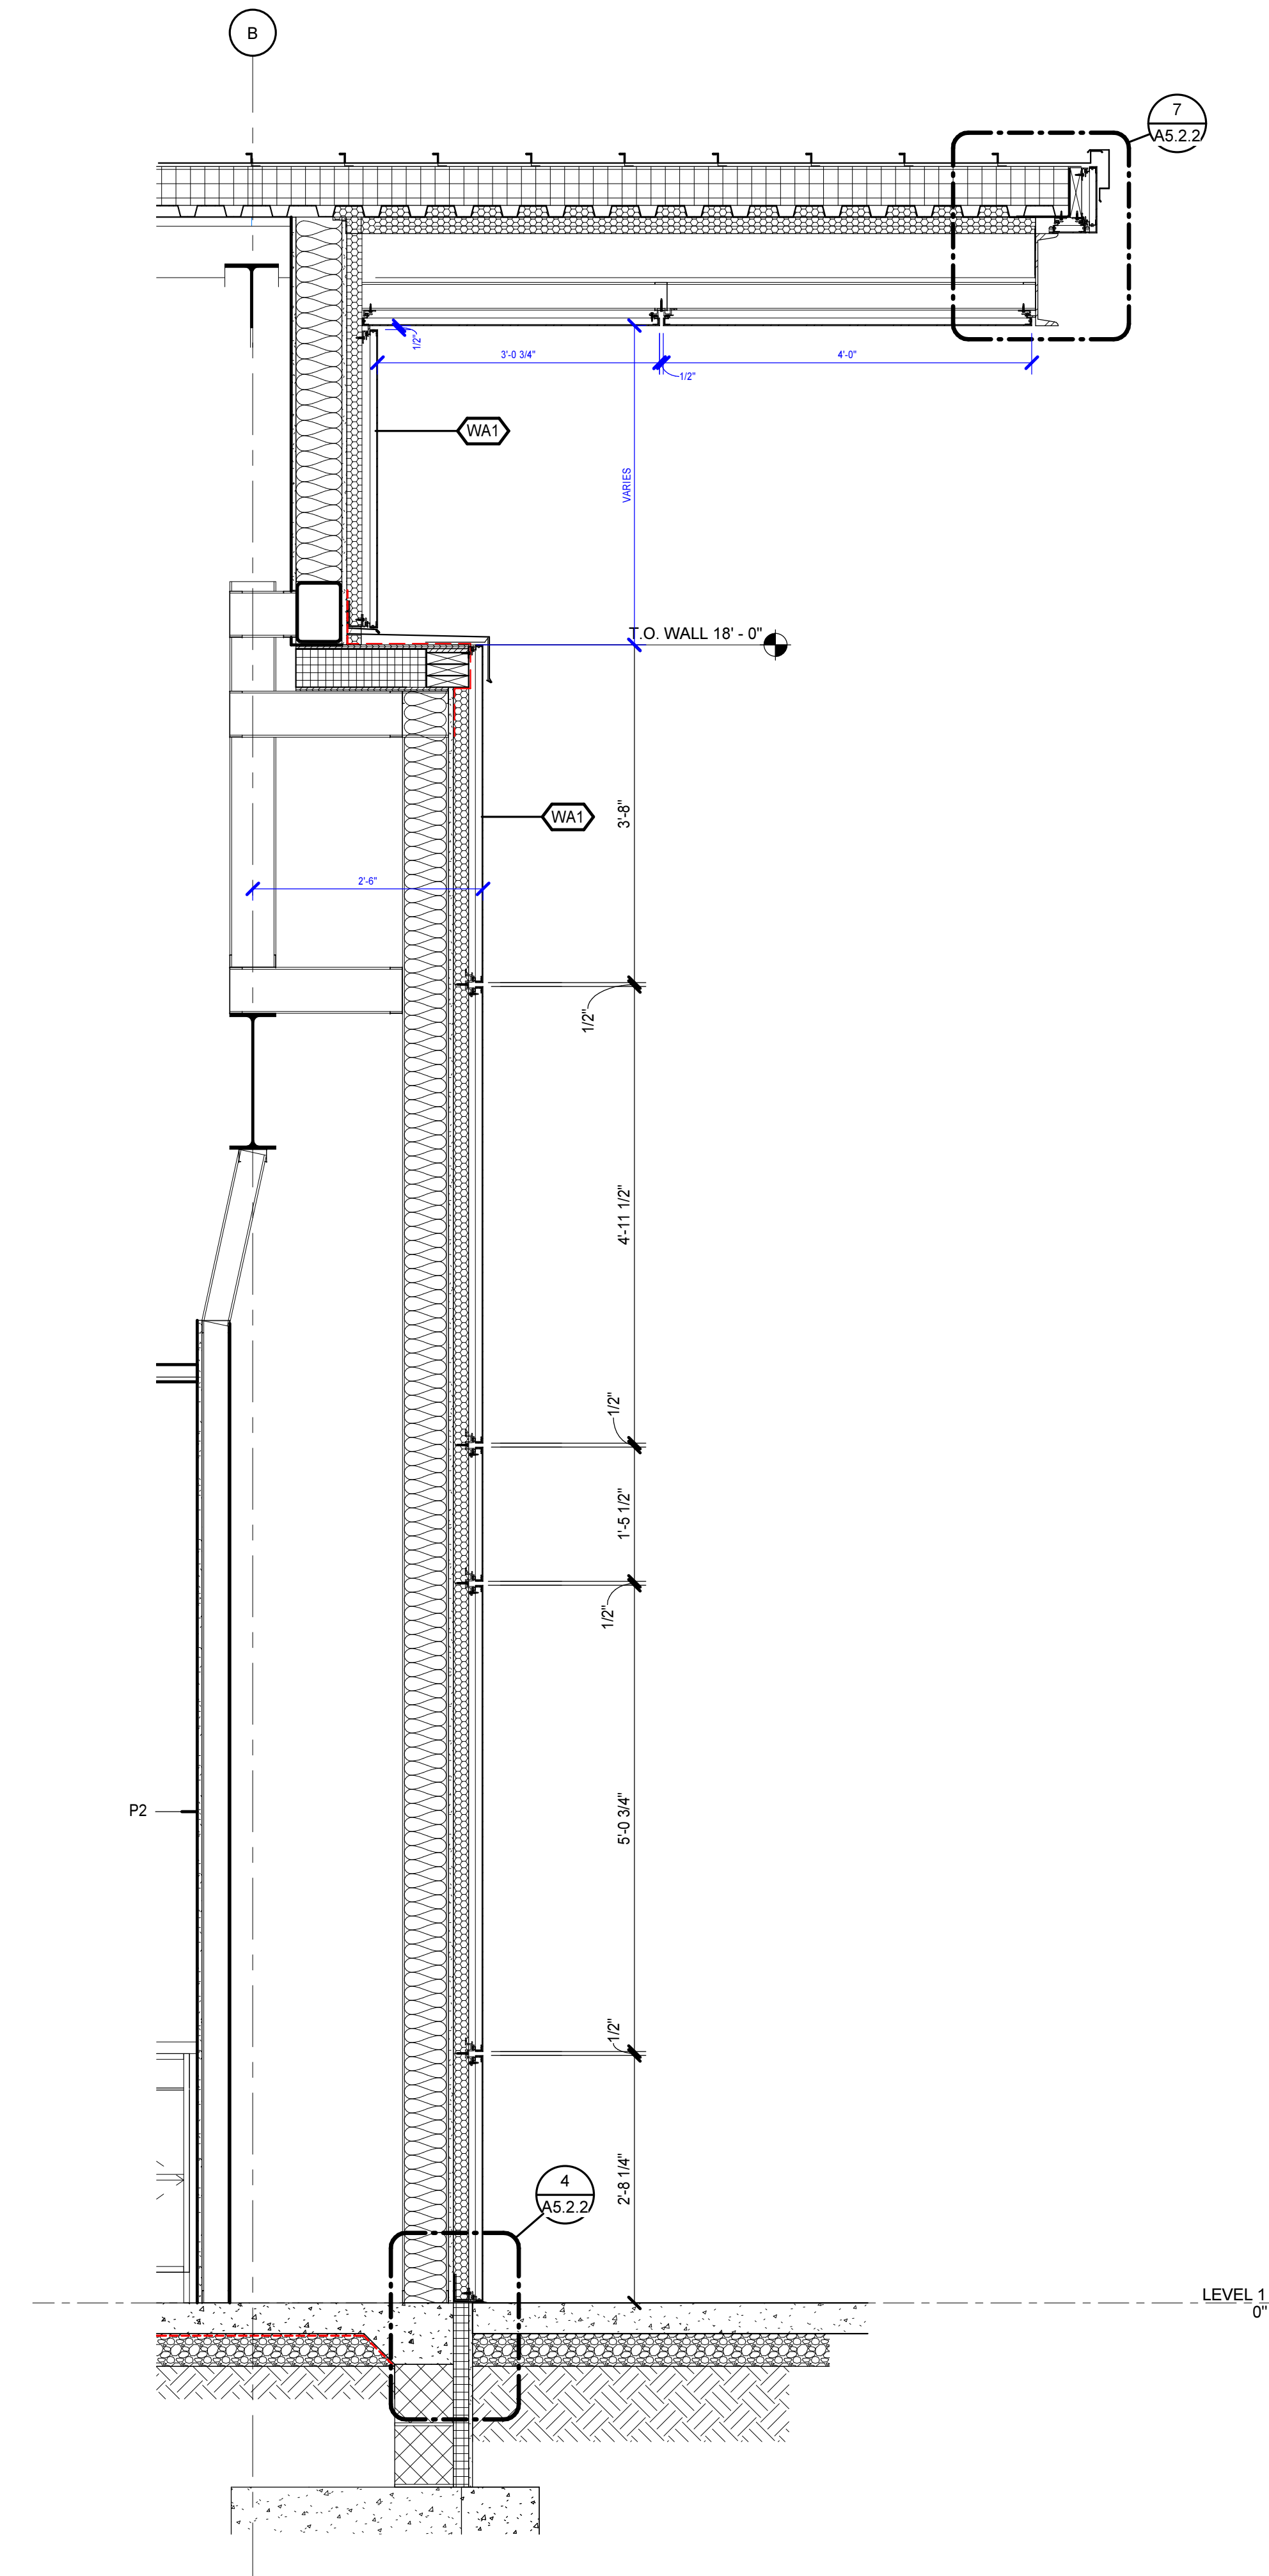

2 WALL SECTION
A2.1.4 | A5.1.8 3/4" = 1'-0"

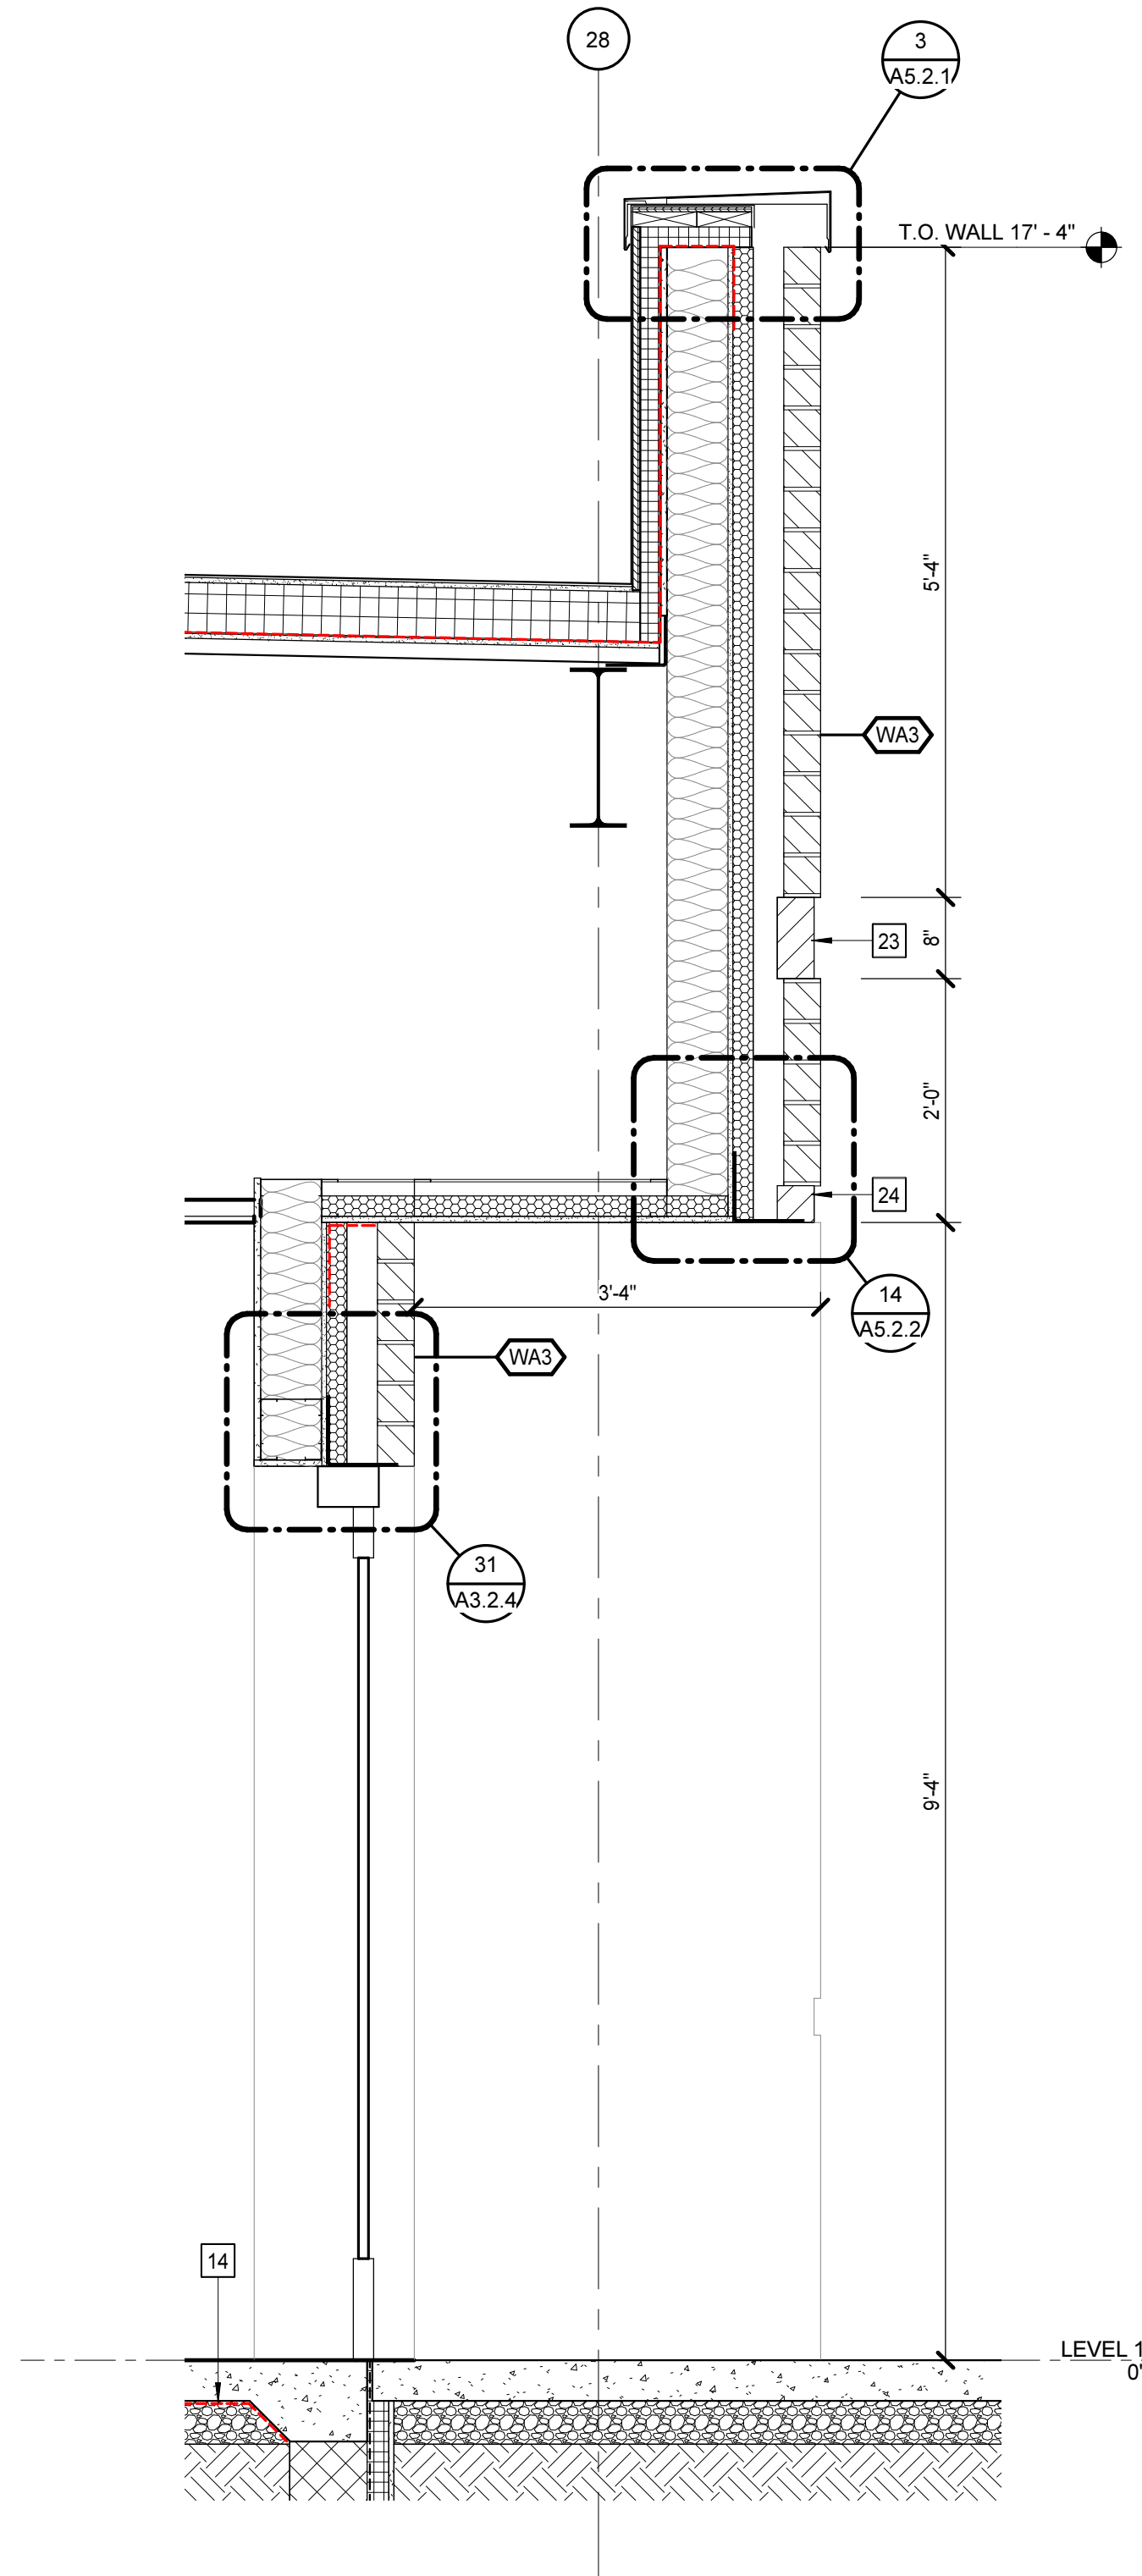



WALL SECTION KEYNOTES

APPLIES TO DRAWINGS A5.1.1 - A5.1.8
REPRESENTED BY []

- | | |
|---|--|
| 1 CEILING PER A9 SERIES | 17 STEEL GRATING ELEVATED SERVICE WALKWAY |
| 2 ACOUSTICAL WALL PANEL | 18 WALL MOUNTED LADDER |
| 3 OVERHEAD COLING DOOR | 19 CHASE LIGHT FIXTURE, SEE E-SERIES |
| 4 5/8" PROJECTED SOLDIER COURSE | 20 EXTERIOR LIGHT FIXTURE - SEE E-SERIES |
| 5 ALUMINUM CURTAINWALL SYSTEM | 21 ARCHITECTURALLY EXPOSED STRUCTURAL STEEL FRAMING |
| 6 PREMANUFACTURED PROTECTIVE COVER | 22 ALUMINUM COMPOSITE METAL PANEL |
| 7 5/8" PROJECTED SOLDIER COURSE - 2 COURSE | 23 5/8" RECESSED SOLDIER COURSE |
| 8 STRUCTURAL STEEL PER S-SERIES | 24 5/8" RECESSED BRICK COURSE |
| 9 SECURITY BARRIER MESH, 1/4" X 6" BATTEN PLATE AND THRU-BOLTS @ 12" O.C. | 25 RAISED ACCESS FLOORING SYSTEM |
| 10 CONCRETE FRAME - REFER TO S-SERIES | 26 DEPRESSED SLAB - SEE S-SERIES |
| 11 DETENTION HOLLOW METAL FRAME - REFER TO DETENTION FRAME SCHEDULE | 27 DIMENSIONAL CHARACTERS - REFER TO DIVISION 10 SECTION 'SIGNAGE' |
| 12 SECURITY SEALANT | 28 CONCEALED FASTENER METAL WALL PANEL |
| 13 REC. YARD SLAB RECESSED 1/4" | 29 REFER TO SHEET A0.1 FOR RATED TOP OF WALL TERMINATION NOTES |
| 14 VAPOR BARRIER | 30 NOT USED |
| 15 STEEL CELL PER DIVISION 13 | 31 CONC. SPLASH BLOCK |
| 16 3'-6" HIGH, 1-1/4" DIA. STEEL PIPE GUARDRAIL & GATE | 32 FIRE RATED, PICK RESISTANT, COMPRESSIBLE WALL SEAL |

MOSELEYARCHITECTS

6210 ARDREY KELL ROAD - THE HUB AT WAWERLY, SUITE 425 - CHARLOTTE, NC 28277
PHONE (704) 540-3155 FAX (704) 540-3154
MOSELEYARCHITECTS.COM

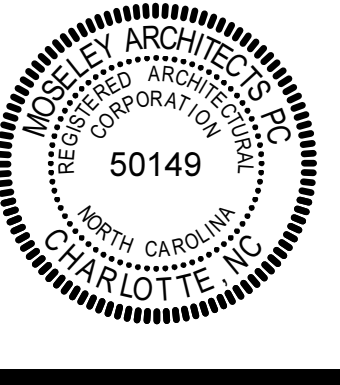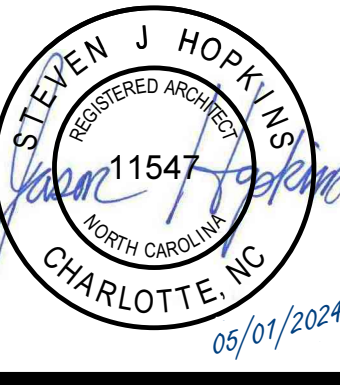


PENDER COUNTY LEC
DHSR# J-368 / FID# 220537
PENDER COUNTY, NORTH CAROLINA
1417 OLD SAVANNAH ROAD BURGAW, NC


PROJECT NO:	611888
DATE:	06/11/2024
REVISIONS	
DATE	DESCRIPTION
06/12/24	AD-03

WALL SECTIONS


A5.1.8

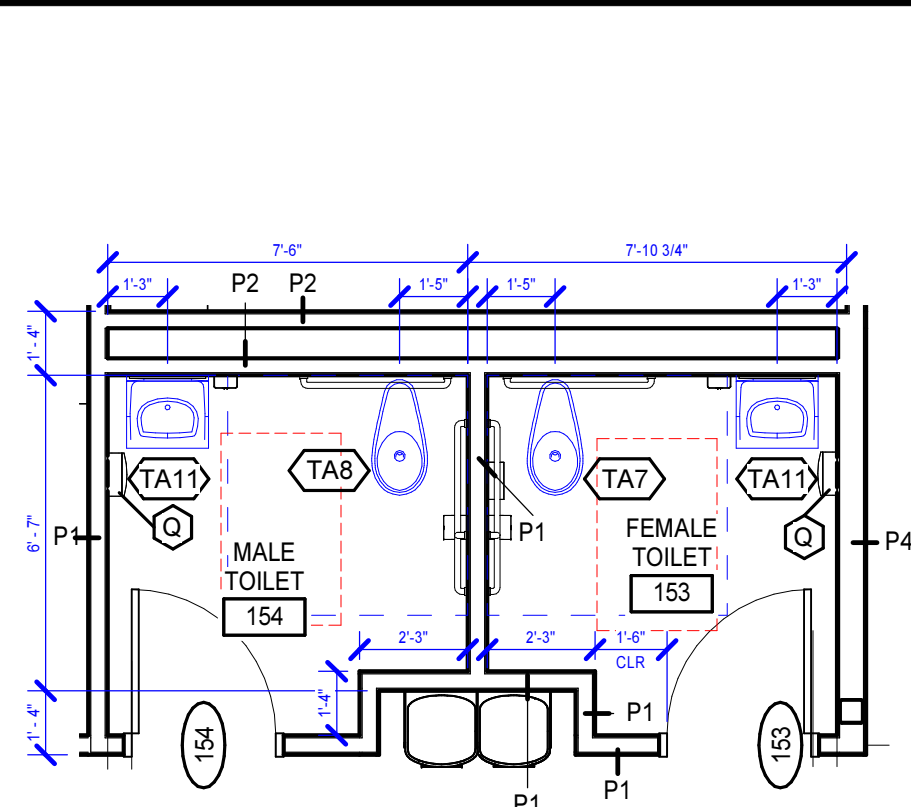


16 ENLARGED PLAN
A2.1.6|A7.1.1 1/4" = 1'-0"

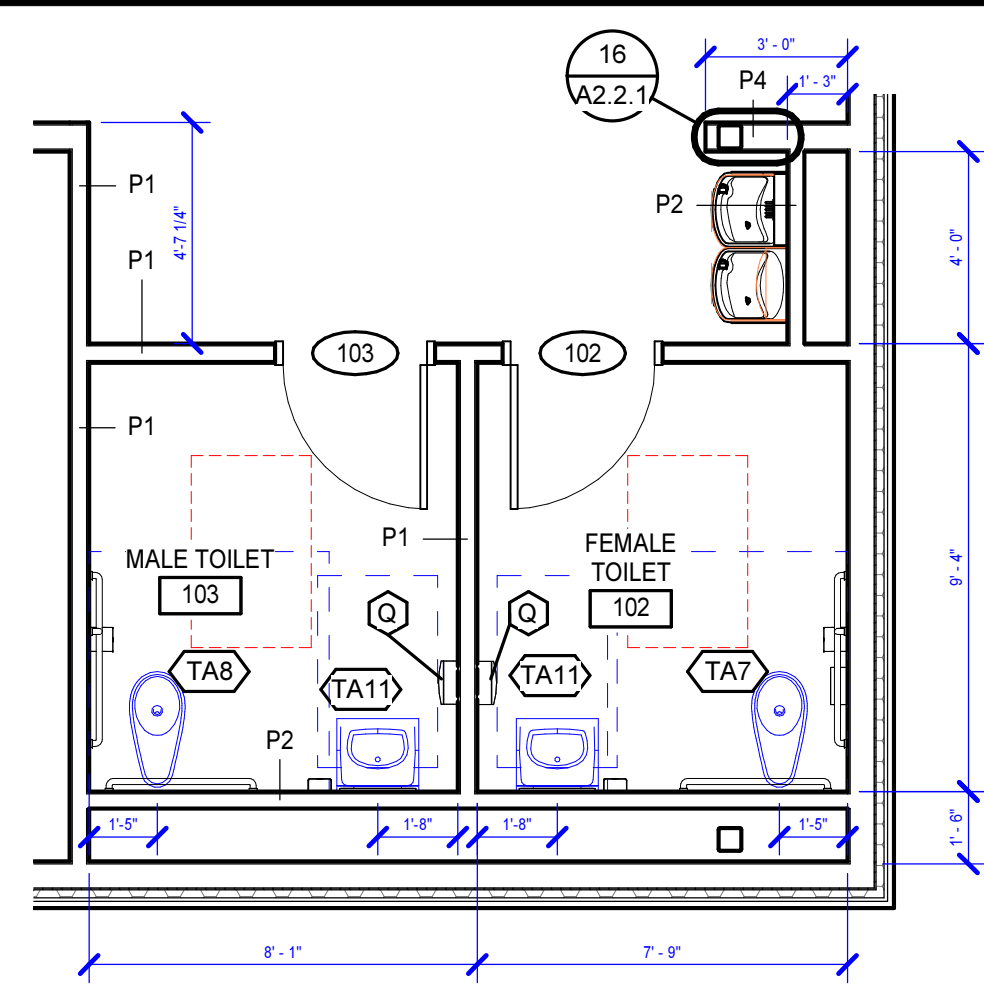


15 ENLARGED PLAN
A2.1.6|A7.1.1 1/4" = 1'-0"

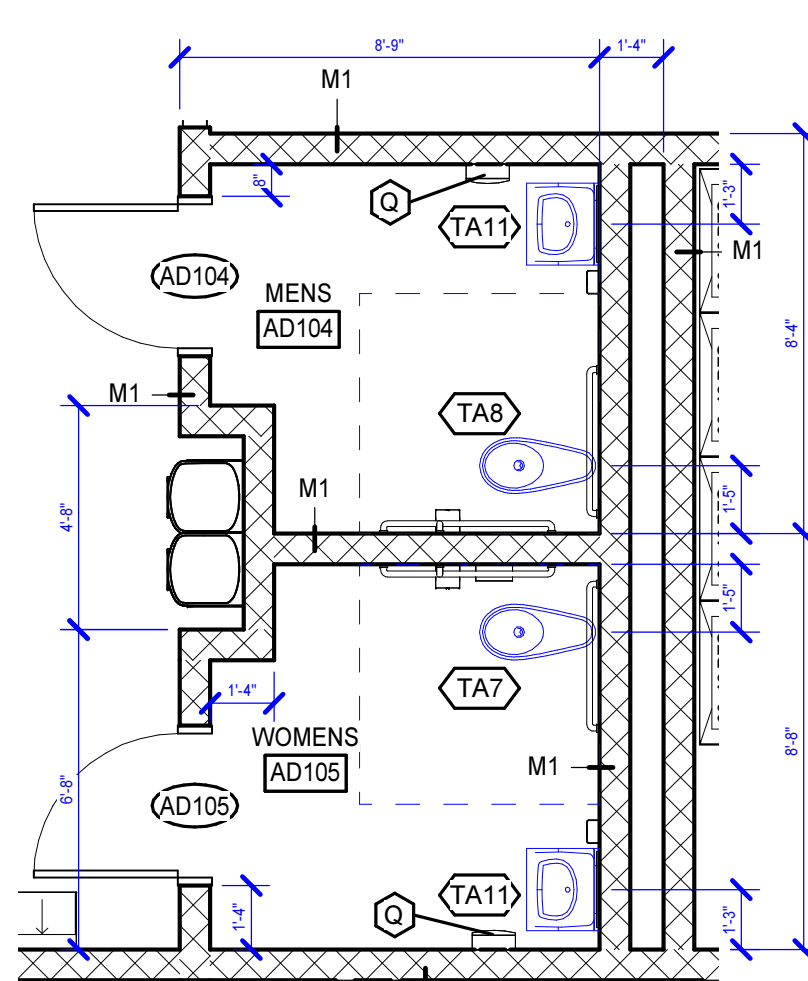


9 ENLARGED PLAN
A2.1.1|A7.1.1 1/4" = 1'-0"

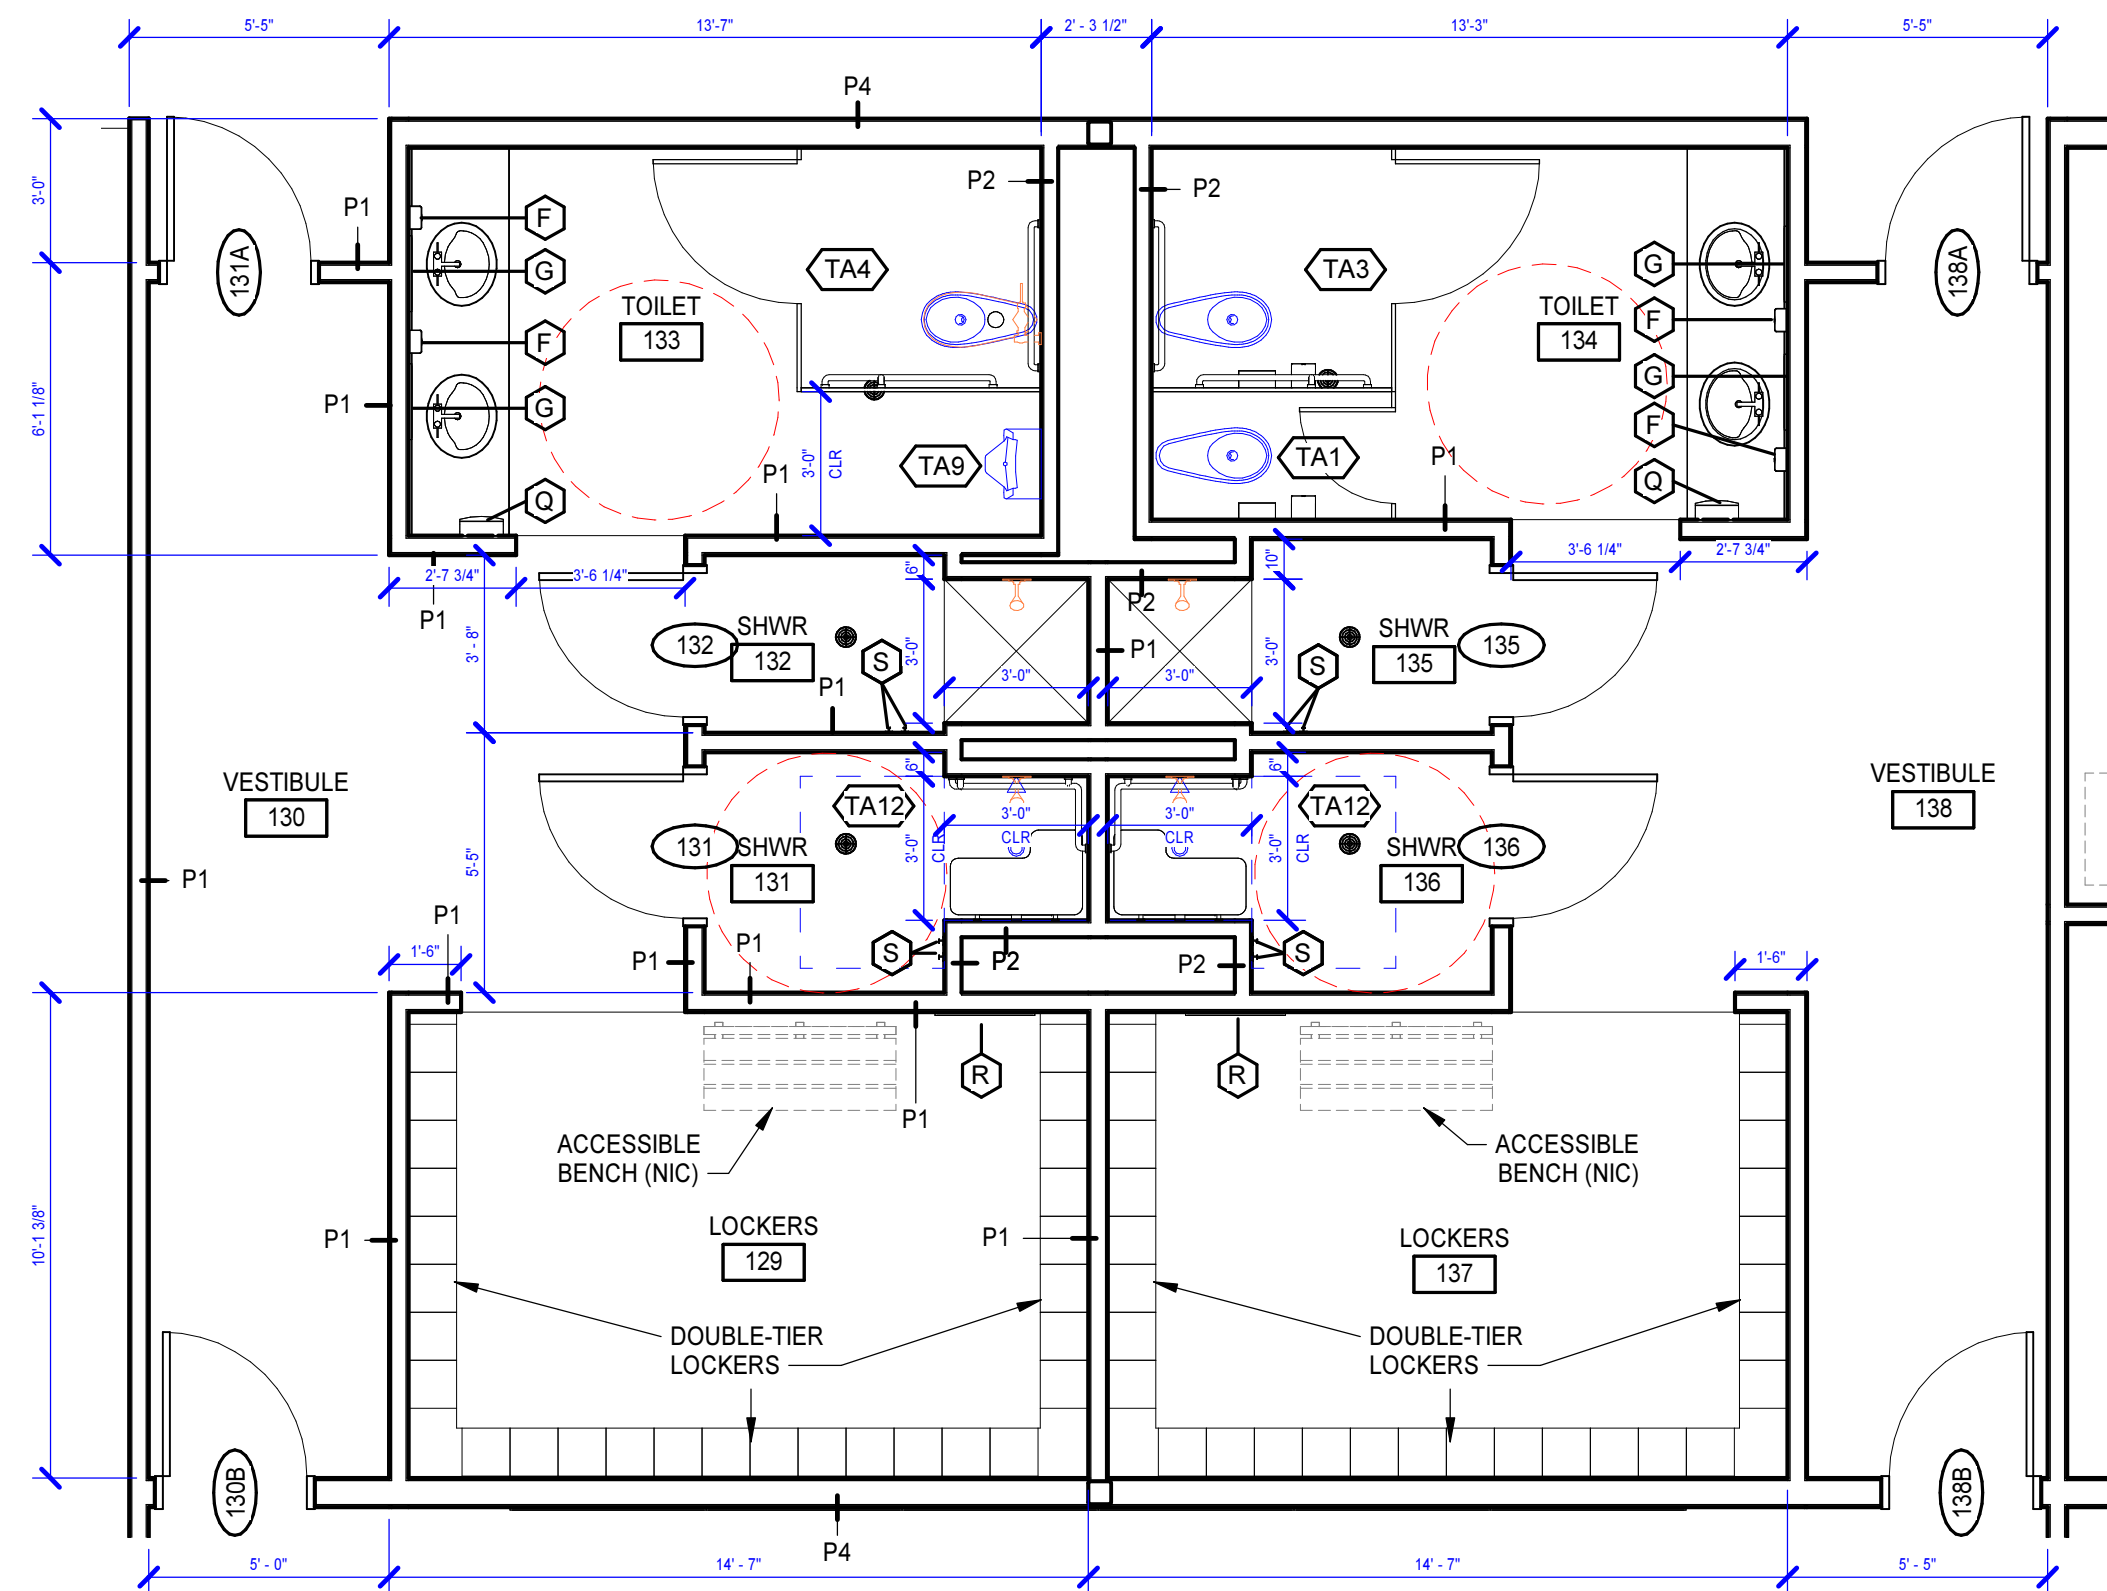


14 ENLARGED LOCKER ROOM PLAN
A2.1.6|A7.1.1 1/4" = 1'-0"

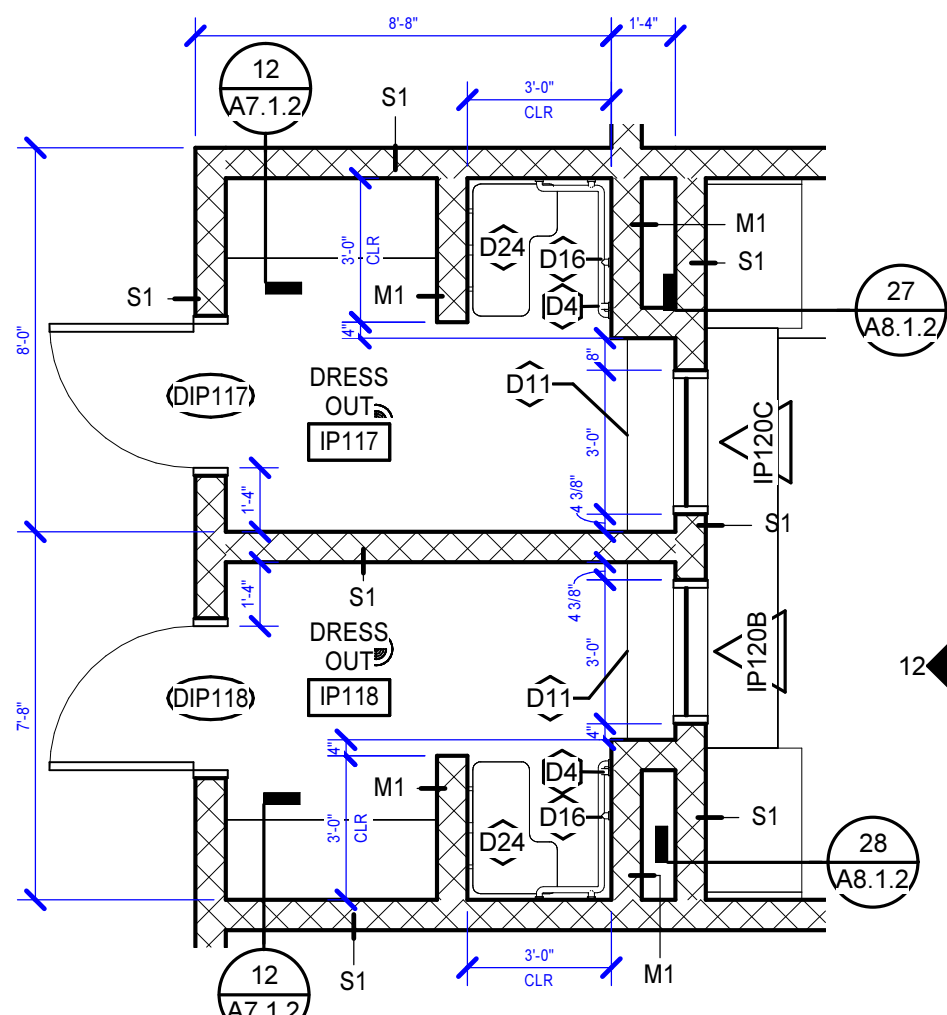


6 ENLARGED PLAN
A2.1.1|A7.1.1 1/4" = 1'-0"

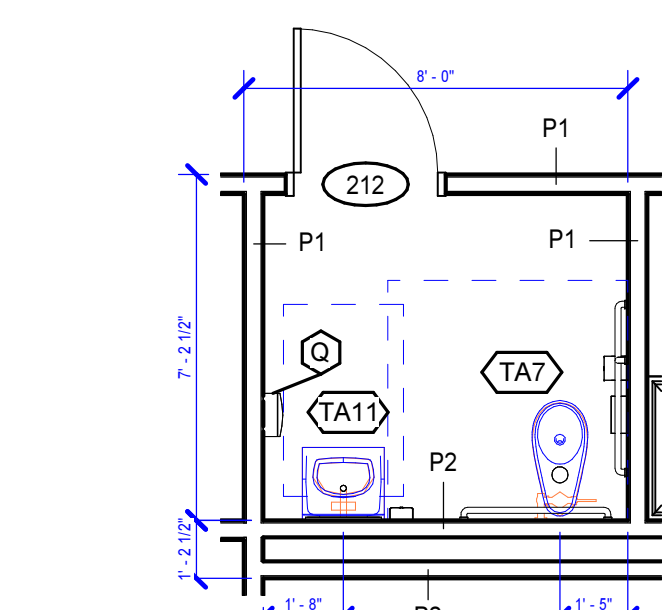


17 ENLARGED PLAN
A2.1.6|A7.1.1 1/4" = 1'-0"

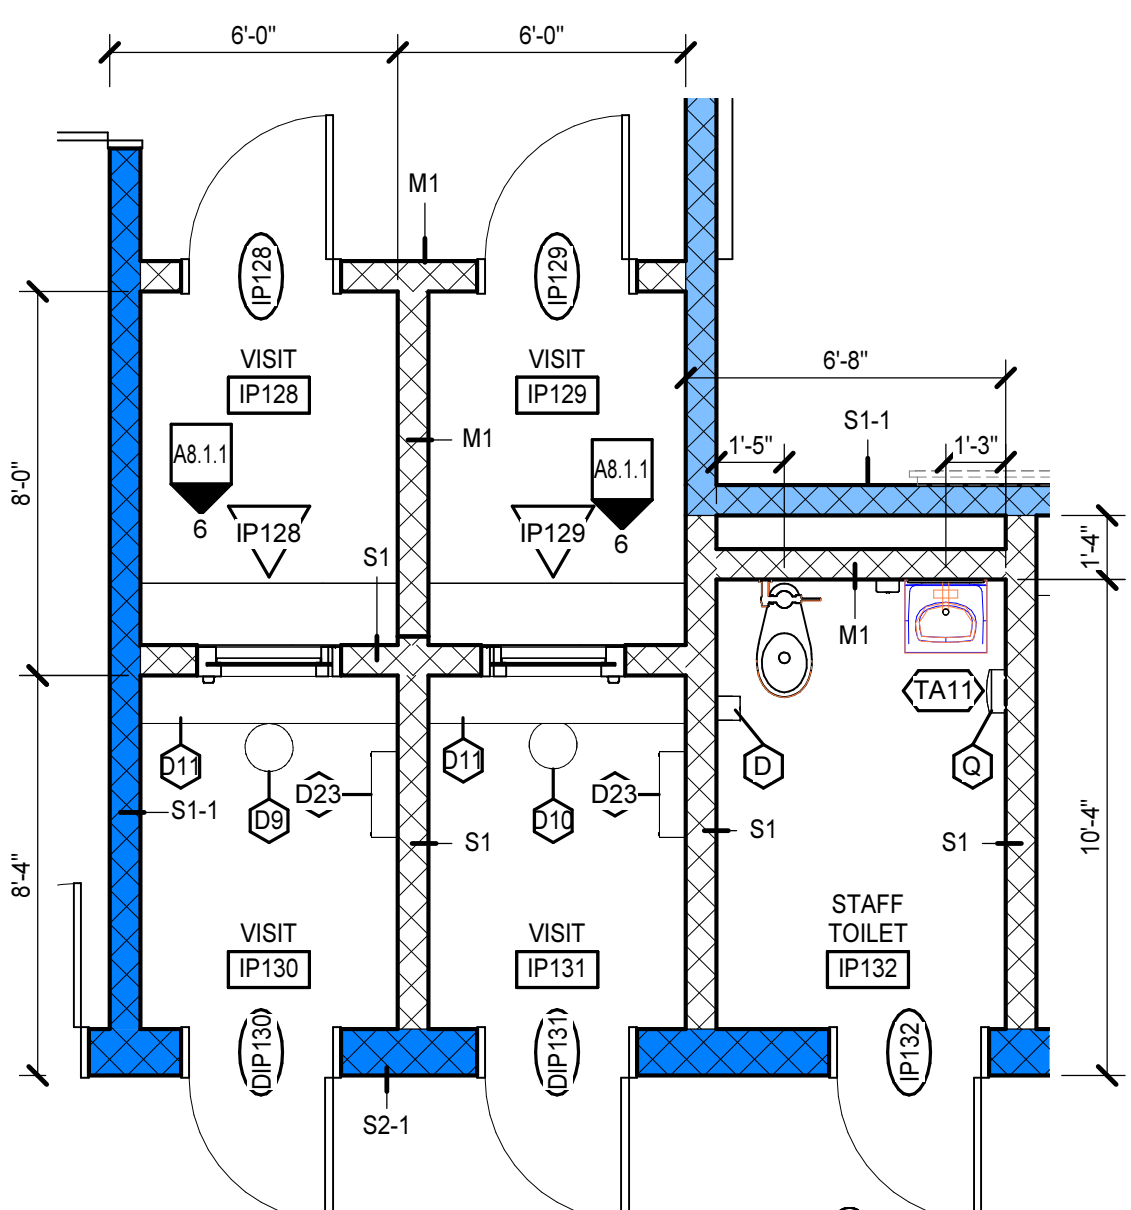


11 ENLARGED PLAN
A2.1.1|A7.1.1 1/4" = 1'-0"

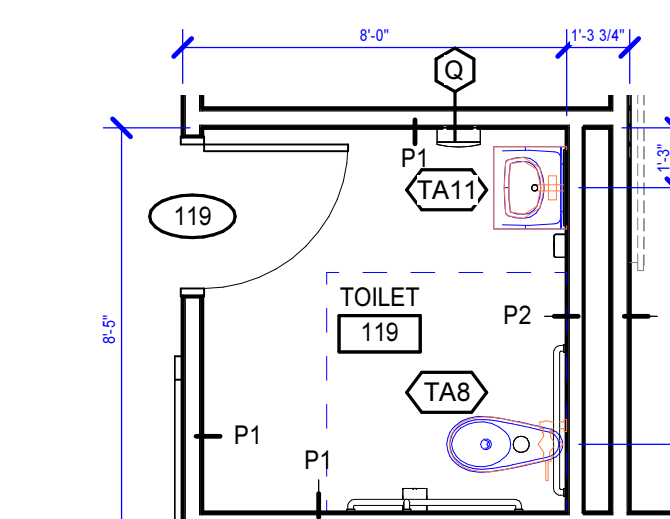


13 ENLARGED PLAN
A2.1.6|A7.1.1 1/4" = 1'-0"

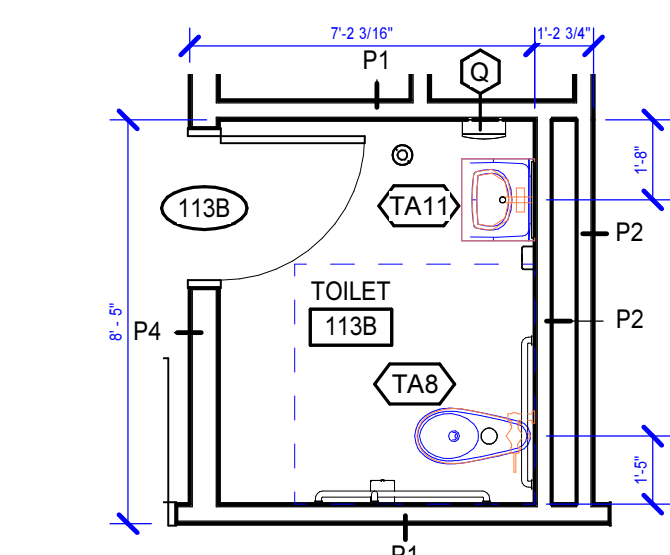


12 ENLARGED PLAN
A2.1.6|A7.1.1 1/4" = 1'-0"

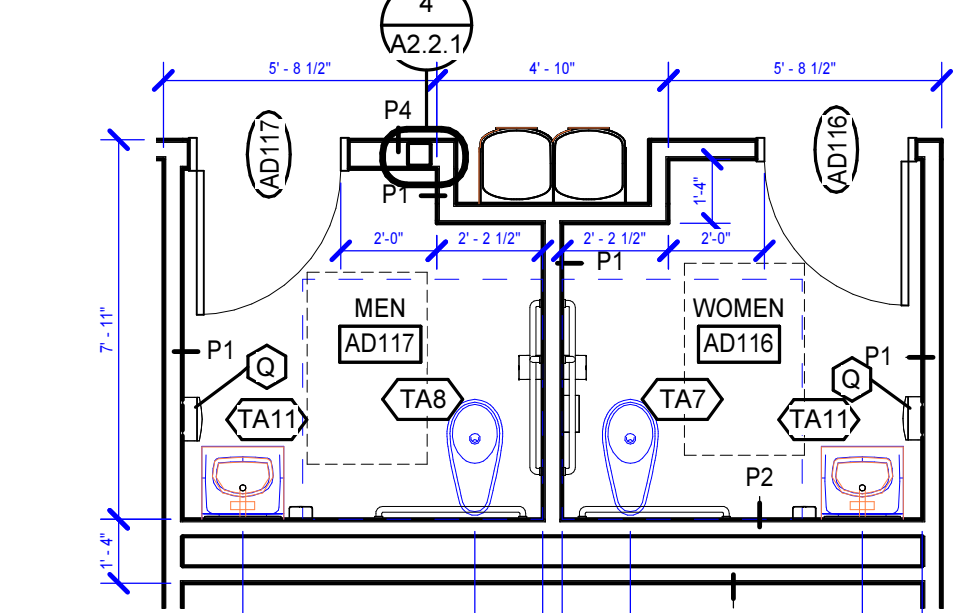


10 ENLARGED PLAN
A2.1.1|A7.1.1 1/4" = 1'-0"

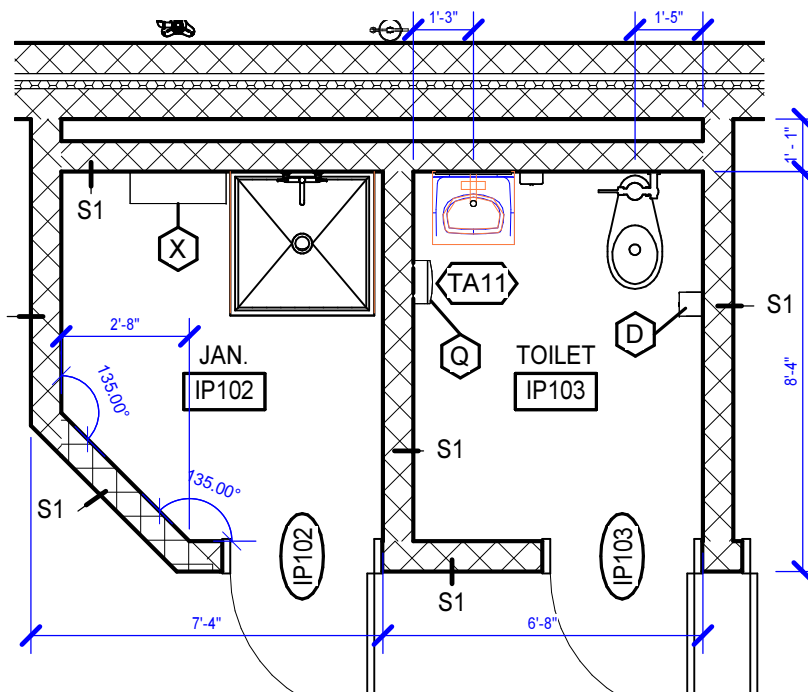


5 ENLARGED PLAN
A2.1.1|A7.1.1 1/4" = 1'-0"

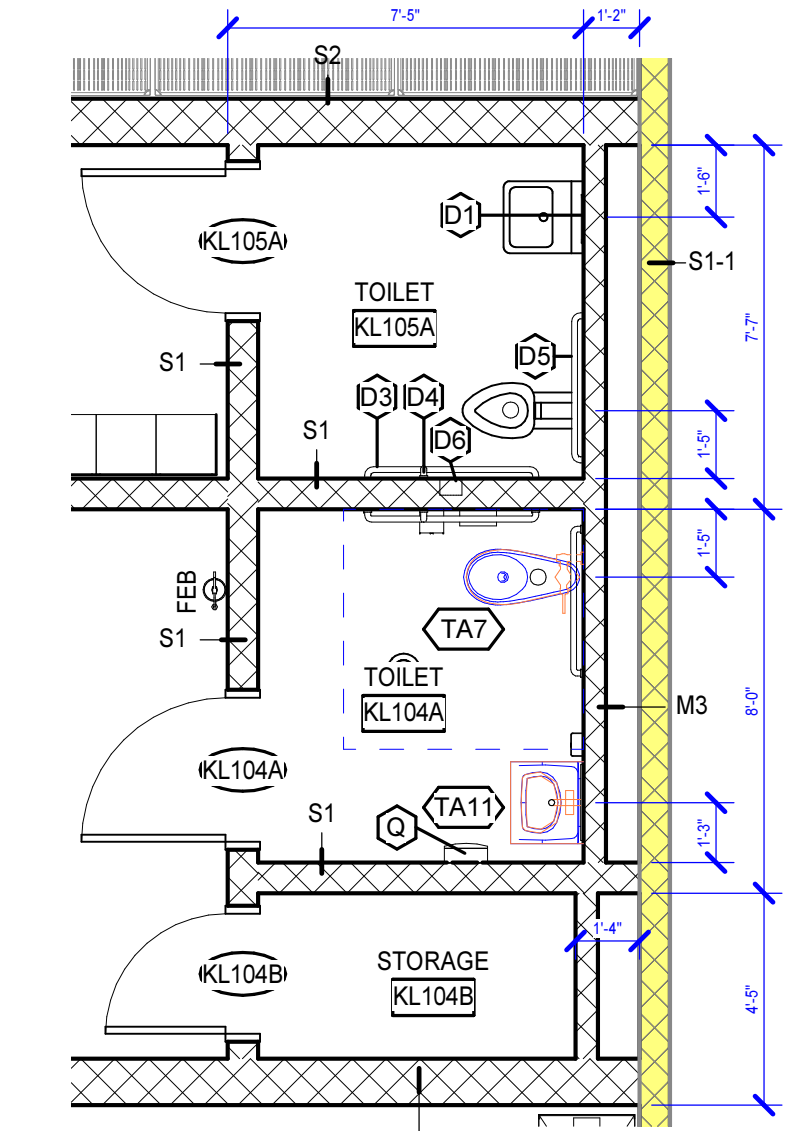

4 ENLARGED PLAN - KITCHEN TOILETS
A2.1.1|A7.1.1 1/4" = 1'-0"

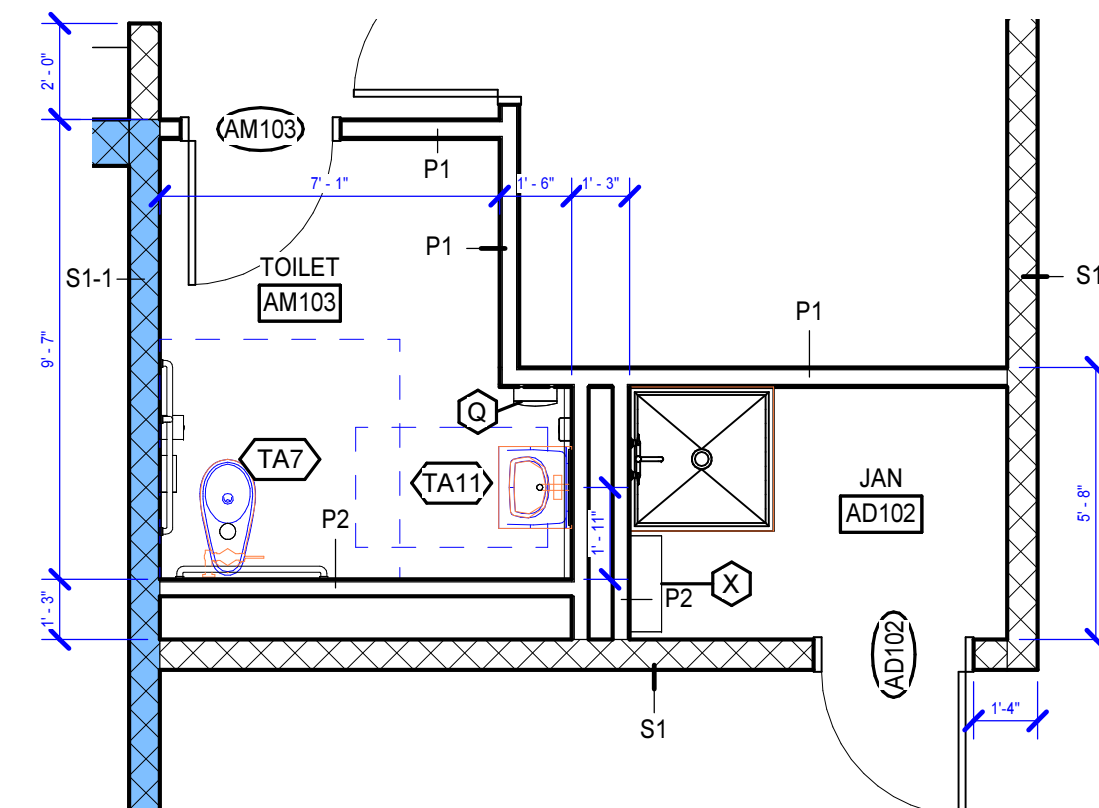


8 ENLARGED PLAN
A2.1.1|A7.1.1 1/4" = 1'-0"

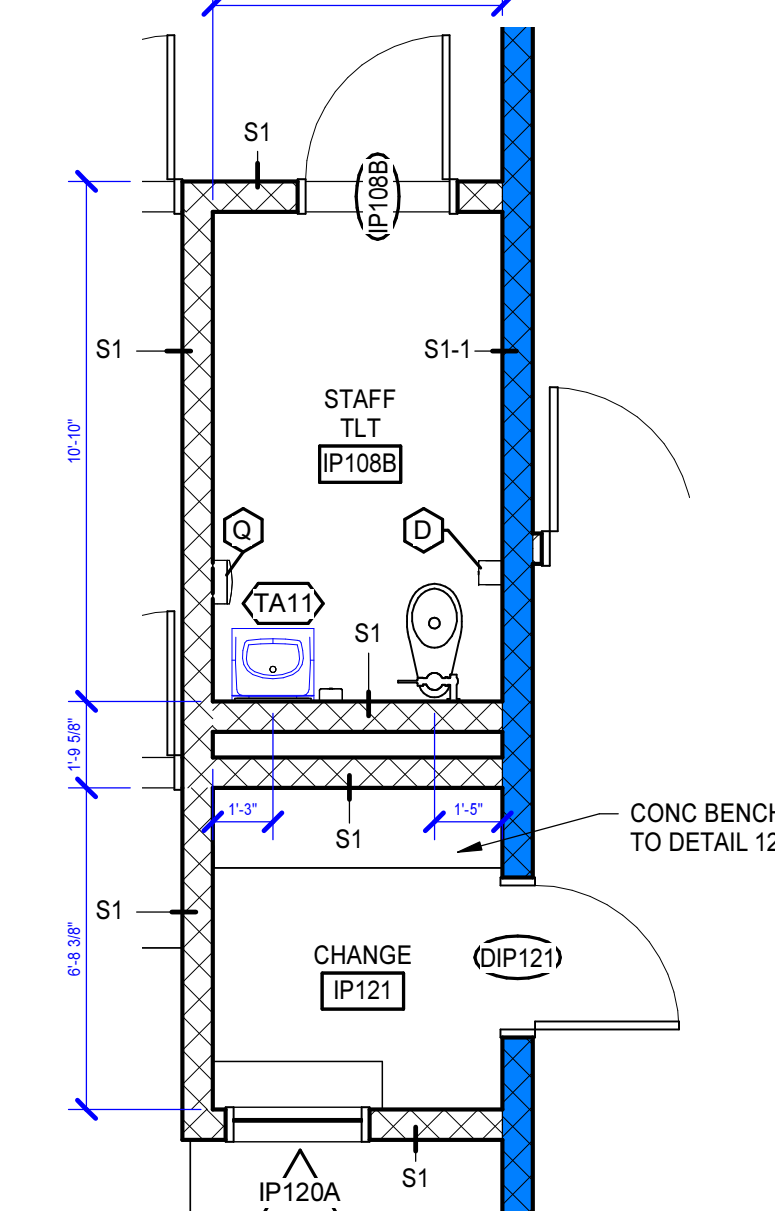

7 ENLARGED PLAN
A2.1.1|A7.1.1 1/4" = 1'-0"

NO	DESCRIPTION	MOUNTING HEIGHT	DETAIL	NOTES
D1	DETENTION MIRROR, SINGLE	REFER TO DETAIL	1/A7.2.1	
D2	DETENTION MIRROR, DOUBLE	REFER TO DETAIL	2/A7.2.1	
D3	GRAB BAR, ANTI-LIGATURE, 42"	REFER TO WATER CLOSET ELEVATIONS	3/A7.2.1	
D4	GRAB BAR, ANTI-LIGATURE - 18" VERTICAL	REFER TO WATER CLOSET ELEVATIONS	3/A7.2.1	REFER TO DETAIL 3/A7.2.1
D5	GRAB BAR, ANTI-LIGATURE, 36"	REFER TO WATER CLOSET ELEVATIONS	3/A7.2.1	
D6	RECESSED TOILET PAPER HOLDER	REFER TO DETAIL	6/A7.2.1	
D7	PISTOL LOCKER, 8-COMPARTMENT, RECESSED MTD	REFER TO DETAIL	5/A7.2.1	
D8	SS BENCH, FLOOR-MOUNTED	FLOOR MOUNTED	7/A7.2.1	
D9	STOOL, DETENTION, FLOOR-MOUNTED	FLOOR MOUNTED	9/A7.2.1	
D10	SHING STOOL, DETENTION, WALL-MOUNTED	REFER TO DETAIL	4/A7.2.1	
D11	DETENTION SS COUNTER, 12" DEPTH	REFER TO DETAIL	11/A7.2.1	
D12	TRANSACTION DRAWER	REFER TO DETAIL	15/A7.2.1	
D13	BUNK, SINGLE, FLOOR-MOUNTED	FLOOR MOUNTED	15/A7.2.1	
D14	CELL SEAT	REFER TO CELL ELEVATIONS	2/A7.2.2	BY CELL MODULE MFR
D15	CELL DESKWORKSURFACE	REFER TO CELL ELEVATIONS	11/A7.2.2	BY CELL MODULE MFR
D16	18"x36" CORNER GRAB BAR ASSEMBLY, ANTI-LIGATURE	REFER TO SHOWER ELEVATIONS		
D17	DETENTION 4MM TABLE	FLOOR MOUNTED	13/A7.2.1	
D17A	DETENTION 4MM TABLE - ACCESSIBLE	FLOOR MOUNTED	14/A7.2.1	
D18	BUNK, SINGLE, WALL-MOUNTED	15" TOP OF PAN	3/A7.2.2	BY CELL MODULE MFR
D19	BUNK, DOUBLE, WALL-MOUNTED	BOTTOM BUNK 15", TOP BUNK 50", TOP OF PAN	3/A7.2.2	BY CELL MODULE MFR
D20	SEMI-RECESSED TOILET PAPER HOLDER	REFER TO DETAIL	8/A7.2.1	BY CELL MODULE MFR
D21	SAFETY HOOK, SINGLE	REFER TO DETAIL	8/A7.2.1	
D22	DOUBLE DETENTION HOOK - ANTI-LIGATURE	REFER TO DETAIL	8/A7.2.1	
D23	VIDEO DISCOVERY STATION	REFER TO DETAIL		REFER TO SECTION 285200
D24	L-SHAPED FOLDING SHOWER SEAT	1'-6" TO SEAT SURFACE		
D25	GRAB BAR, ANTI-LIGATURE, 24"	REFER TO WATER CLOSET ELEVATIONS	3/A7.2.1	
D26	GRAB BAR, ANTI-LIGATURE, 48"	REFER TO WATER CLOSET ELEVATIONS	3/A7.2.1	

AD-03

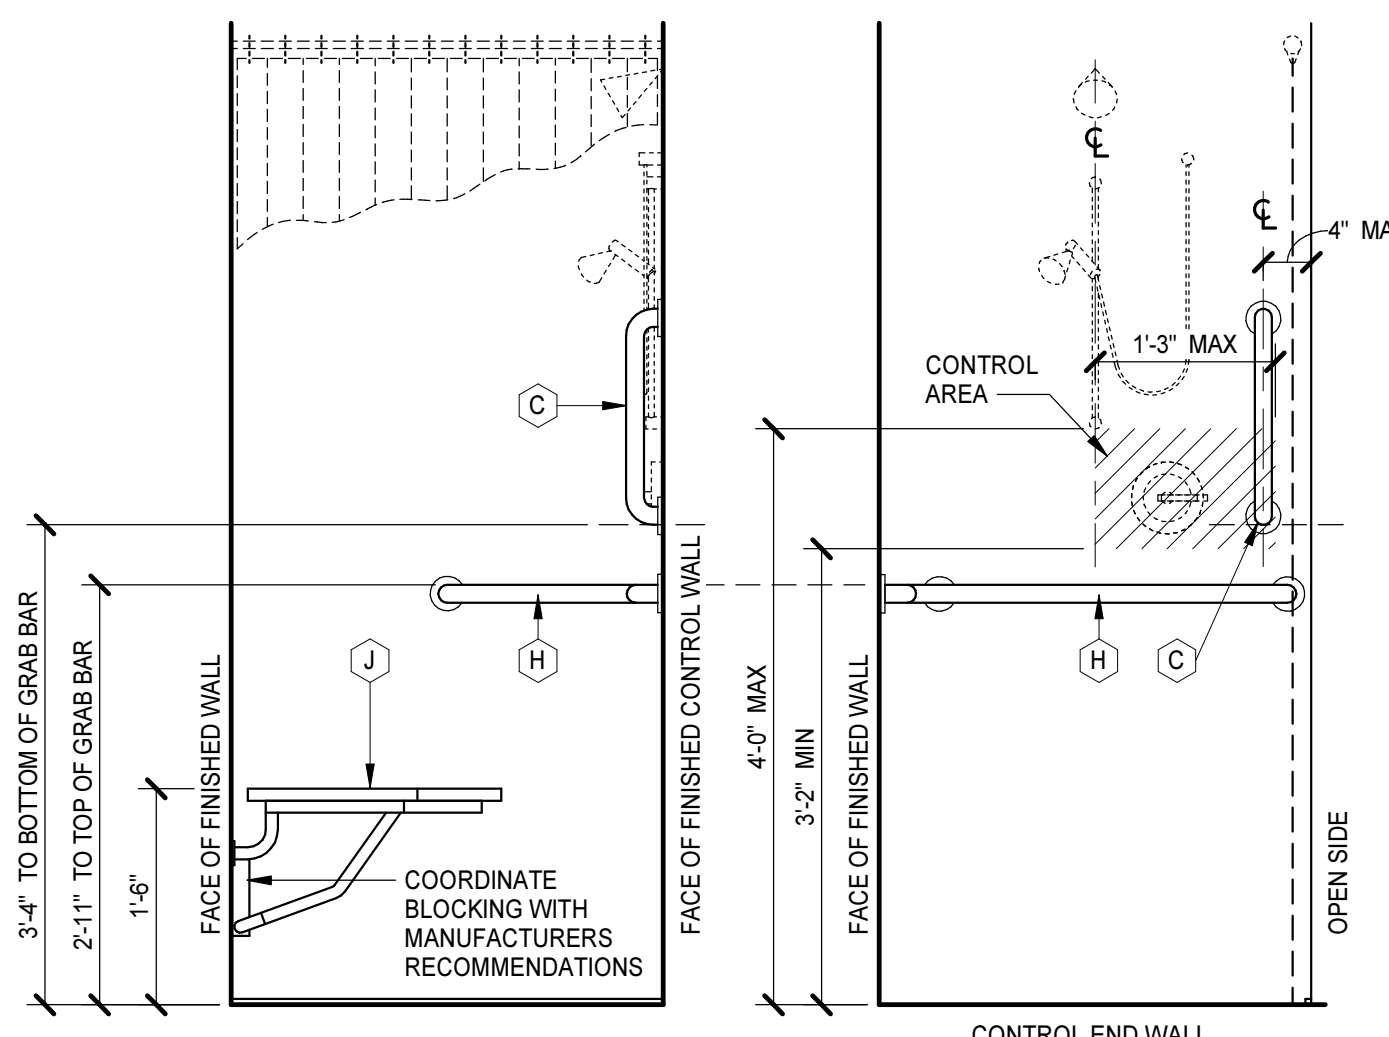

TRANSFER-TYPE SHOWER ELEVATIONS

TOILET ASSEMBLIES			TOILET ASSEMBLIES		
APPLIES TO DRAWINGS A7.1.1 - A7.1.n			REPRESENTED BY (TA#)		
MARK	REMARKS	PLAN	MARK	REMARKS	PLAN
TA1			TA10	BARRIER FREE	
TA2	OMIT (E)		TA11	CENTER OVER LAVATORY	
TA3			TA12	BARRIER FREE	
TA4	OMIT (E)		TA13	OMIT (C, H, J)	
TA5			TA14	BARRIER FREE	
TA6	OMIT (E)		TA15	BARRIER FREE	
TA7					
TA8	OMIT (E)				
TA9					


TOILET ACCESSORIES SCHEDULE			
MARK	DESCRIPTION	MOUNTING HEIGHT	REMARKS
A	36" HORIZONTAL GRAB BAR	REFER TO WATER CLOSET ELEVATIONS	
B	42" HORIZONTAL GRAB BAR	REFER TO WATER CLOSET ELEVATIONS	
C	18" VERTICAL GRAB BAR	REFER TO WATER CLOSET ELEVATIONS	
D	TOILET TISSUE DISPENSER	REFER TO WATER CLOSET ELEVATIONS	
E	SANITARY NAPKIN DISPOSAL	REFER TO WATER CLOSET ELEVATIONS	
F	SOAP DISPENSER	3'-4" AFF TO DISPENSING OUTLET	
G	MIRROR (18" x 36") OVER LAV AND COUNTERTOP	3'-4" AFF TO BOTTOM OF REFLECTIVE SURFACE	
H	18"x36" CORNER GRAB BAR ASSEMBLY	REFER TO SHOWER ELEVATIONS	
J	L-SHAPED FOLDING SHOWER SEAT	1'-6" TO SEAT SURFACE	
Q	PAPER TOWEL DISPENSER	3'-8" AFF TO DISPENSING OUTLET	
R	MIRROR (24" x 30")	2'-0" AFF TO BOTTOM OF REFLECTIVE SURFACE	
S	ROBE HOOK	3'-11" TO TOP OF HOOK	
X	COMBINATION UTILITY SHELF / MOP HOLDER		

- ACCESSORY ITEMS ARE IDENTIFIED BY (X) ON PLANS. LETTERS CORRESPOND TO SCHEDULE ABOVE.
- ACTUAL DIMENSIONS OF ACCESSORIES MAY VARY. COORDINATE DIFFERENCES, IF ANY.
- REFER TO ALL CASEWORK ELEVATIONS FOR ADDITIONAL TOILET ACCESSORY LOCATIONS.
- PROVIDE MOP AND BROOM HOLDER W/ SHELF (X) AT ALL CUSTODIAL/ANTITORIAL SINKS. MOUNT AT 5'-0" AFF TO CENTERLINE AND LOCATE ON SIDE WALL OF SINK (NOT ON WALL ABOVE FAUCET).
- PROVIDE ROBE HOOK ON INTERIOR FACE OF ALL TOILET ROOM DOORS WHEREIN ONLY ONE WATER CLOSET IS PROVIDED. MOUNT AT 3'-11" AFF TO TOP.

TOILET ASSEMBLIES, SCHEDULE AND ENLARGED PLAN GENERAL NOTES

A. PLAN DIMENSIONS ARE TO FACE OF WALL OR PARTITION. WHERE APPLIED FINISHES OCCUR SUCH AS CERAMIC TILE, DIMENSIONS ARE TO FACE OF APPLIED FINISH. FOR WAINSCOTS, FLOOR PLAN DIMENSIONS ARE TO FACE OF WAINSCOT MATERIAL. APPLIED FINISHES ARE NOT ALLOWED TO REDUCE CLEAR DIMENSIONS. "APPLIED FINISHES" IN THIS CASE DO NOT INCLUDE TRIM, BASE, AND ACOUSTIC WALL PANELS.

B. CLEAR DIMENSIONS ARE TO FACE OF APPLIED WALL AND PARTITION FINISHES.

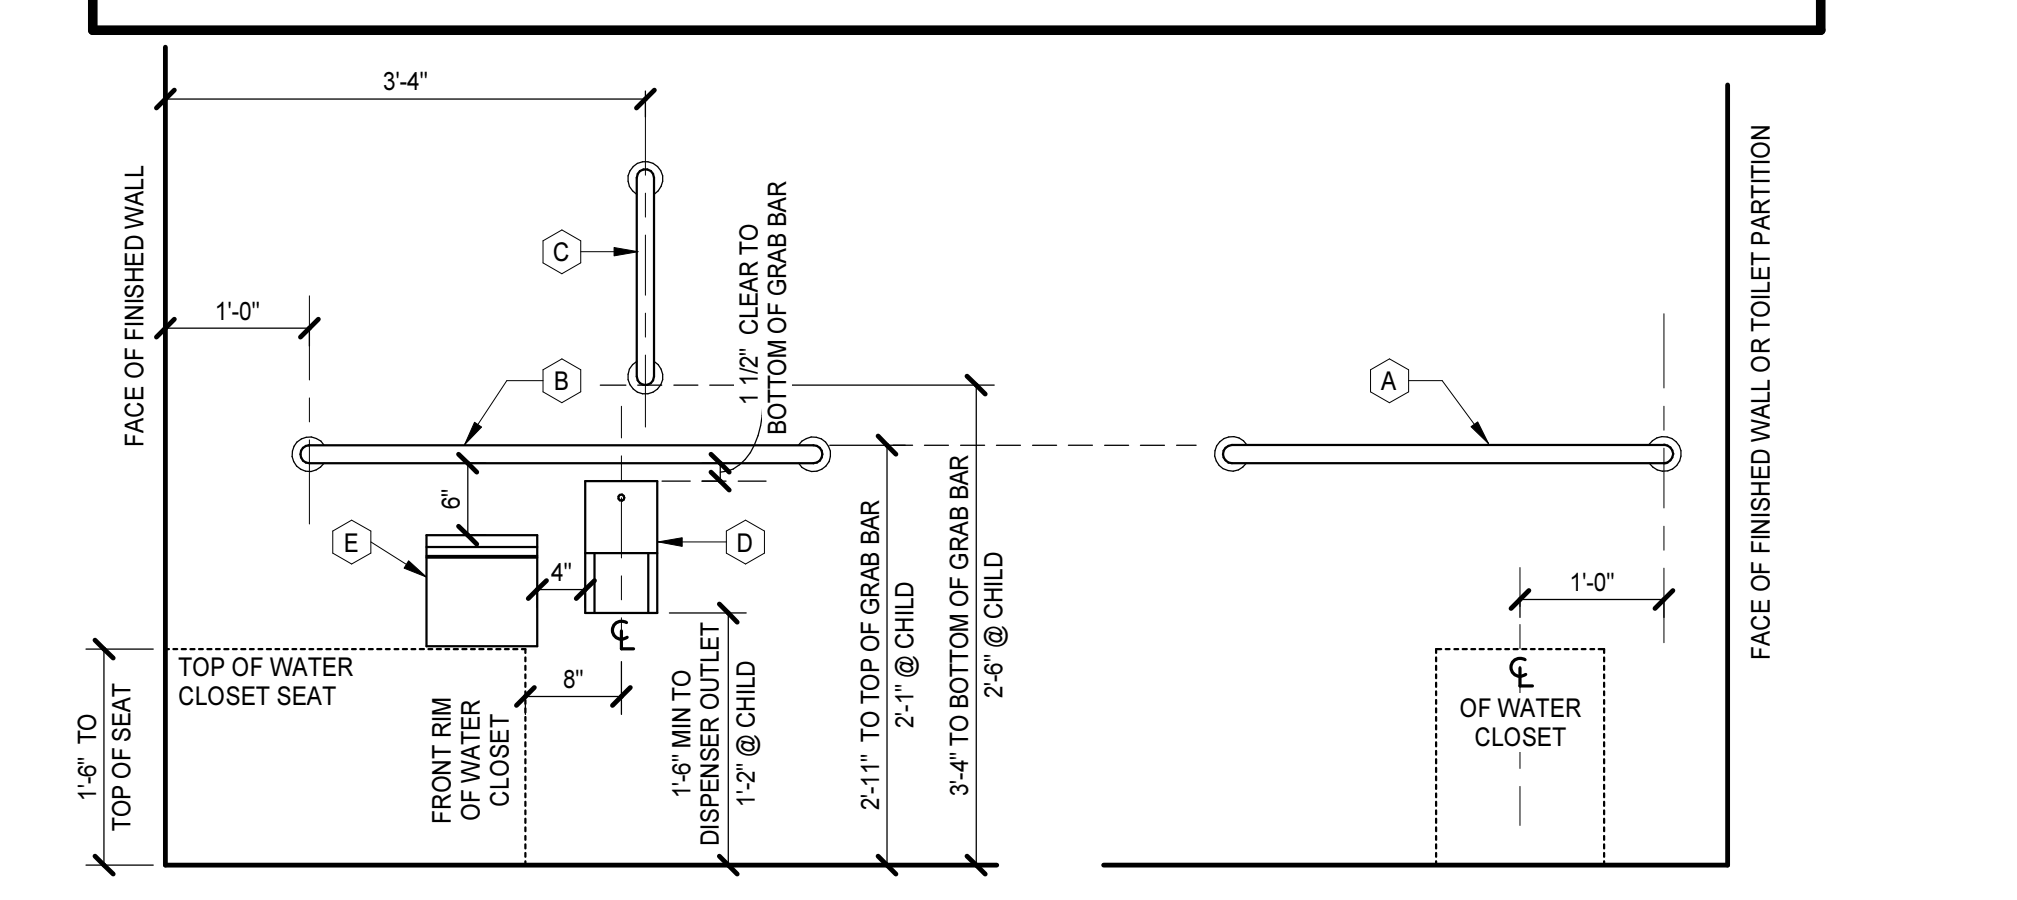

WATER CLOSET ELEVATIONS

MOSELEY ARCHITECTS
6210 ARDREY KELL ROAD • THE HUB AT WAWERLY, SUITE 425 • CHARLOTTE, NC 28277
PHONE (704) 540-3155 FAX (704) 540-3154
MOSELEYARCHITECTS.COM

STEVEN J. HOPKINS
REGISTERED ARCHITECT
11547
NORTH CAROLINA
01/15/24
CHARLOTTE, NC

MOSELEY ARCHITECTS, P.C.
REGISTERED ARCHITECTS
50149
NORTH CAROLINA
01/15/24


PENDER COUNTY LEG
DHSR# J-368 / FID# 220537
PENDER COUNTY, NORTH CAROLINA
1417 OLD SAVANNAH ROAD BURGAW, NC

DATE	REVISIONS
06/12/24	AD-03


PROJECT NO: 611688
DATE: 06/12/24
DATE: 06/12/24
DESCRIPTION: AD-03

TOILET ASSEMBLIES, SCHEDULE & ENLARGED PLANS


A7.1.1

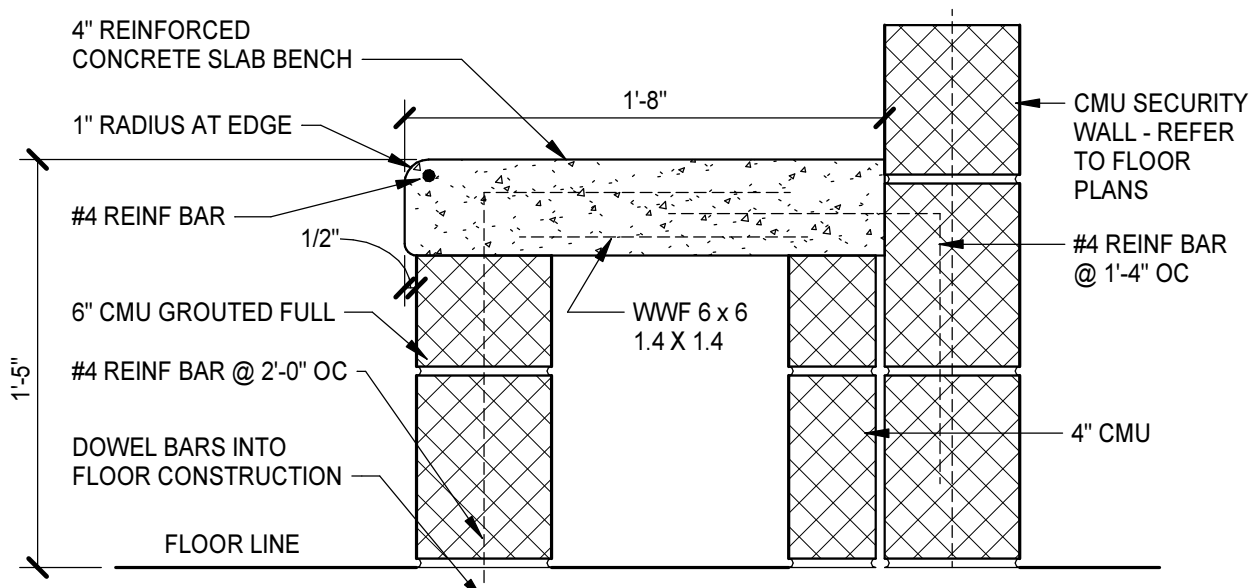


12 CONCRETE BENCH
A7.1.1/A7.1.2 1/4" = 1'-0"

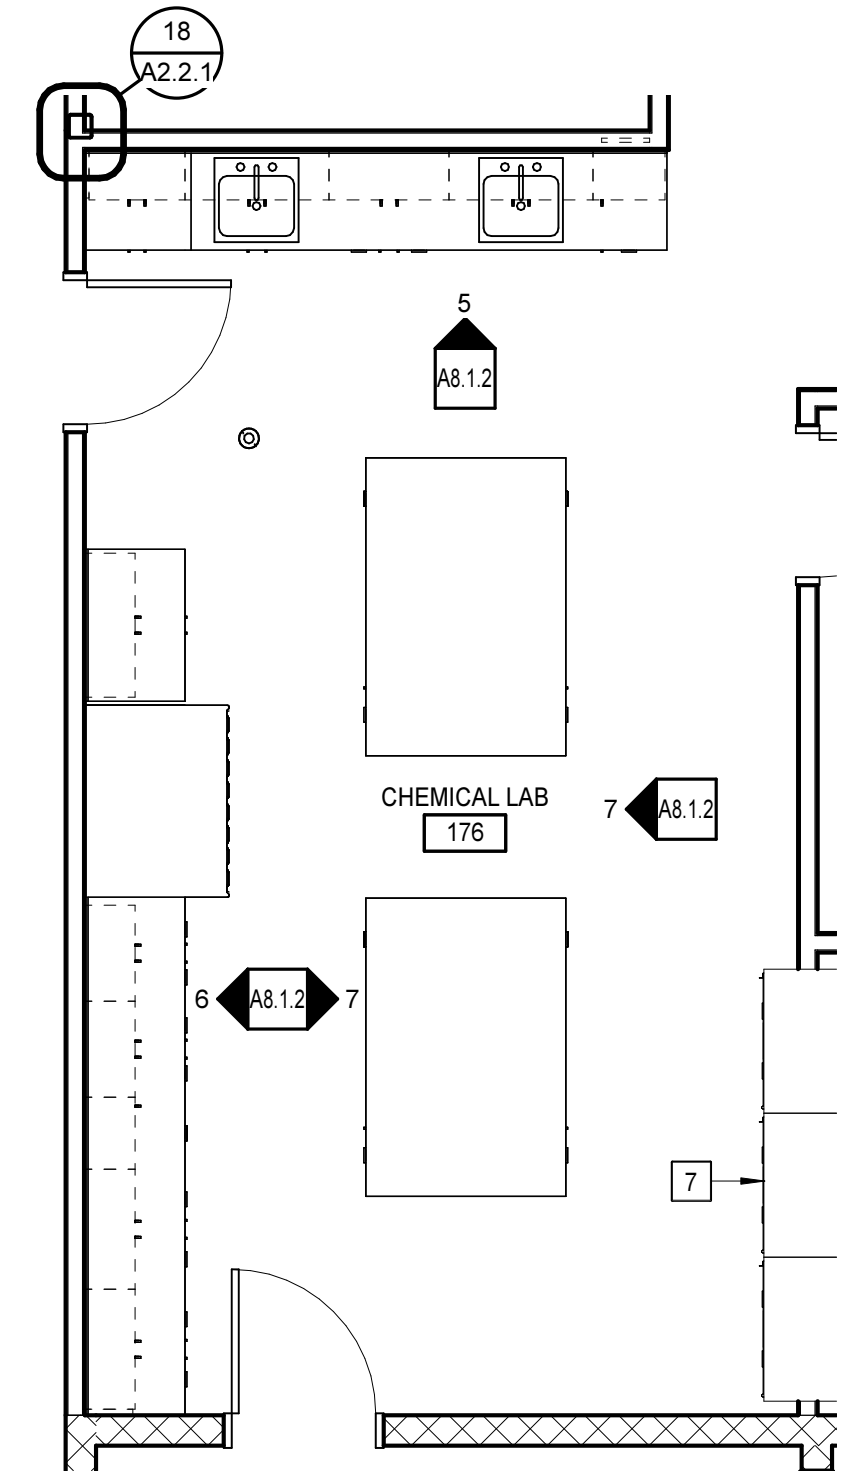


11 ENLARGED PLAN
A2.1.7/A7.1.2 1/4" = 1'-0"

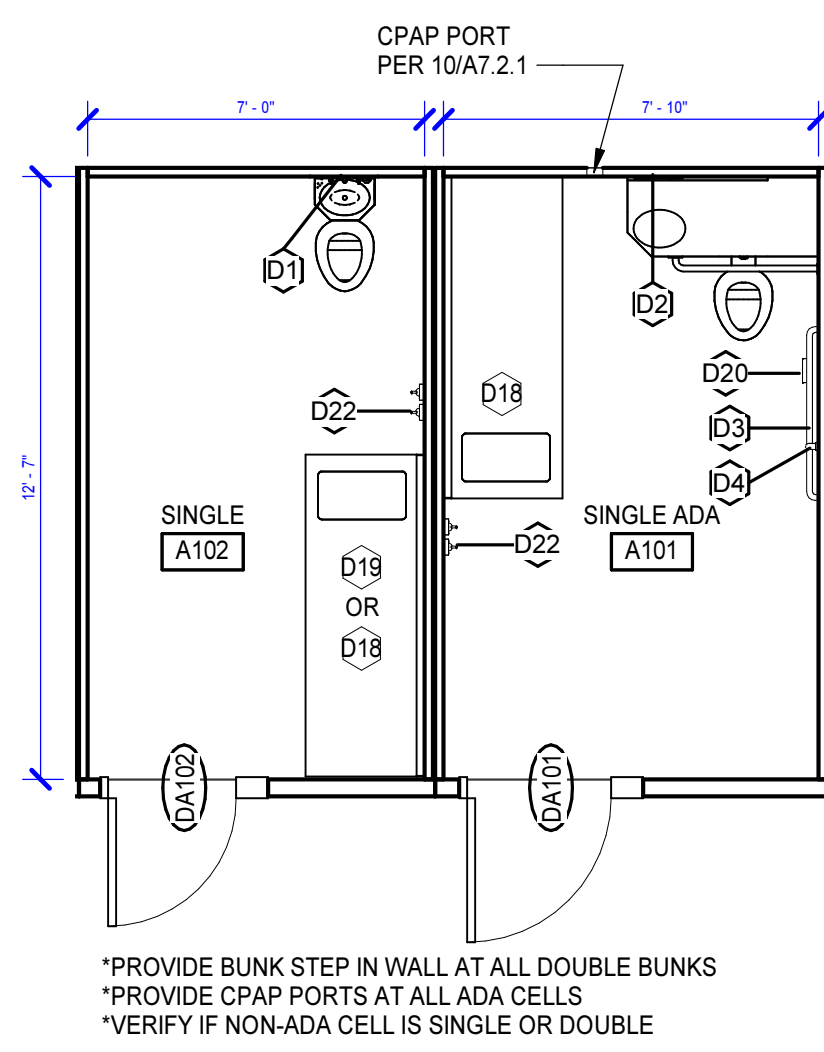


9 ENLARGED PLAN - TYPICAL CELL MODULE
A2.1.2/A7.1.2 1/4" = 1'-0"

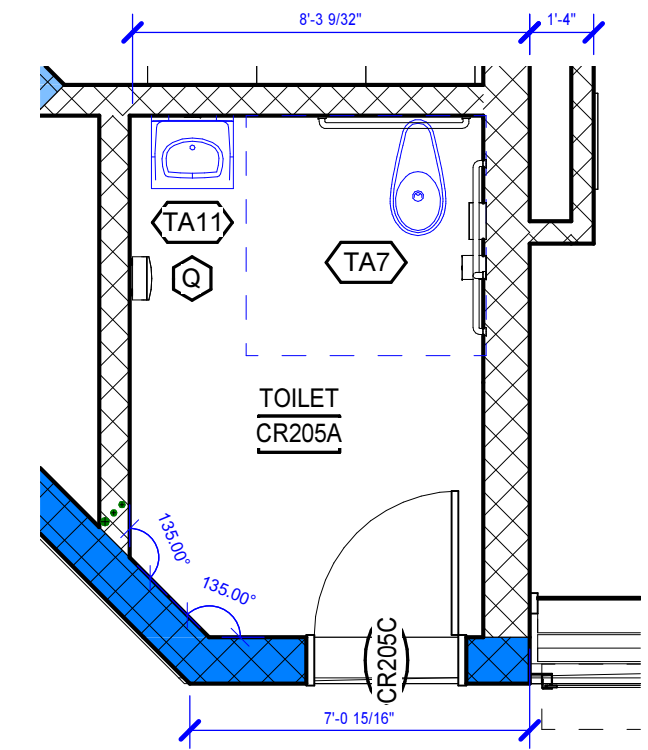


10 ENLARGED PLAN
A2.1.3/A7.1.2 1/4" = 1'-0"

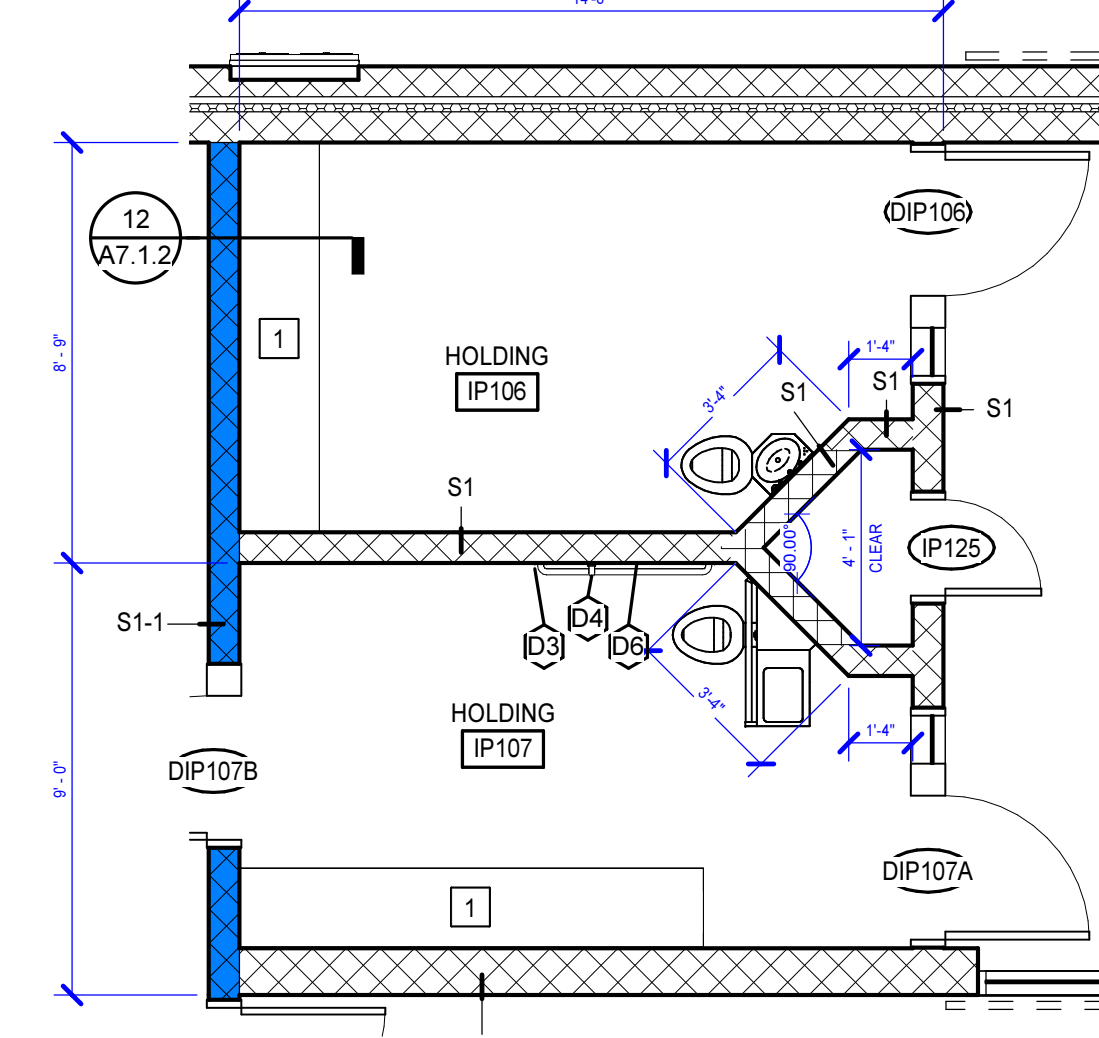


8 ENLARGED PLAN
A2.1.1/A7.1.2 1/4" = 1'-0"

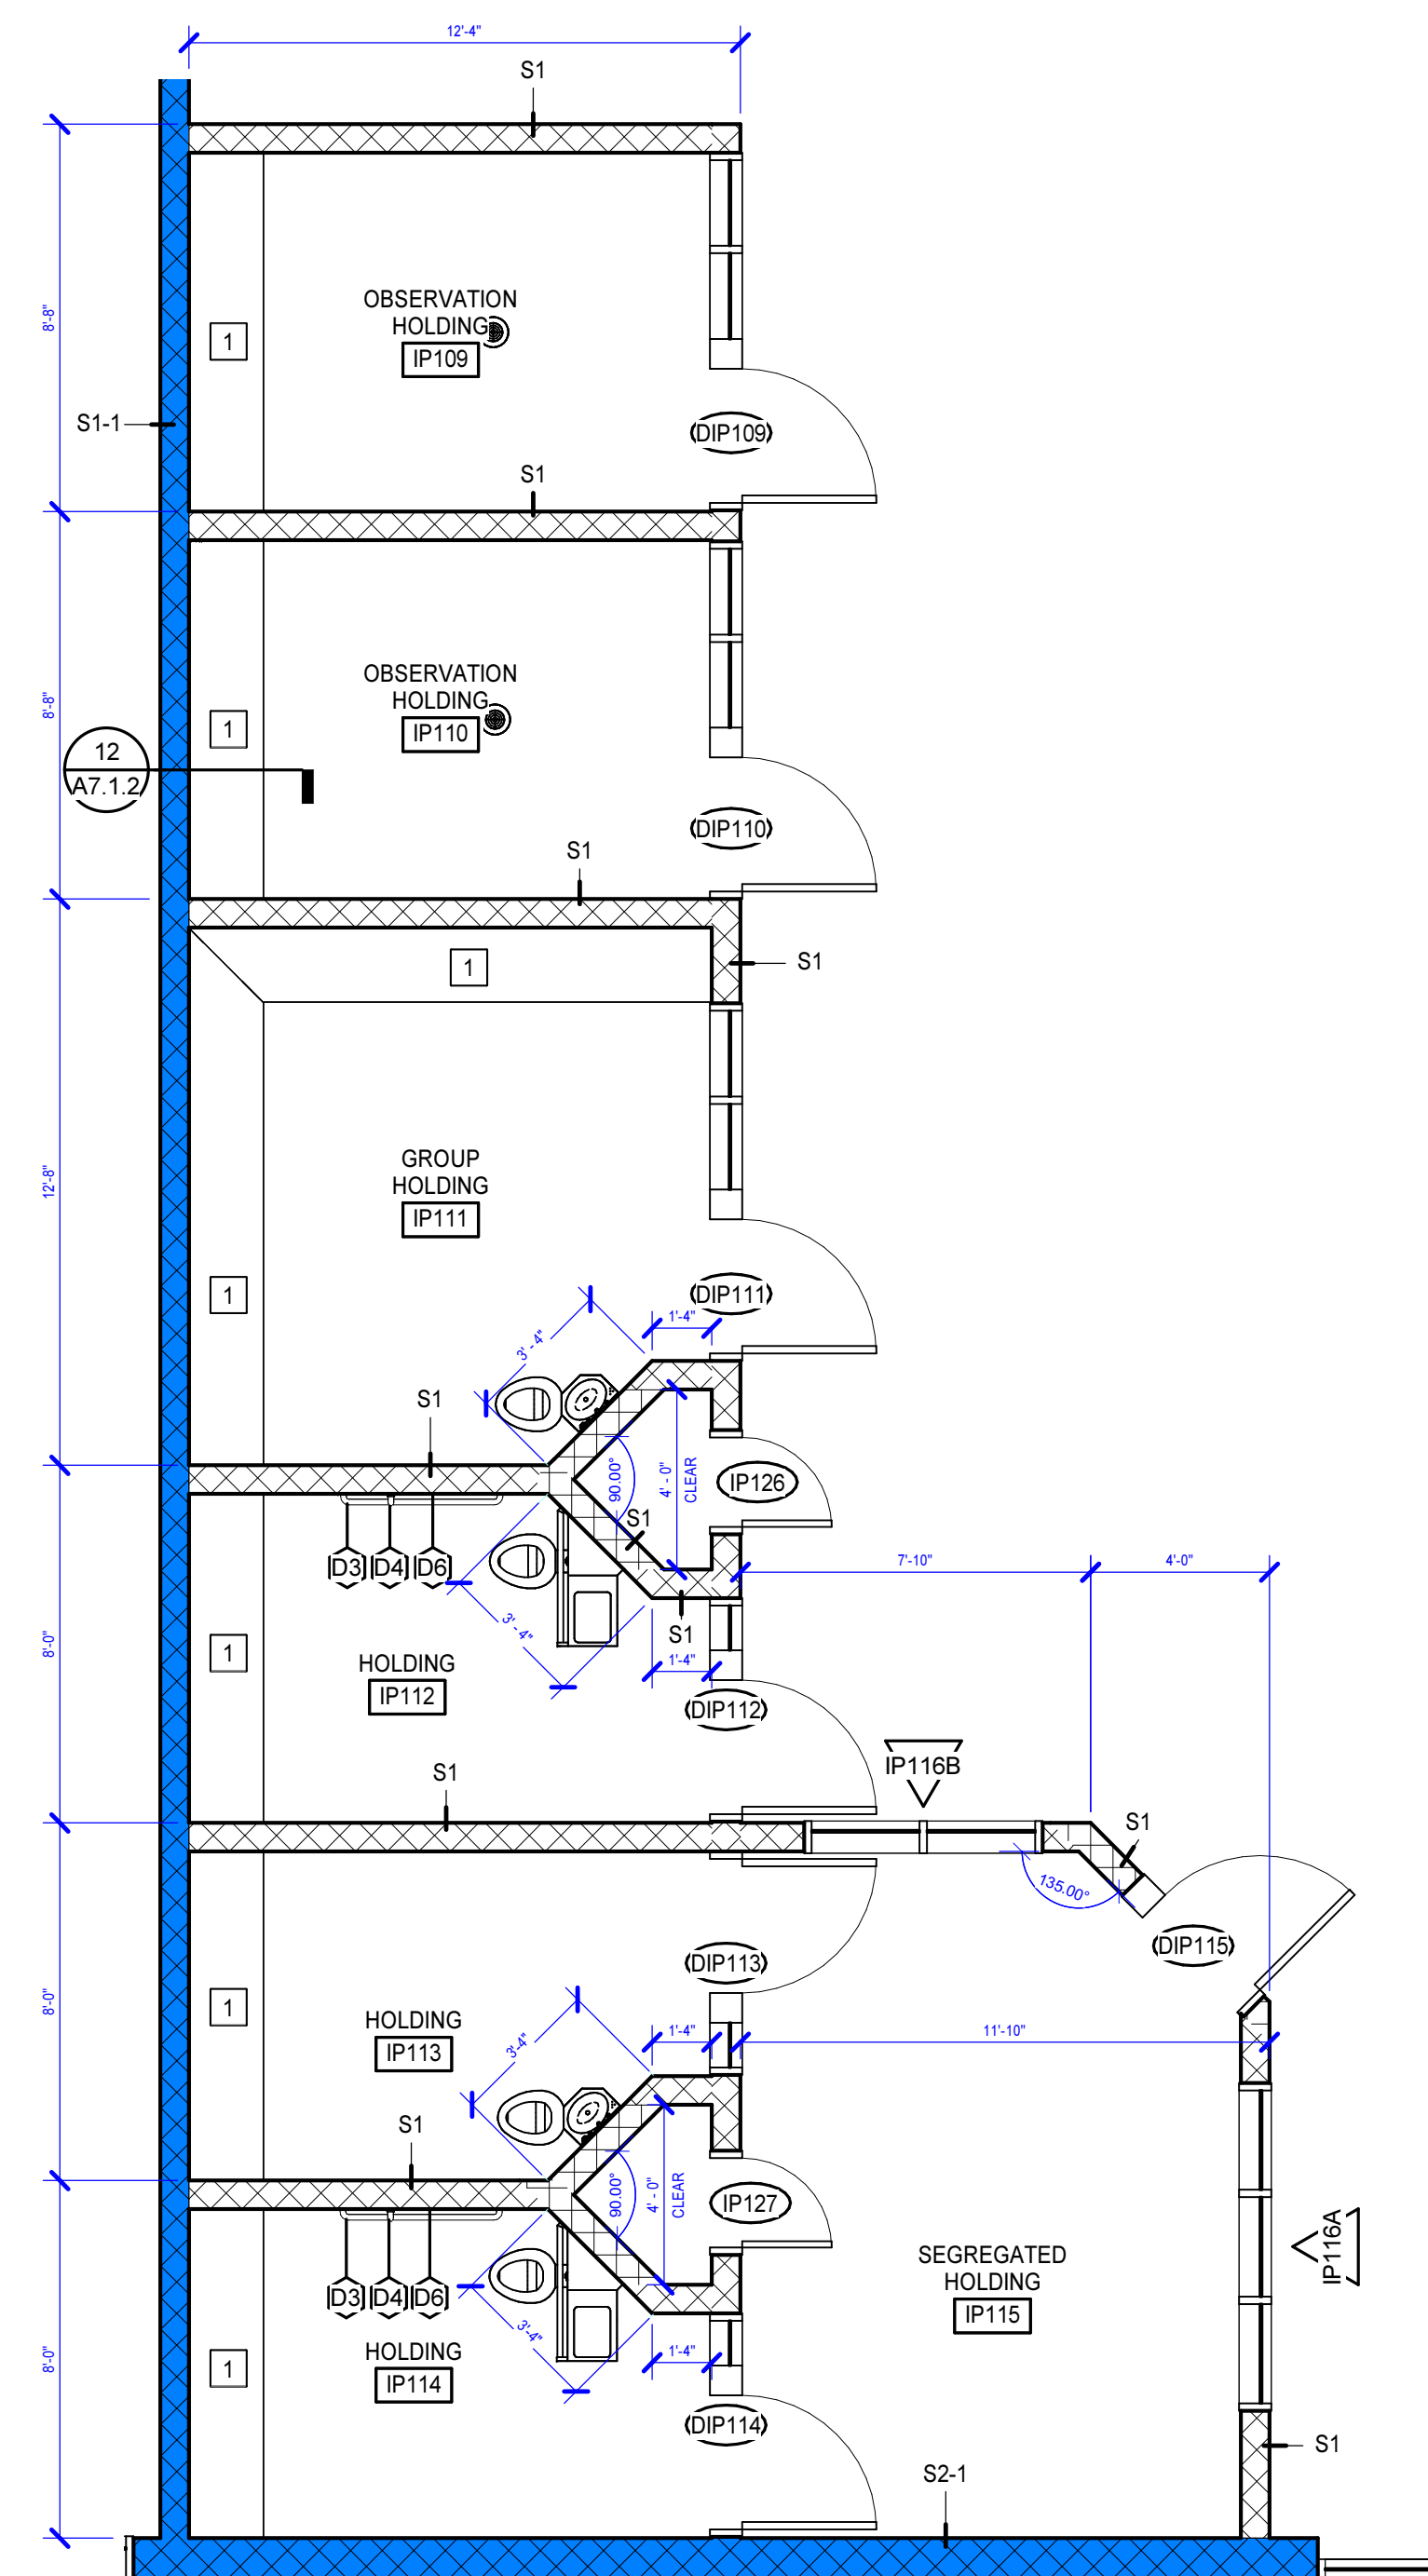

7 ENLARGED PLAN
A2.1.1/A7.1.2 1/4" = 1'-0"

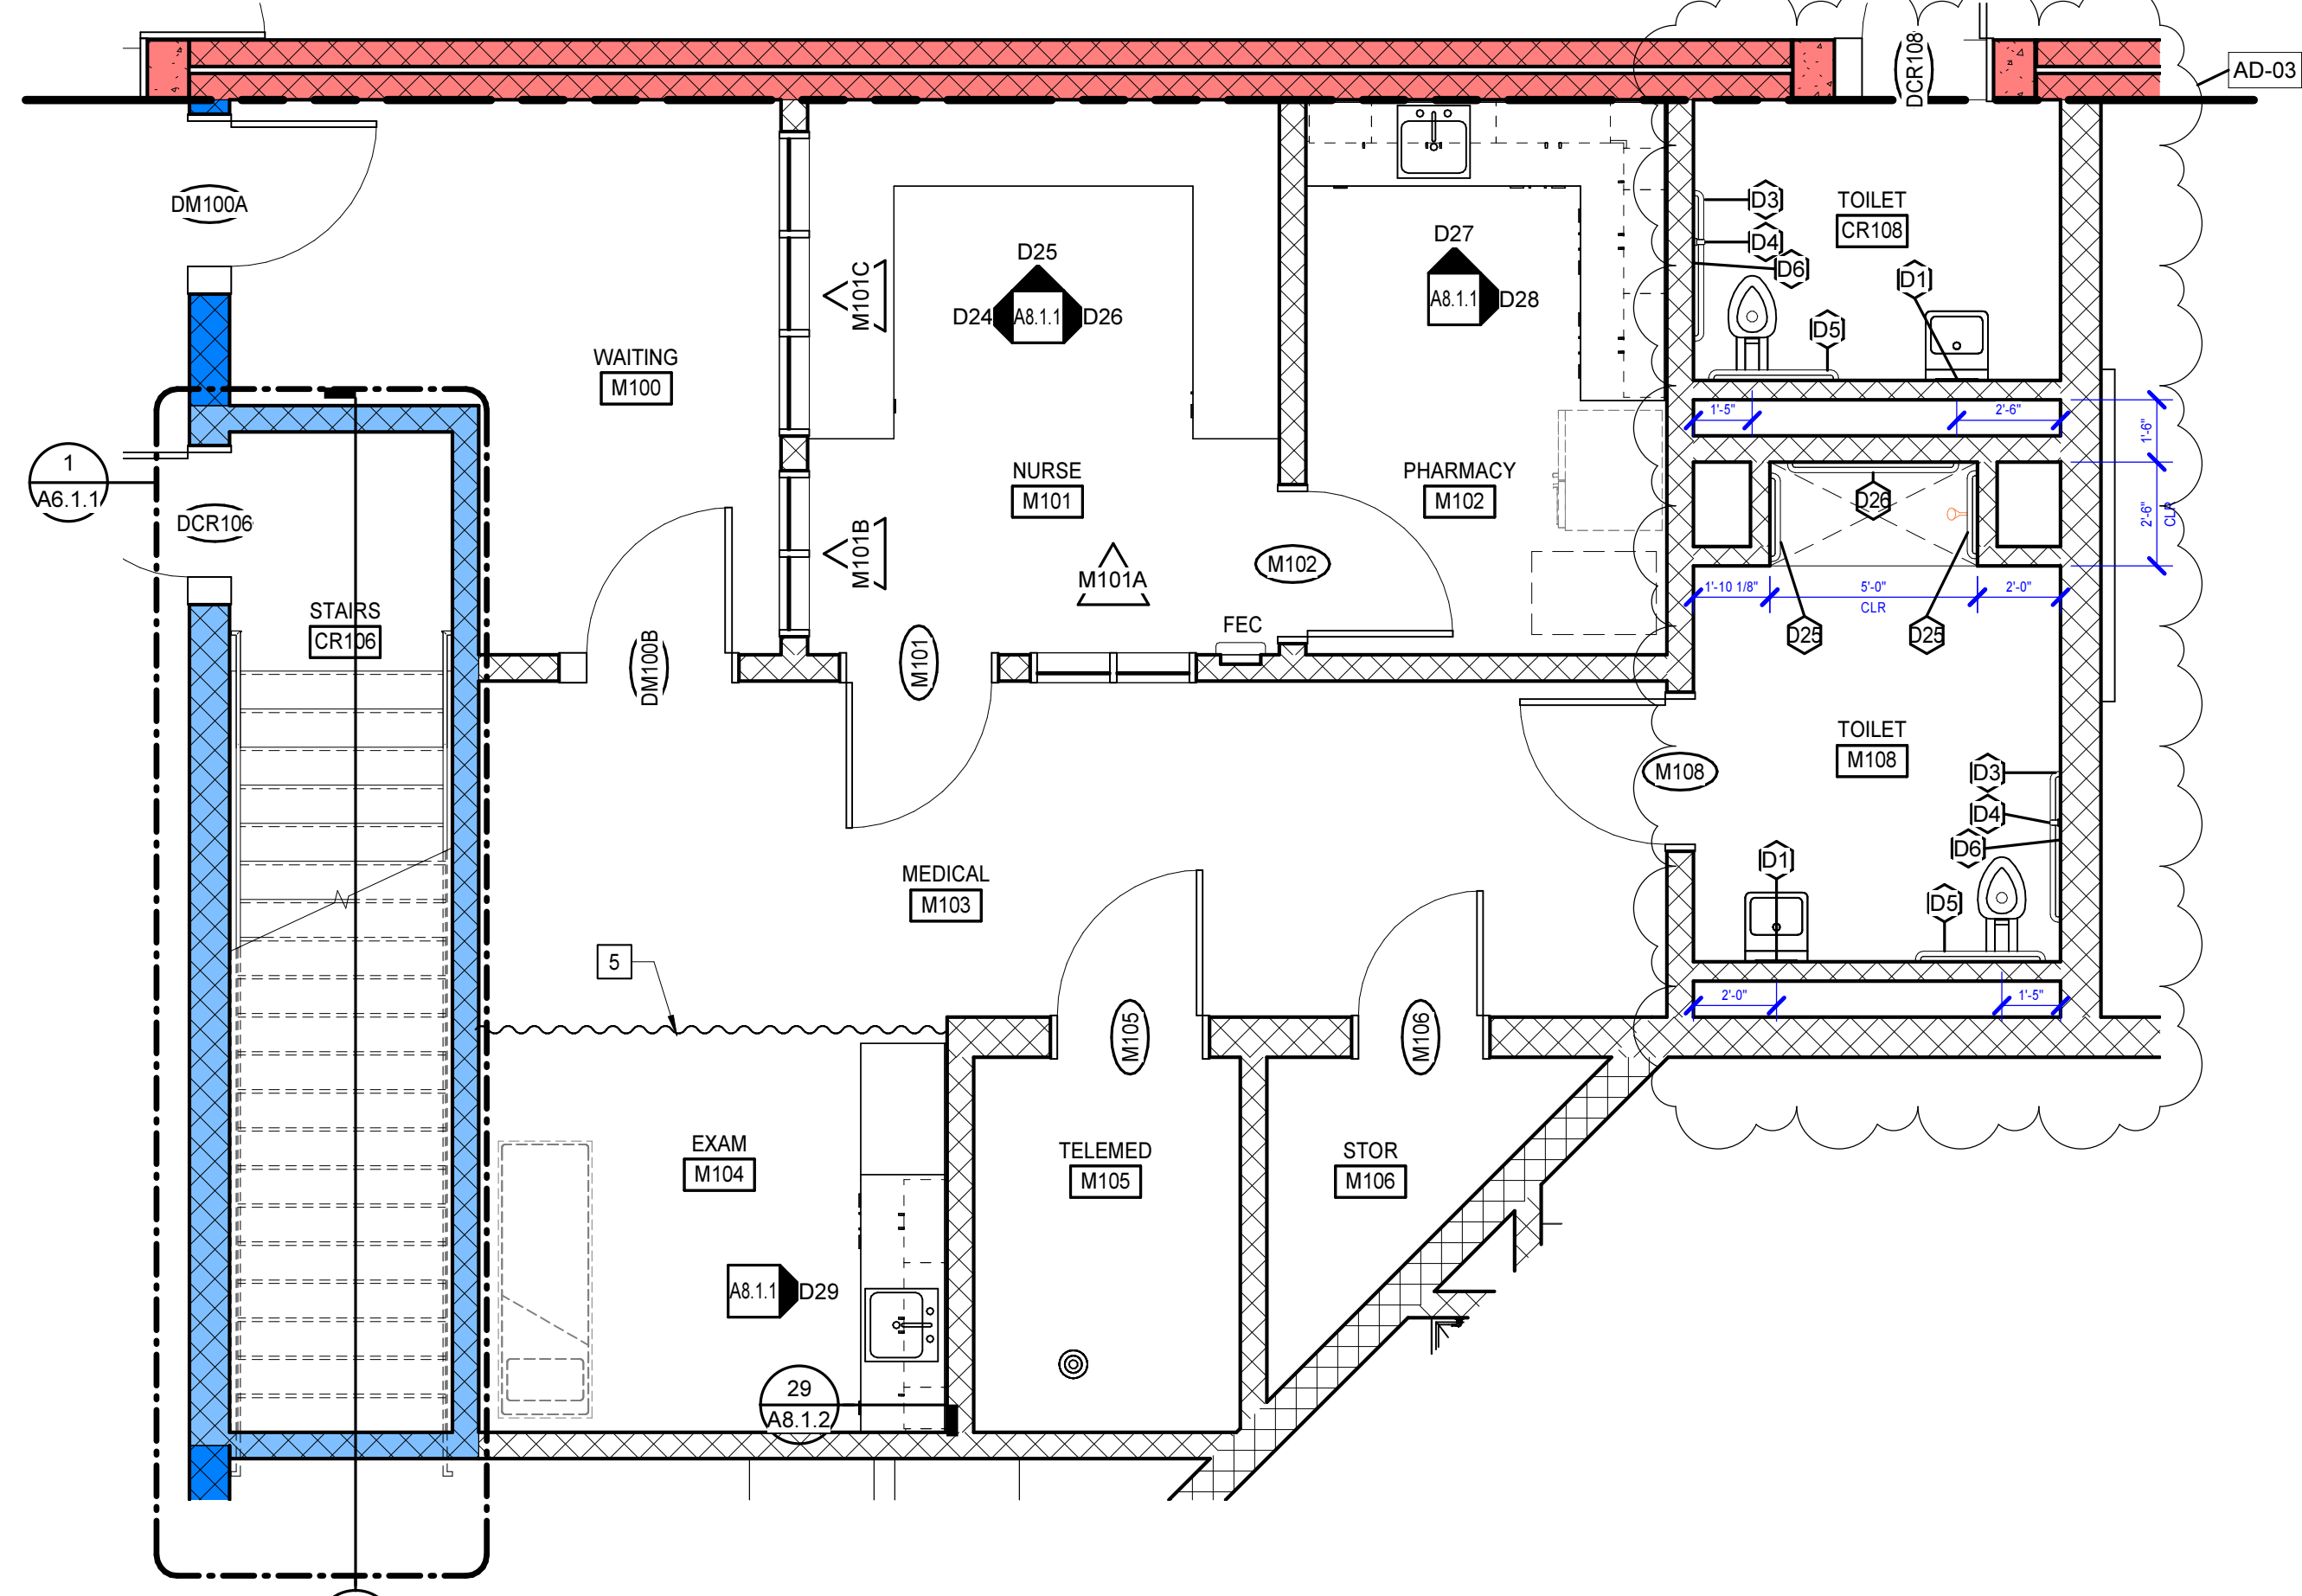

5 ENLARGED PLAN - MEDICAL AREA
A2.1.2/A7.1.2 1/4" = 1'-0"

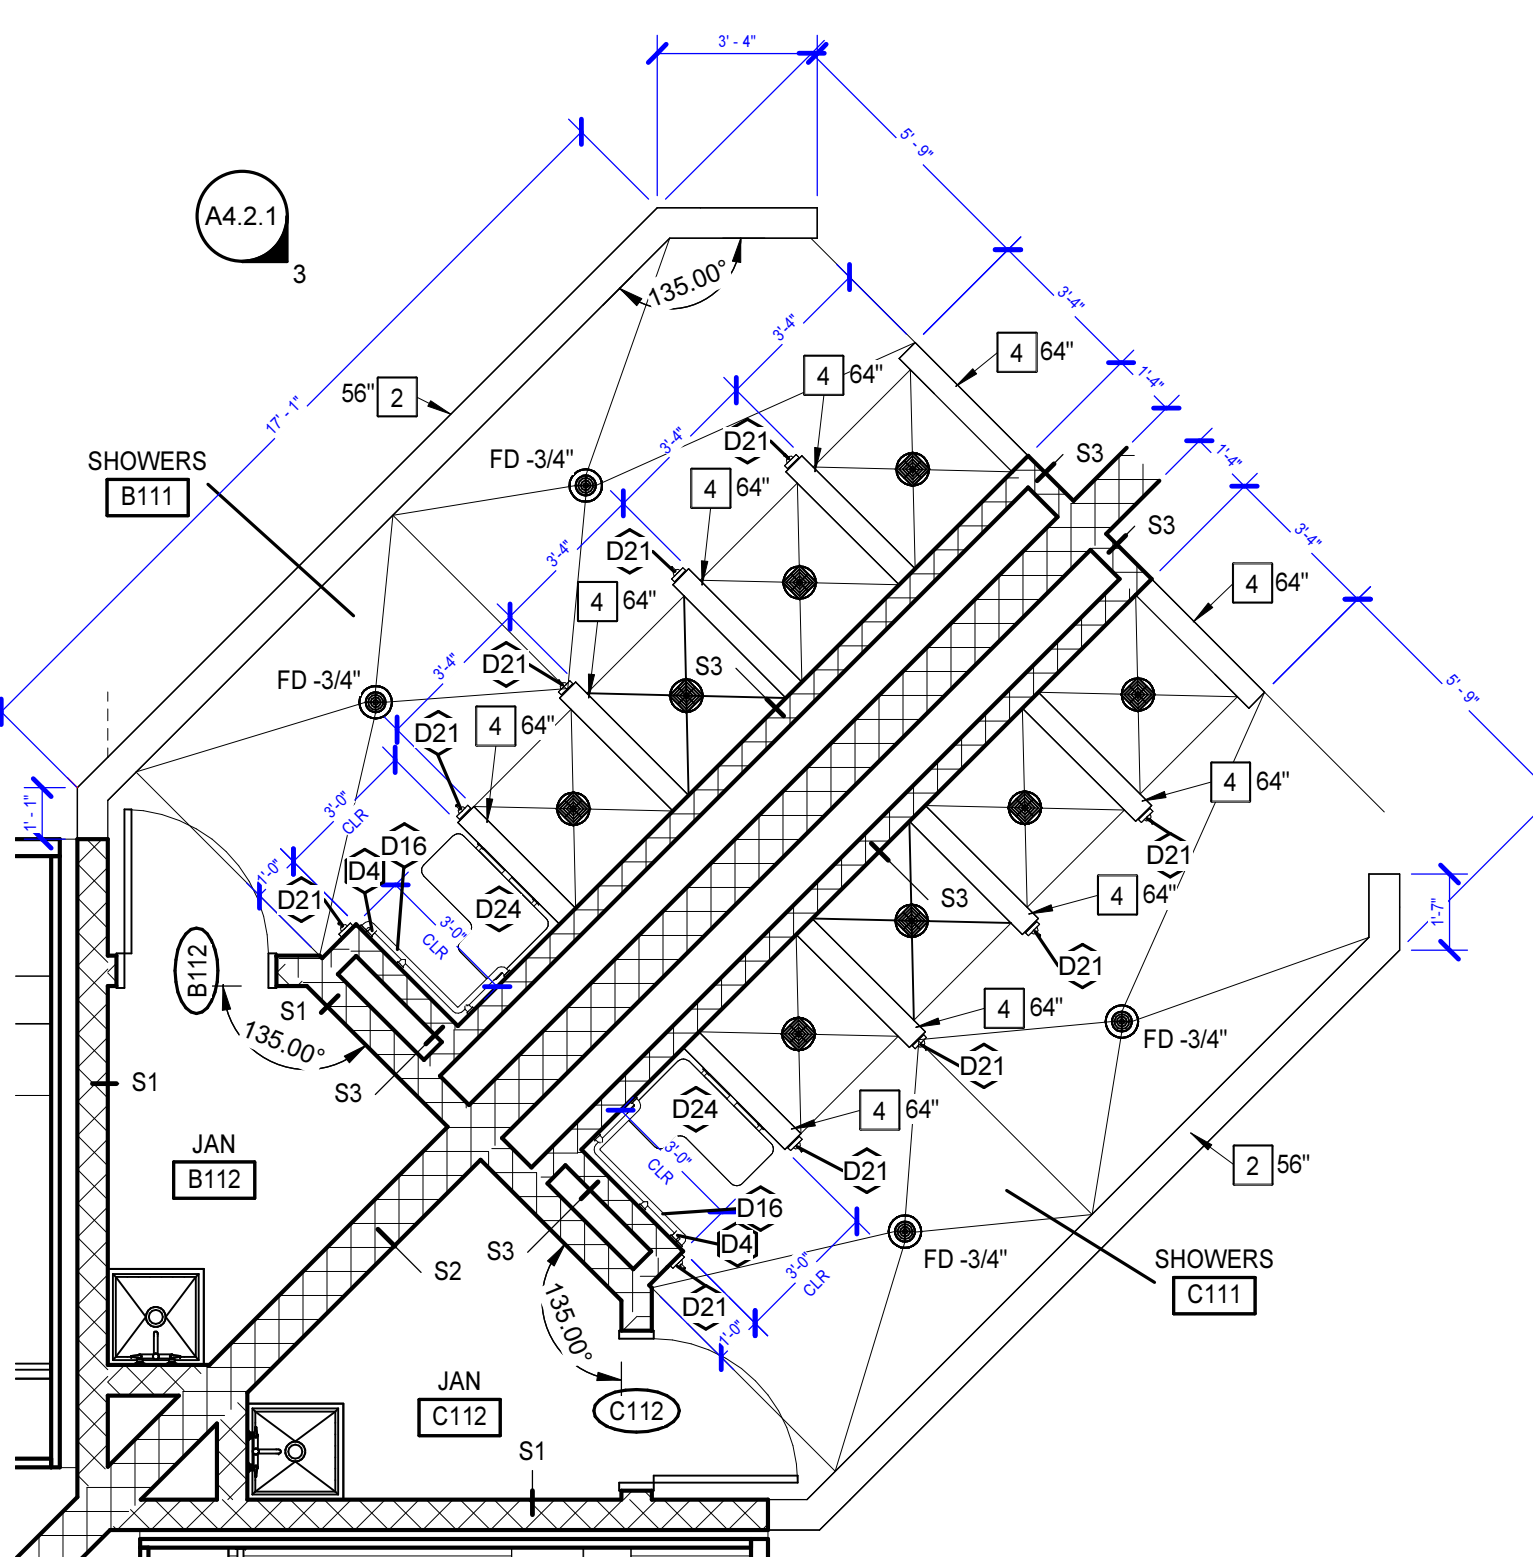


4 ENLARGED PLAN
A2.1.2/A7.1.2 1/4" = 1'-0"

ENLARGED PLAN GENERAL NOTES


- PROVIDE CORNER GUARDS AT ALL EXPOSED OUTSIDE GYP. BOARD CORNERS, REF. SPECS.
- PROVIDE CONT. SILICONE CAULK AT ALL DOOR FRAMES WHERE GYP. BOARD AND FRAMES MEET BEFORE PAINTING OCCURS.
- PROVIDE PAINTED METAL FINISH ON ALL CEILING AND WALL ACCESS PANELS FOR ACCESS TO MECHANICAL, ELECTRICAL, AND PLUMBING SPACES.
- "MIN." FOR DIMENSIONS INDICATED MINIMUM ACCEPTABLE DIMENSION. IF "MIN." DIMENSIONS FALL SHORT OF WHAT IS SHOWN ON DRAWINGS, I.C. IS TO NOTIFY THE ARCHITECT IMMEDIATELY SO AS TO NOT DELAY THE PROJECT.

ENLARGED PLAN KEYNOTES
APPLIES TO DRAWINGS A7.1.2 REPRESENTED BY [n]


- CONCRETE BENCH. REFER TO DETAIL 12/A7.1.2
- CMU LOW WALL PER DETAIL 1/A5.2.1
- MOTORIZED ROLL-UP PRIVACY SHUTTER AT FEMALE HOUSING ONLY
- CMU LOW WALL PER DETAIL 2/A5.2.1
- CUBICLE CURTAIN AND TRACK
- PASS-THRU EVIDENCE LOCKERS

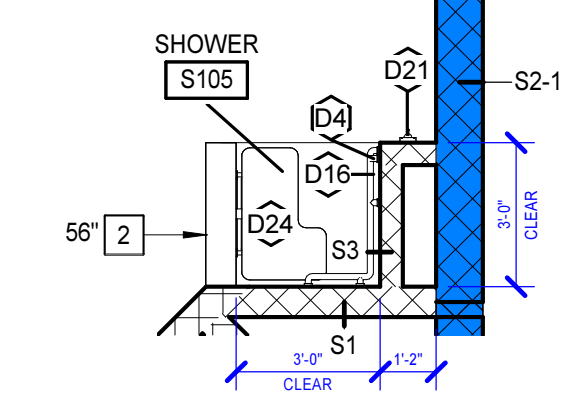


6 ENLARGED PLAN
A2.1.2/A7.1.2 1/4" = 1'-0"

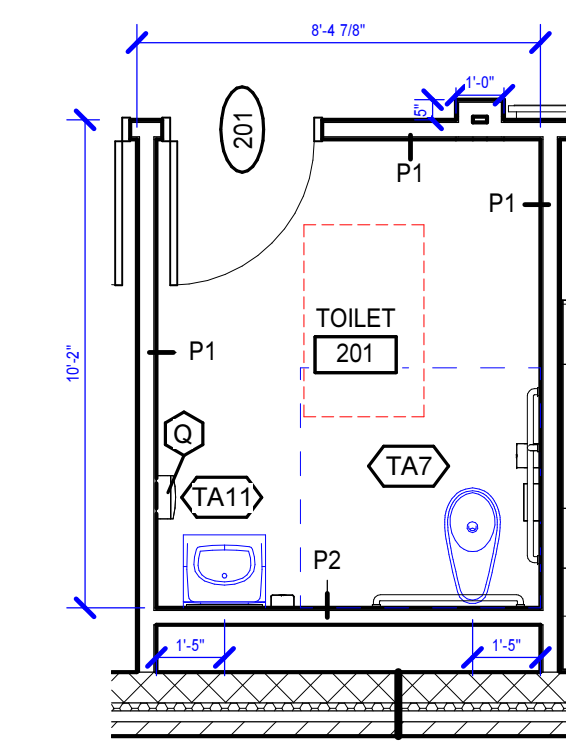

3 ENLARGED PLAN
A2.1.7/A7.1.2 1/4" = 1'-0"

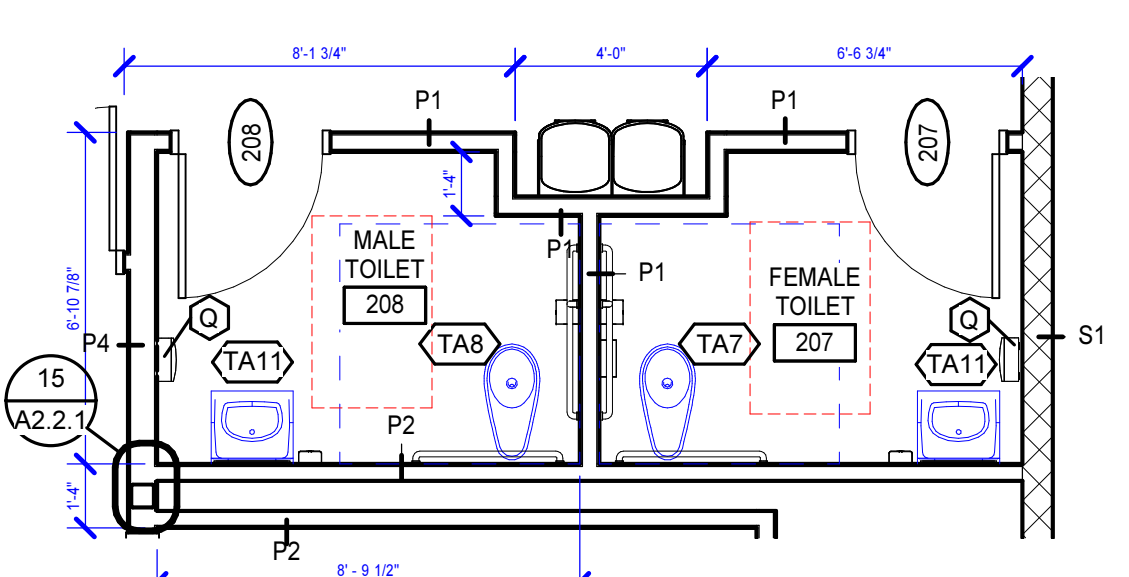

2 ENLARGED PLAN
A2.1.7/A7.1.2 1/4" = 1'-0"

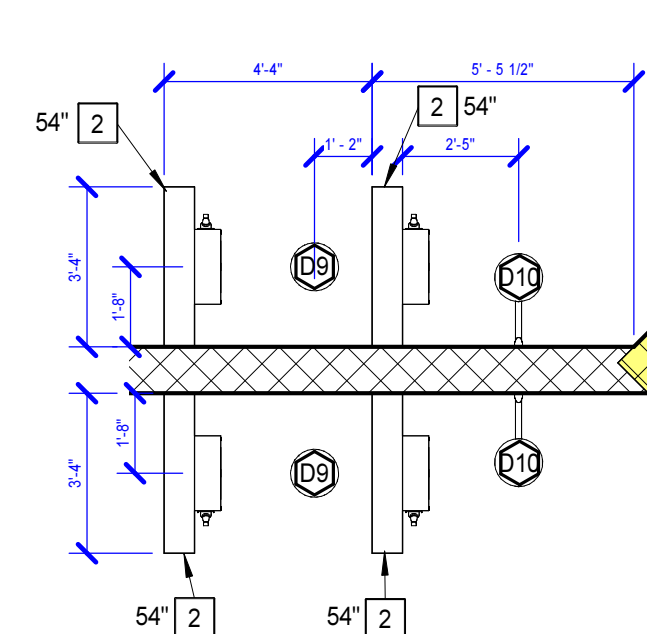

1 ENLARGED PLAN
A2.1.2/A7.1.2 1/4" = 1'-0"

MOSELEY ARCHITECTS
6210 ARDREY KELL ROAD - THE HUB AT WAWERLY, SUITE 425 - CHARLOTTE, NC 28277
PHONE (704) 540-3155 FAX (704) 540-3154
MOSELEYARCHITECTS.COM

STEVEN J. HOPKINS
11547
ARCHITECT
NORTH CAROLINA
CHARLOTTE, NC
01/15/24

MOSELEY ARCHITECTS
CORPORATION
50149
ARCHITECT
NORTH CAROLINA
CHARLOTTE, NC

PENDER COUNTY LEC
DHSR# J-368 / FID# 220537
PENDER COUNTY, NORTH CAROLINA
1417 OLD SAVANNAH ROAD BURGAW, NC

PROJECT NO: 811888
DATE: 06/12/24


DATE	REVISIONS	DESCRIPTION
06/12/24	AD-03	

ENLARGED PLANS


A7.1.2

6/10/2024 1:56:27 PM


3 WAREHOUSE - ENLARGED DETAIL
A7.1.9 | A7.1.9 | 1/1/2" = 1'-0"

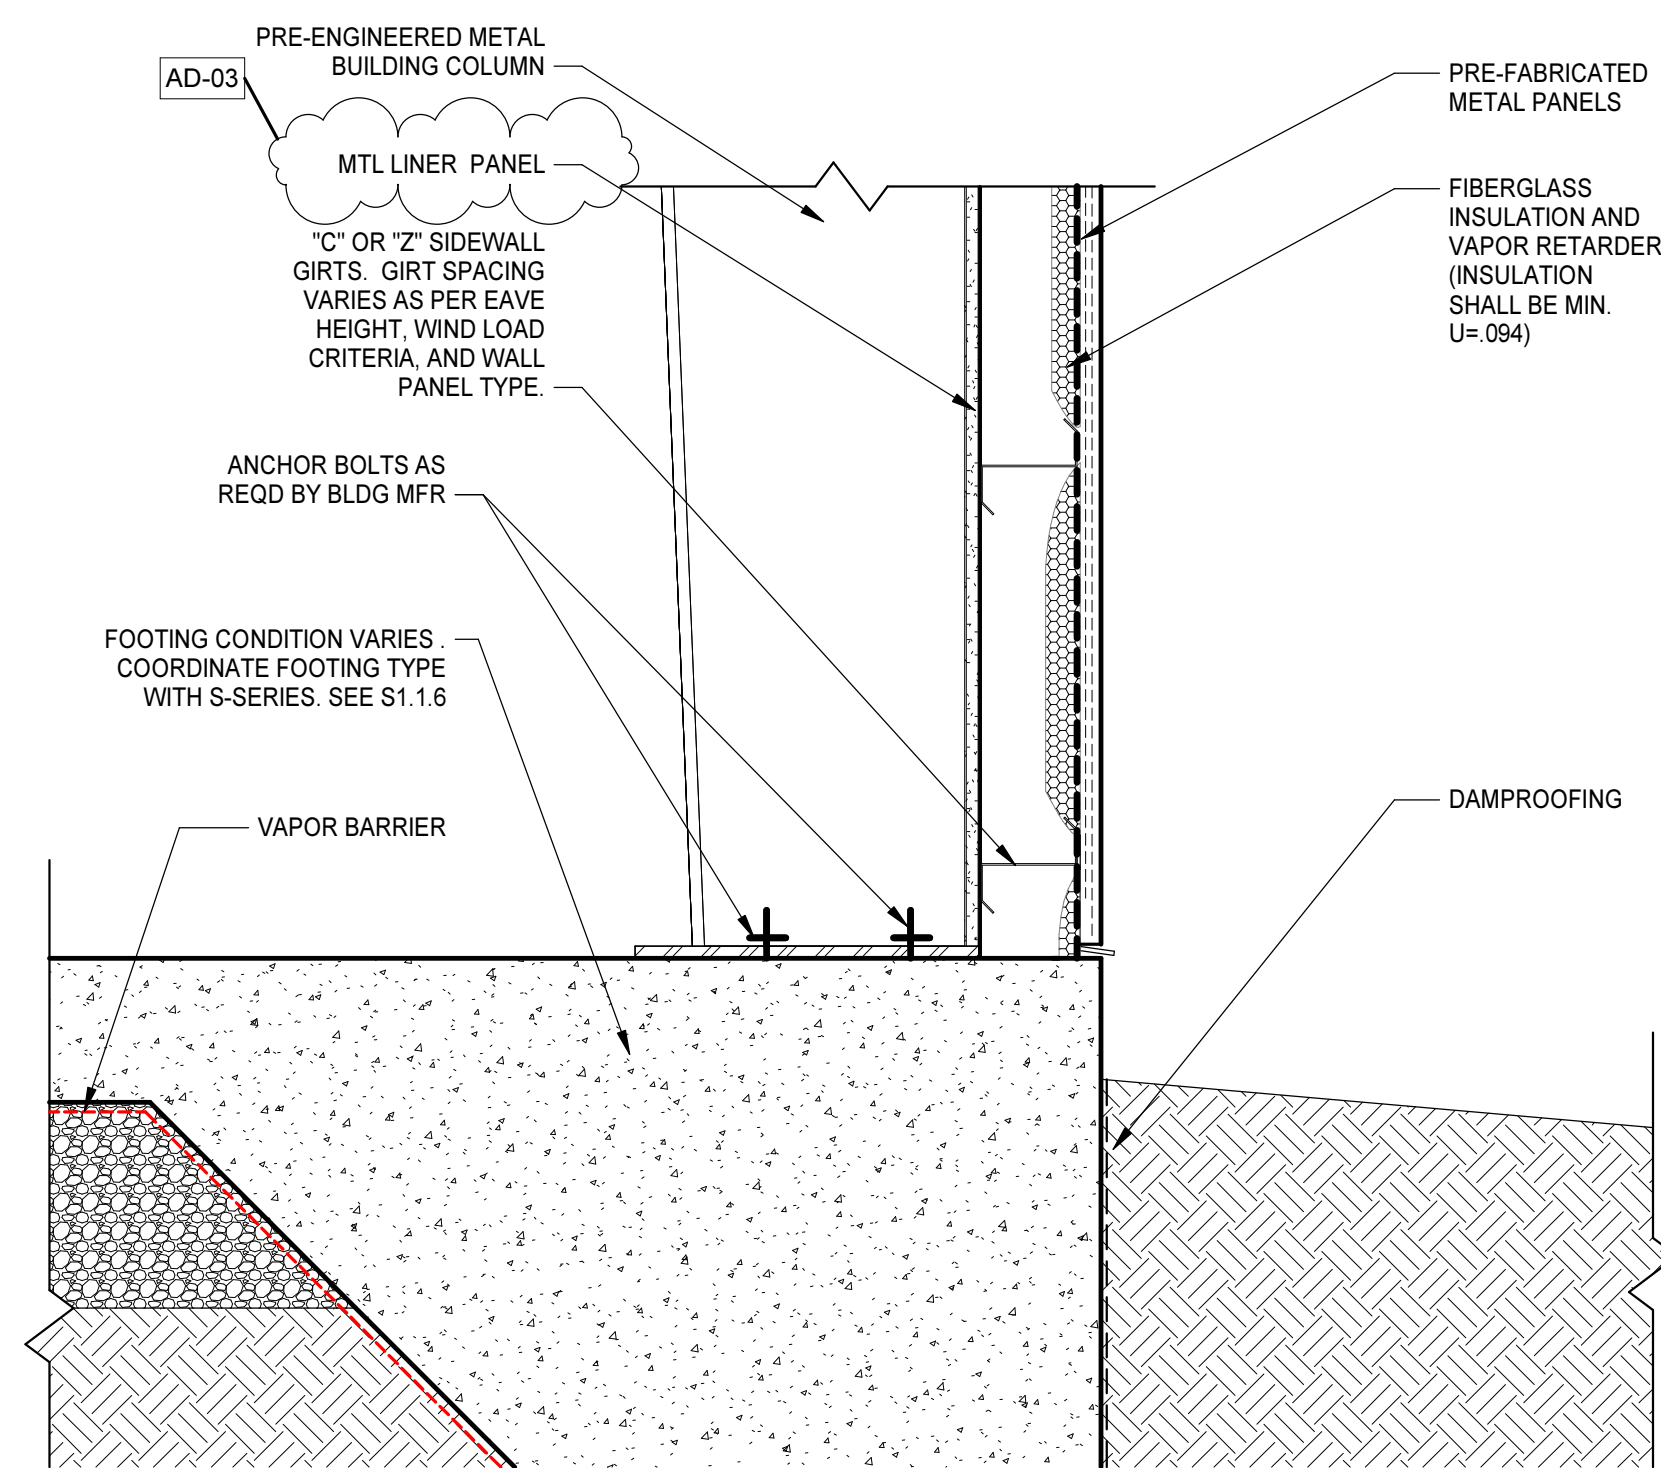


2 WAREHOUSE EXTERIOR WALL SECTION
A7.1.8 | A7.1.9 | 3/4" = 1'-0"

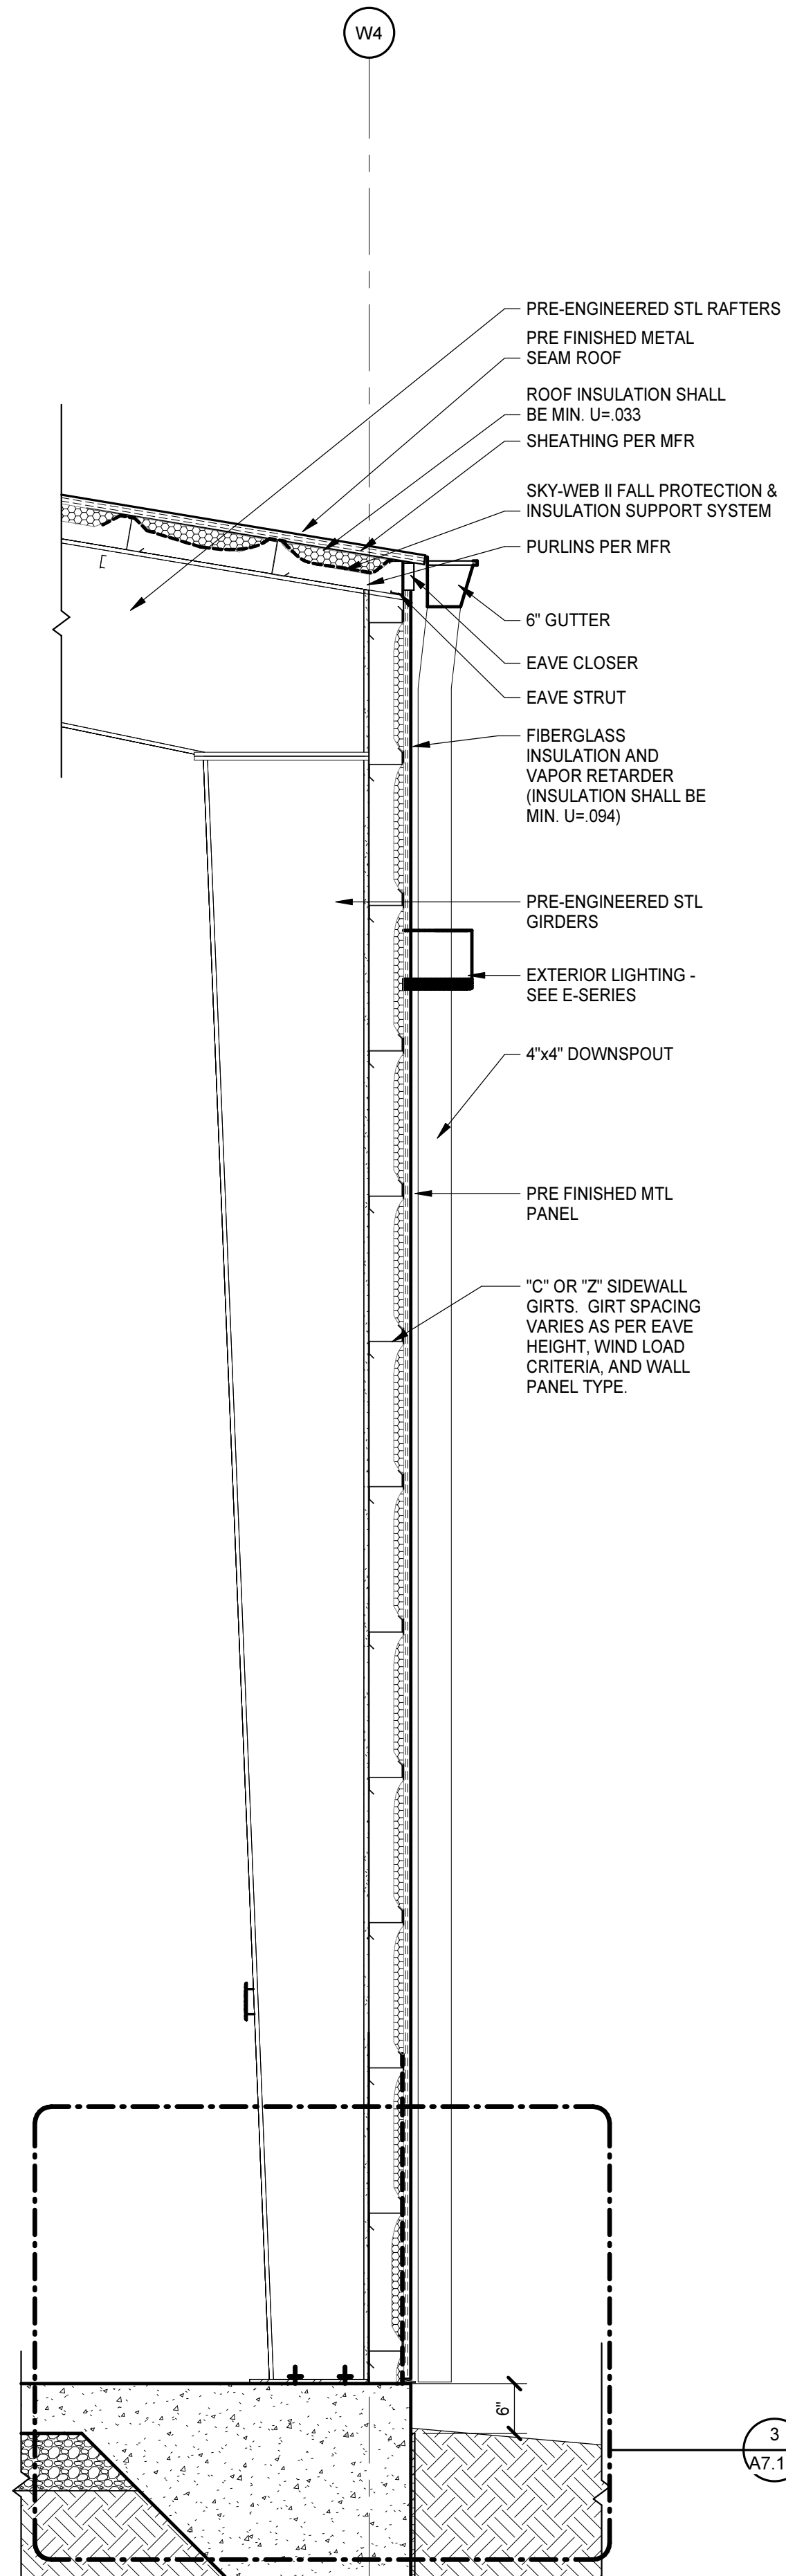




1 ROOF PLAN - WAREHOUSE
A7.1.9 | 1/8" = 1'-0"

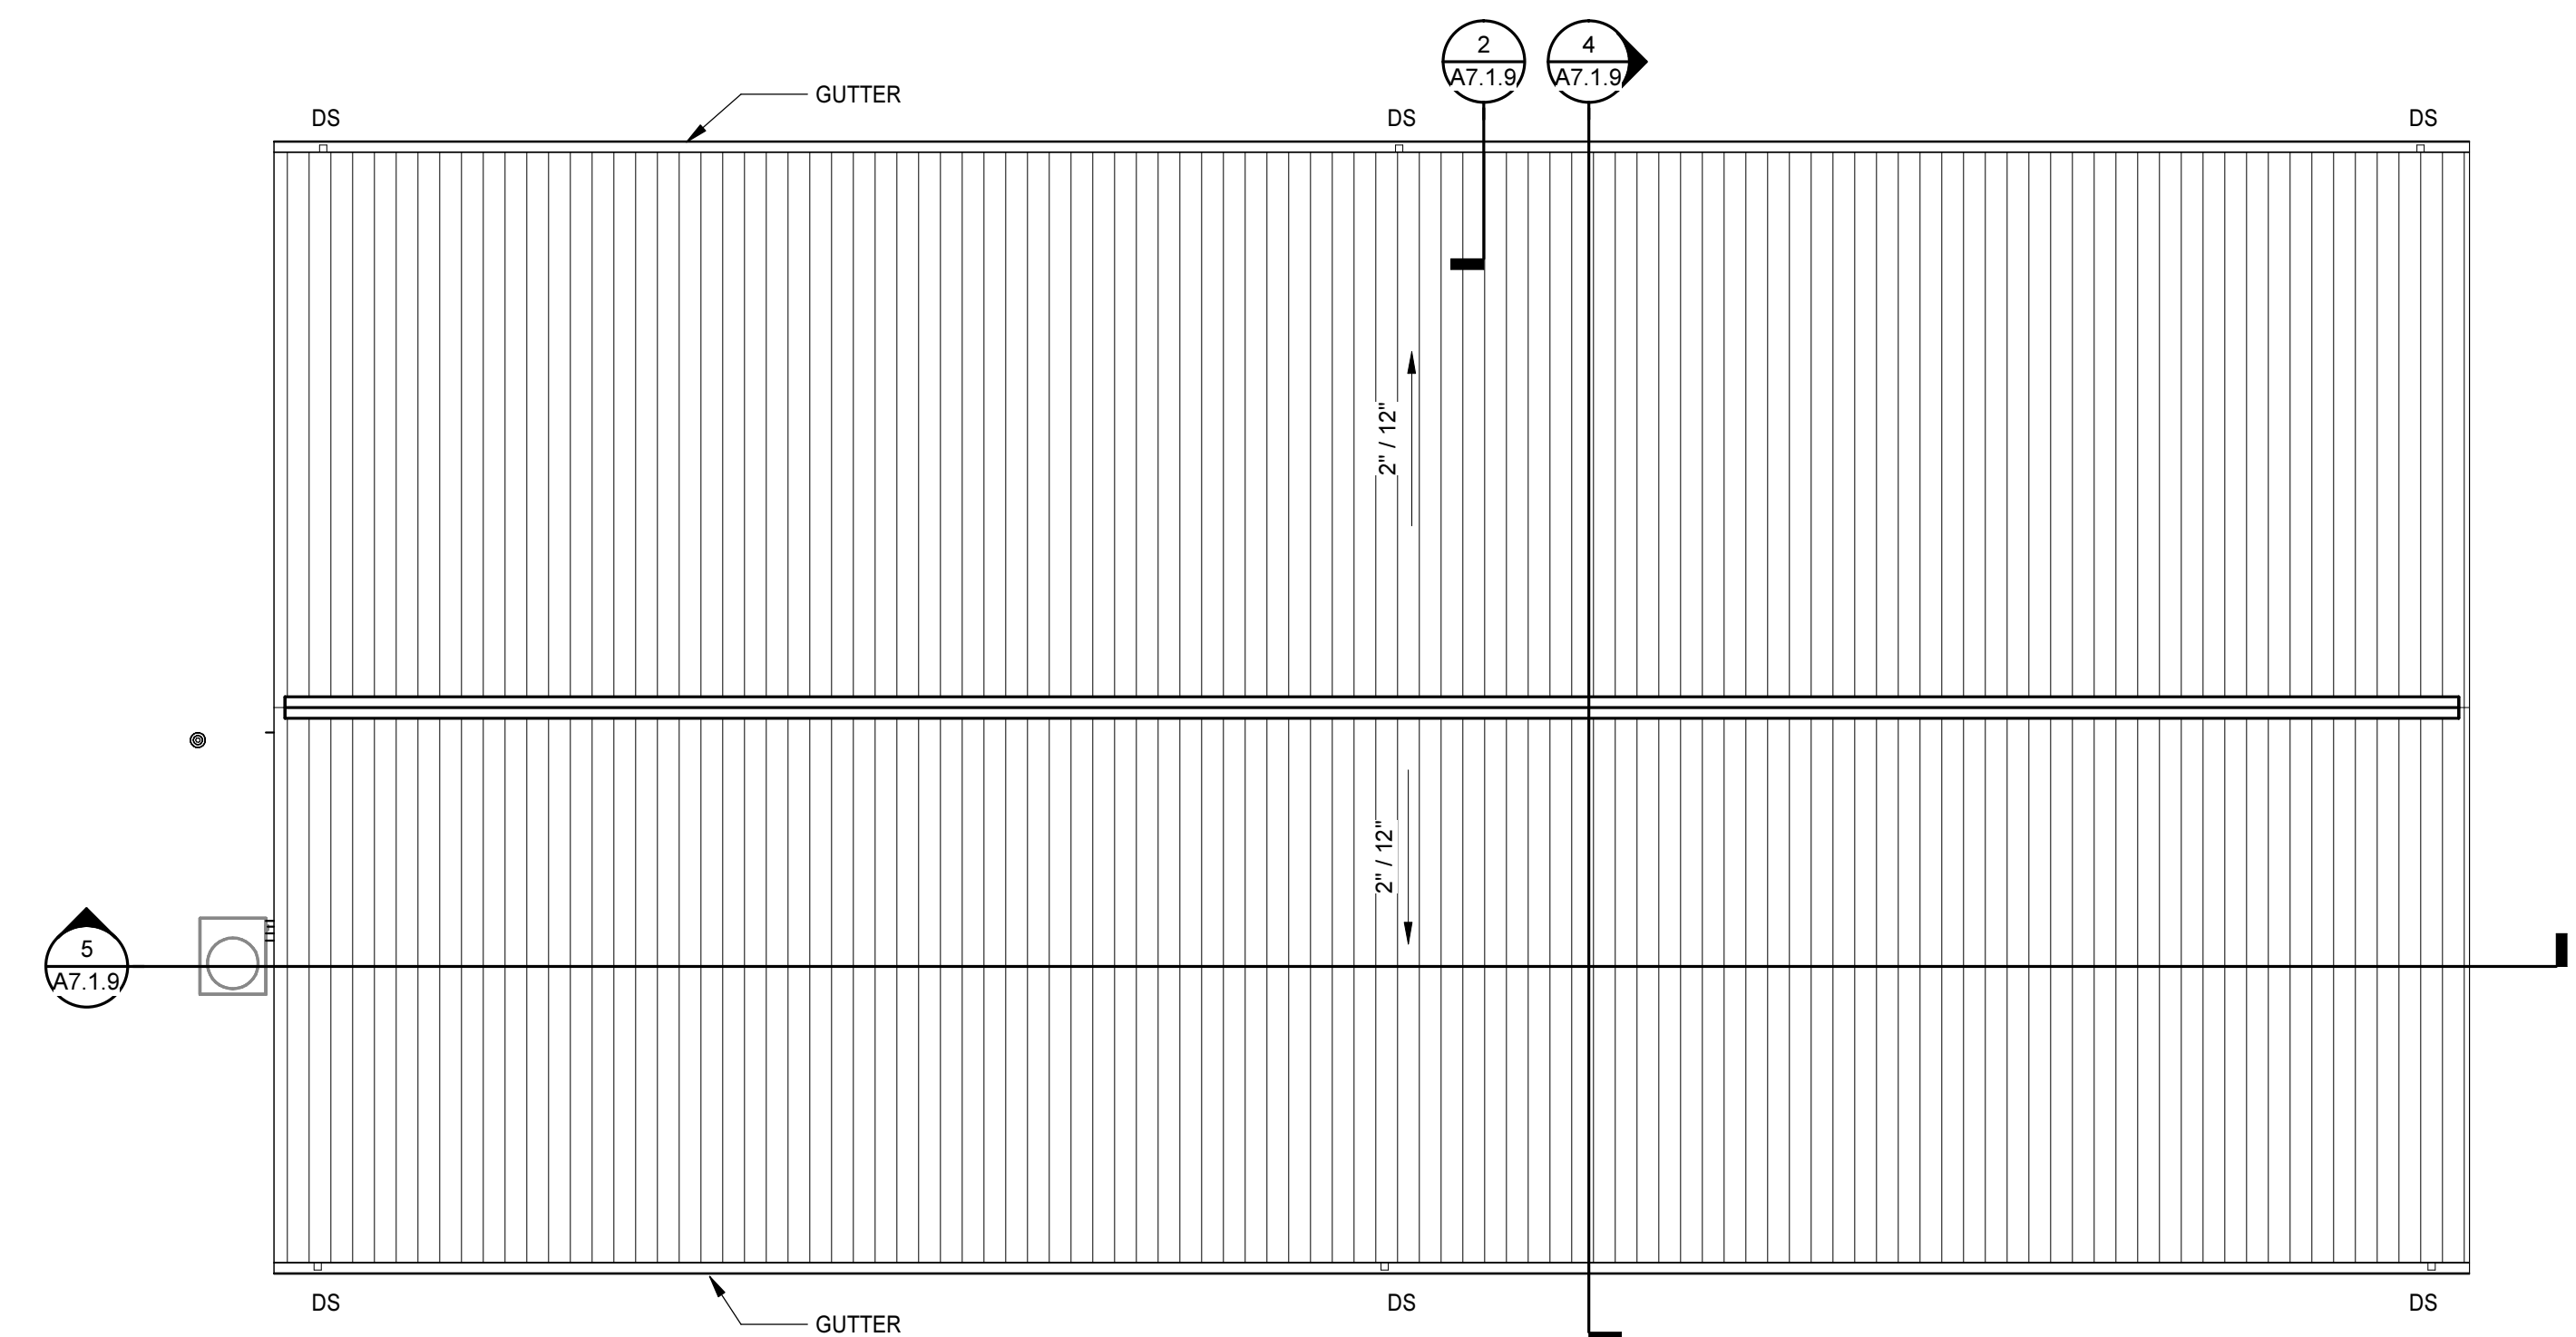


5 WAREHOUSE SECTION 2
A7.1.8 | A7.1.9 | 1/8" = 1'-0"

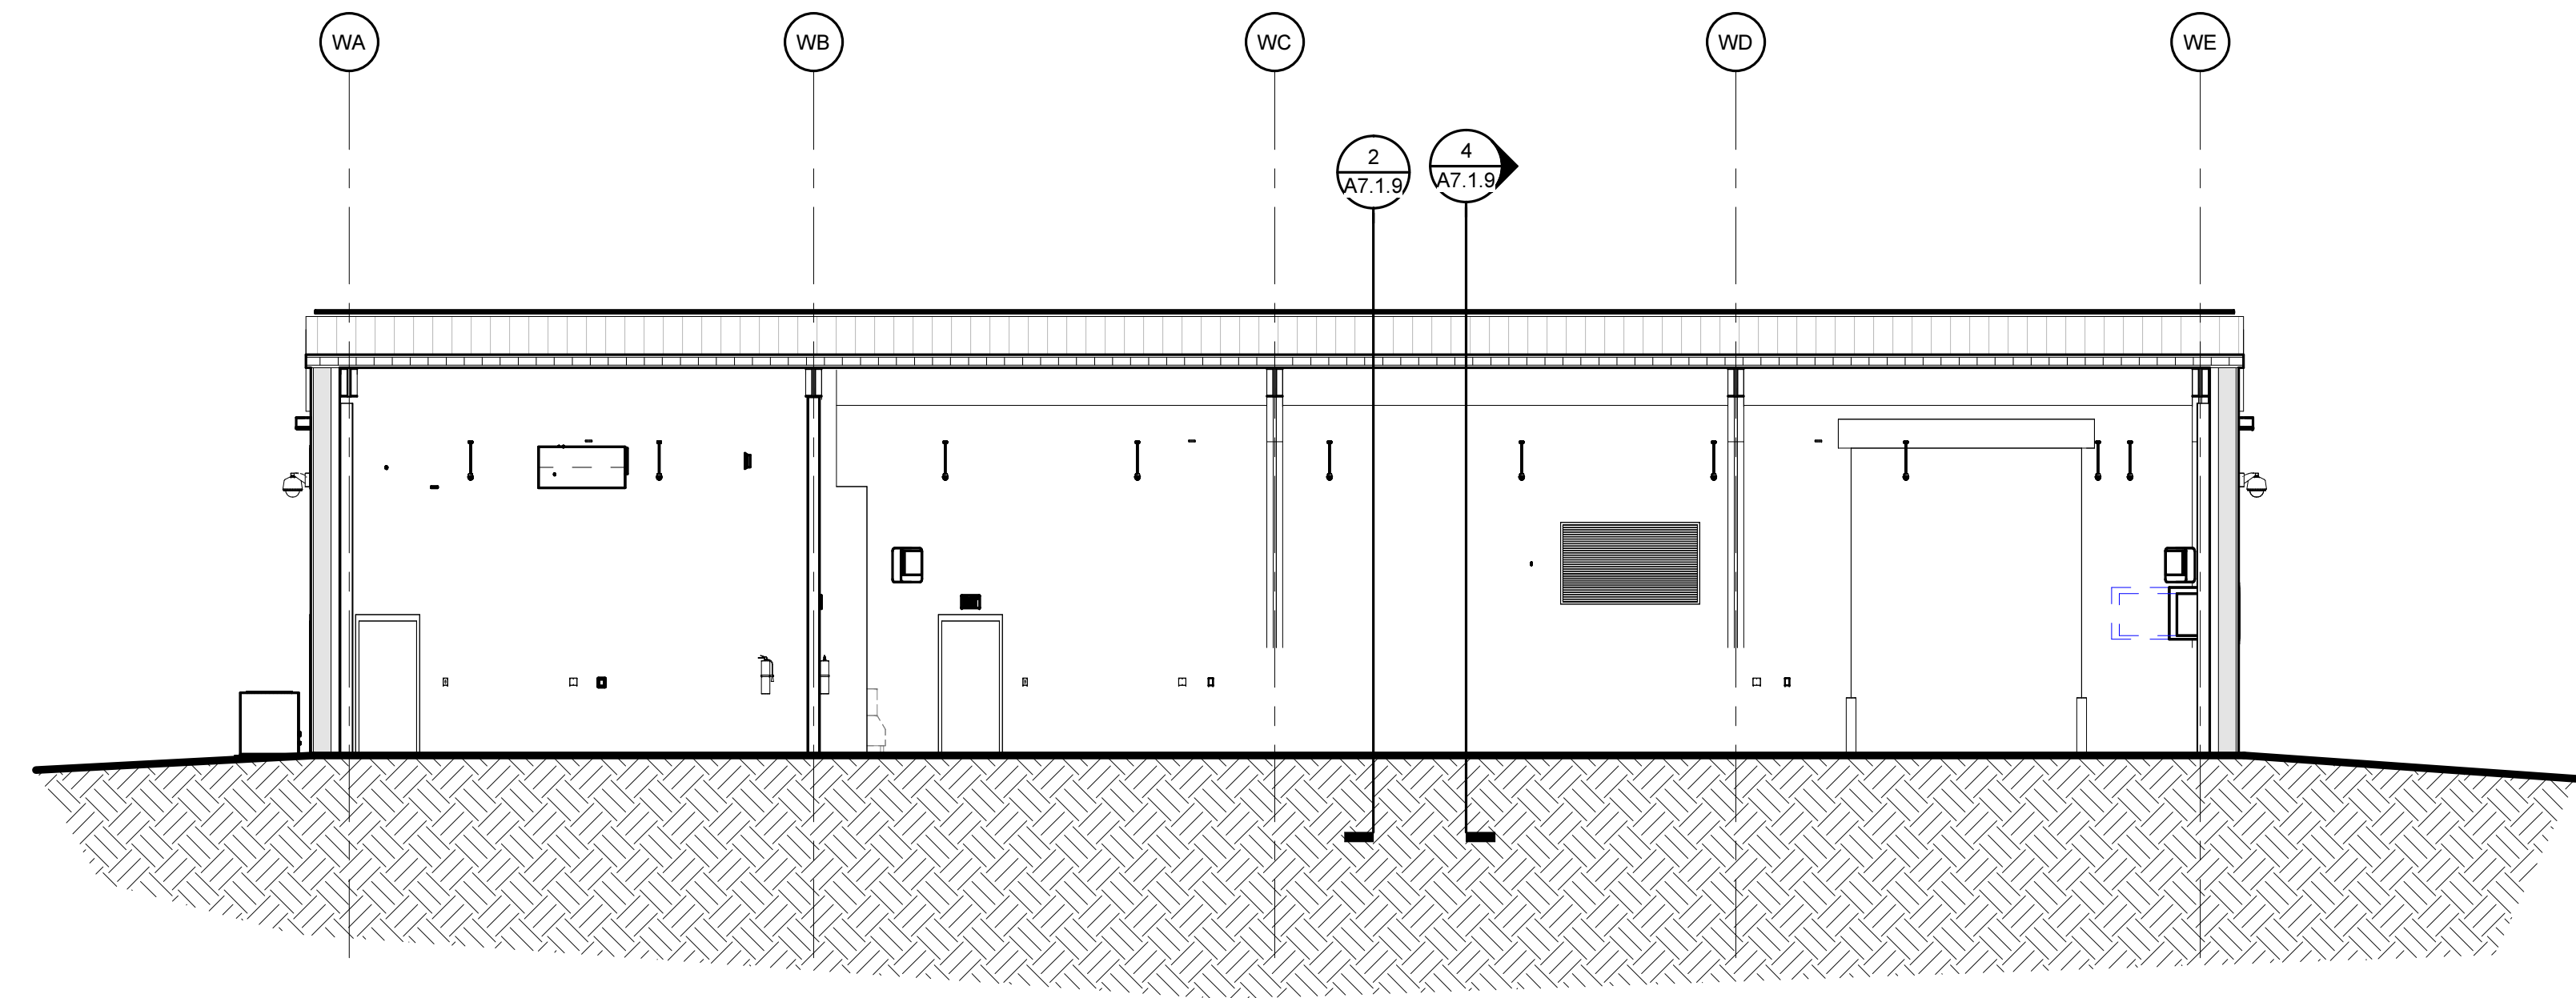

4 WAREHOUSE SECTION 1
A7.1.8 | A7.1.9 | 1/8" = 1'-0"


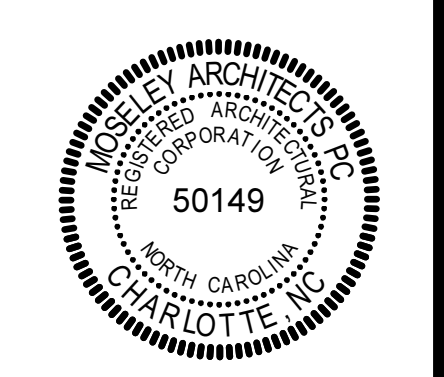
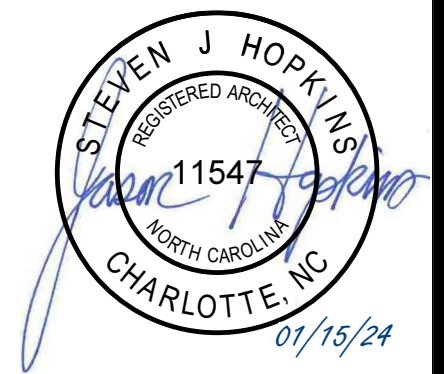
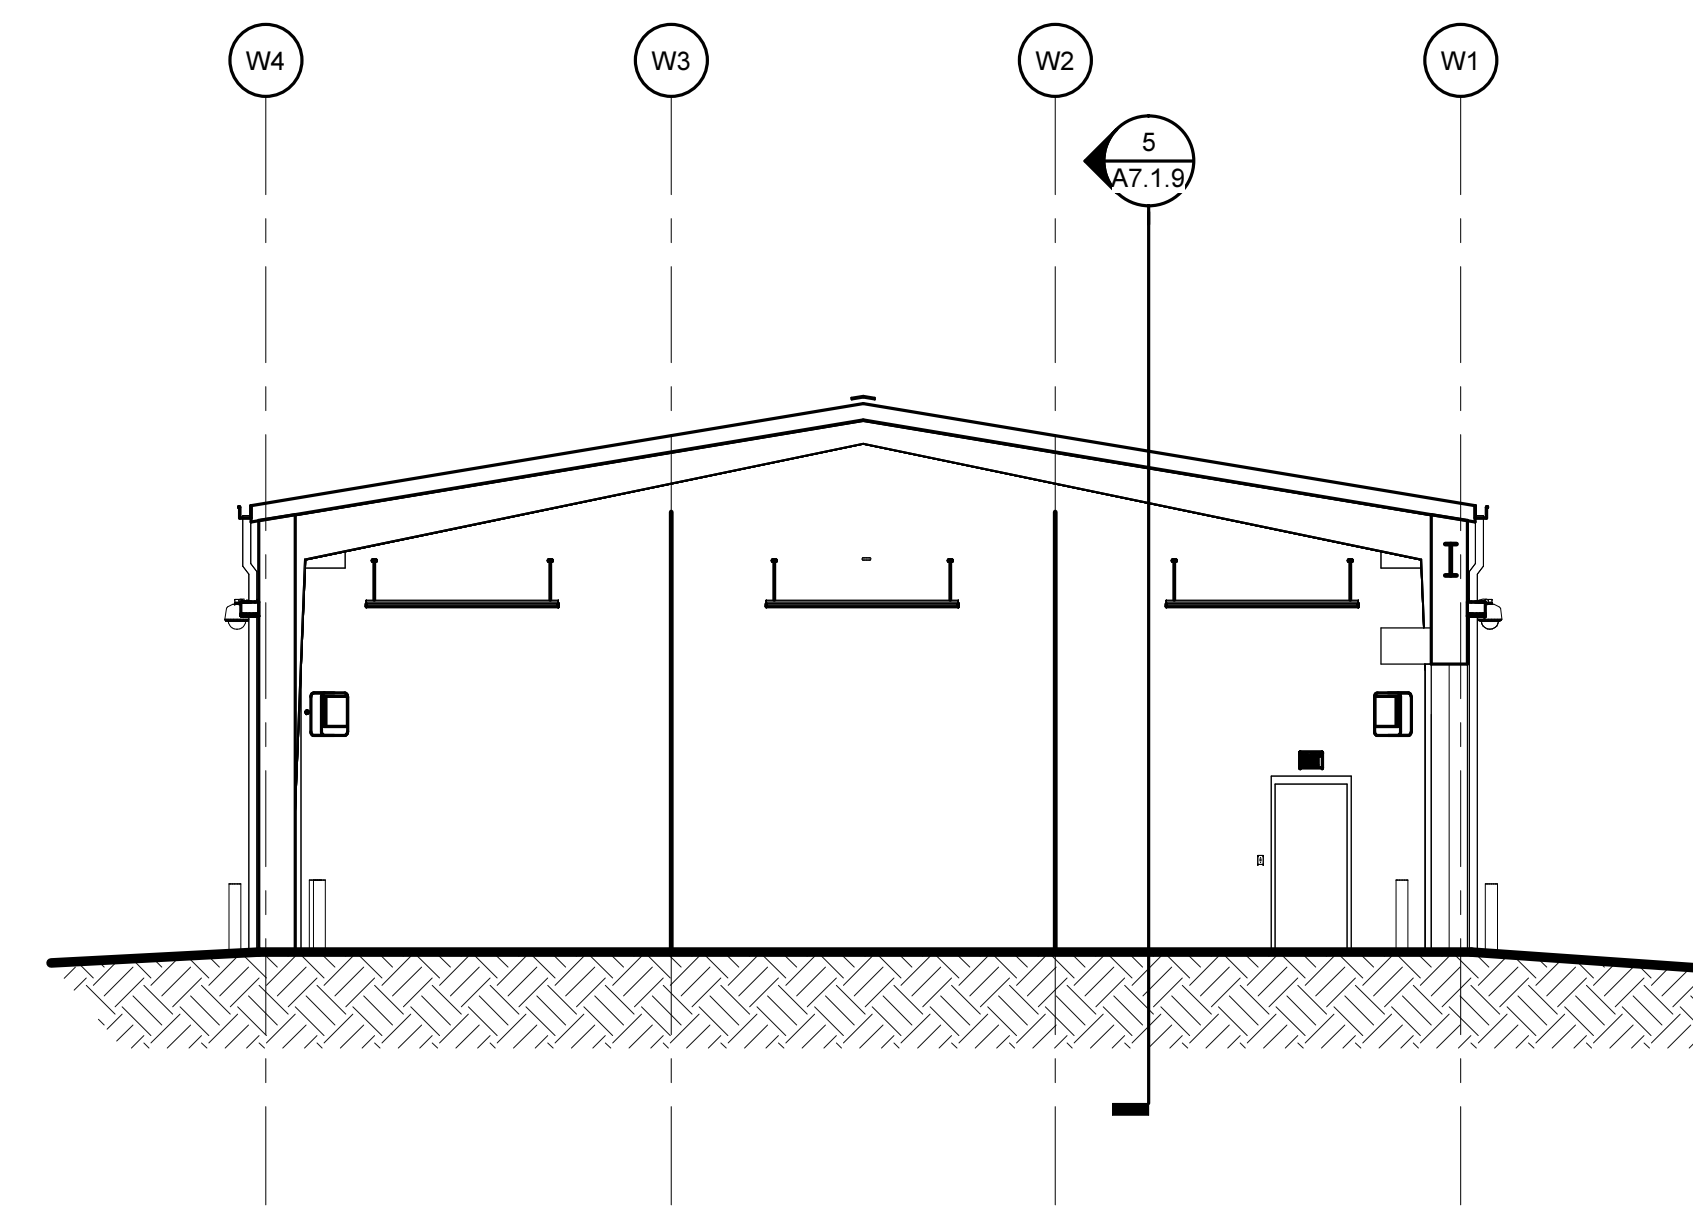


PROJECT NO:	611888
DATE:	06/10/2024
REVISIONS	
DATE	DESCRIPTION
06/12/24	AD-03

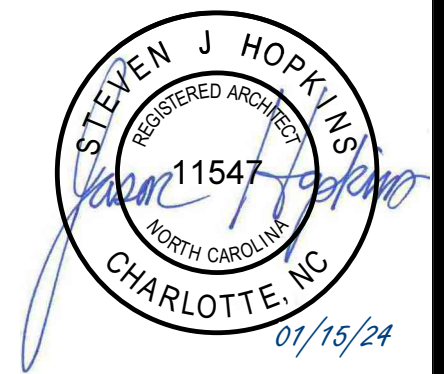

CASEWORK GENERAL NOTES	
A.	UNLESS INDICATED OTHERWISE, ALL COUNTERTOPS: • 2'-10" AFF OR 2'-10" TO TOP OF RIM AT DROP-IN SINKS AND LAVATORIES WHERE OCCURS • 2'-1" DEEP • SOLID SURFACE • BACKSPASHES: 4' HIGH AT ALL SIDES AND BACK
B.	UNLESS INDICATED OTHERWISE, ALL BASE CABINET(S): • 2'-0" DEEP NOMINAL • TOE KICKS: 4" HIGH AND 3" DEEP • SINK LOCATIONS: 3'-0" WIDE CLEAR KNEE SPACE (NO BASE CABINET) FOR BARRIER FREE ACCESS
C.	UNLESS INDICATED OTHERWISE, ALL WALL CABINET(S): • 1'-0" DEEP NOMINAL • 2'-6" HIGH • TOP AT 7'-0" AFF
D.	BUILT-IN EQUIPMENT: SIZE OPENING (HEIGHT, WIDTH AND DEPTH) AND ROUGH-IN REQUIREMENTS AS REQUIRED BASED ON APPROVED MANUFACTURER SUBMITTED.
E.	ALL SHELVES: ADJUSTABLE UNLESS INDICATED OTHERWISE
F.	PROVIDE FINISH END PANELS AT ALL EXPOSED CASEWORK ENDS
G.	LOCKS: PROVIDE AT BOOKING DESK IP108, NURSE M101, PHARMACY M102, AND EXAM M104. UNLESS INDICATED OTHERWISE
H.	PAINT UNDERCOUNTER SUPPORT BRACKETS TO MATCH WALL
I.	ELEVATION TAGS BEGINNING WITH '10' INDICATES DETENTION CASEWORK
J.	PROVIDE FULL BULLNOSE EDGE AND 2" RADIUS CORNERS FOR DETENTION CASEWORK SSM COUNTERTOPS
K.	PROVIDE UNDERCOUNTER WIRE MANAGEMENT AT COUNTERTOPS WITH GROMMETS



CASEWORK KEYNOTES	
REPRESENTED BY []	
APPLIES TO DRAWINGS AB.1.1-AB.1.2	
1	PACKAGE PASS - REFER TO DETAIL ON DRAWING A7.2.1. AD-03
2	OPEN KNEE SPACE - PROVIDE UNDERCOUNTER SUPPORT BRACKETS AS INDICATED IN SPECIFICATION 064100
3	COPIER (NIC)
4	GROMMET - COORDINATE LOCATION WITH OWNER
5	MICROWAVE (NIC)
6	COFFEE MAKER (NIC)
7	UNDERCOUNTER REFRIGERATOR (NIC)
8	REMOVEABLE BARRIER-FREE PLAM PANEL
9	REFRIGERATOR (NIC)
10	OPEN CABINET
11	SHREDDER (NIC)
12	ICE MACHINE (NIC)
13	VENDING MACHINE (NIC)
14	EYE WASH
15	OPEN MAIL SLOTS
16	FUME HOOD
17	ACCESSIBLE SINK CABINET WITH ATTACHED TOE KICK
18	CPU HOLDER
19	LABORATORY CASEWORK - REFER TO DIVISION 12 "WOOD LABORATORY CASEWORK"
20	32" DEEP COUNTERTOP
21	12" DEEP COUNTERTOP AD-03
22	OPEN KNEE SPACE - PROVIDE CONCEALED UNDERCOUNTER SUPPORT BRACKETS AS INDICATED IN SPECIFICATION 064100
23	18" DEEP COUNTERTOP
24	50" DEEP COUNTERTOP
25	SOLID SURFACE MATERIAL
26	UNDERCOUNTER UTILITY BRACE, PAINT TO MATCH WALL COLOR
27	TRANSACTION WINDOW
28	CONCEALED SUPPORT BRACKET
29	PROVIDE FINISHED END PANEL
30	ACIDS STORAGE CABINET
31	FLAMMABLES STORAGE CABINET
32	WATERFALL EDGE AD-03
33	PAPER PASS INTEGRAL TO WINDOW FRAME ASSEMBLY. REFER TO SPEC SECTION 06690 AD-03

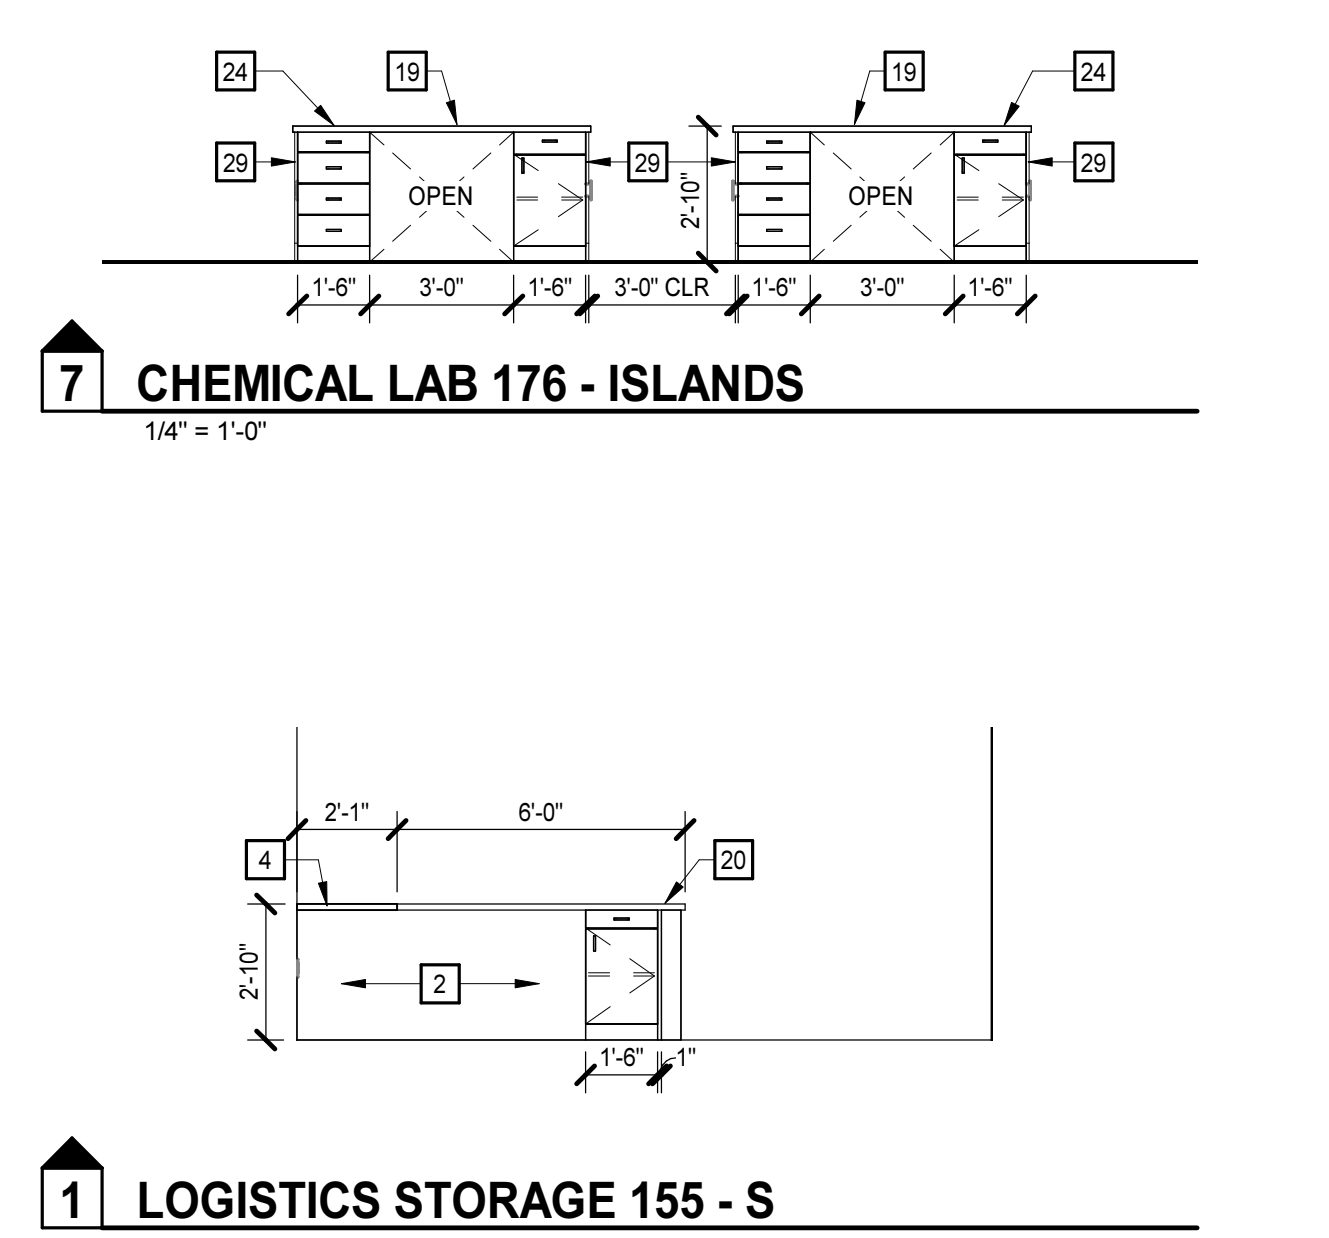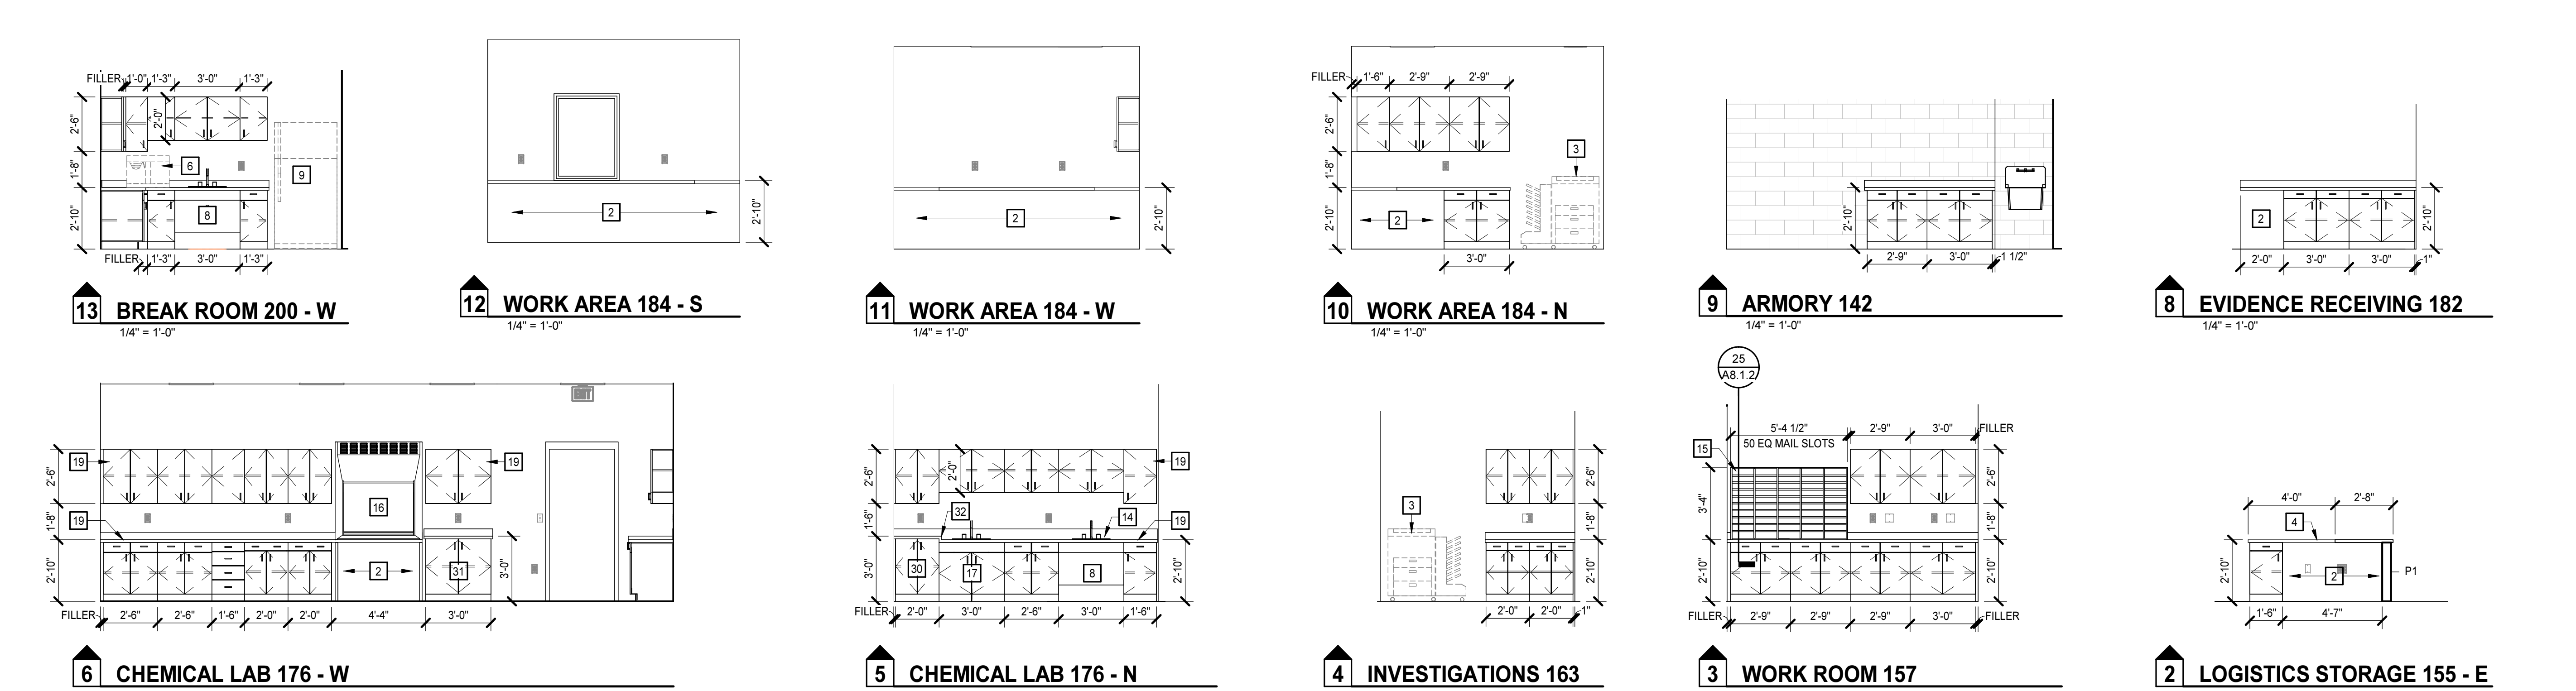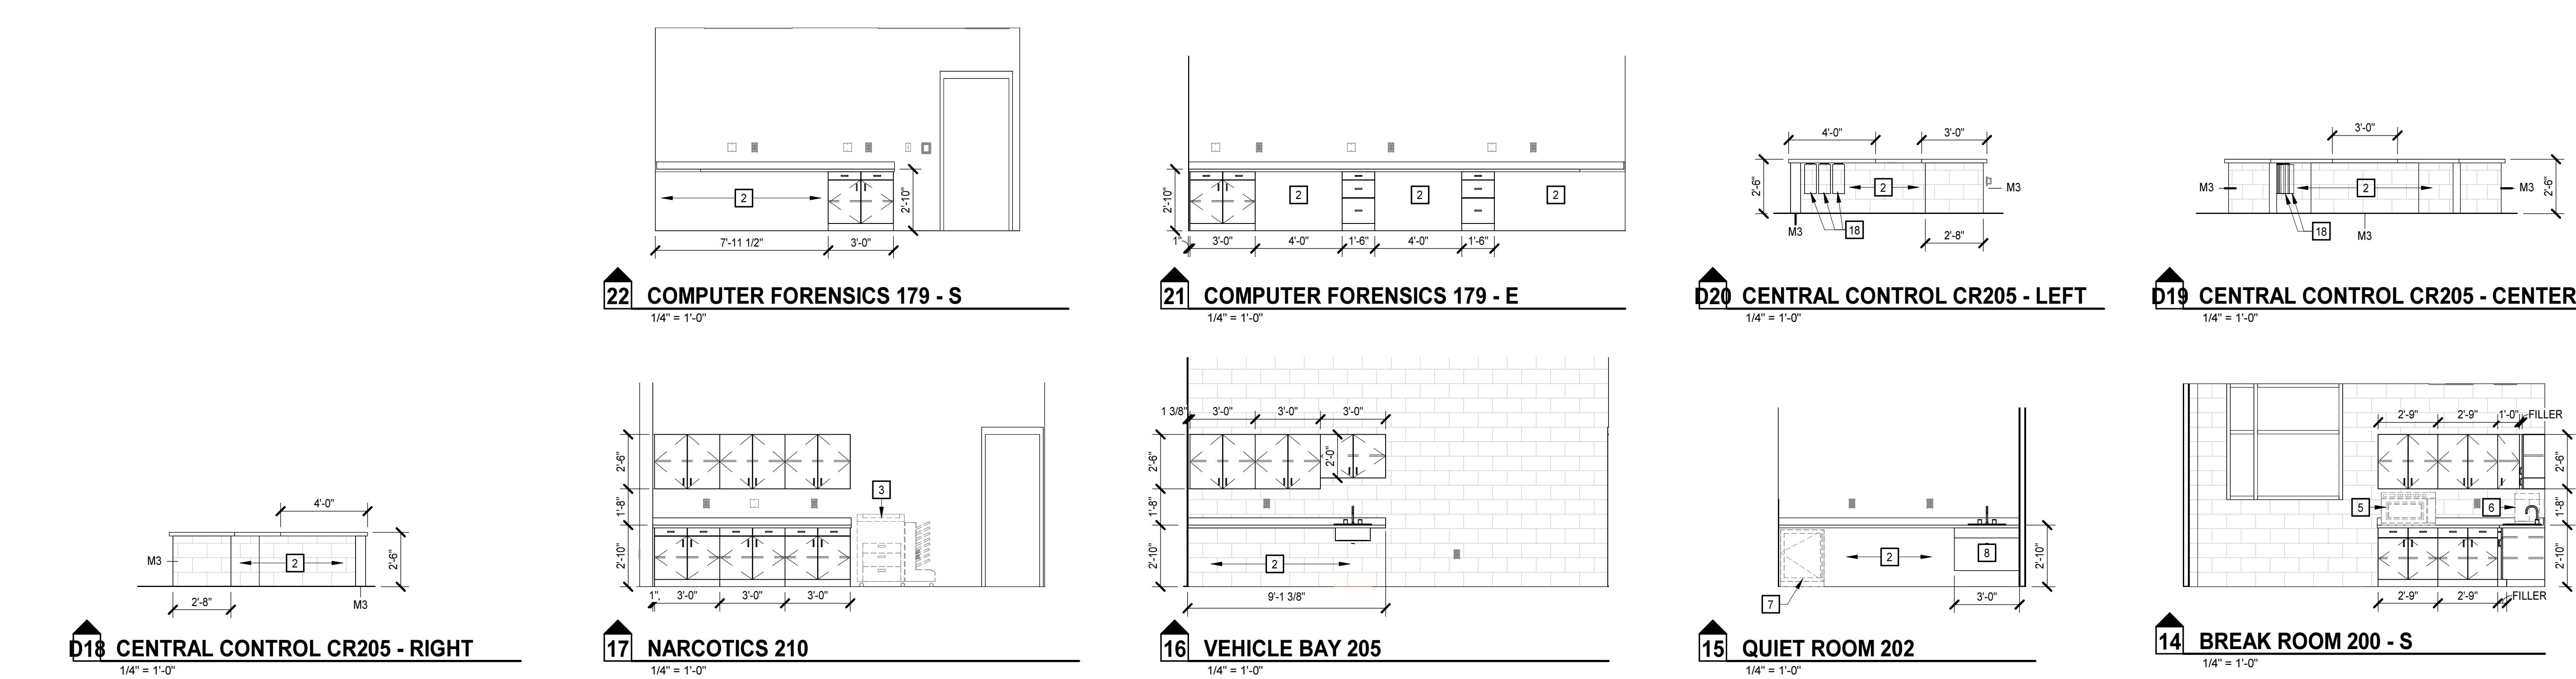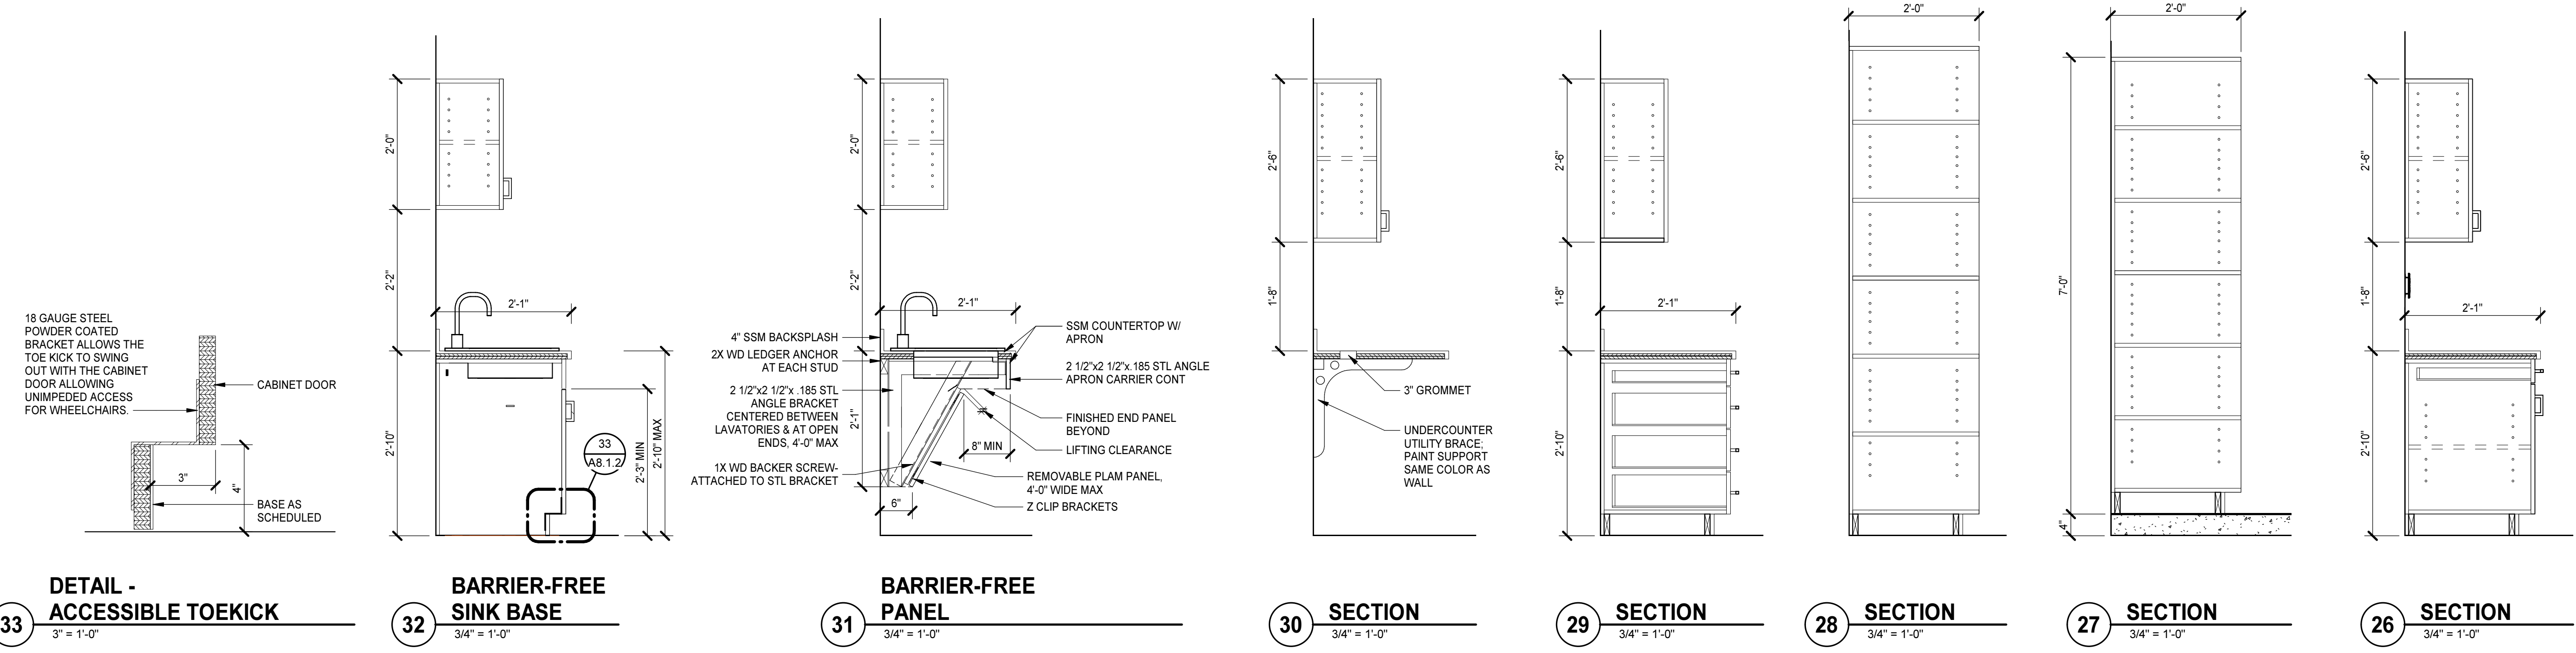


PENDER COUNTY LEC
 DHSR# J-368 / FID# 220537
 PENDER COUNTY, NORTH CAROLINA
 1417 OLD SAVANNAH ROAD BURGAW, NC

PROJECT NO:	611888
DATE:	06/01/2024
REVISIONS:	
DATE:	
DESCRIPTION:	


CASEWORK, ELEVATIONS, AND DETAILS

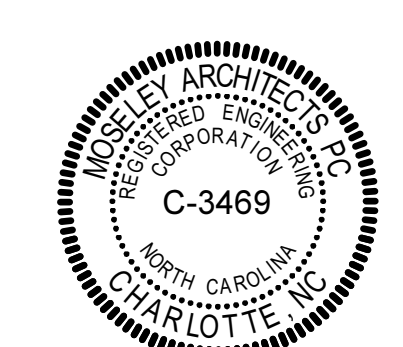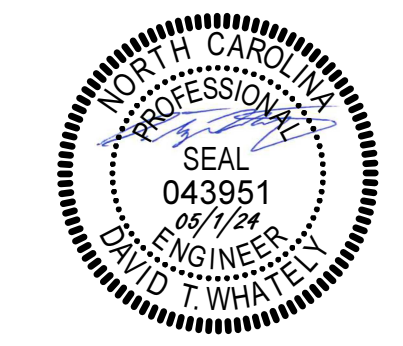


KEYNOTES	
APPLIES TO DRAWINGS P2.0.2	
REPRESENTED BY [N]	
1.	4" SAN INVERT ELEVATION AT -3' 1" BFF. REFER TO CIVIL FOR CONTINUATION.
2.	SANITARY UP TO GROUND CLEANOUT.
3.	SANITARY UP TO FLOOR CLEANOUT.
4.	3" SAN PTRAP-UP TO FLOOR DRAIN.
5.	2" SAN PTRAP-UP TO SHOWER DRAIN.
6.	4" SAN-UP TO WATER CLOSET.
7.	2" SAN-UP TO LAVATORY.
8.	2" SAN-UP TO SINK.
9.	3" SAN PTRAP-UP TO MOP BASIN.
10.	SANITARY UP TO WALL CLEANOUT.
11.	4" SAN-UP TO PENAL COMBINATION FIXTURE.
12.	8" SD INVERT ELEVATION AT -3' 0" BFF. REFER TO CIVIL FOR CONTINUATION.
13.	8" SD INVERT ELEVATION AT -3' 0" BFF. REFER TO CIVIL FOR CONTINUATION.
14.	4" SD-UP TO AREA DRAIN.
15.	STORM DRAINAGE UP TO GROUND CLEANOUT.
16.	STORM DRAINAGE UP TO FLOOR CLEANOUT.
17.	3" SAN PTRAP-UP TO FLOOR SINK.
18.	3" SAN PTRAP-UP TO LAUNDRY TRENCH DRAIN.
19.	3" SD INVERT ELEVATION AT -2' 0" BFF. REFER TO CIVIL FOR CONTINUATION.
20.	REFER TO REC YARD A113 & B113 PLAN FOR CONTINUATION.
21.	REFER TO REC YARD E113 & F113 PLAN FOR CONTINUATION.

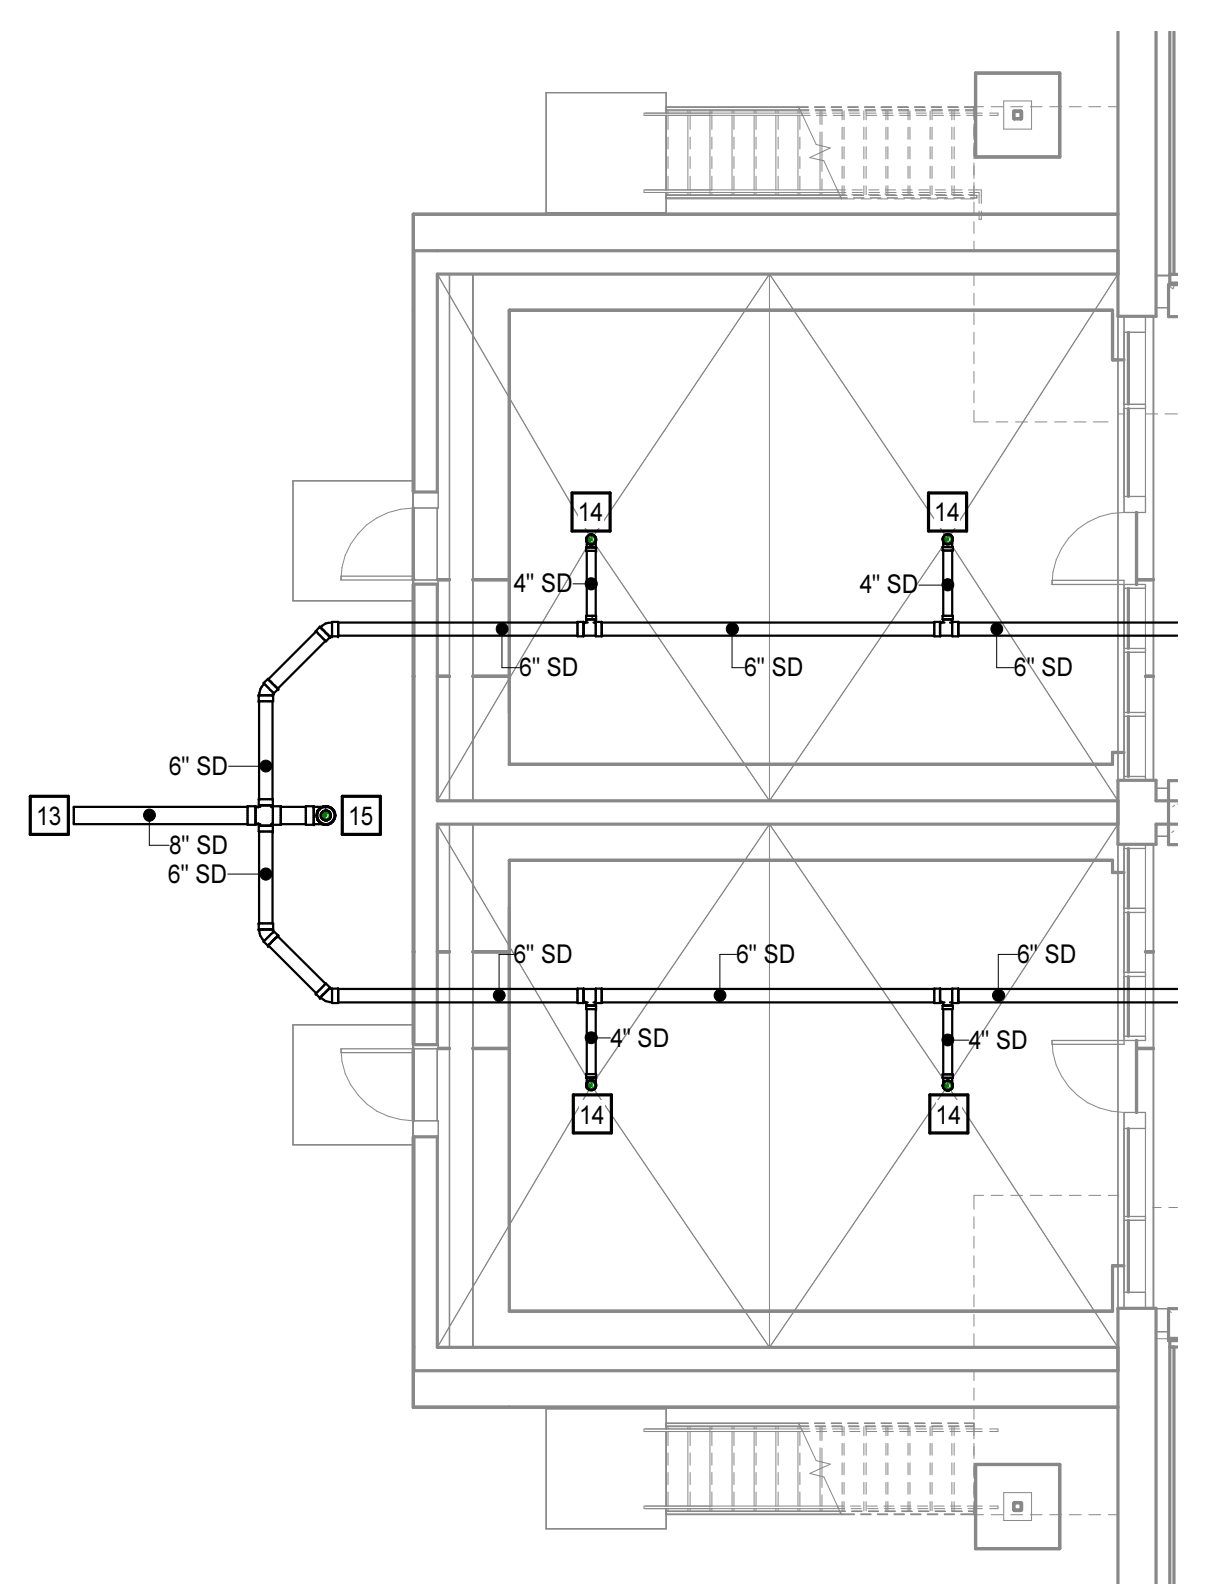



FOUNDATION PLAN - PART B - REC YARD A113 & B113
 1/8" = 1'-0"

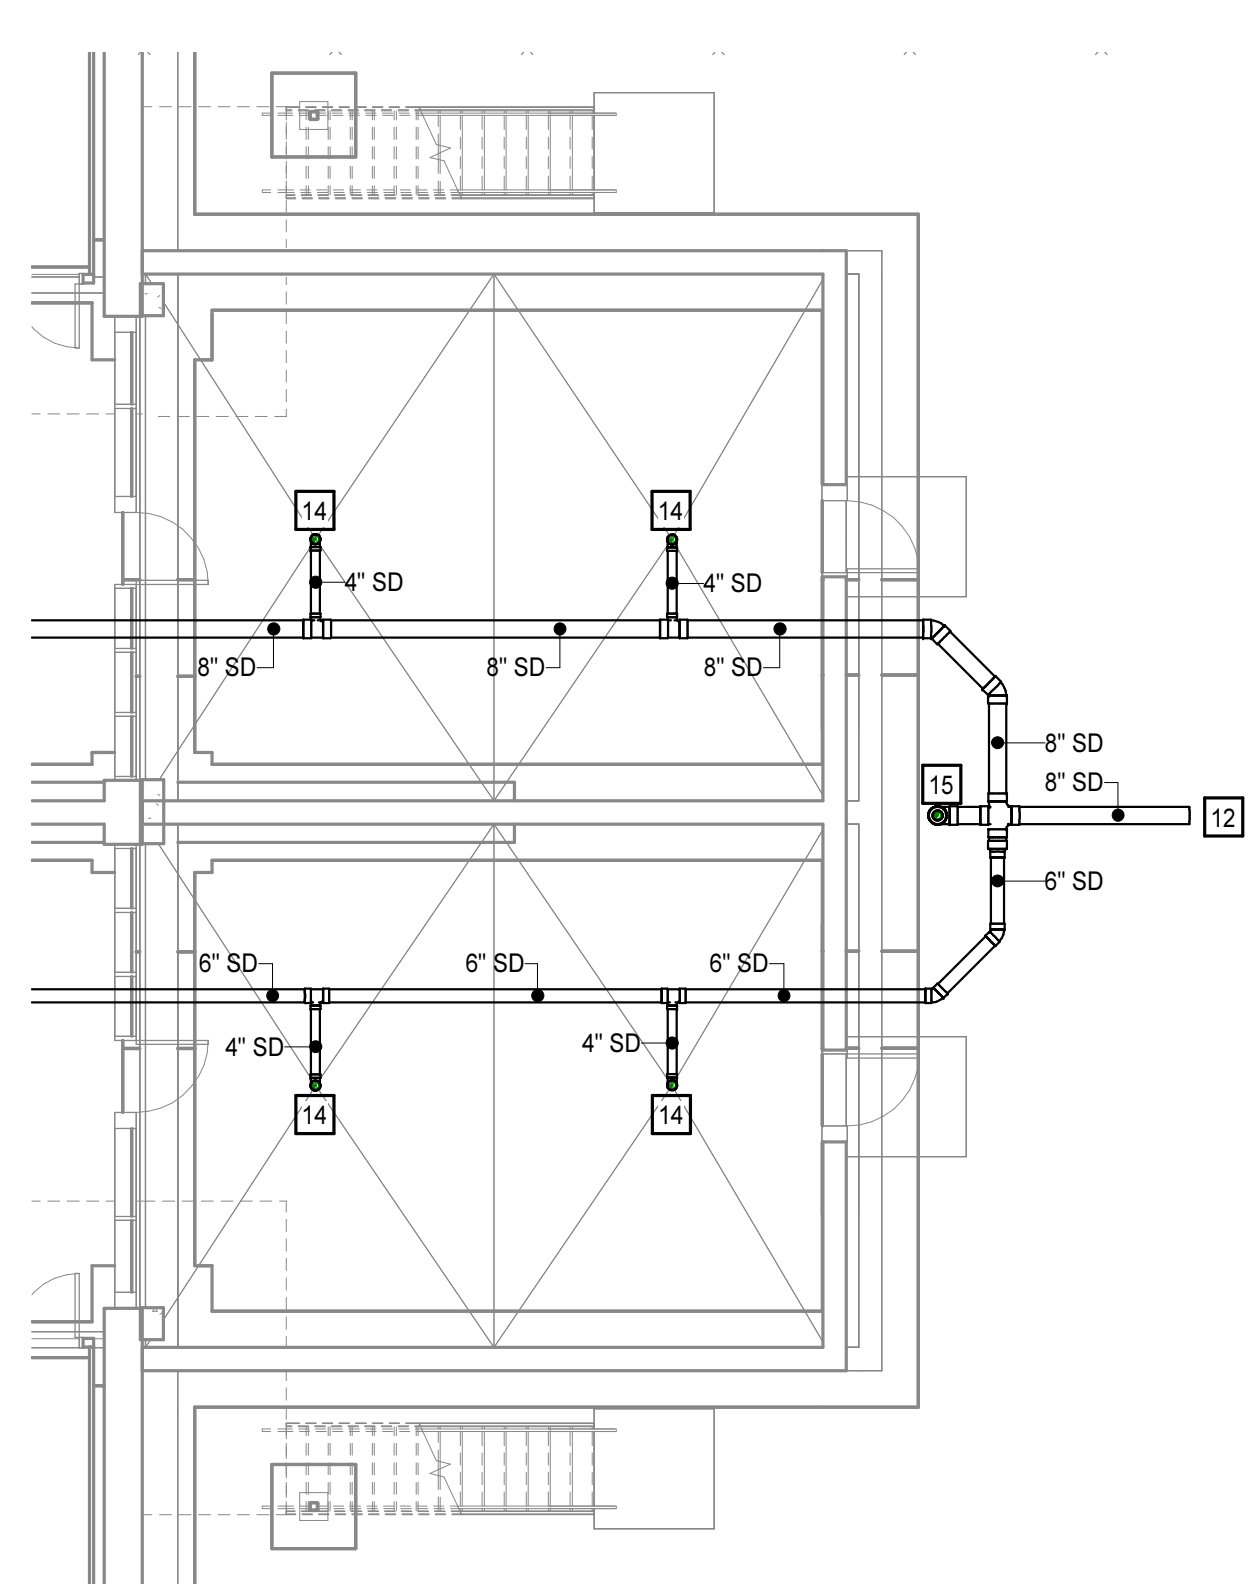

FOUNDATION PLAN - PART B - REC YARD E113 & F113
 1/8" = 1'-0"

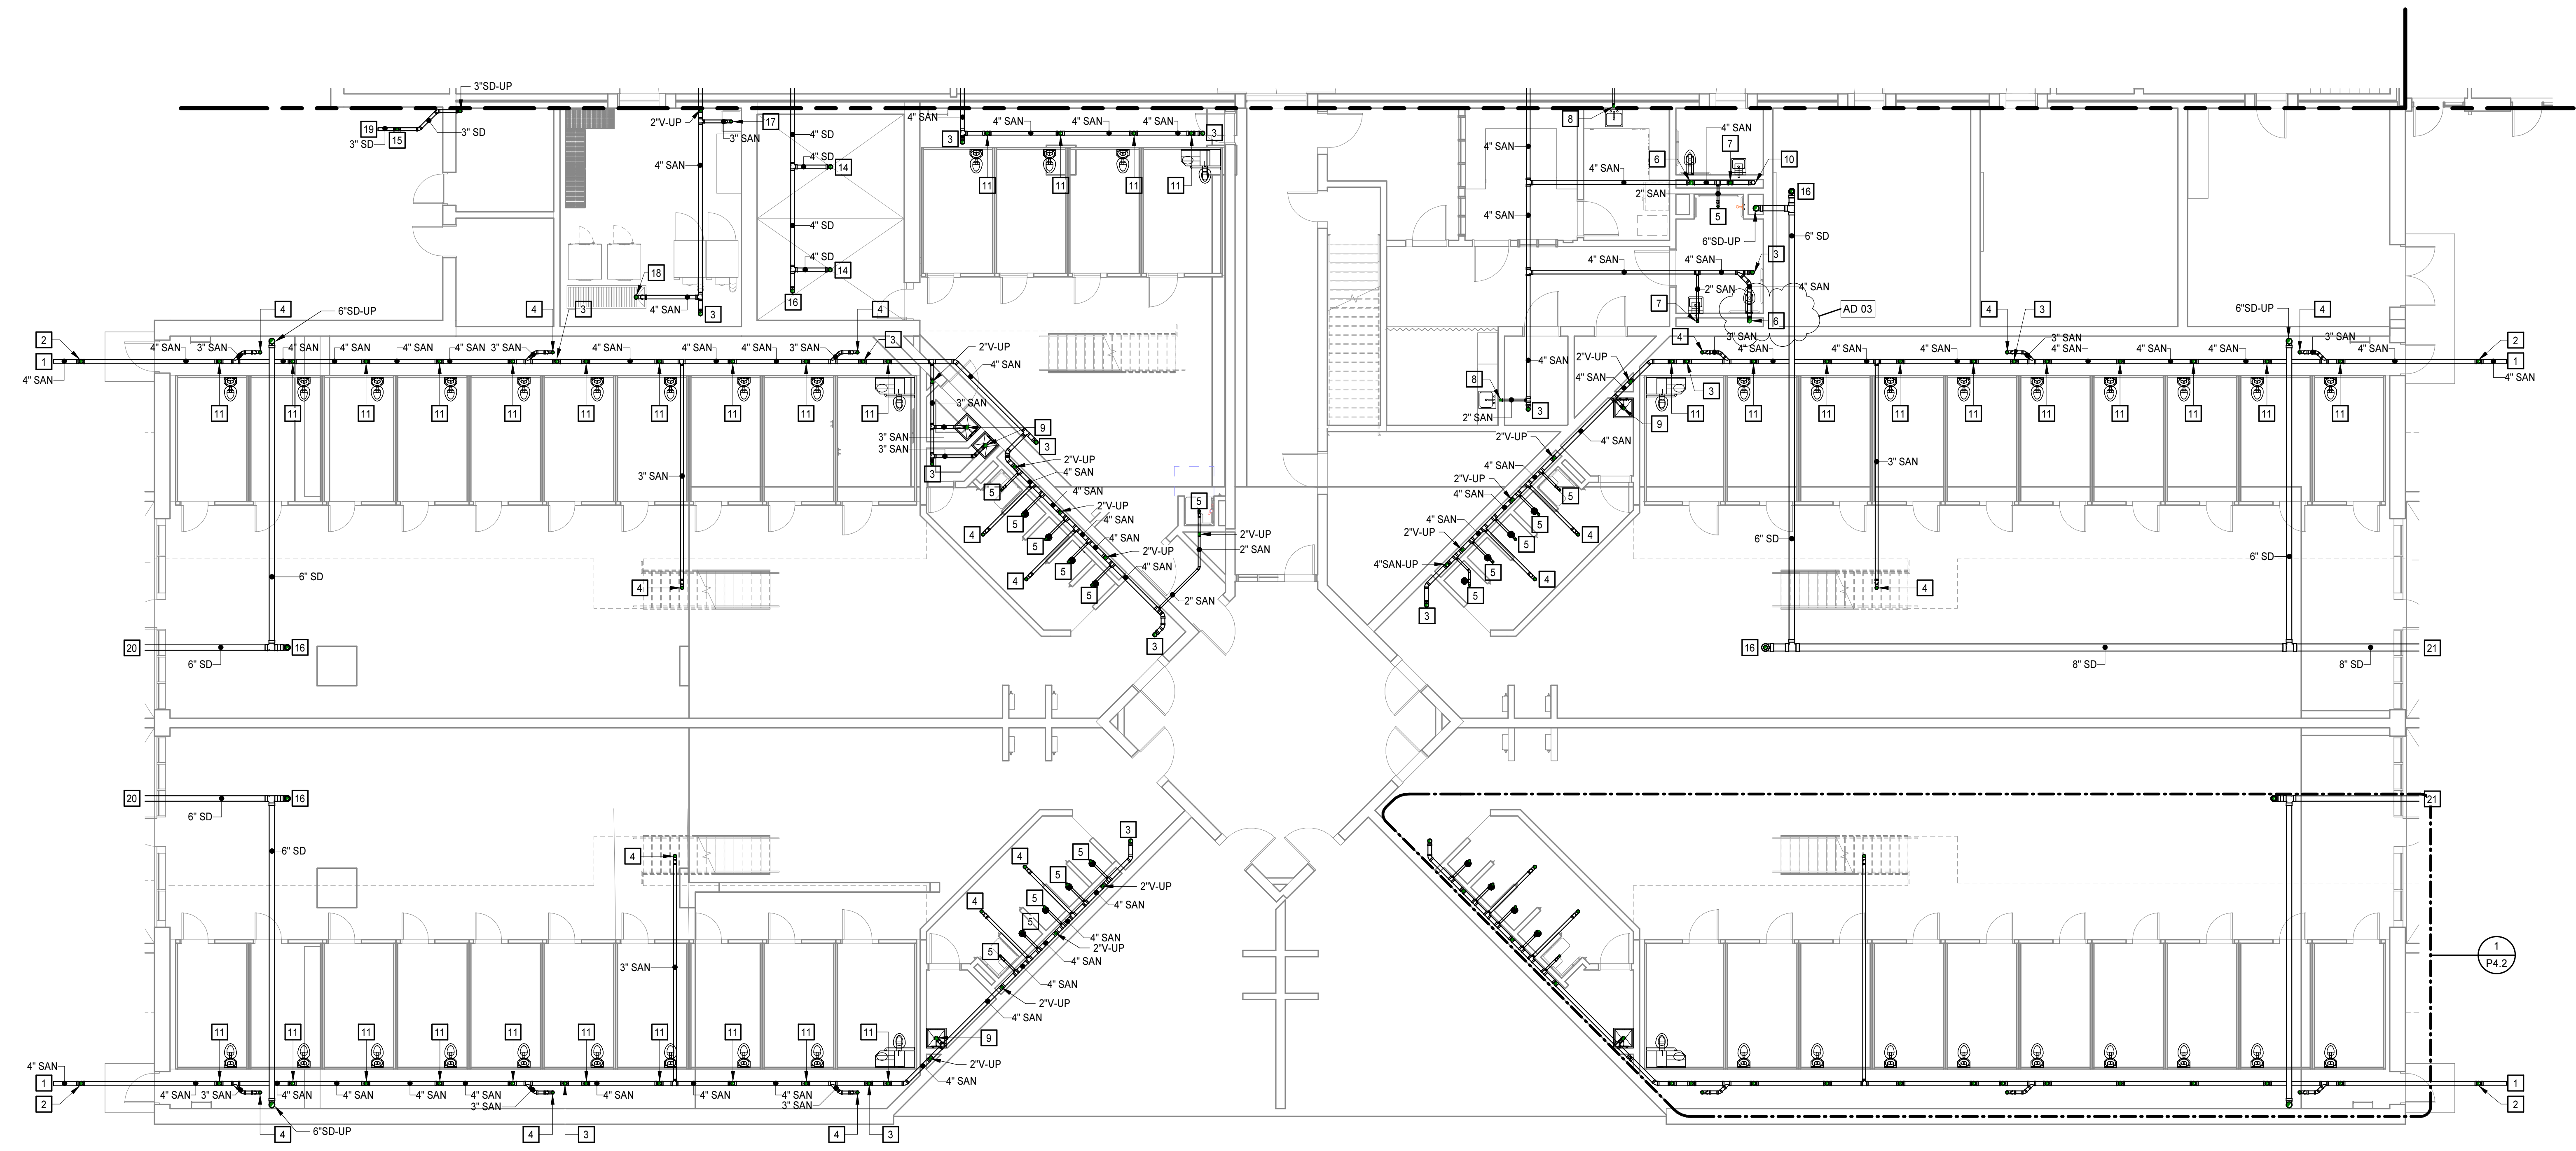

FOUNDATION PLAN - PART B - PLUMBING
 1/8" = 1'-0"

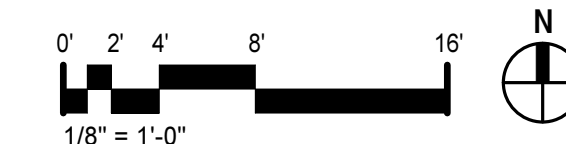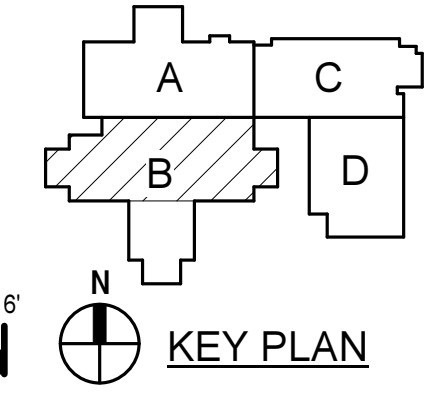



PENDER COUNTY LEC

PENDER COUNTY, NORTH CAROLINA
 OLD SAVANNAH ROAD BURGAW, NC

PROJECT NO:	811888
DATE:	MAY 1, 2024
REVISIONS	
DATE	DESCRIPTION
06/12/2024	AD 03

FOUNDATION PLAN - PART B - PLUMBING


P2.0.2

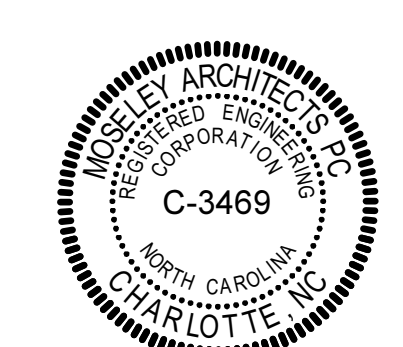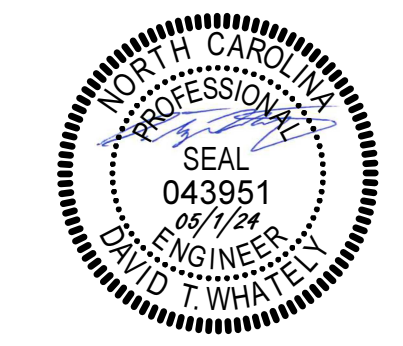



KEYNOTES	
APPLIES TO DRAWINGS P2.1.2	
REPRESENTED BY [n]	
1.	2"V-DN TO 2"SAN-DN.
2.	2"V-DN TO 4"SAN-DN.
3.	4"SAN STACK-UP WITH WCO AT BASE TYP OF 10.
4.	1 1/2"V-UP TYP OF 10.
5.	4"SAN STACK-UP WITH WCO AT BASE TYP OF 4.
6.	1 1/2"V-UP TYP OF 4.
7.	4"SAN-UP TO WATER CLOSET.
8.	2"SAN-UP TO LAVATORY.
9.	6"SD STACK WITH WCO AT BASE.
10.	2"V-UP TO 2"VIB.
11.	PROVIDE TRAP PRIMER CONNECTIONS FOR FLOOR DRAINS IN HOUSING UNIT AREAS.

FIRST FLOOR PLAN - PART B - REC YARD A113 & B113
 1/8" = 1'-0"

FIRST FLOOR PLAN - PART B - REC YARD E113 & F113
 1/8" = 1'-0"

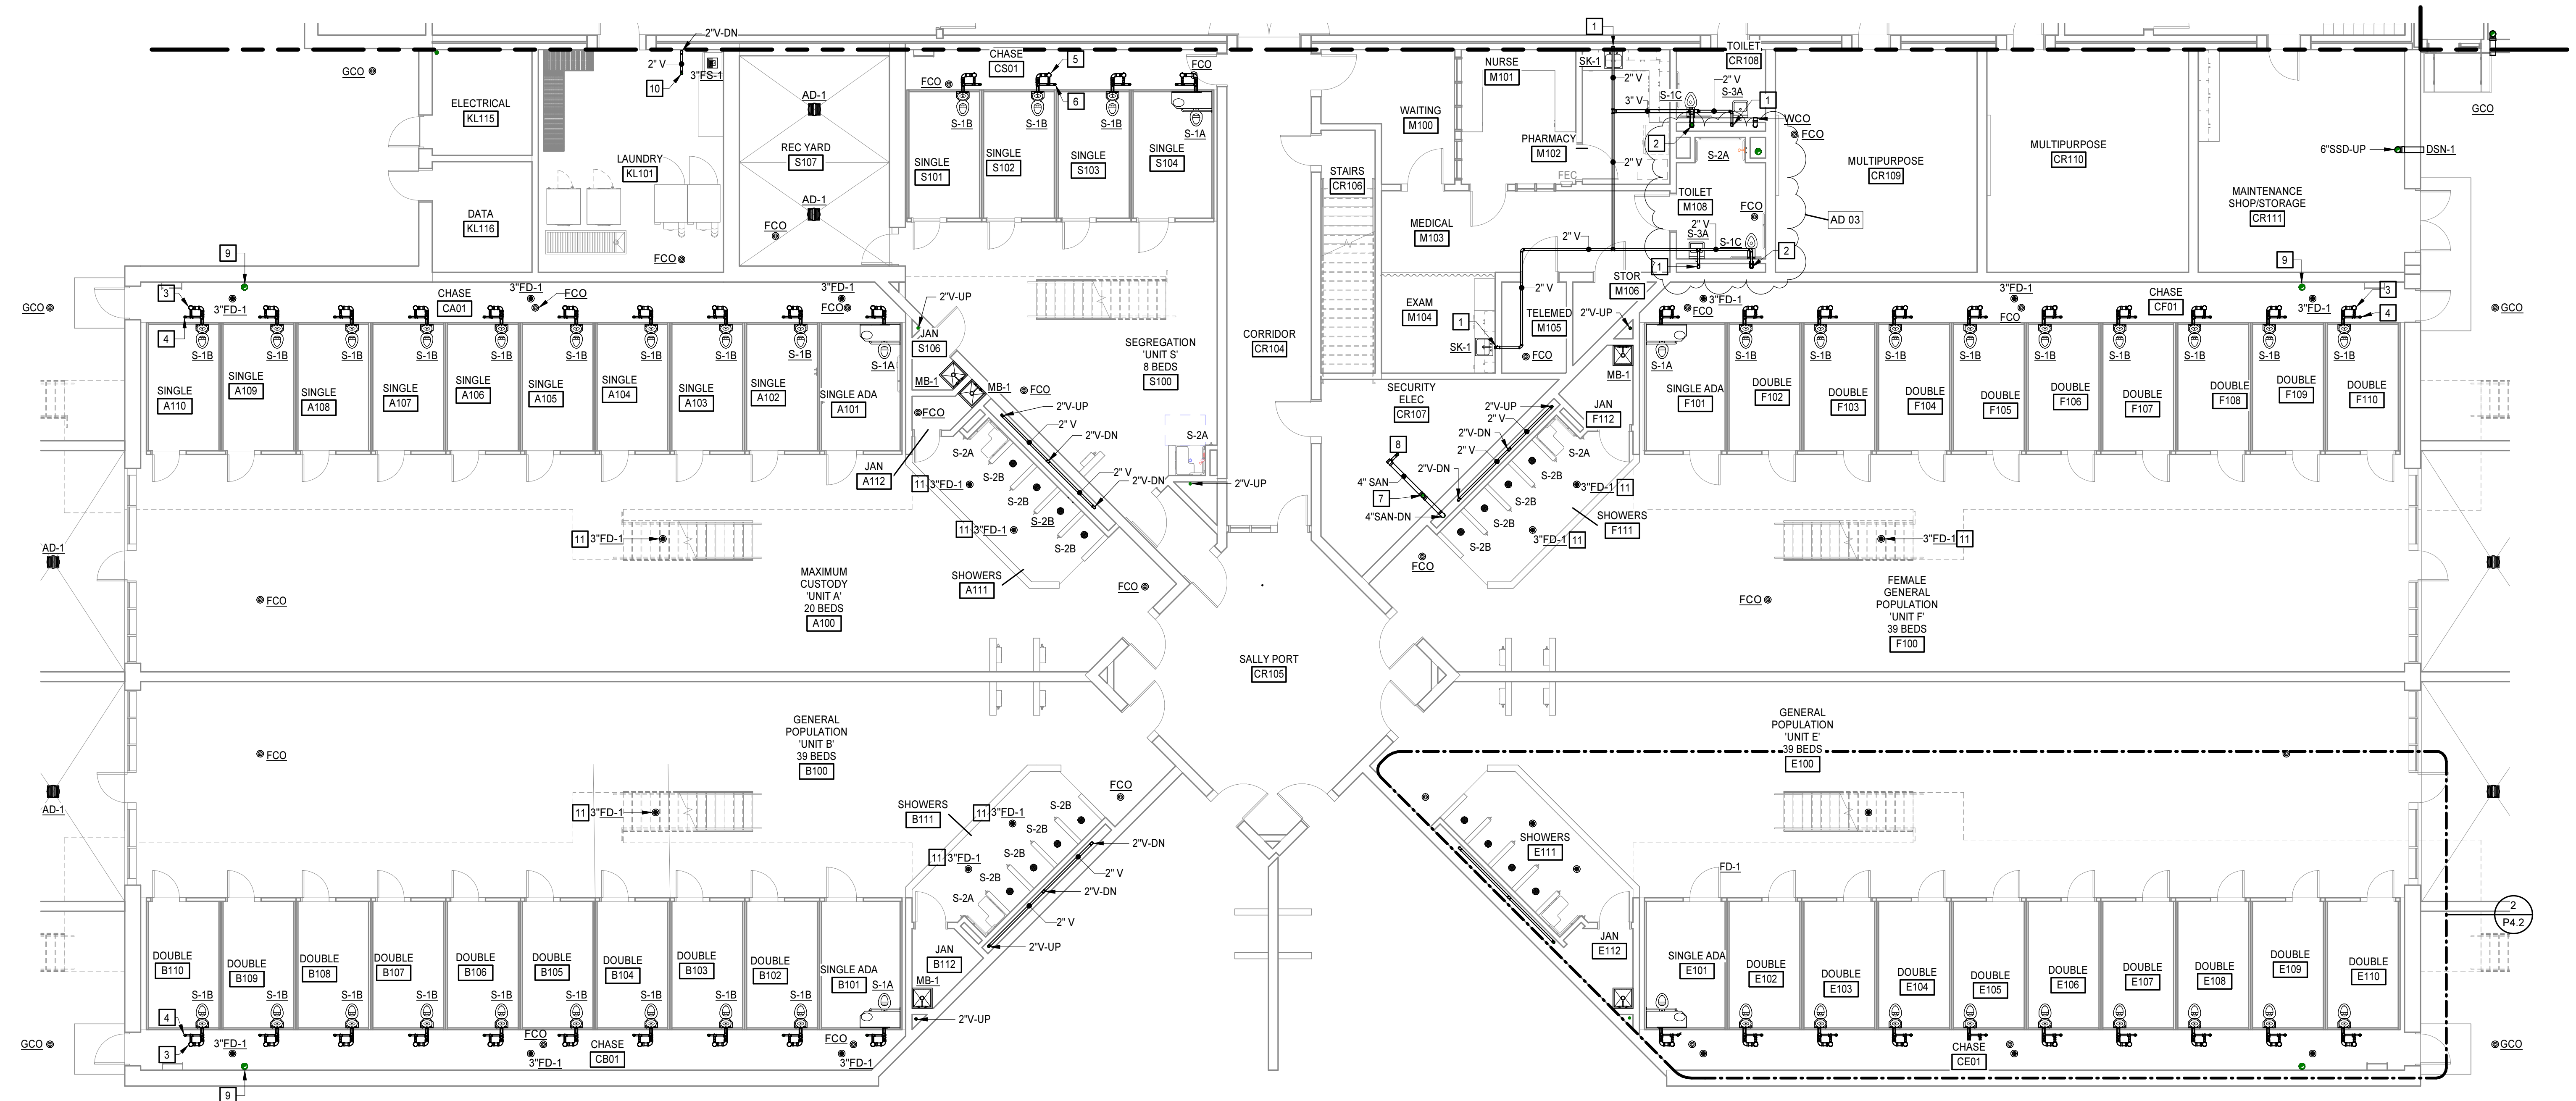

FIRST FLOOR PLAN - PART B - SANITARY
 1/8" = 1'-0"

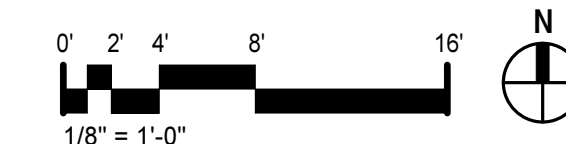
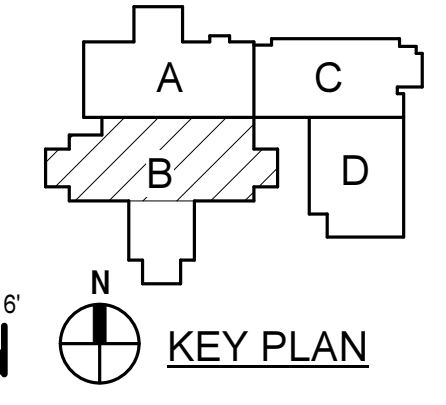


PENDER COUNTY LEC
 PENDER COUNTY, NORTH CAROLINA
 OLD SAVANNAH ROAD BURGAW, NC


PROJECT NO:	811888
DATE:	MAY 1, 2024
REVISIONS:	
DATE:	
DESCRIPTION:	

06/12/2024 AD 03



FIRST FLOOR PLAN - PART B - SANITARY

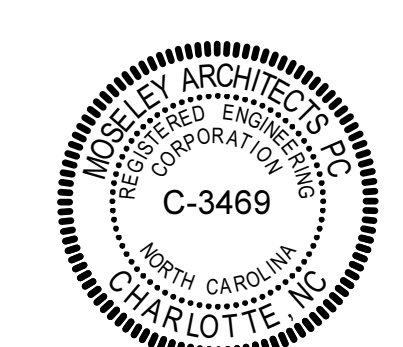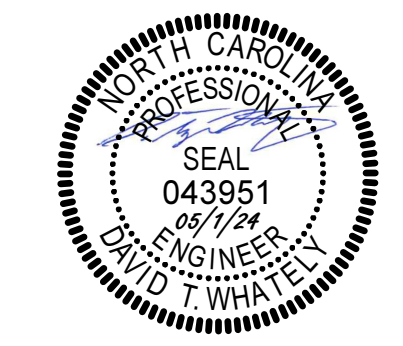

KEYNOTES	
APPLIES TO DRAWINGS P2.1.3	
REPRESENTED BY [Symbol]	
1.	2"V-DN TO 2"SAN-DN
2.	3"V-UP TO 3"VTR
3.	2"V-UP TO 2"VTR
4.	6"SSD-UP TO SRO-1
5.	6"SSD-UP TO SRO-1
6.	6"SSD-DN WITH WCO AT BASE

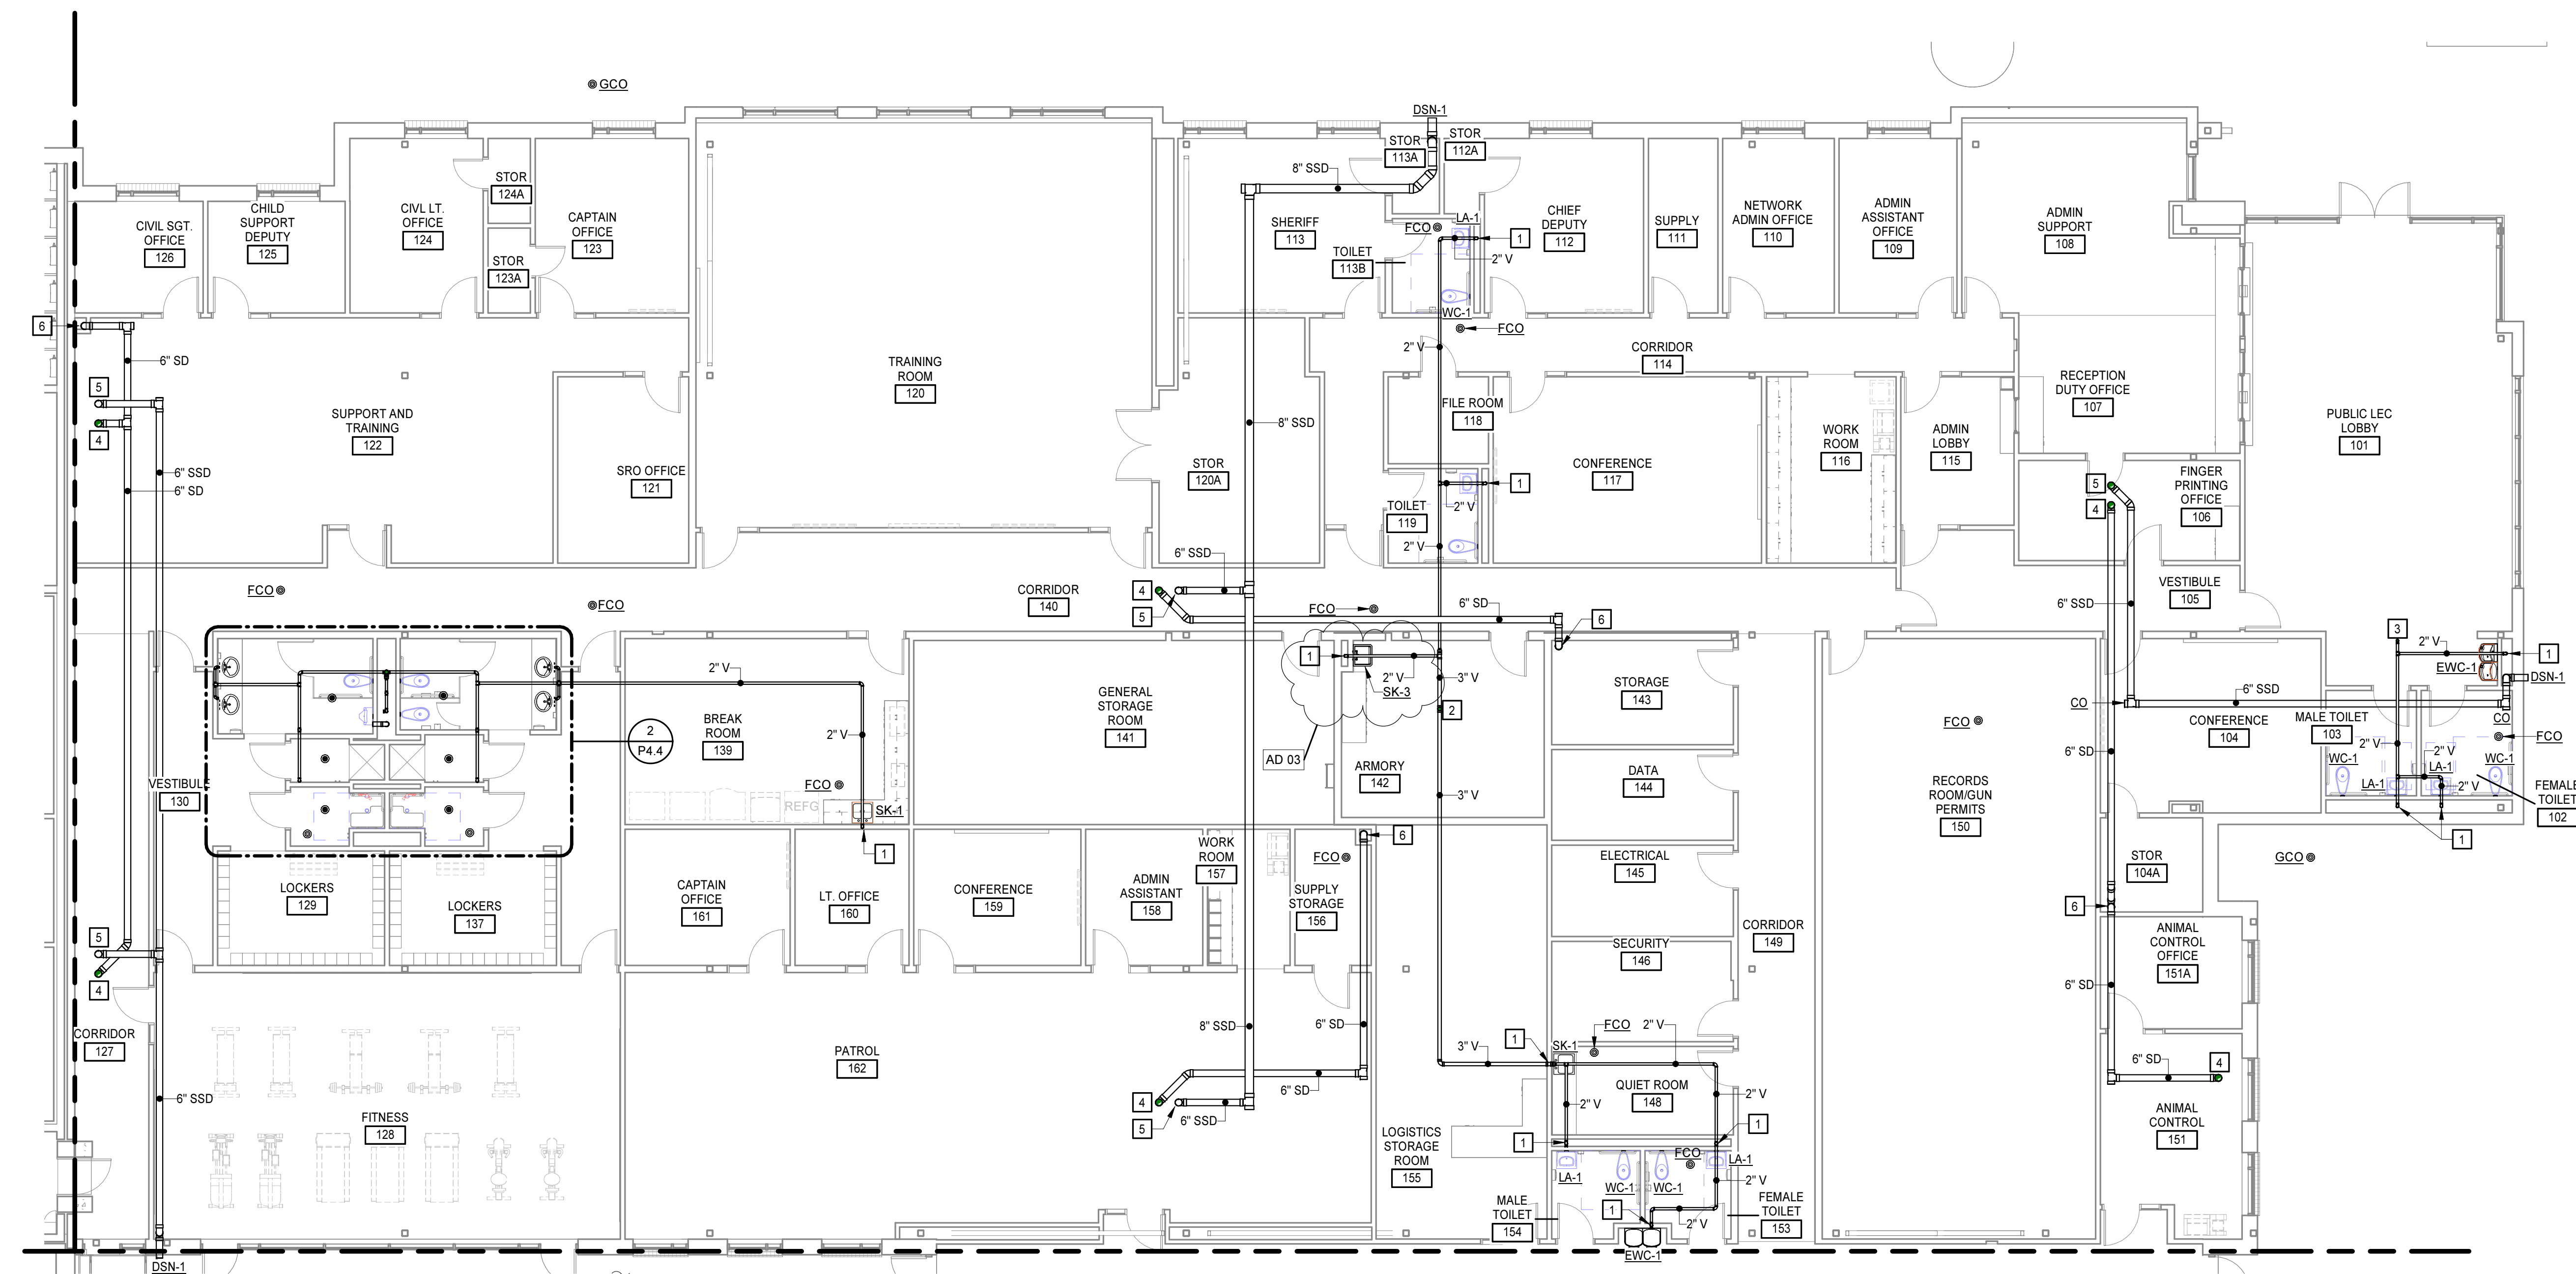



FIRST FLOOR PLAN - PART C - SANITARY
 1/8" = 1'-0"

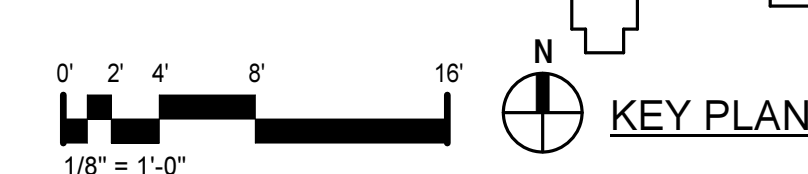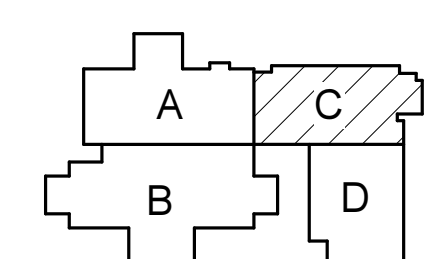

PENDER COUNTY LEC
 PENDER COUNTY, NORTH CAROLINA
 OLD SAVANNAH ROAD BURGAW, NC


PROJECT NO:	811888
DATE:	MAY 1, 2024
REVISIONS	
DATE	DESCRIPTION
06/12/2024	AD 03

FIRST FLOOR PLAN - PART C - SANITARY

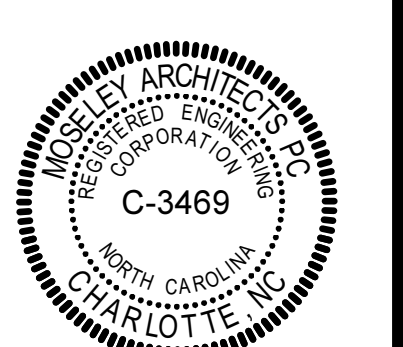
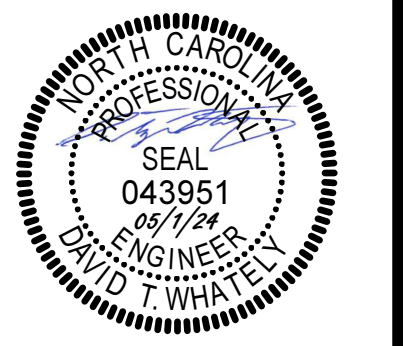


KEYNOTES
 APPLIES TO DRAWINGS P2.1.5
 REPRESENTED BY [Symbol]

1. PROVIDE DOMESTIC COLD AND HOT WATER MOTORIZED ISOLATION VALVES. VALVES SHALL BE CONTROLLED BY THE SECURITY ELECTRONICS SYSTEM IN MASTER CONTROL ROOM. RELAY AND VALVE ACTUATOR POWER SHALL BE PROVIDED BY DIVISION 26. COORDINATE WITH SECURITY ELECTRONICS SYSTEM FOR SECURITY SYSTEM INTERFACE. REFER TO DOMESTIC WATER MOTORIZED ISOLATION VALVE DETAIL. ALL ZONE CELEBLOCK MANUAL. AN SOLENOID VALVE TO BE LOCATED IN CHASE WALLS AND ACCESSIBLE FROM LADDER.
2. 1" DCW-DN TO FLUSHING FLOOR DRAIN. PUSH BUTTON FLUSH VALVE LOCATED IN WALL.
3. FLUSHING FLOOR DRAIN REMOTE BUTTON. REFER TO DETAIL FOR ADDITIONAL INFORMATION.
4. 1" DCW-DN TO WATER CLOSET.
5. 1/2" DCW & 1/2" DHW-DN TO LAVATORY.
6. 3/4" DCW & 3/4" DHW-DN TO MOP BASIN.
7. 1/2" DCW & 1/2" DHW-DN TO SHOWER.

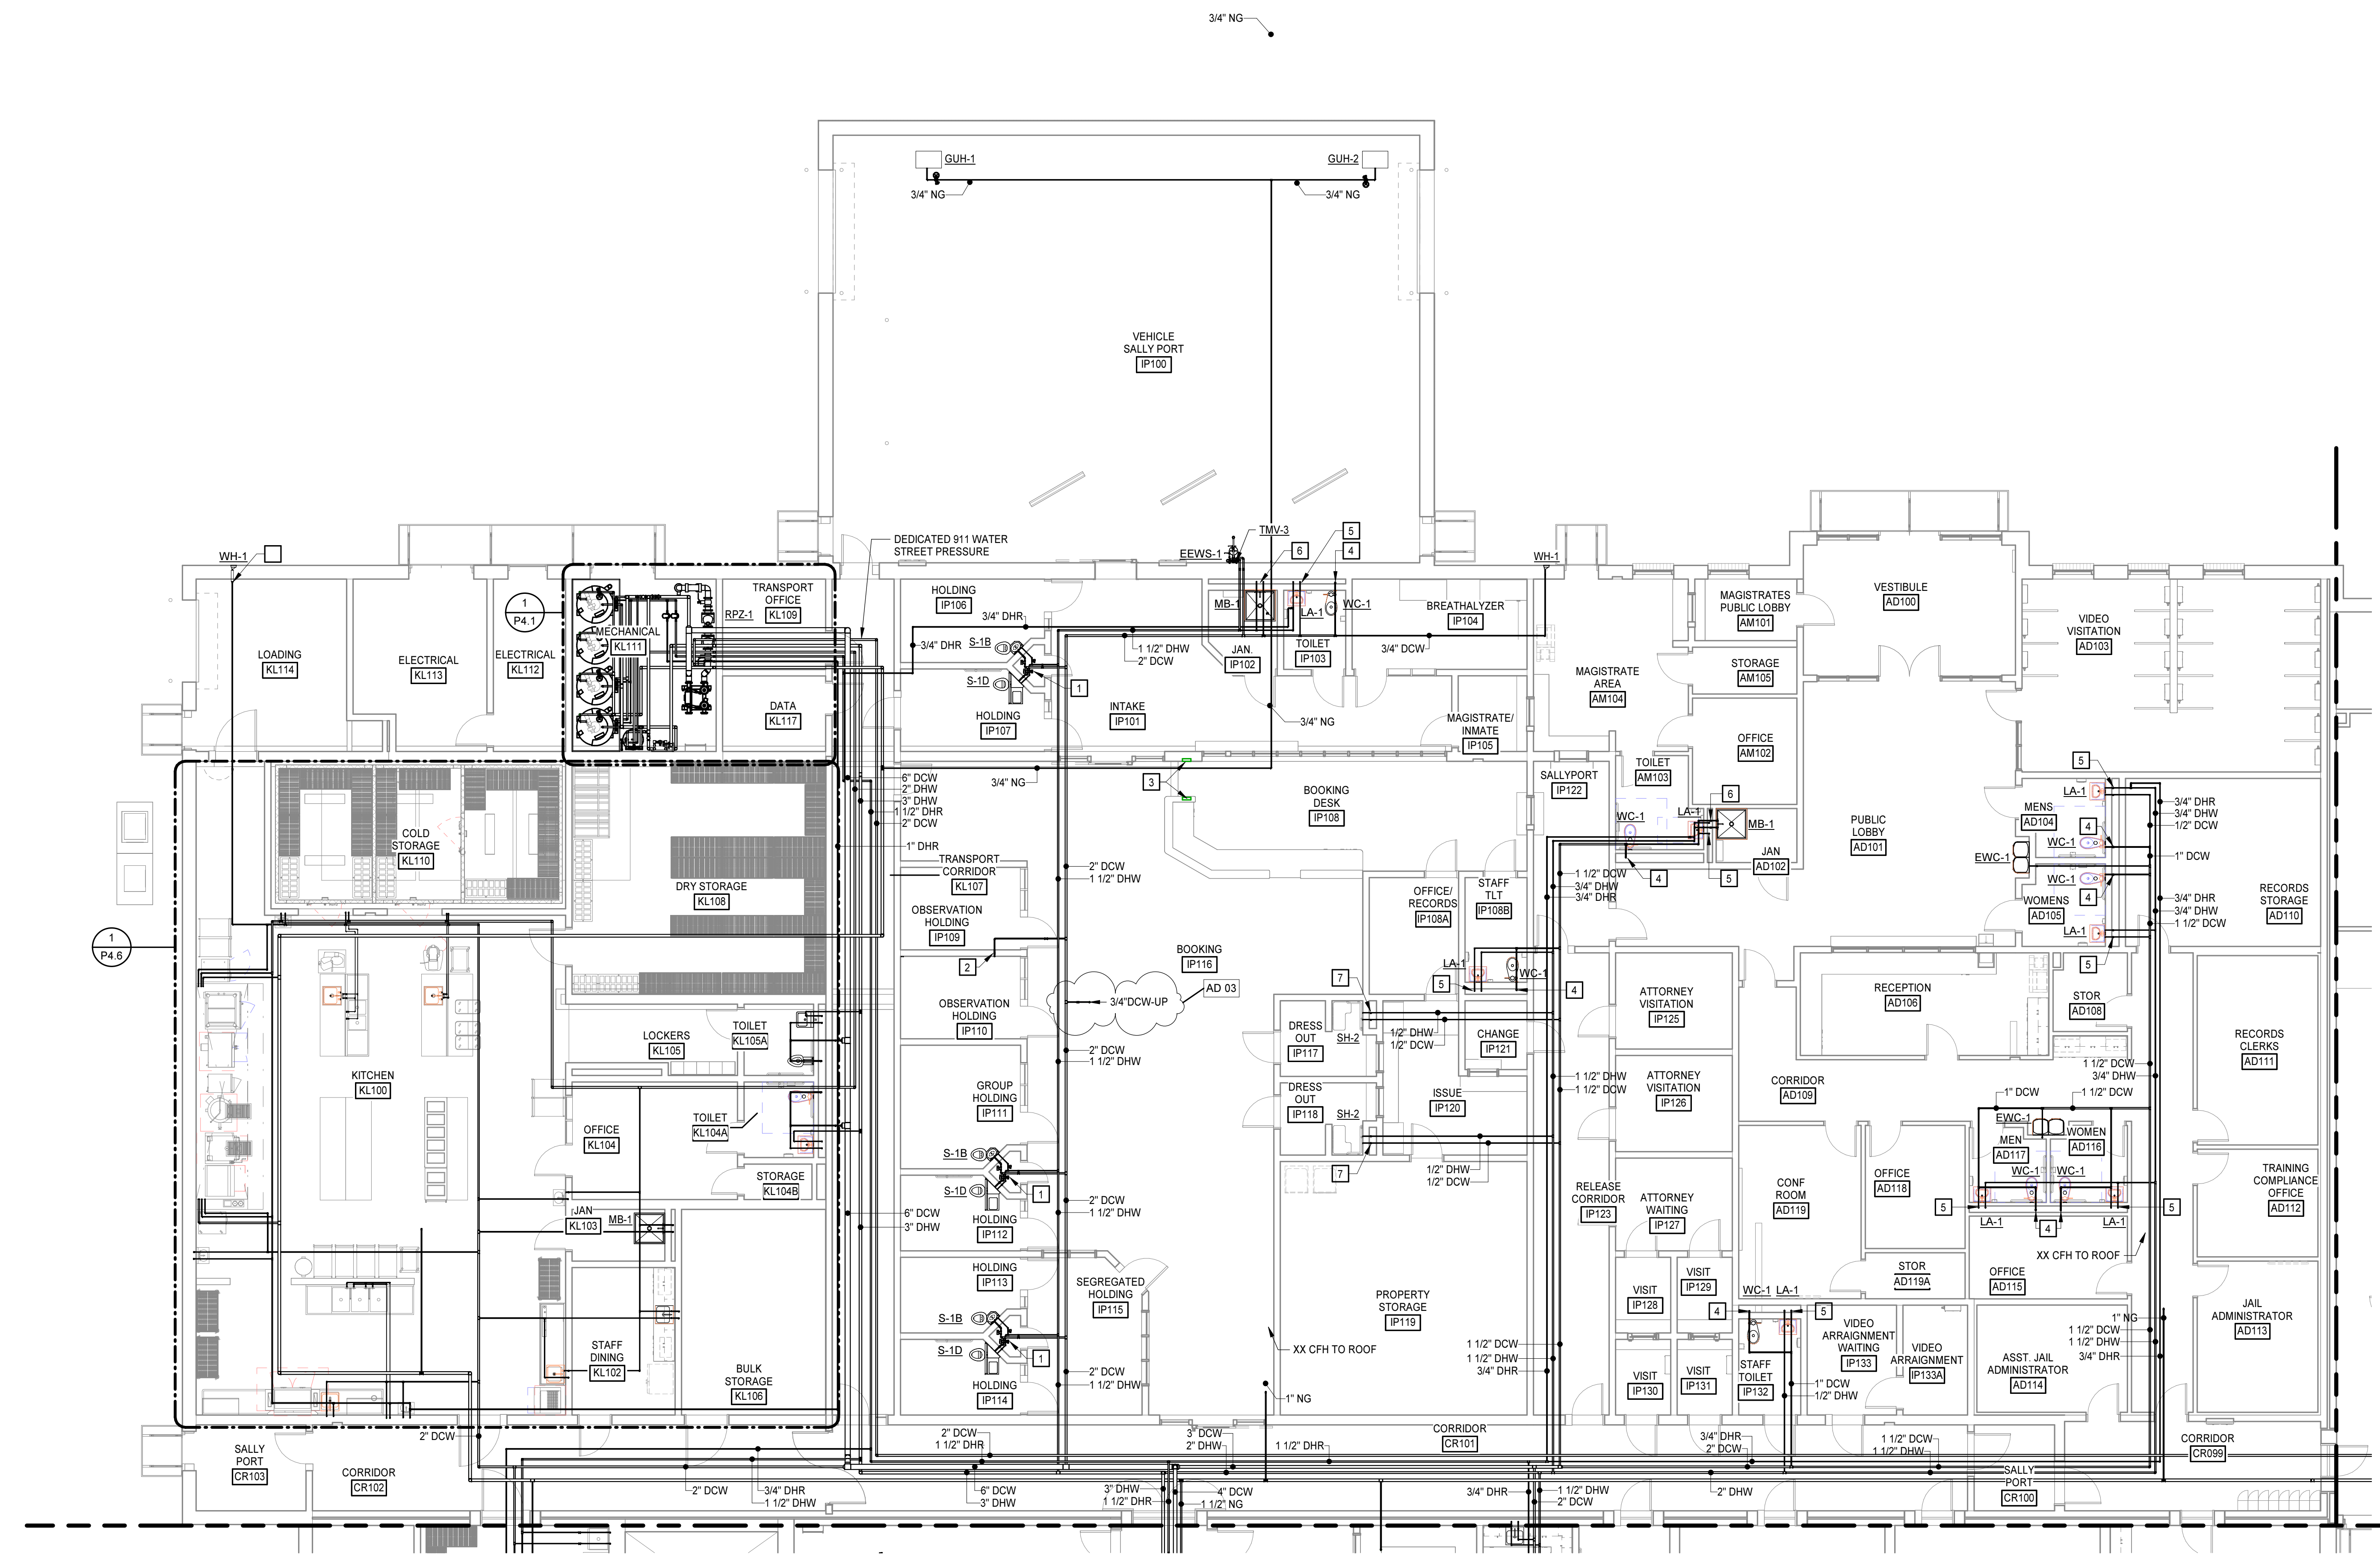

FIRST FLOOR PLAN - PART A - DOMESTIC
 1/8" = 1'-0"

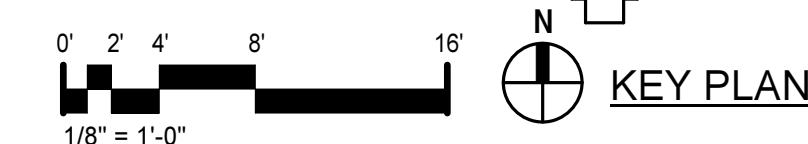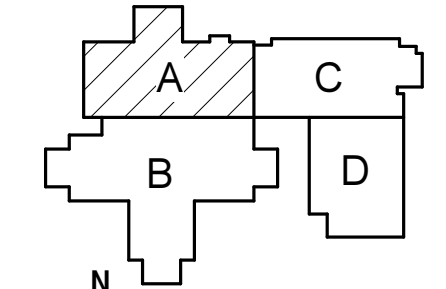


PENDER COUNTY LEC
 PENDER COUNTY, NORTH CAROLINA
 OLD SAVANNAH ROAD BURGAW, NC

PROJECT NO:	811888
DATE:	MAY 1, 2024
REVISIONS:	
DATE:	DESCRIPTION
06/12/2024	AD 03


FIRST FLOOR PLAN - PART A - DOMESTIC

P2.1.5

KEYNOTES	
APPLIES TO DRAWINGS P2.1.6	
REPRESENTED BY [A]	
1.	1"DCW-DN TO WATER CLOSET.
2.	1/2"DCW & 1/2"DHW-DN TO LAVATORY.
3.	1/2"DCW & 1/2"DHW-DN TO SINK.
4.	1/2"DCW & 1/2"DHW-DN TO SHOWER.
5.	3/4"DCW & 3/4"DHW-DN TO MOP BASIN.
6.	1"DCW & 1/2"DHW-UP.
7.	1/2"DCW & 1/2"DHW-DN.
8.	3/4"DCW & 3/4"DHW-UP.
9.	PROVIDE DOMESTIC COLD AND HOT WATER MOTORIZED ISOLATION VALVES. VALVES SHALL BE CONTROLLED BY THE SECURITY ELECTRONICS SYSTEM IN MASTER CONTROL ROOM. RELAY AND VALVE ACTUATOR POWER SHALL BE PROVIDED BY DIVISION 26. COORDINATE WITH SECURITY ELECTRONICS SYSTEM FOR SECURITY SYSTEM INTERFACE. REFER TO DOMESTIC WATER MOTORIZED ISOLATION VALVE DETAIL ALL ZONE CELLBLOCK MANUAL AN SOLENOID VALVE TO BE LOADED IN CHASE WALLS AND ACCESSIBLE FROM LADDER.
10.	2 1/2"DCW, 2 1/2"DHW, & 1"DHR-UP TO MEZZANINE LEVEL.
11.	3/4"DCW-UP.

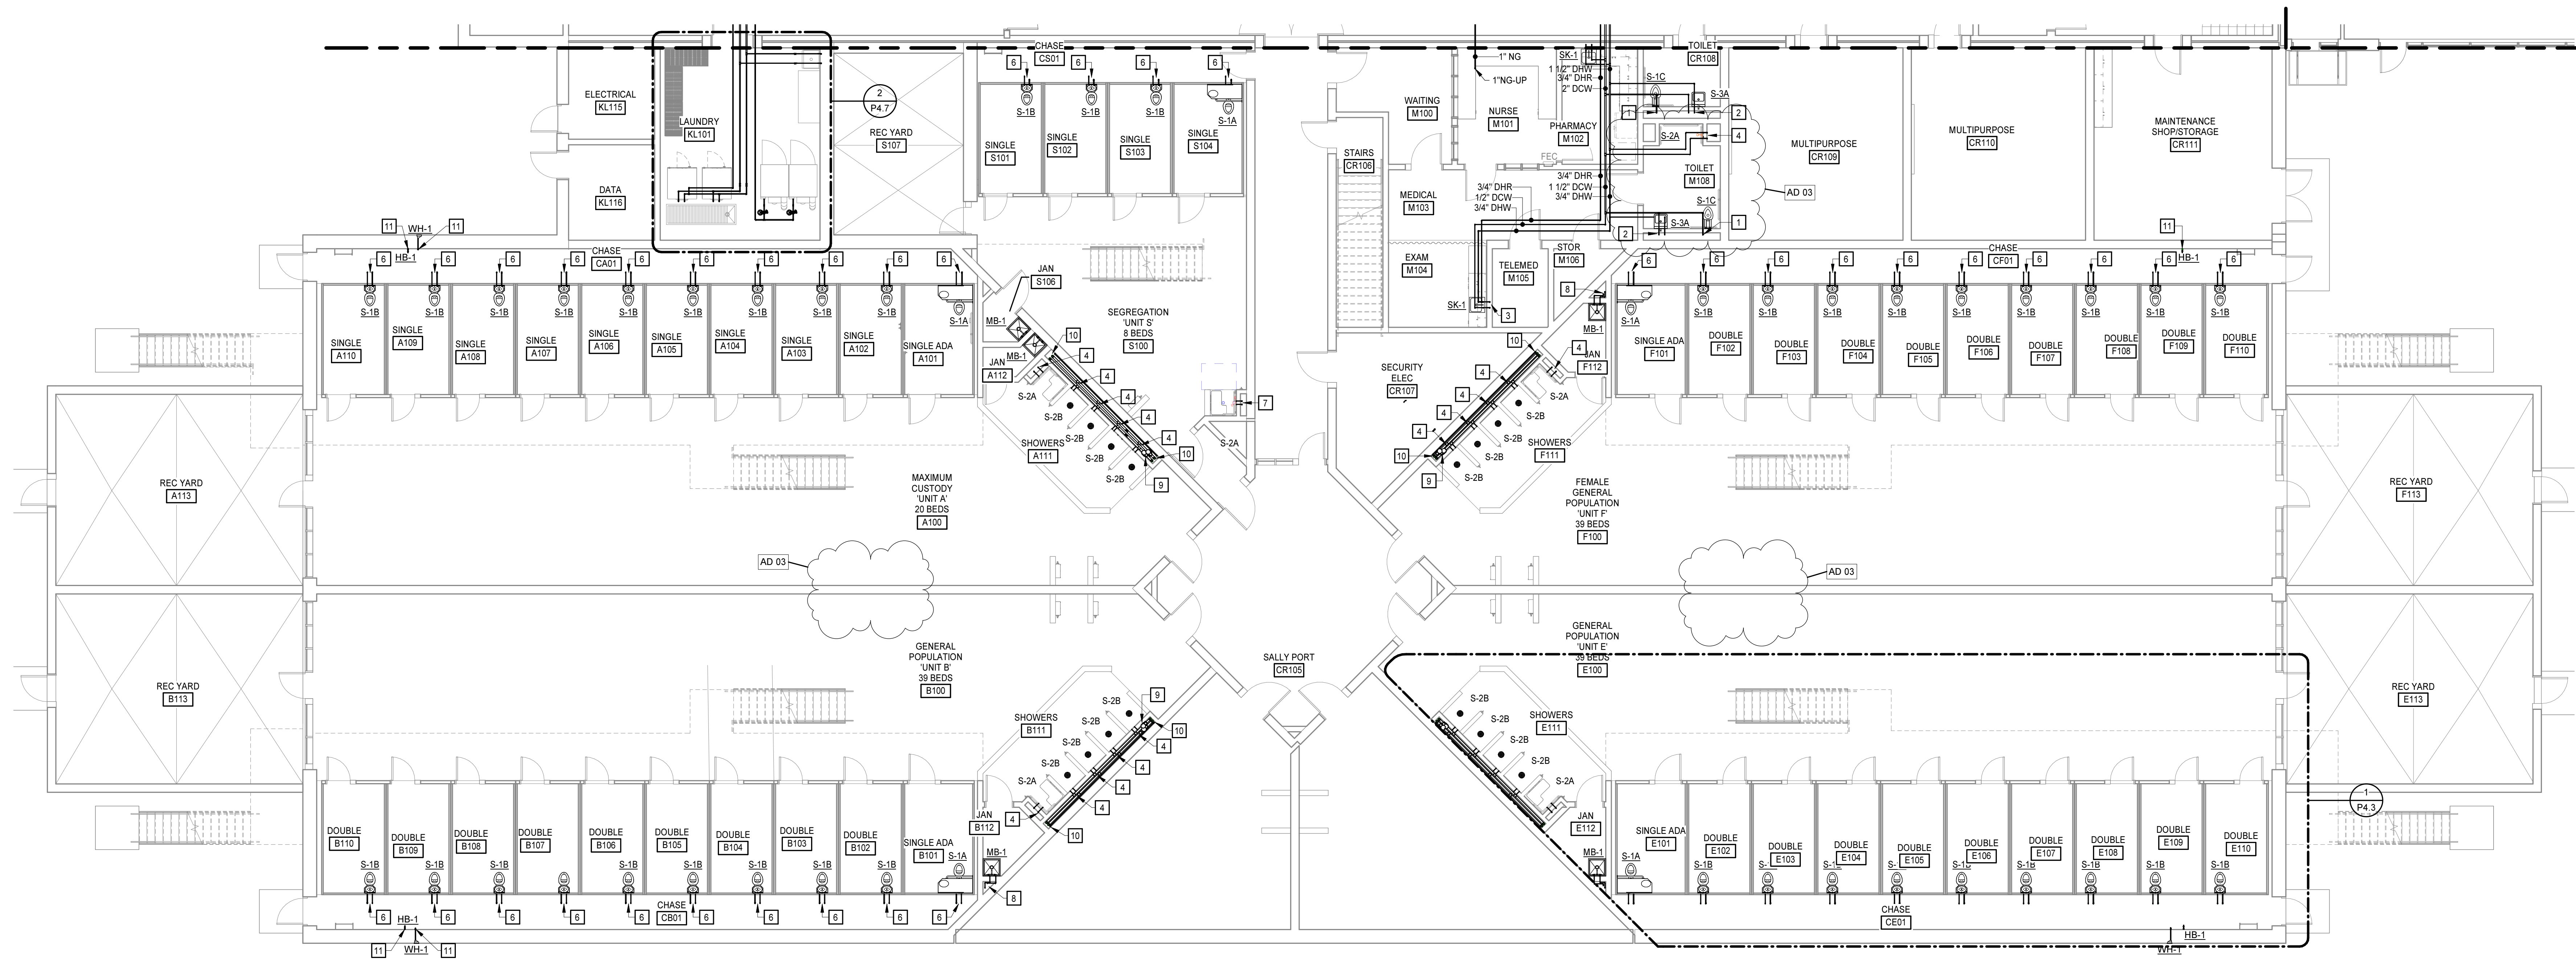


FIRST FLOOR PLAN - PART B - DOMESTIC
 1/8" = 1'-0"

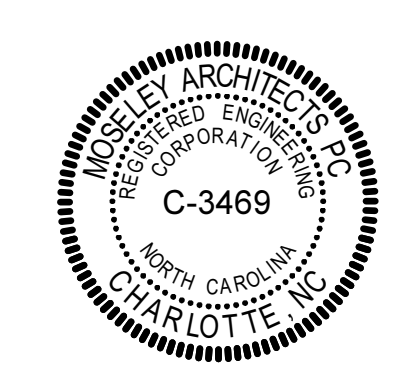



PENDER COUNTY LEC

PENDER COUNTY, NORTH CAROLINA
 OLD SAVANNAH ROAD BURGAW, NC

DATE	REVISIONS
06/12/2024	AD 03

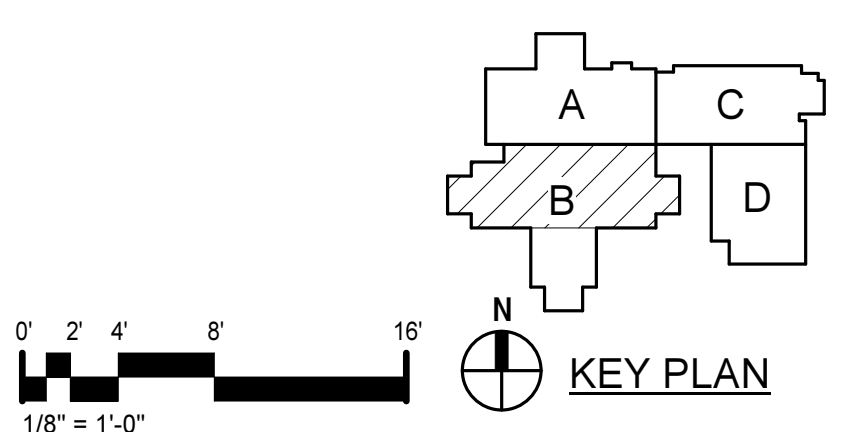


FIRST FLOOR PLAN - PART B - DOMESTIC

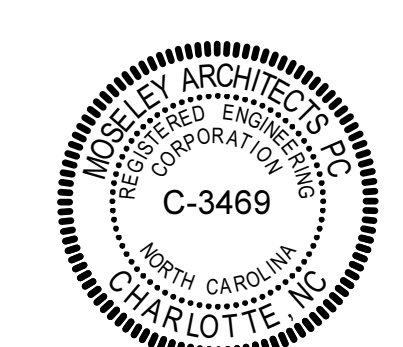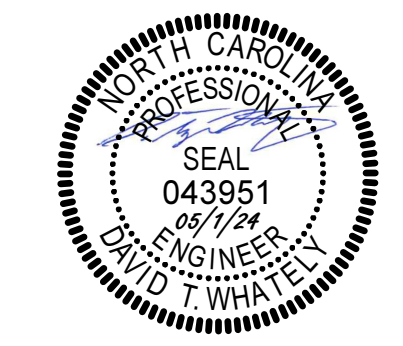

KEYNOTES
 APPLIES TO DRAWINGS P2.1.7
 REPRESENTED BY [Symbol]

- 1' DCW-DN TO WATER CLOSET.
- 1/2' DCW & 1/2' DHW-DN TO LAVATORY.
- 1/2' DCW & 1/2' DHW-DN TO SINK.
- 1/2' DCW-DN TO DRINKING FOUNTAIN.

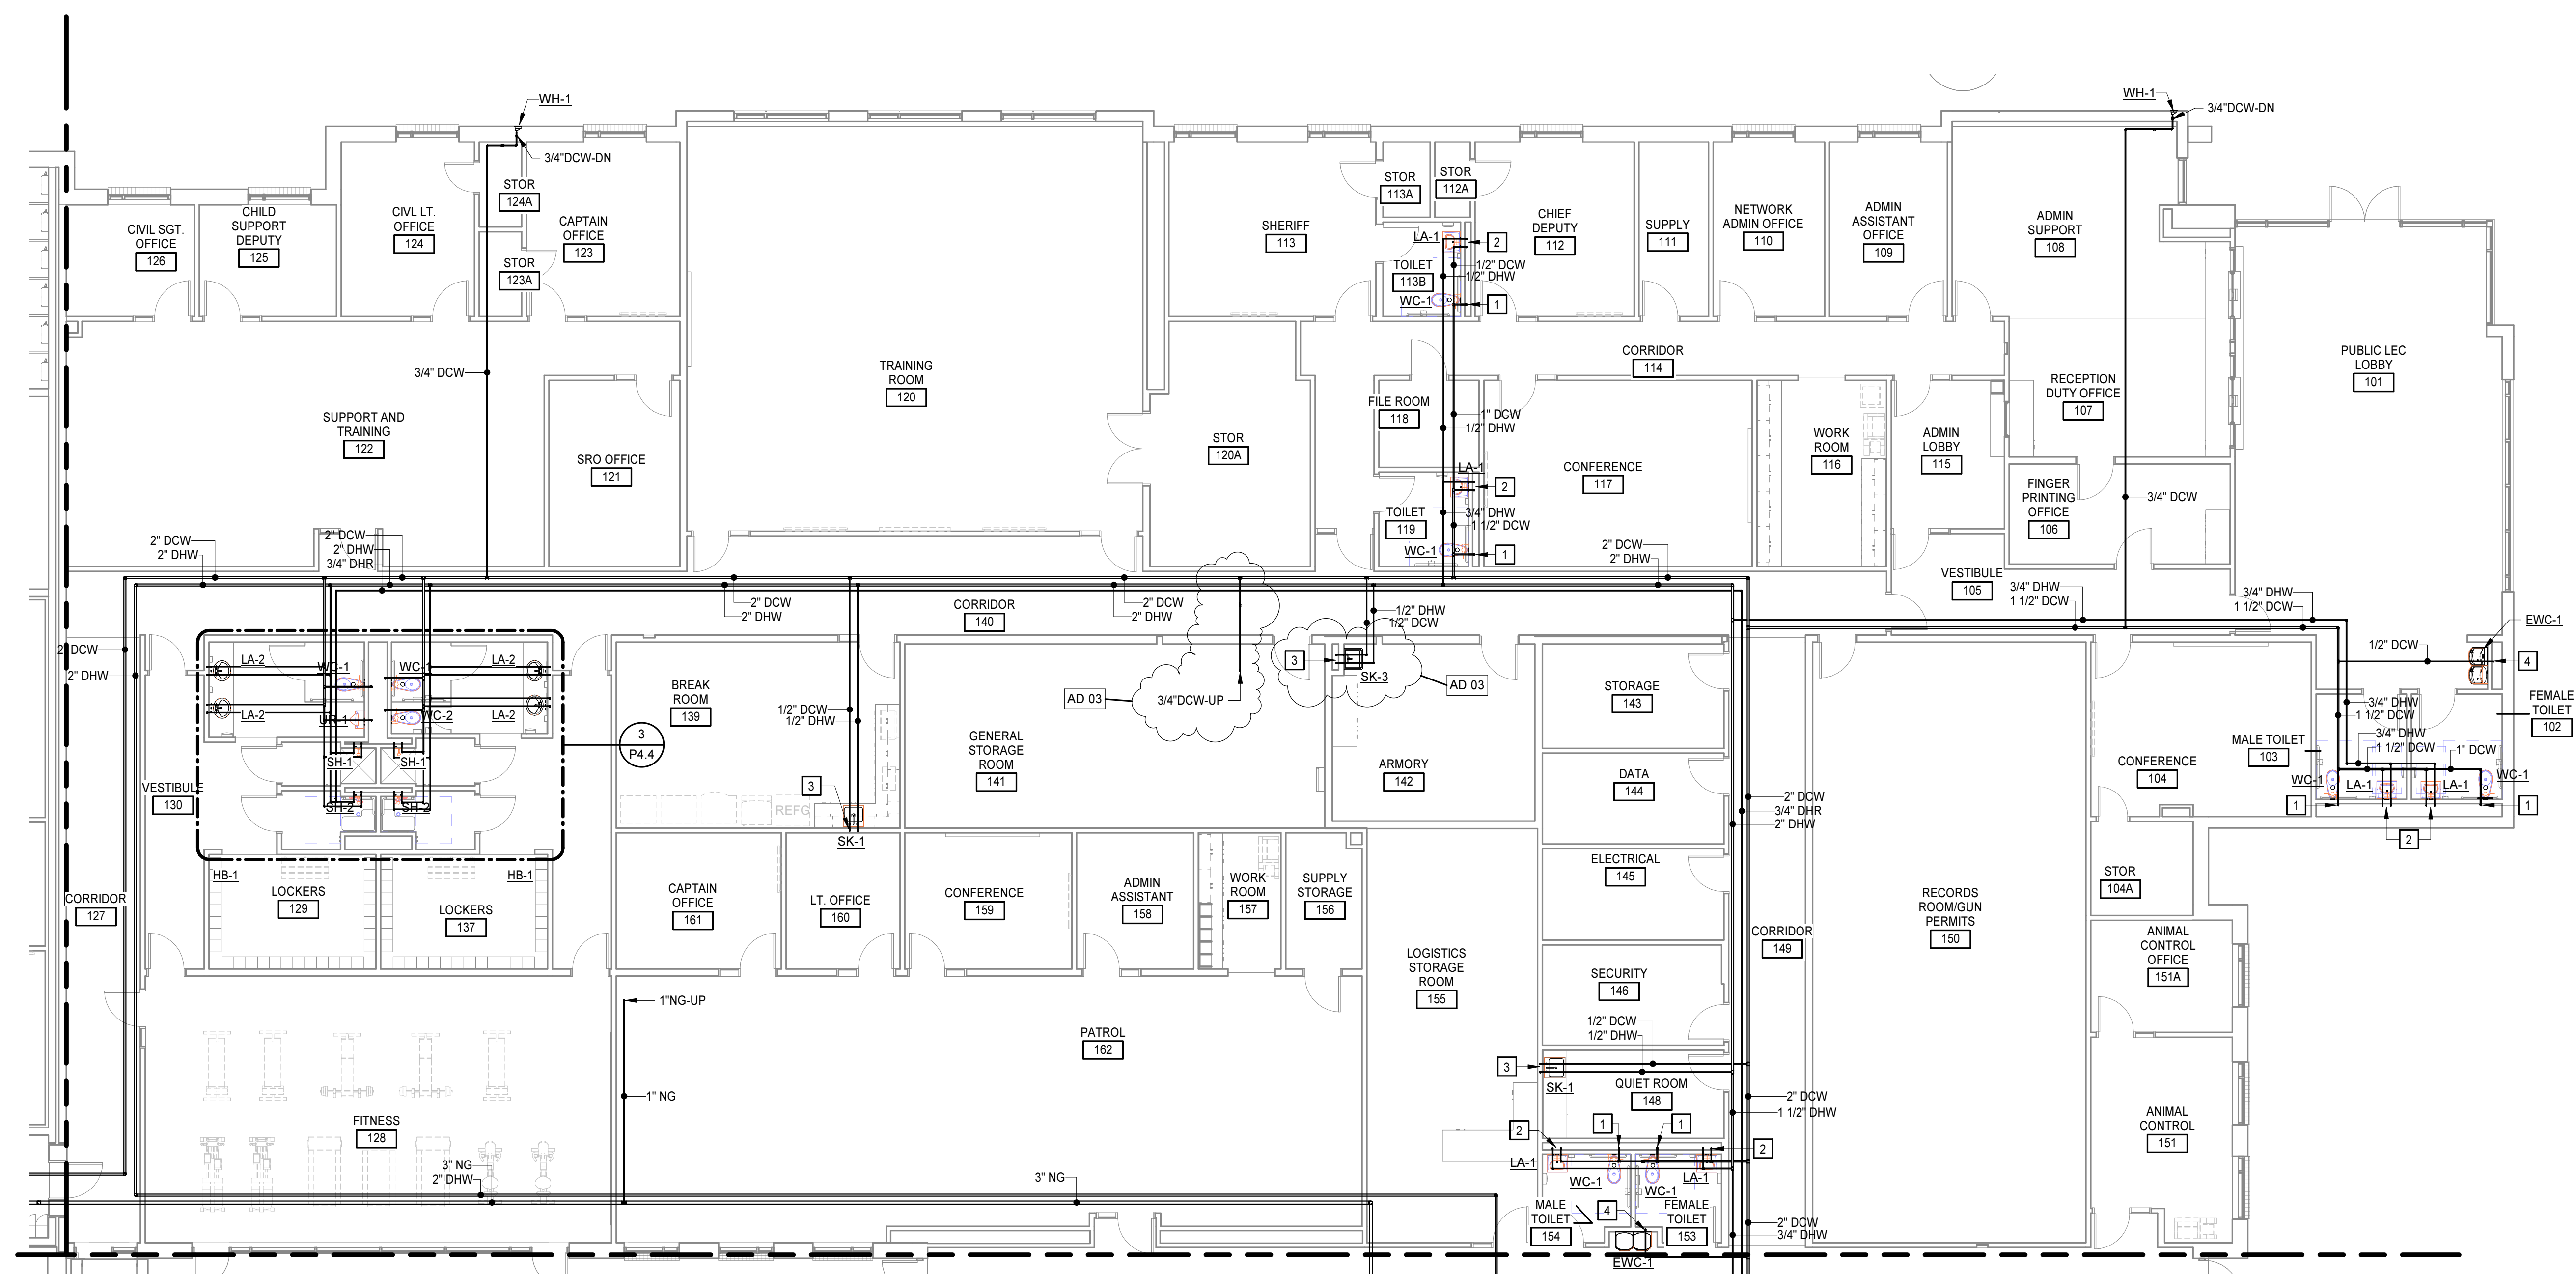


FIRST FLOOR PLAN - PART C - DOMESTIC
 1/8" = 1'-0"

PENDER COUNTY LEC
 PENDER COUNTY, NORTH CAROLINA
 OLD SAVANNAH ROAD BURGAW, NC

PROJECT NO:	811888
DATE:	MAY 1, 2024
REVISIONS	
DATE	DESCRIPTION
06/12/2024	AD 03


FIRST FLOOR PLAN - PART C - DOMESTIC

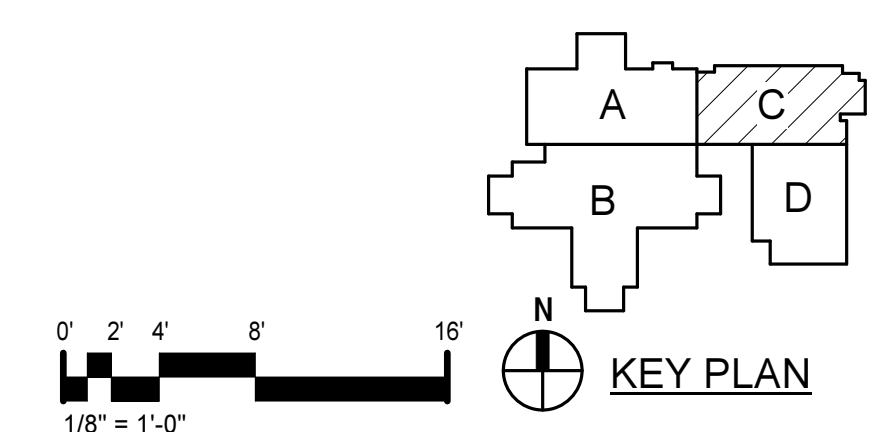

6/12/2024 9:28:46 AM

6/12/2024 9:28:52 AM

J
H
G
F
E
D
C
B
A


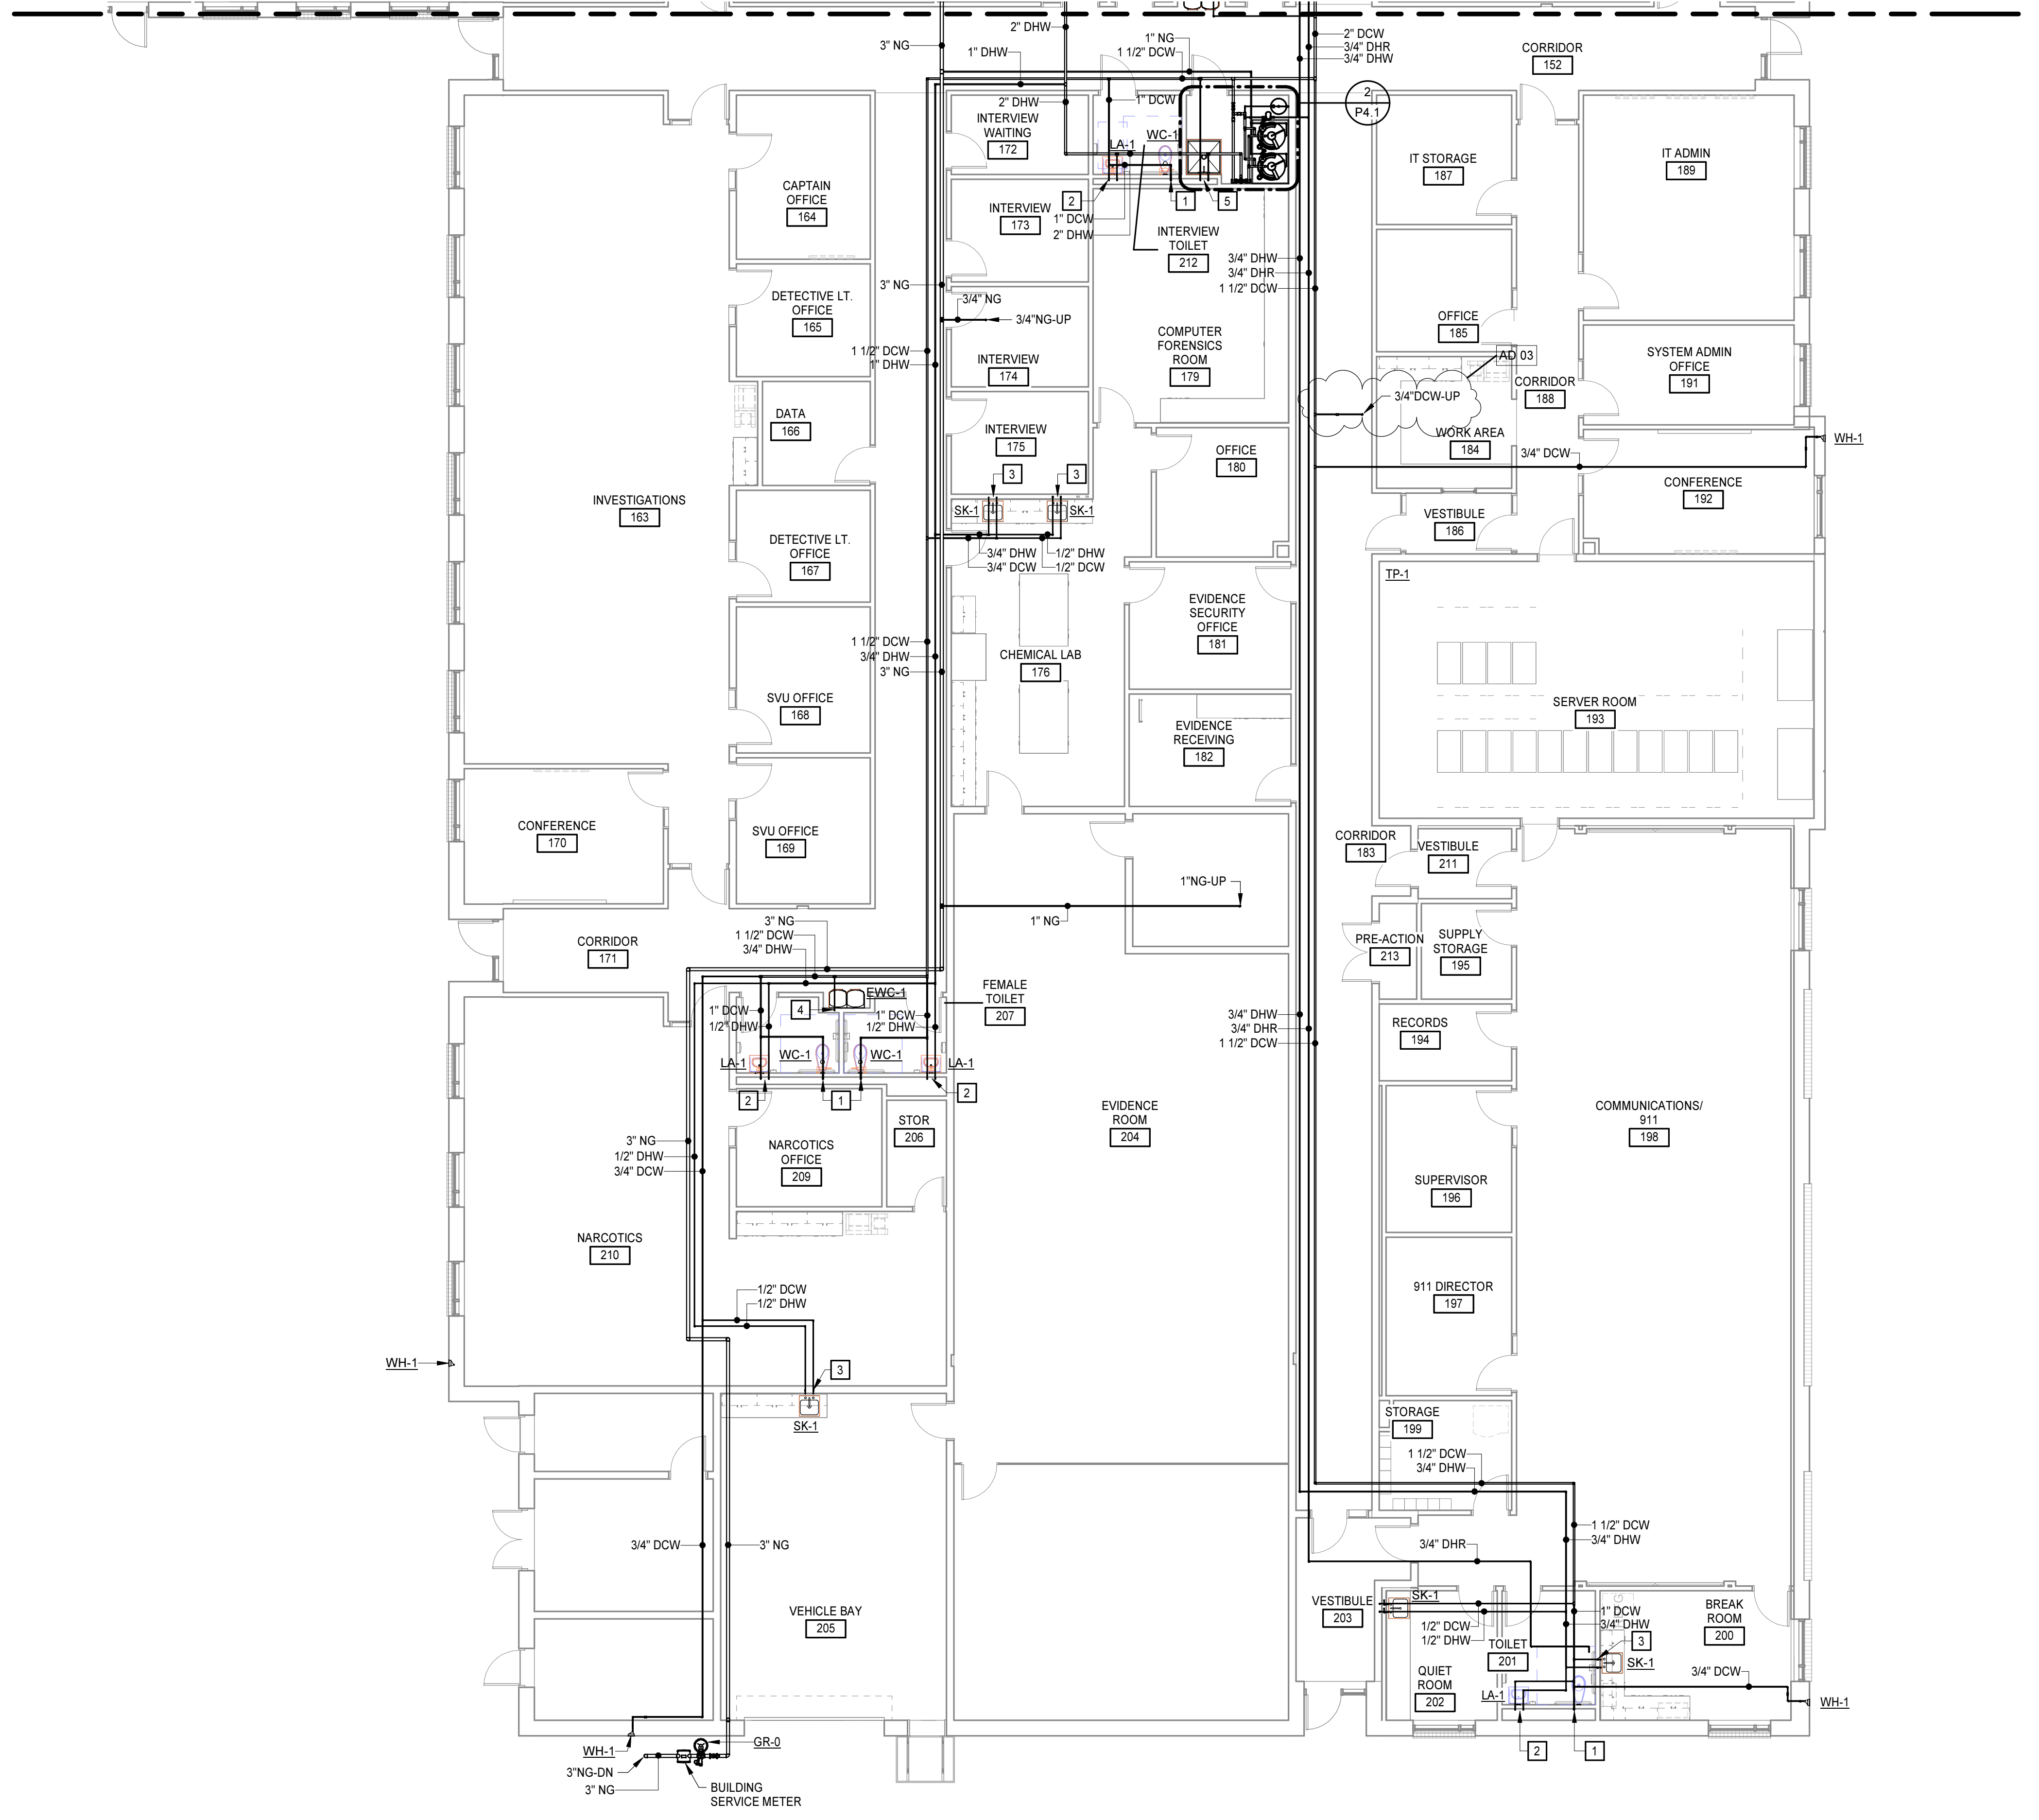


N
 FIRST FLOOR PLAN - PART D - DOMESTIC
 1/8" = 1'-0"

KEYNOTES	
APPLIES TO DRAWINGS P2.1.8	
REPRESENTED BY [n]	
1.	1" DCW-DN TO WATER CLOSET
2.	1/2" DCW & 1/2" DHW-DN TO LAVATORY
3.	1/2" DCW & 1/2" DHW-DN TO SINK
4.	1/2" DCW-DN TO DRINKING FOUNTAIN
5.	3/4" DCW & 3/4" DHW-DN TO MOP BASIN

MOSELEY ARCHITECTS

6210 ARDREY KELL ROAD - THE HUB AT WAWERLY, SUITE 425 - CHARLOTTE, NC 28277
 PHONE (704) 545-3755 FAX (704) 545-3754
 MOSELEYARCHITECTS.COM

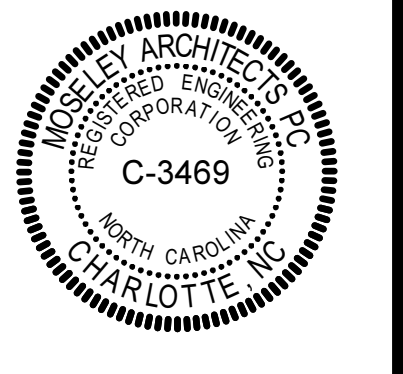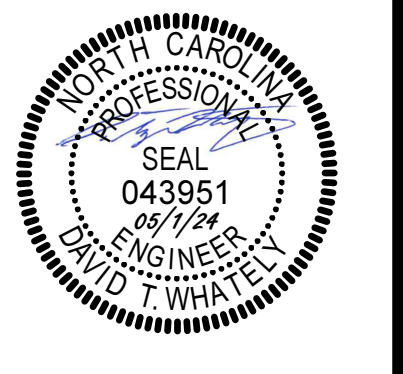


PENDER COUNTY LEC

PENDER COUNTY, NORTH CAROLINA
 OLD SAVANNAH ROAD BURGAW, NC

DATE	REVISIONS
06/12/2024	AD 03




FIRST FLOOR PLAN - PART D - DOMESTIC

P2.1.8


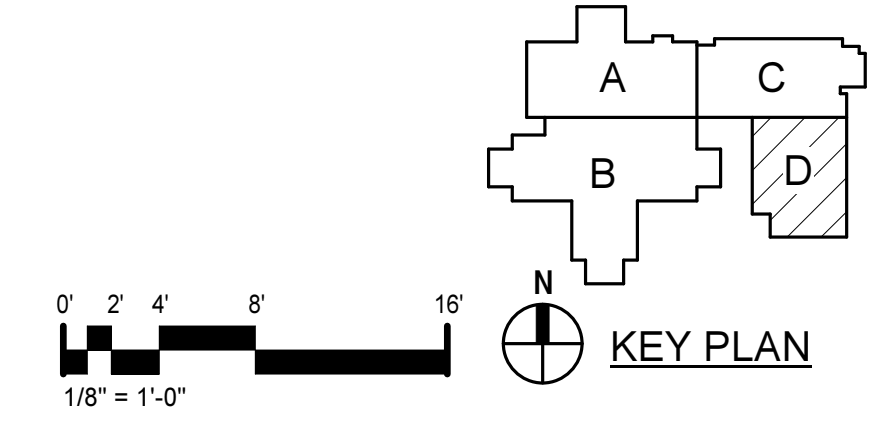


KEYNOTES
 APPLIES TO DRAWINGS P2.2.2
 REPRESENTED BY [A]

- 1" DCW-DN TO WATER CLOSET.
- 1/2" DCW & 1/2" DHW-DN TO LAVATORY.
- 1 1/2" DCW & 3/4" DHW-DN.
- PROVIDE THERMOSTATIC BALANCING VALVE STATION. REFER TO HOT WATER RECIRCULATION BRANCH CONNECTION DETAIL.
- 2 1/2" DCW, 2 1/2" DHW, & 1" DHR-DN.
- PROVIDE DOMESTIC COLD AND HOT WATER MOTORIZED ISOLATION VALVES. VALVES SHALL BE CONTROLLED BY THE SECURITY ELECTRONICS SYSTEM IN MASTER CONTROL ROOM. RELAY AND VALVE ACTUATOR POWER SHALL BE PROVIDED BY DIVISION 26. COORDINATE WITH SECURITY ELECTRONICS SYSTEM FOR SECURITY SYSTEM INTERFACE. REFER TO DOMESTIC WATER MOTORIZED ISOLATION VALVE DETAIL. ALL ZONE CELERLOCK MANUAL AN SOLENOID VALVE TO BE LOADED IN CHASE WALLS AND ACCESSIBLE FROM LADDER.
- DOMESTIC COLD WATER, DOMESTIC HOT WATER, DOMESTIC HOT WATER RETURN, AND NATURAL GAS LINES TO BE VALVED AND CAPPED ABOVE CEILING FOR FUTURE USE.
- 1/2" DCW & 1/2" DHW-DN.
- 3/4" DCW & 3/4" DHW-DN TO MOP BASIN.
- 3/4" DCW-DN.

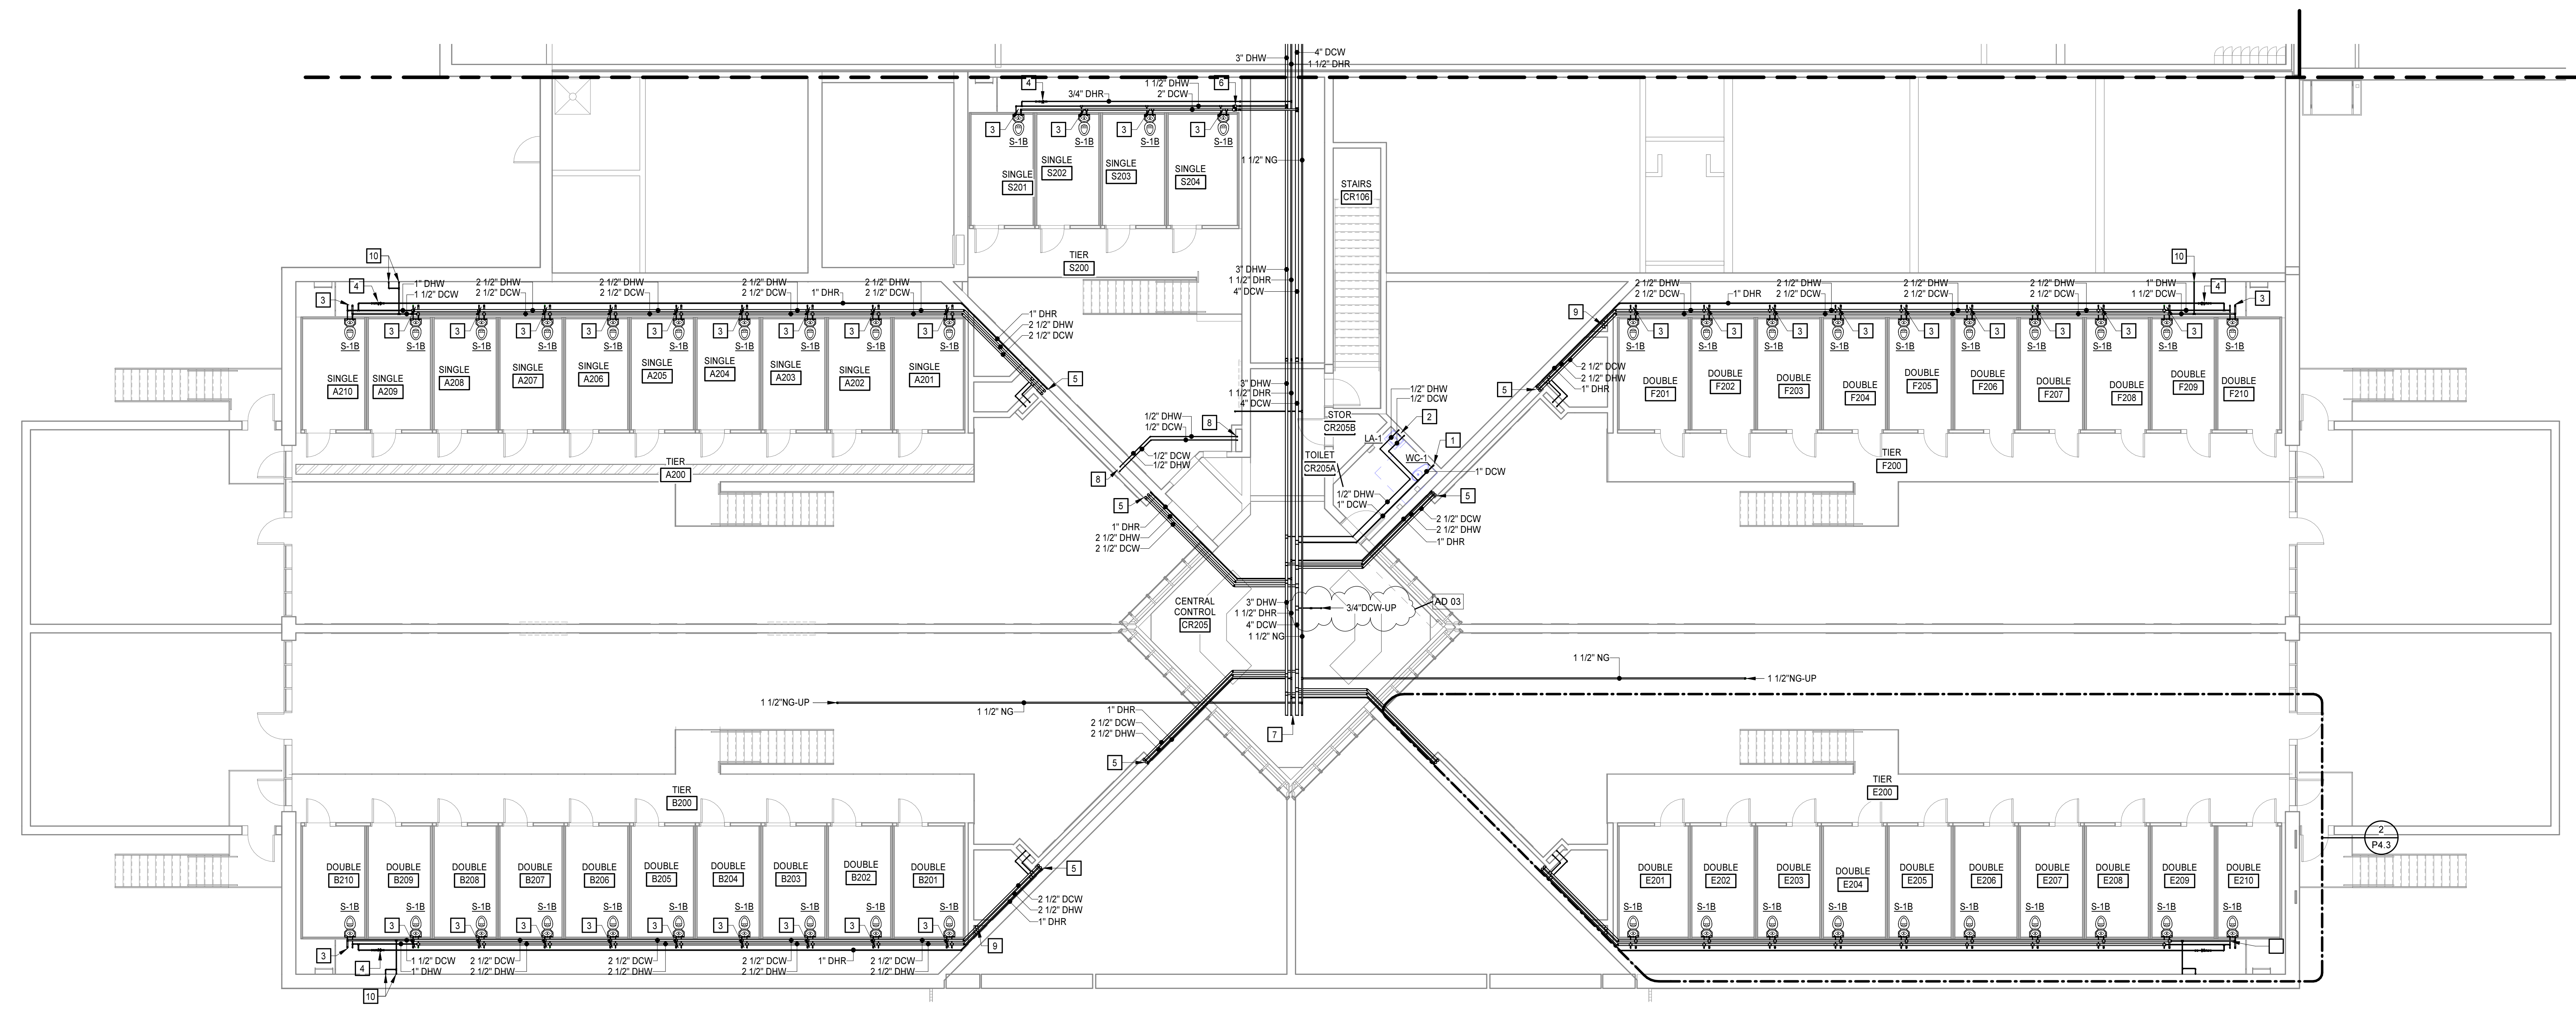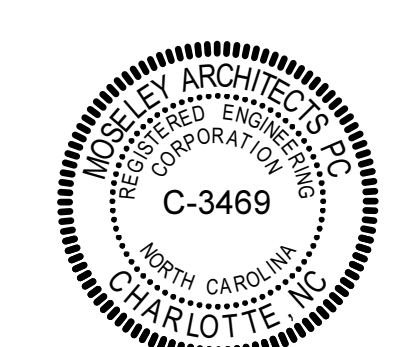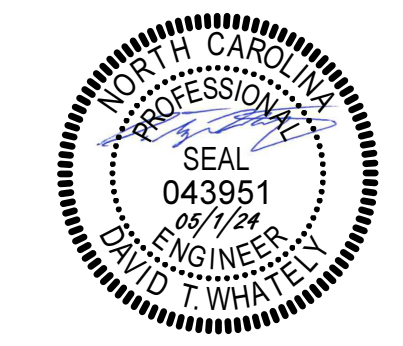

MEZZANINE LEVEL - PART B - DOMESTIC
 1/8" = 1'-0"

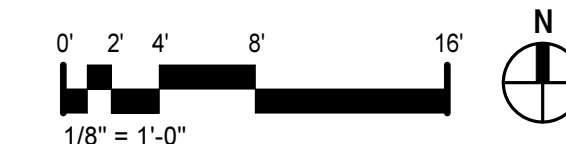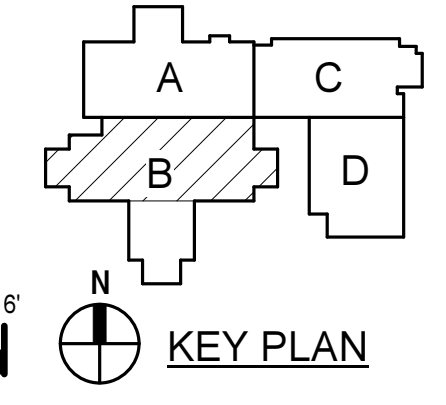

PENDER COUNTY LEC
 PENDER COUNTY, NORTH CAROLINA
 OLD SAVANNAH ROAD BURGAW, NC

PROJECT NO:	811888
DATE:	MAY 1, 2024
REVISIONS:	
DATE:	DESCRIPTION
06/12/2024	AD 03



MEZZANINE LEVEL - PART B - DOMESTIC

6/12/2024 9:29:03 AM



ROOF PLAN - PART A - PLUMBING

1/8" = 1'-0"

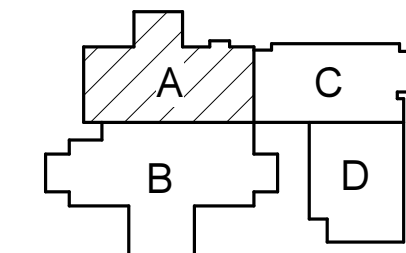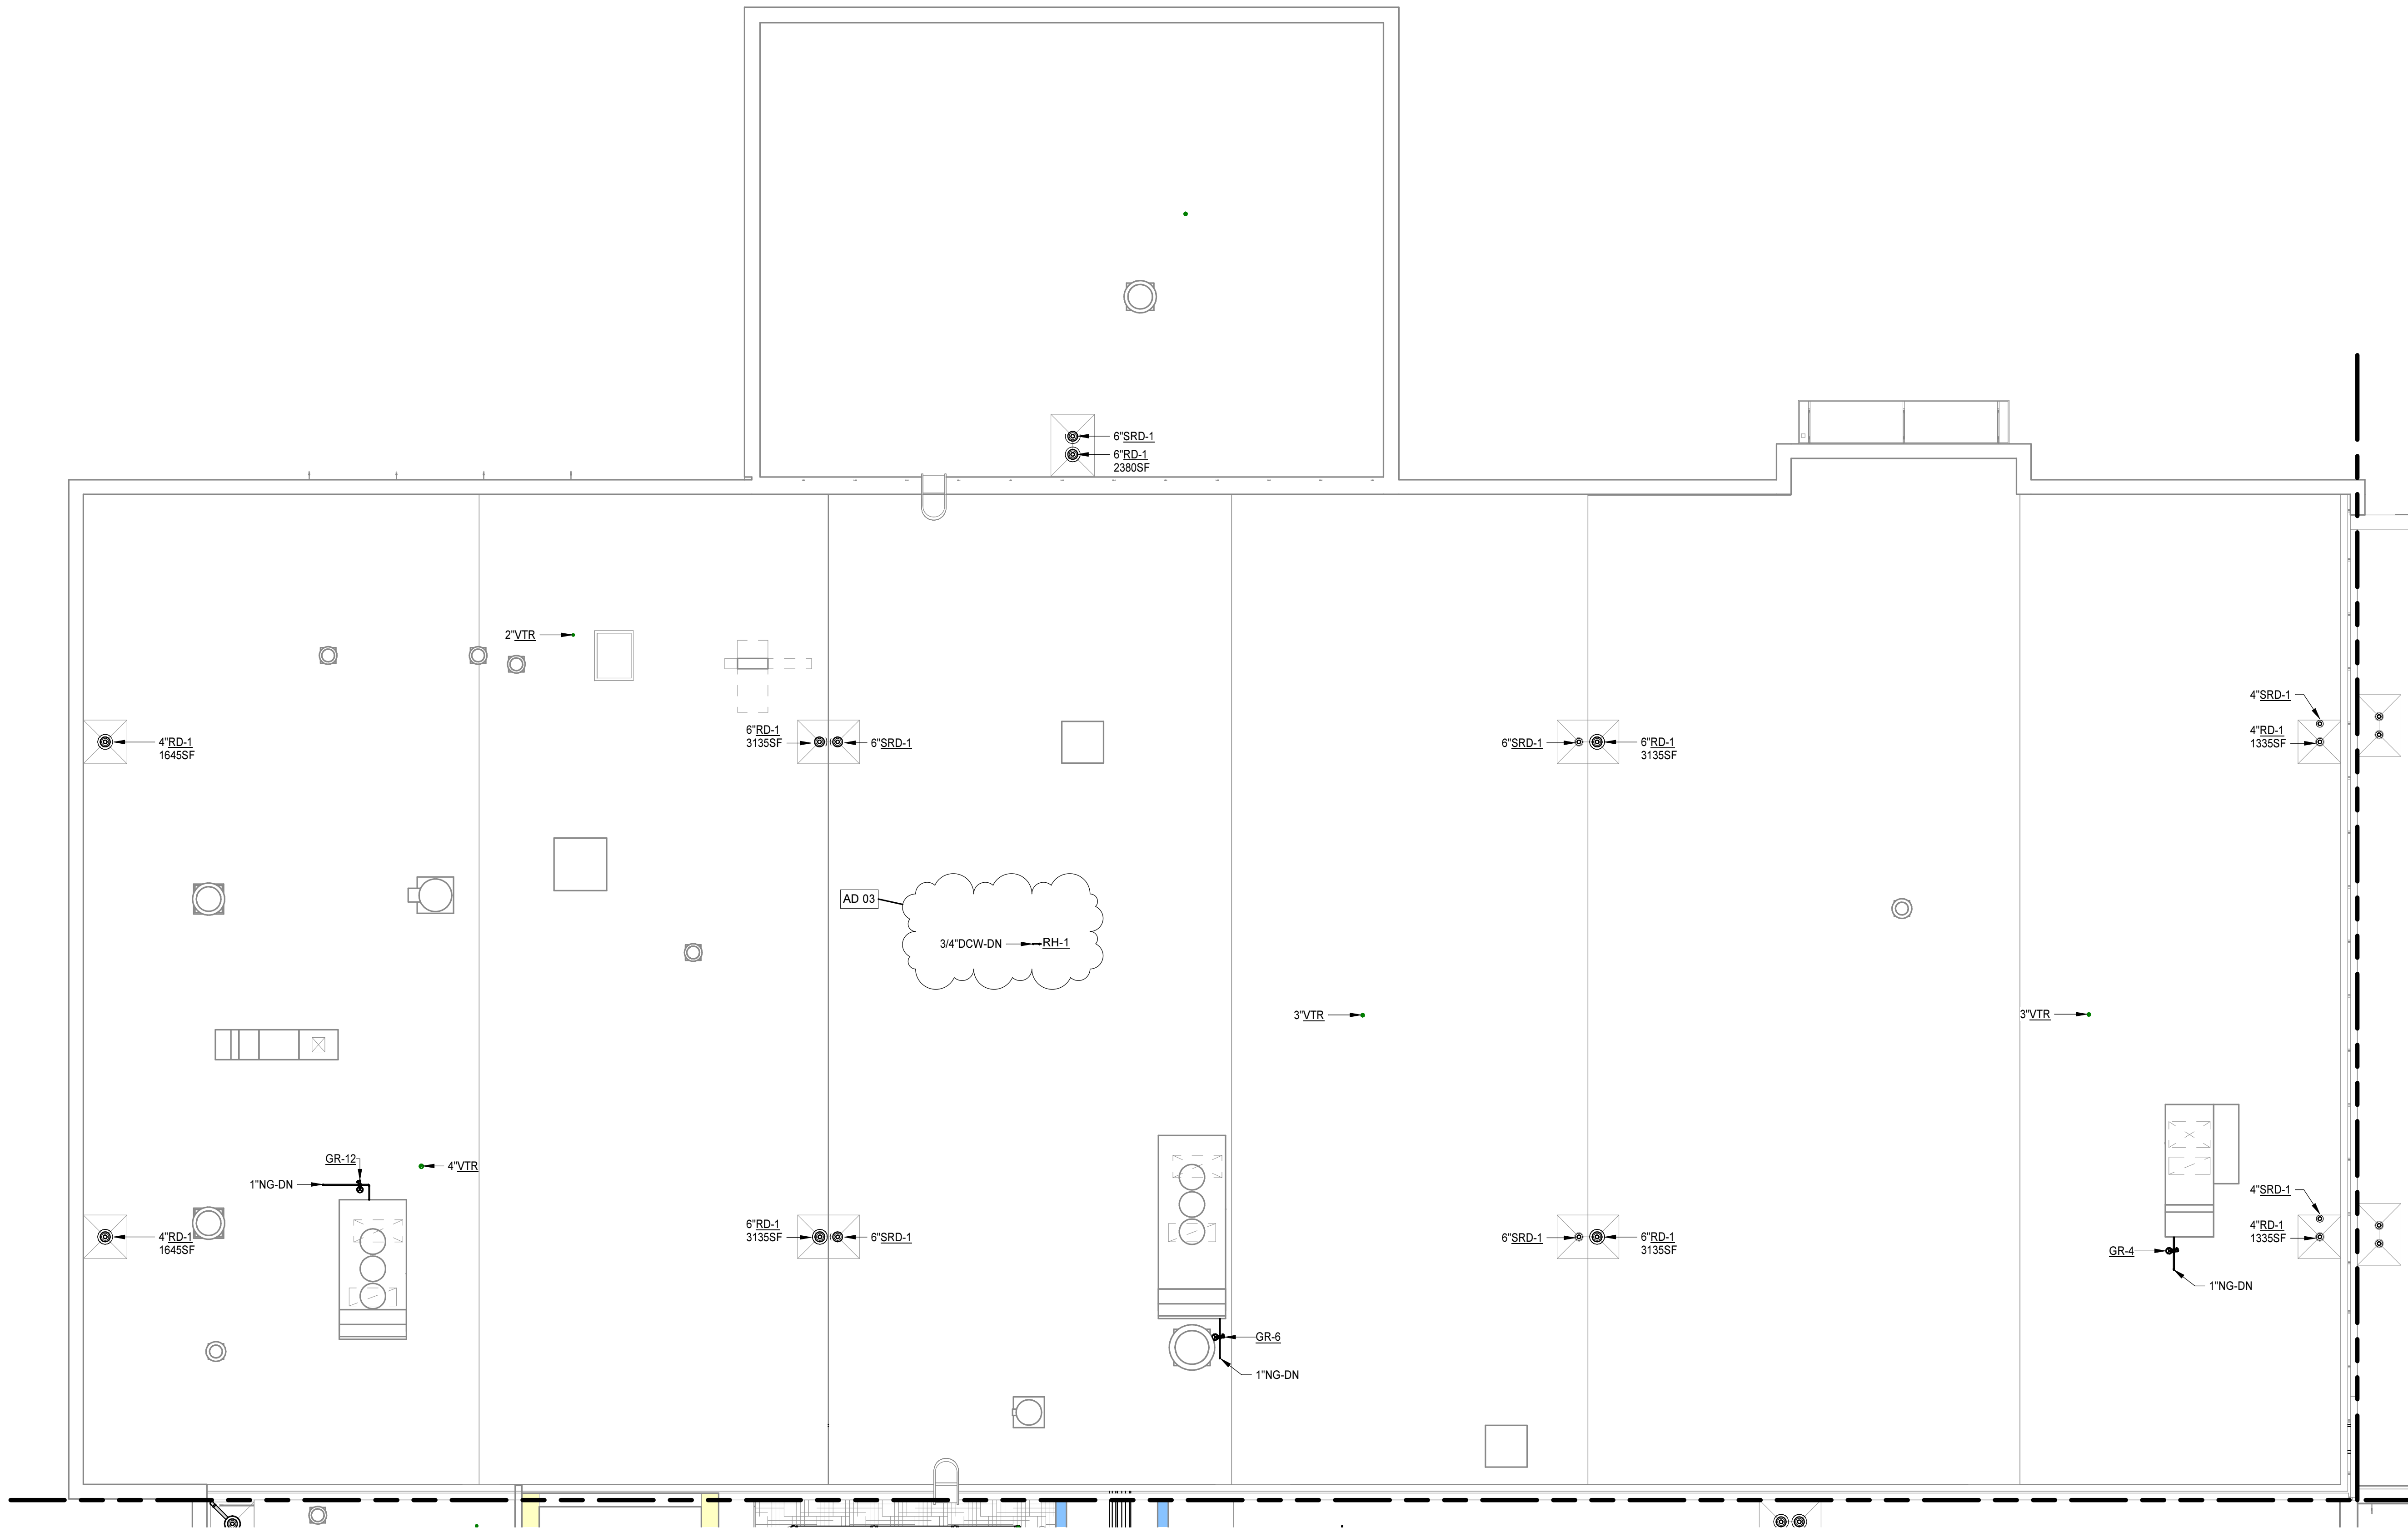


0' 2' 4' 8' 16'
1/8" = 1'-0" KEY PLAN

PROJECT NO:	611888
DATE:	MAY 1, 2024
REVISIONS	
DATE	DESCRIPTION
06/12/2024	AD 03

ROOF PLAN - PART A - PLUMBING

PENDER COUNTY LEC

PENDER COUNTY, NORTH CAROLINA
OLD SAVANNAH ROAD BURGAW, NC

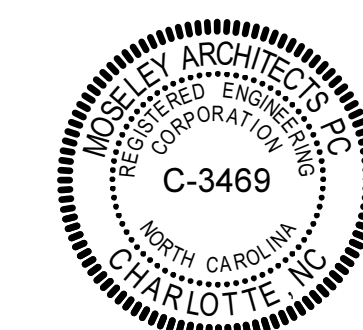


MOSELEYARCHITECTS

6210 ARDREY KELL ROAD - THE HUB AT WAVERLY, SUITE #25 • CHARLOTTE, NC 28277
PHONE (704) 540-3755 FAX (704) 540-3754
MOSELEYARCHITECTS.COM



P2.3.1

6/12/2024 9:29:07 AM

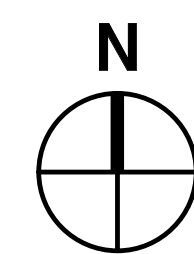

ROOF PLAN - PART B - PLUMBING

1/8" = 1'-0"

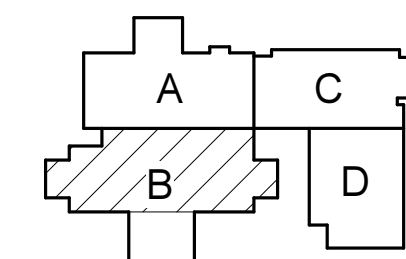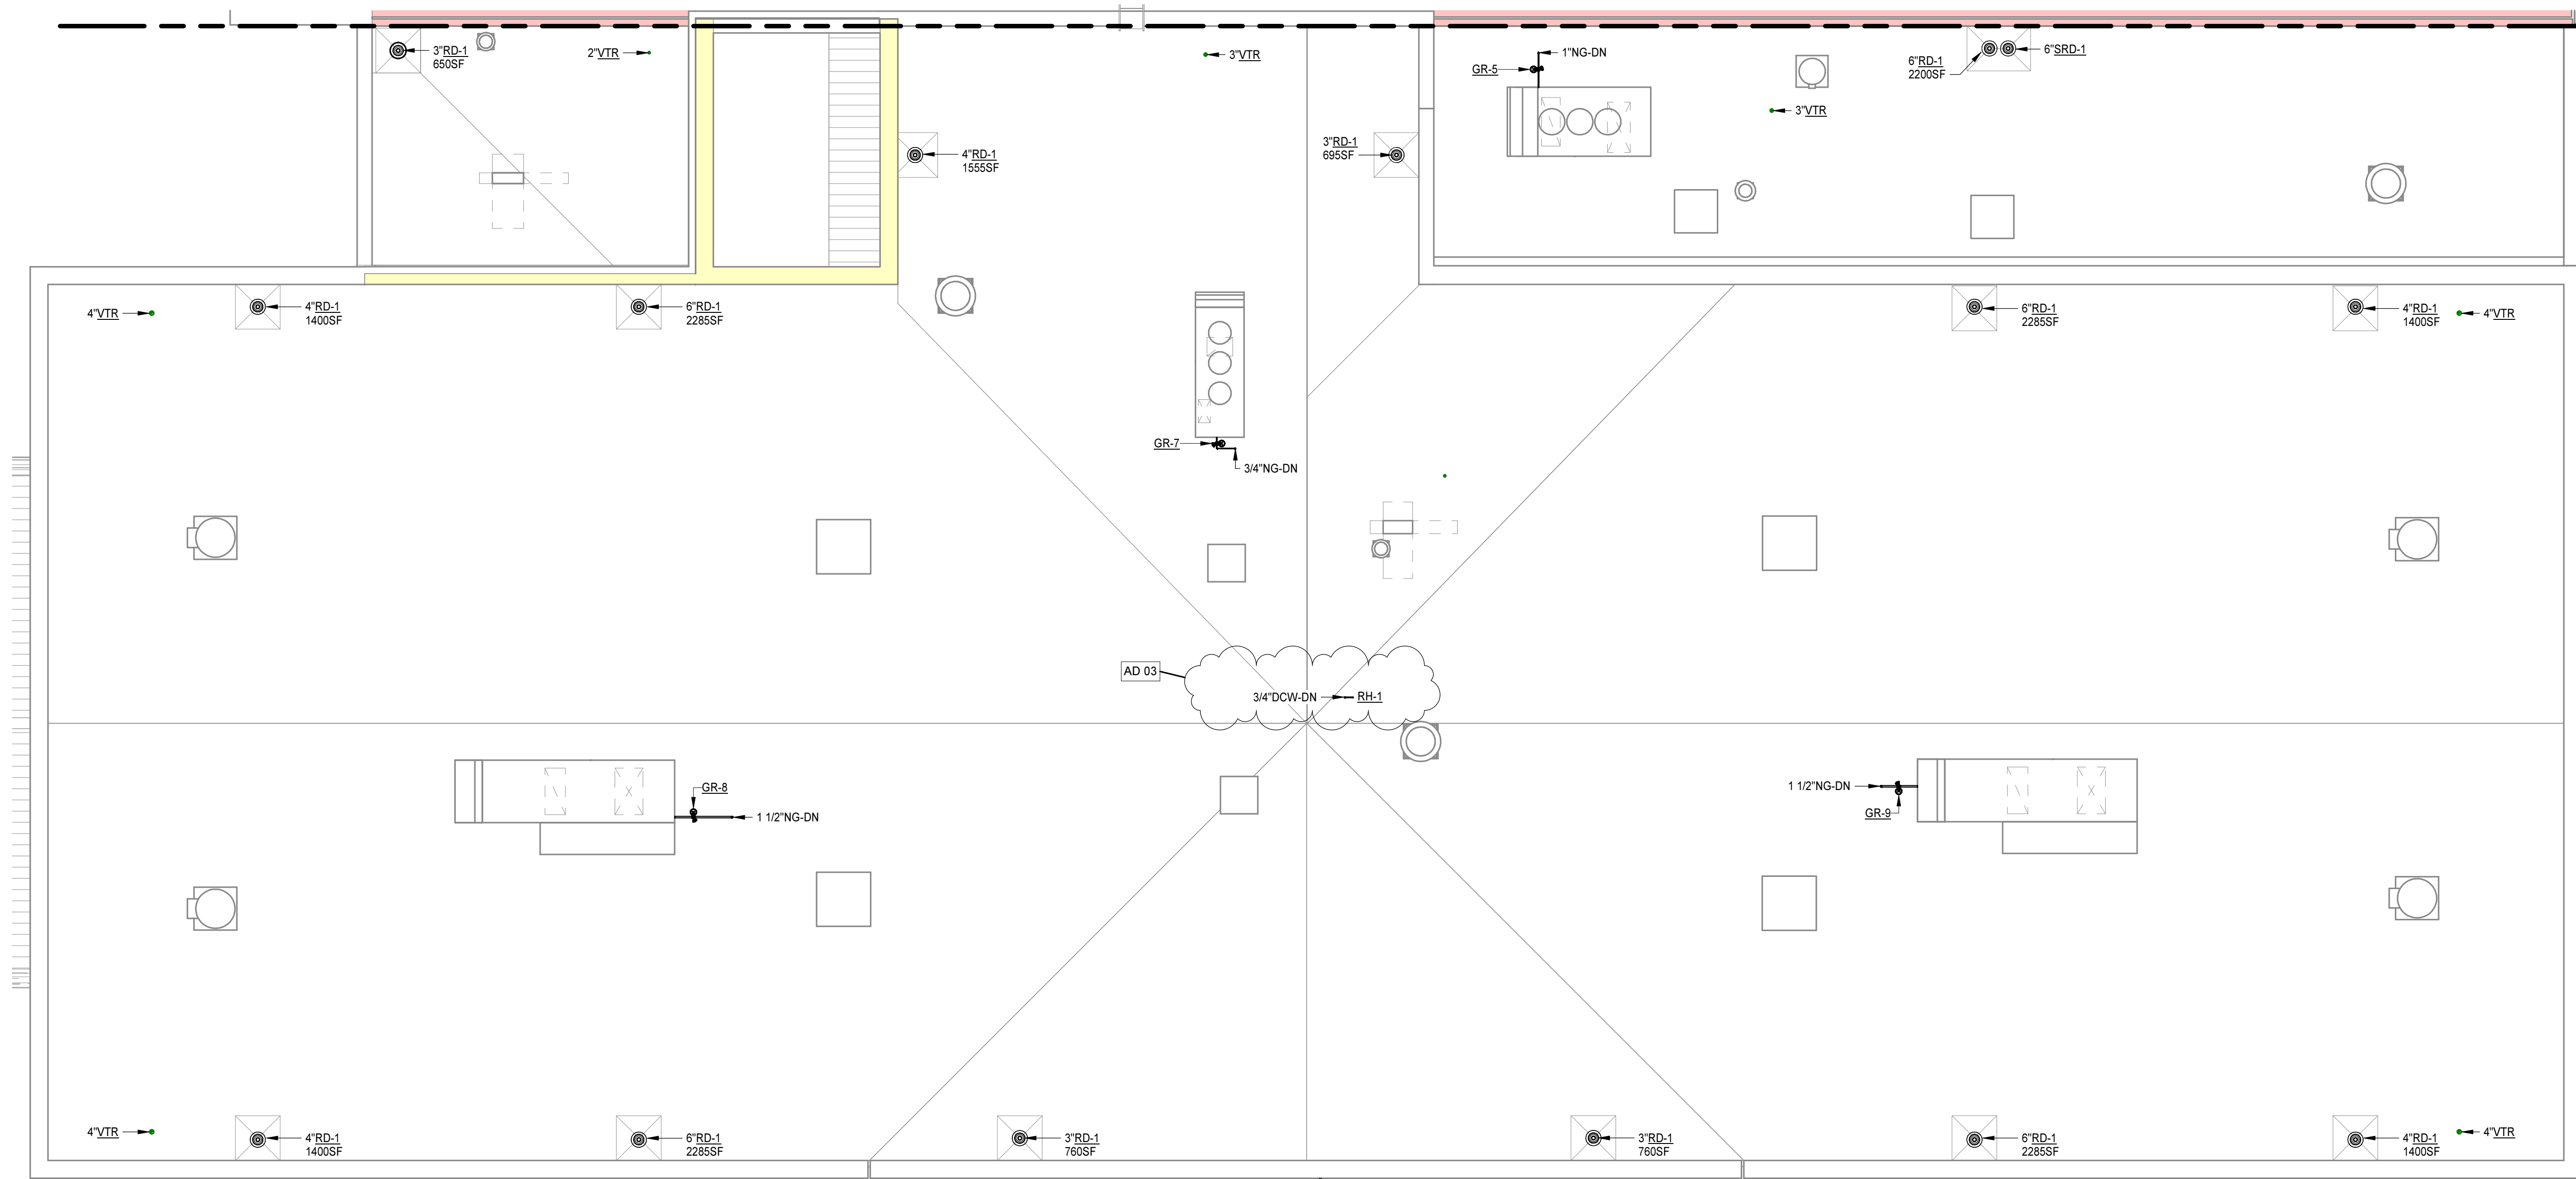

0' 2' 4' 8' 16'
1/8" = 1'-0"

KEY PLAN



PENDER COUNTY LEC

PENDER COUNTY, NORTH CAROLINA
OLD SAVANNAH ROAD BURGAW, NC

PROJECT NO:	611888
DATE:	MAY 1, 2024
REVISIONS	
DATE	DESCRIPTION
06/12/2024	AD 03

ROOF PLAN - PART B - PLUMBING

P2.3.2

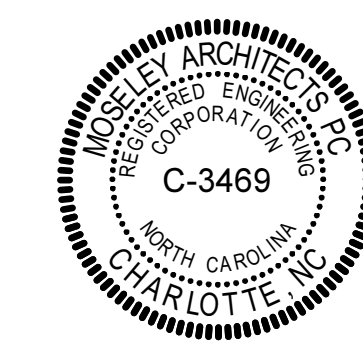
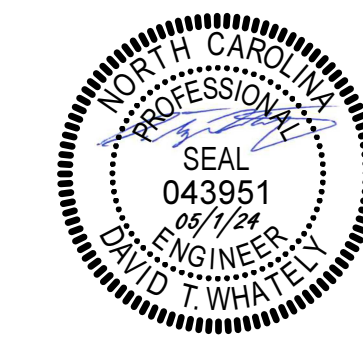


MOSELEYARCHITECTS

6210 ARDREY KELL ROAD - THE HUB AT WAVERLY, SUITE 425 - CHARLOTTE, NC 28277
PHONE (704) 540-3755 FAX (704) 540-3754
MOSELEYARCHITECTS.COM

6/12/2024 9:29:08 AM



ROOF PLAN - PART C - PLUMBING
1/8" = 1'-0"

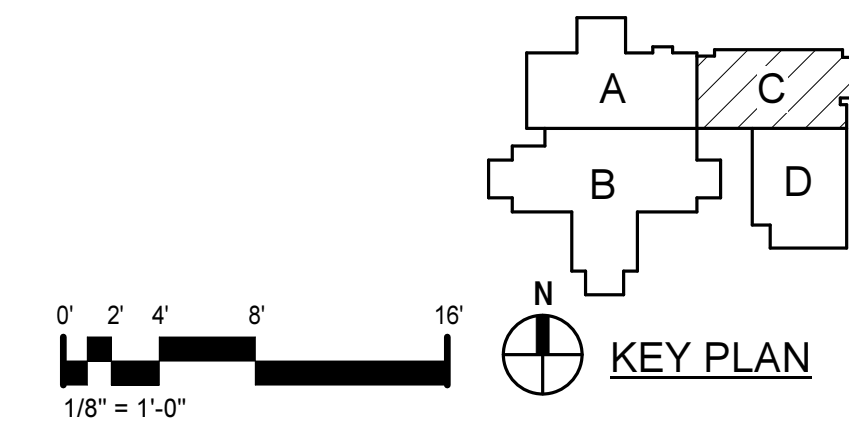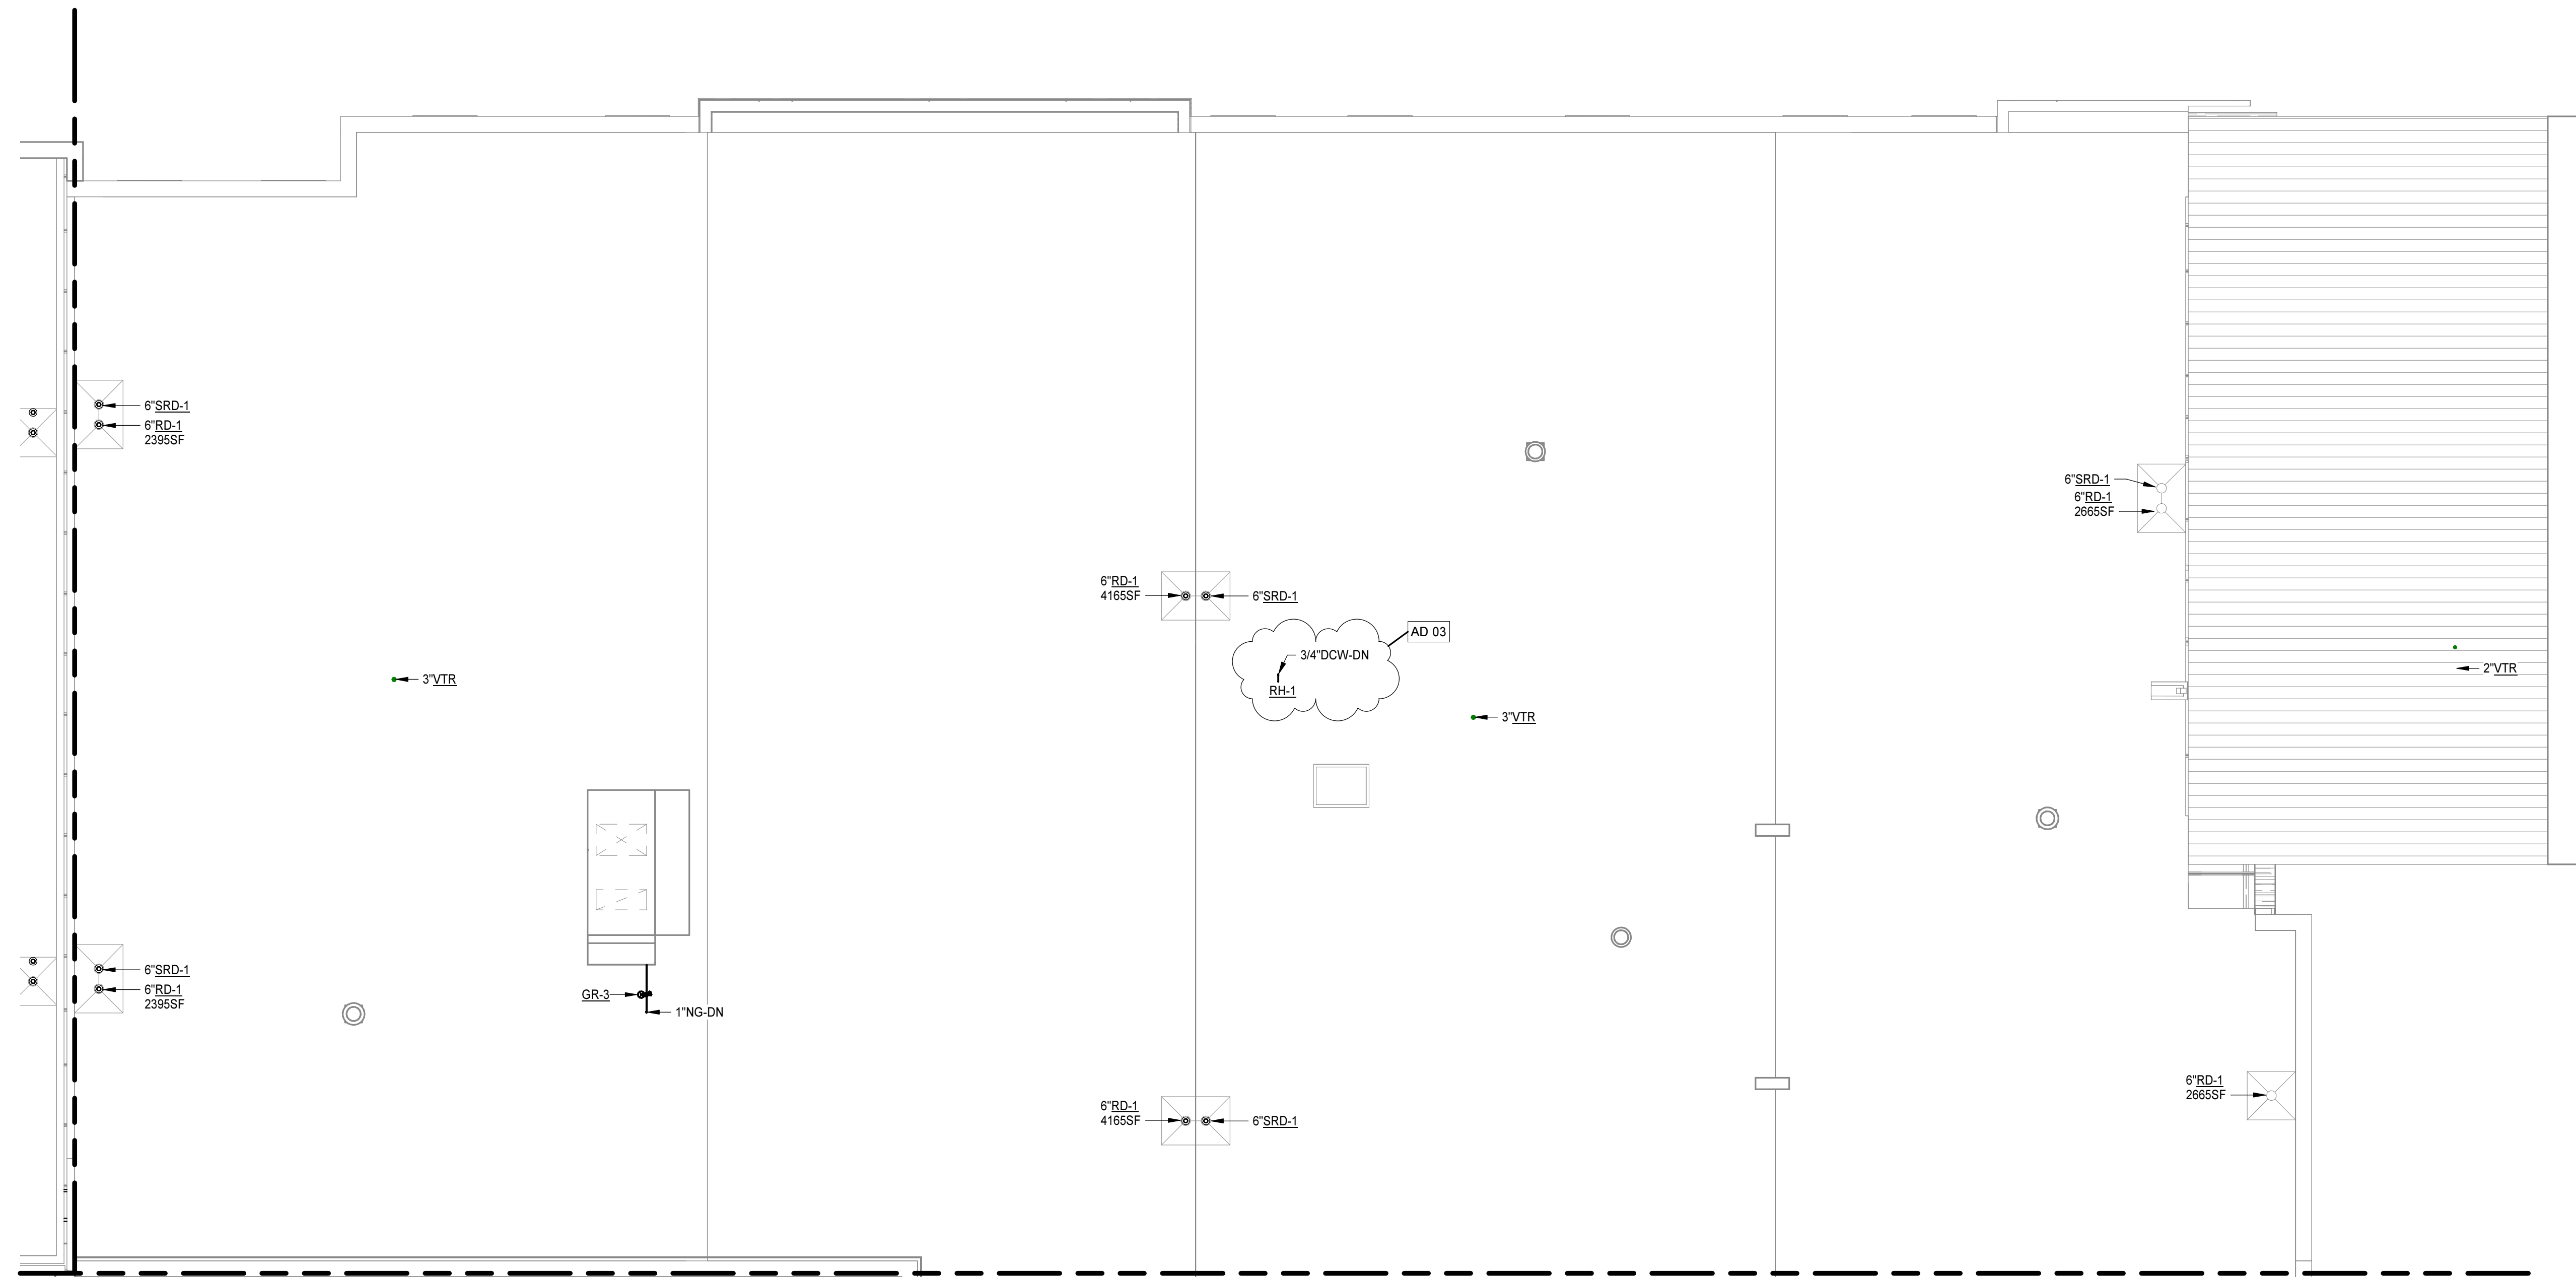

PROJECT NO:	611888
DATE:	MAY 1, 2024
REVISIONS	
DATE	DESCRIPTION
06/12/2024	AD 03

ROOF PLAN - PART C - PLUMBING

PENDER COUNTY LEC
PENDER COUNTY, NORTH CAROLINA
OLD SAVANNAH ROAD BURGAW, NC

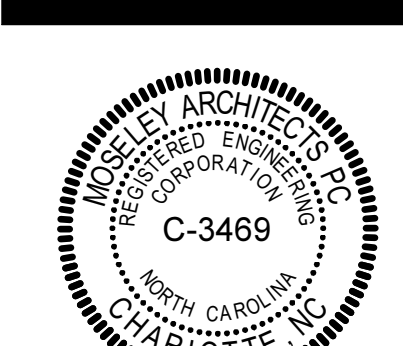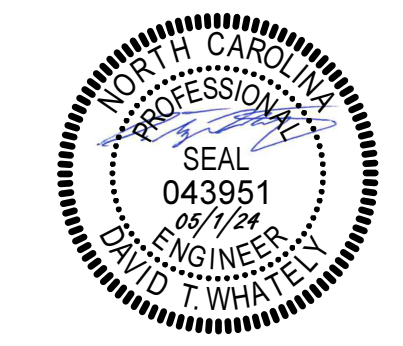

MOSELEYARCHITECTS

6210 ARDREY KELL ROAD - THE HUB AT WAVERLY, SUITE 425 • CHARLOTTE, NC 28277
PHONE (704) 540-3755 FAX (704) 540-3754
MOSELEYARCHITECTS.COM



P2.3.3

6/12/2024 9:29:11 AM

J
H
G
F
E
D
C
B
A

1 2 3 4 5 6 7 8 9 10


ROOF PLAN - PART D - PLUMBING
1/8" = 1'-0"

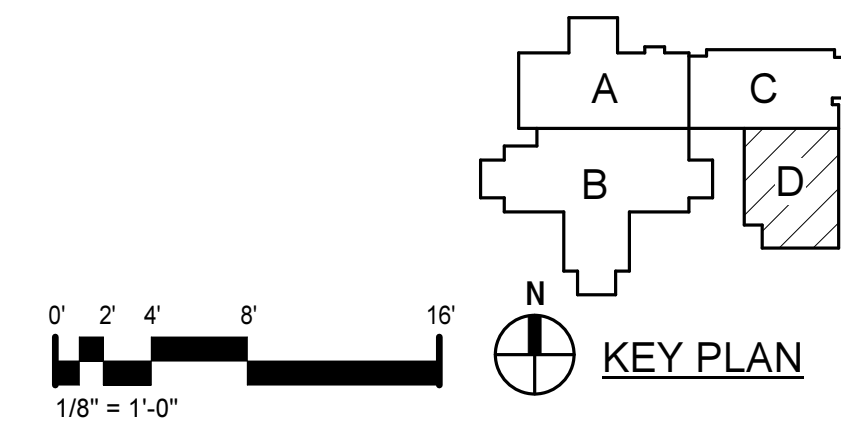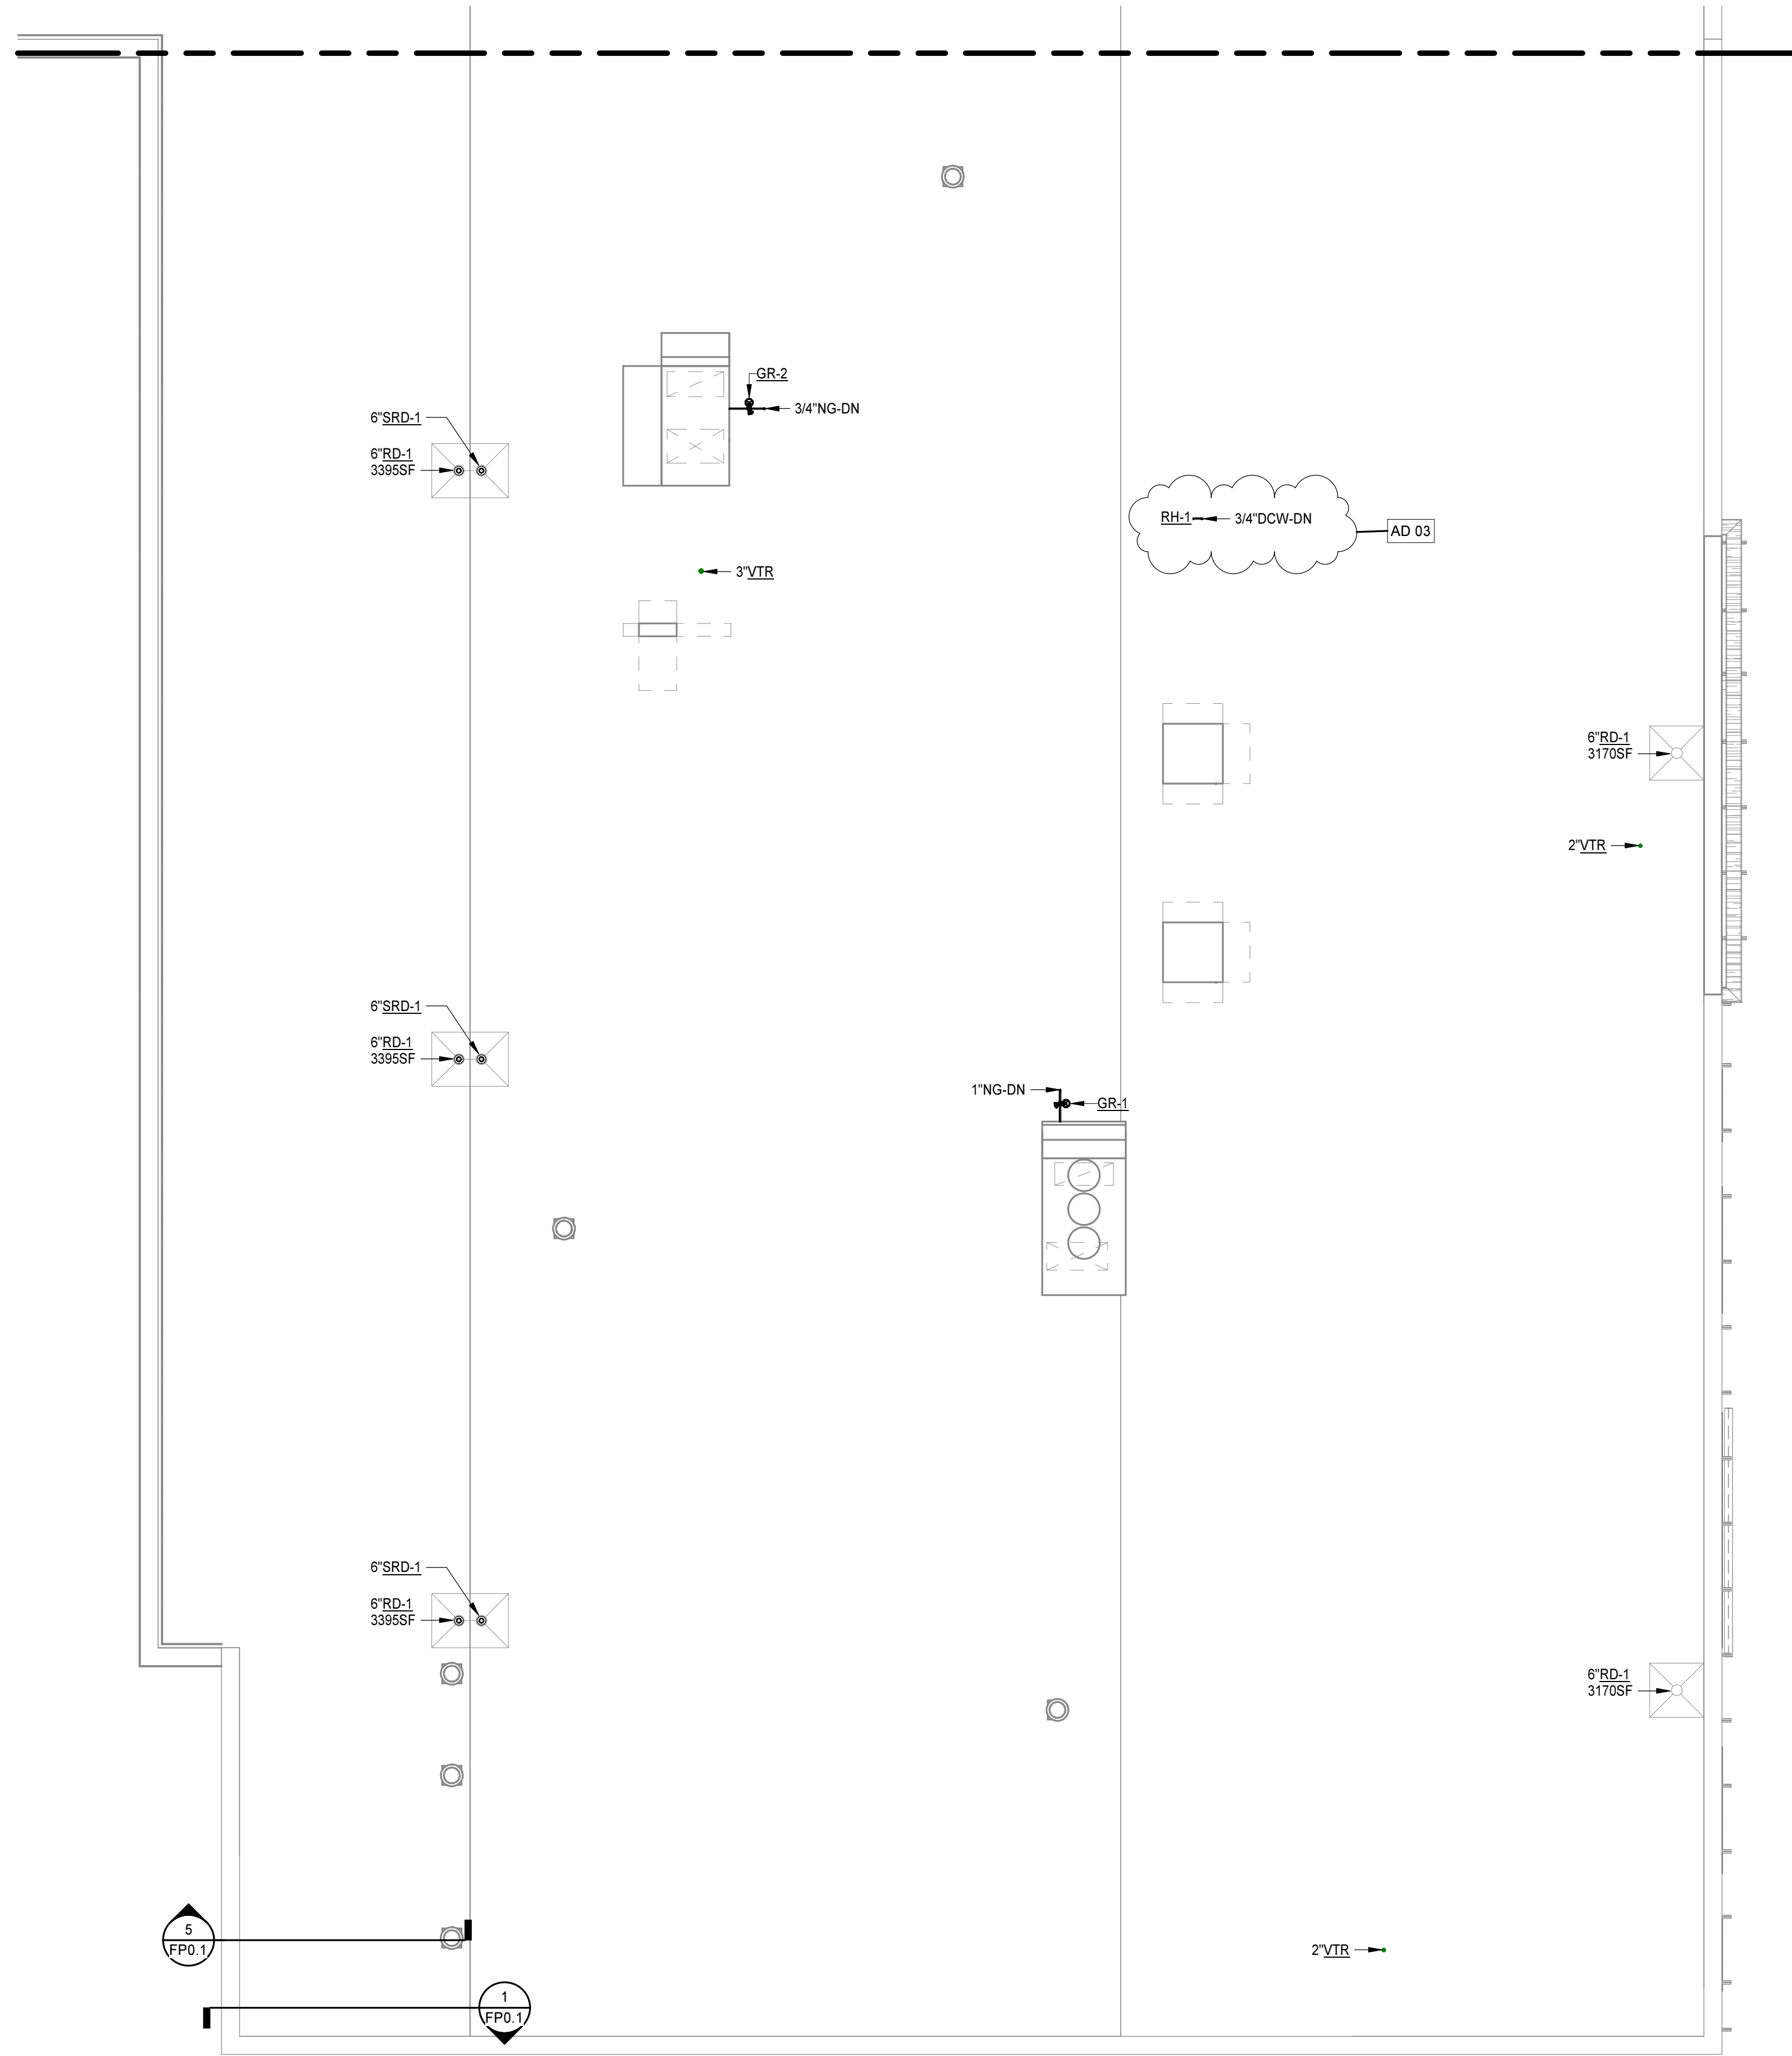

PROJECT NO:	811888
DATE:	MAY 1, 2024
REVISIONS	
DATE	DESCRIPTION
06/12/2024	AD 03

ROOF PLAN - PART D - PLUMBING

PENDER COUNTY LEC
PENDER COUNTY, NORTH CAROLINA
OLD SAVANNAH ROAD BURGAW, NC

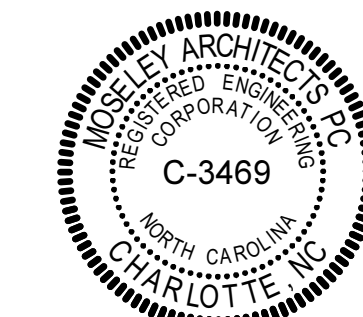

MOSELEYARCHITECTS

6210 ARDREY KELL ROAD - THE HUB AT WAVERLY, SUITE 425 - CHARLOTTE, NC 28277
PHONE (704) 545-3755 FAX (704) 545-3754
MOSELEYARCHITECTS.COM


P2.3.4

6/12/2024 9:29:19 AM




FOUNDATION PLAN - PART B - PLUMBING - ALTERNATE


1/8" = 1'-0"

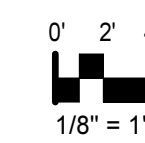



1/8" = 1'-0"

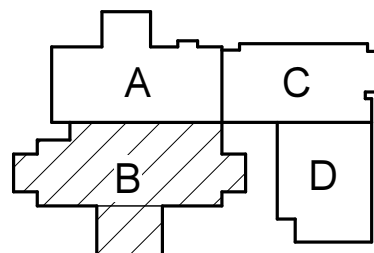


KEY PLAN

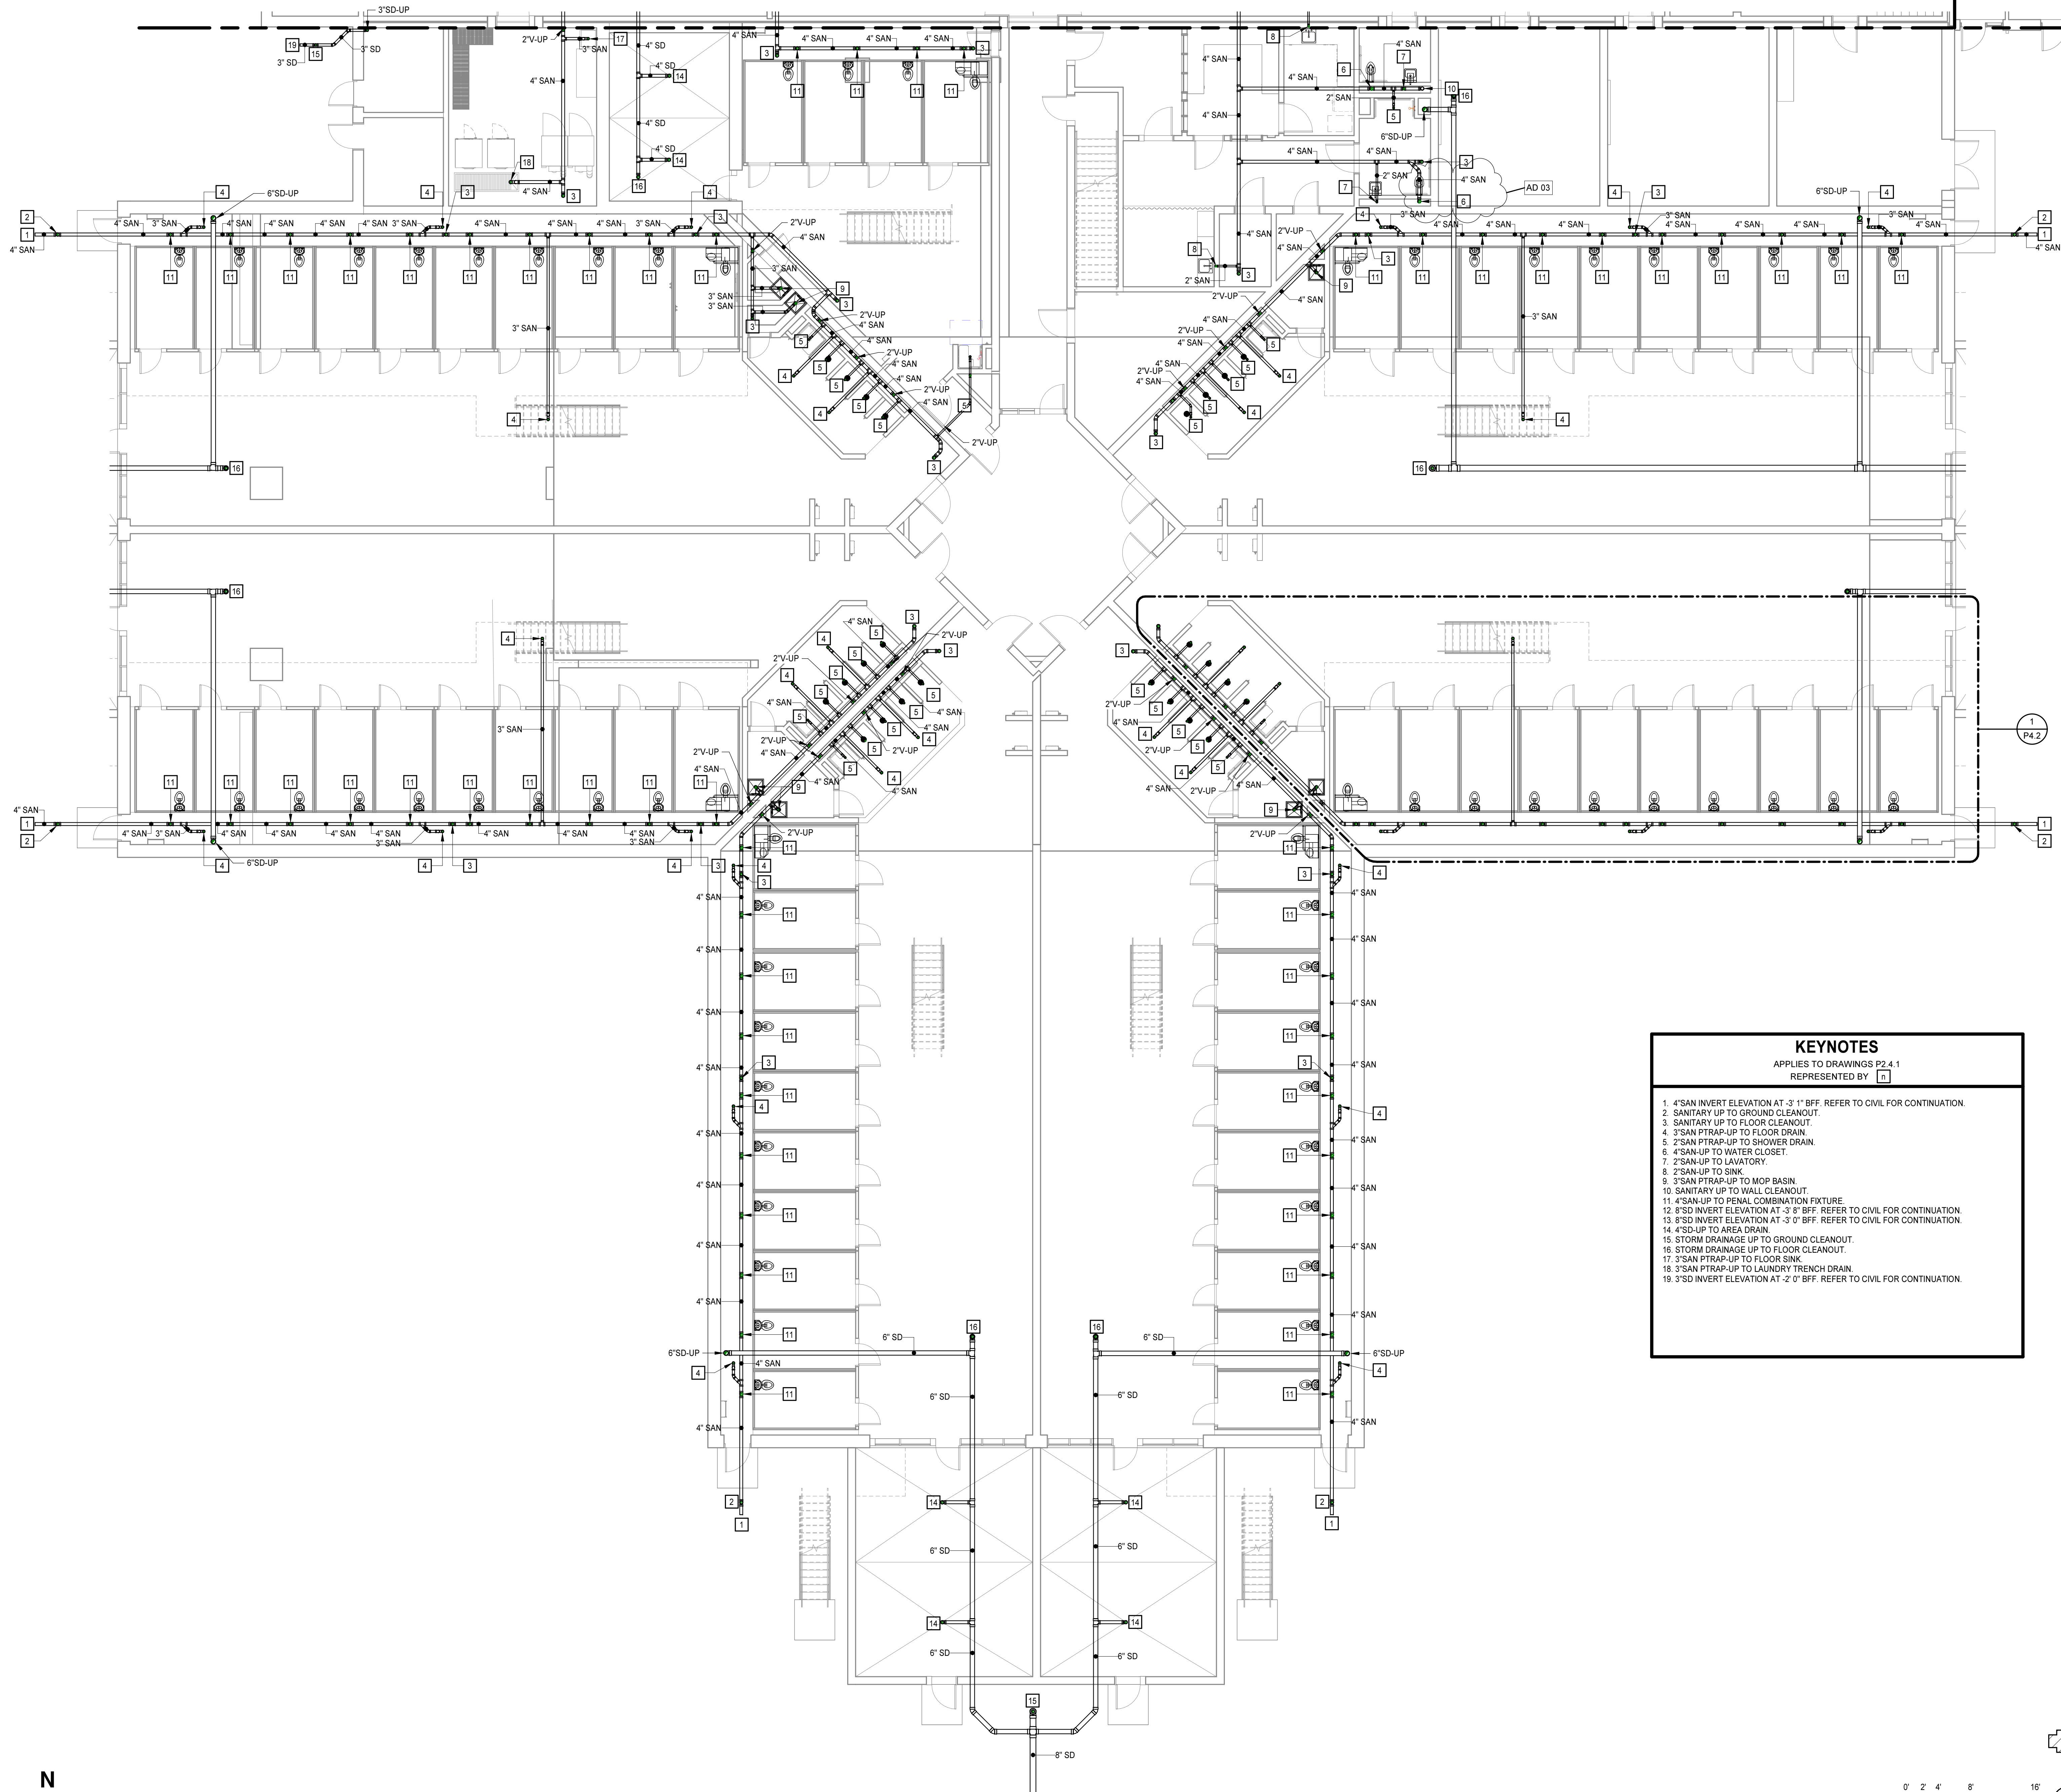

KEYNOTES	
APPLIES TO DRAWINGS P2.4.1	
REPRESENTED BY [Symbol]	
1.	4" SAN INVERT ELEVATION AT -3' 1" BFF. REFER TO CIVIL FOR CONTINUATION.
2.	SANITARY UP TO GROUND CLEANOUT.
3.	SANITARY UP TO FLOOR CLEANOUT.
4.	3" SAN PTRAP-UP TO FLOOR DRAIN.
5.	2" SAN PTRAP-UP TO SHOWER DRAIN.
6.	4" SAN UP TO WATER CLOSET.
7.	2" SAN UP TO LAVATORY.
8.	2" SAN UP TO SINK.
9.	3" SAN PTRAP-UP TO MOP BASIN.
10.	SANITARY UP TO WALL CLEANOUT.
11.	4" SAN UP TO PENAL COMBINATION FIXTURE.
12.	8" SD INVERT ELEVATION AT -3' 8" BFF. REFER TO CIVIL FOR CONTINUATION.
13.	8" SD INVERT ELEVATION AT -3' 0" BFF. REFER TO CIVIL FOR CONTINUATION.
14.	4" SD UP TO AREA DRAIN.
15.	STORM DRAINAGE UP TO GROUND CLEANOUT.
16.	STORM DRAINAGE UP TO FLOOR CLEANOUT.
17.	3" SAN PTRAP-UP TO FLOOR SINK.
18.	3" SAN PTRAP-UP TO LAUNDRY TRENCH DRAIN.
19.	3" SD INVERT ELEVATION AT -2' 0" BFF. REFER TO CIVIL FOR CONTINUATION.

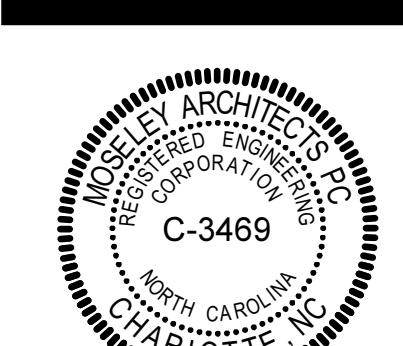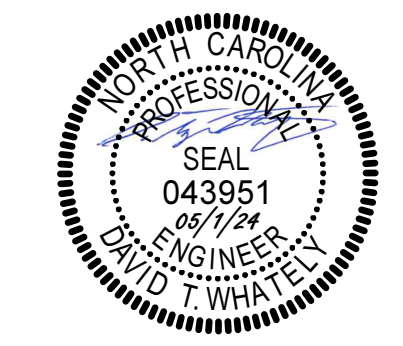

PROJECT NO.	REVISIONS
611888	MAY 1, 2024
DATE	DESCRIPTION
06/12/2024	AD 03

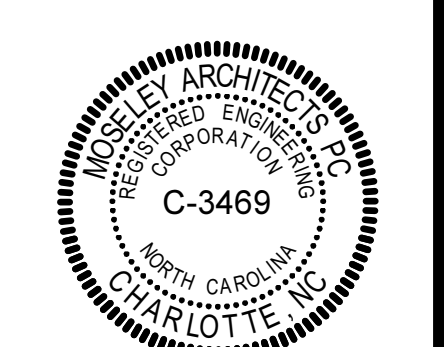


PENDER COUNTY LEC

PENDER COUNTY, NORTH CAROLINA
 OLD SAVANNAH ROAD BURGAW, NC

PROJECT NO:	811888
DATE:	MAY 1, 2024
REVISIONS	
DATE	DESCRIPTION
06/12/2024	AD 03


FIRST FLOOR PLAN - PART B - SANITARY - ALTERNATE

P2.4.2


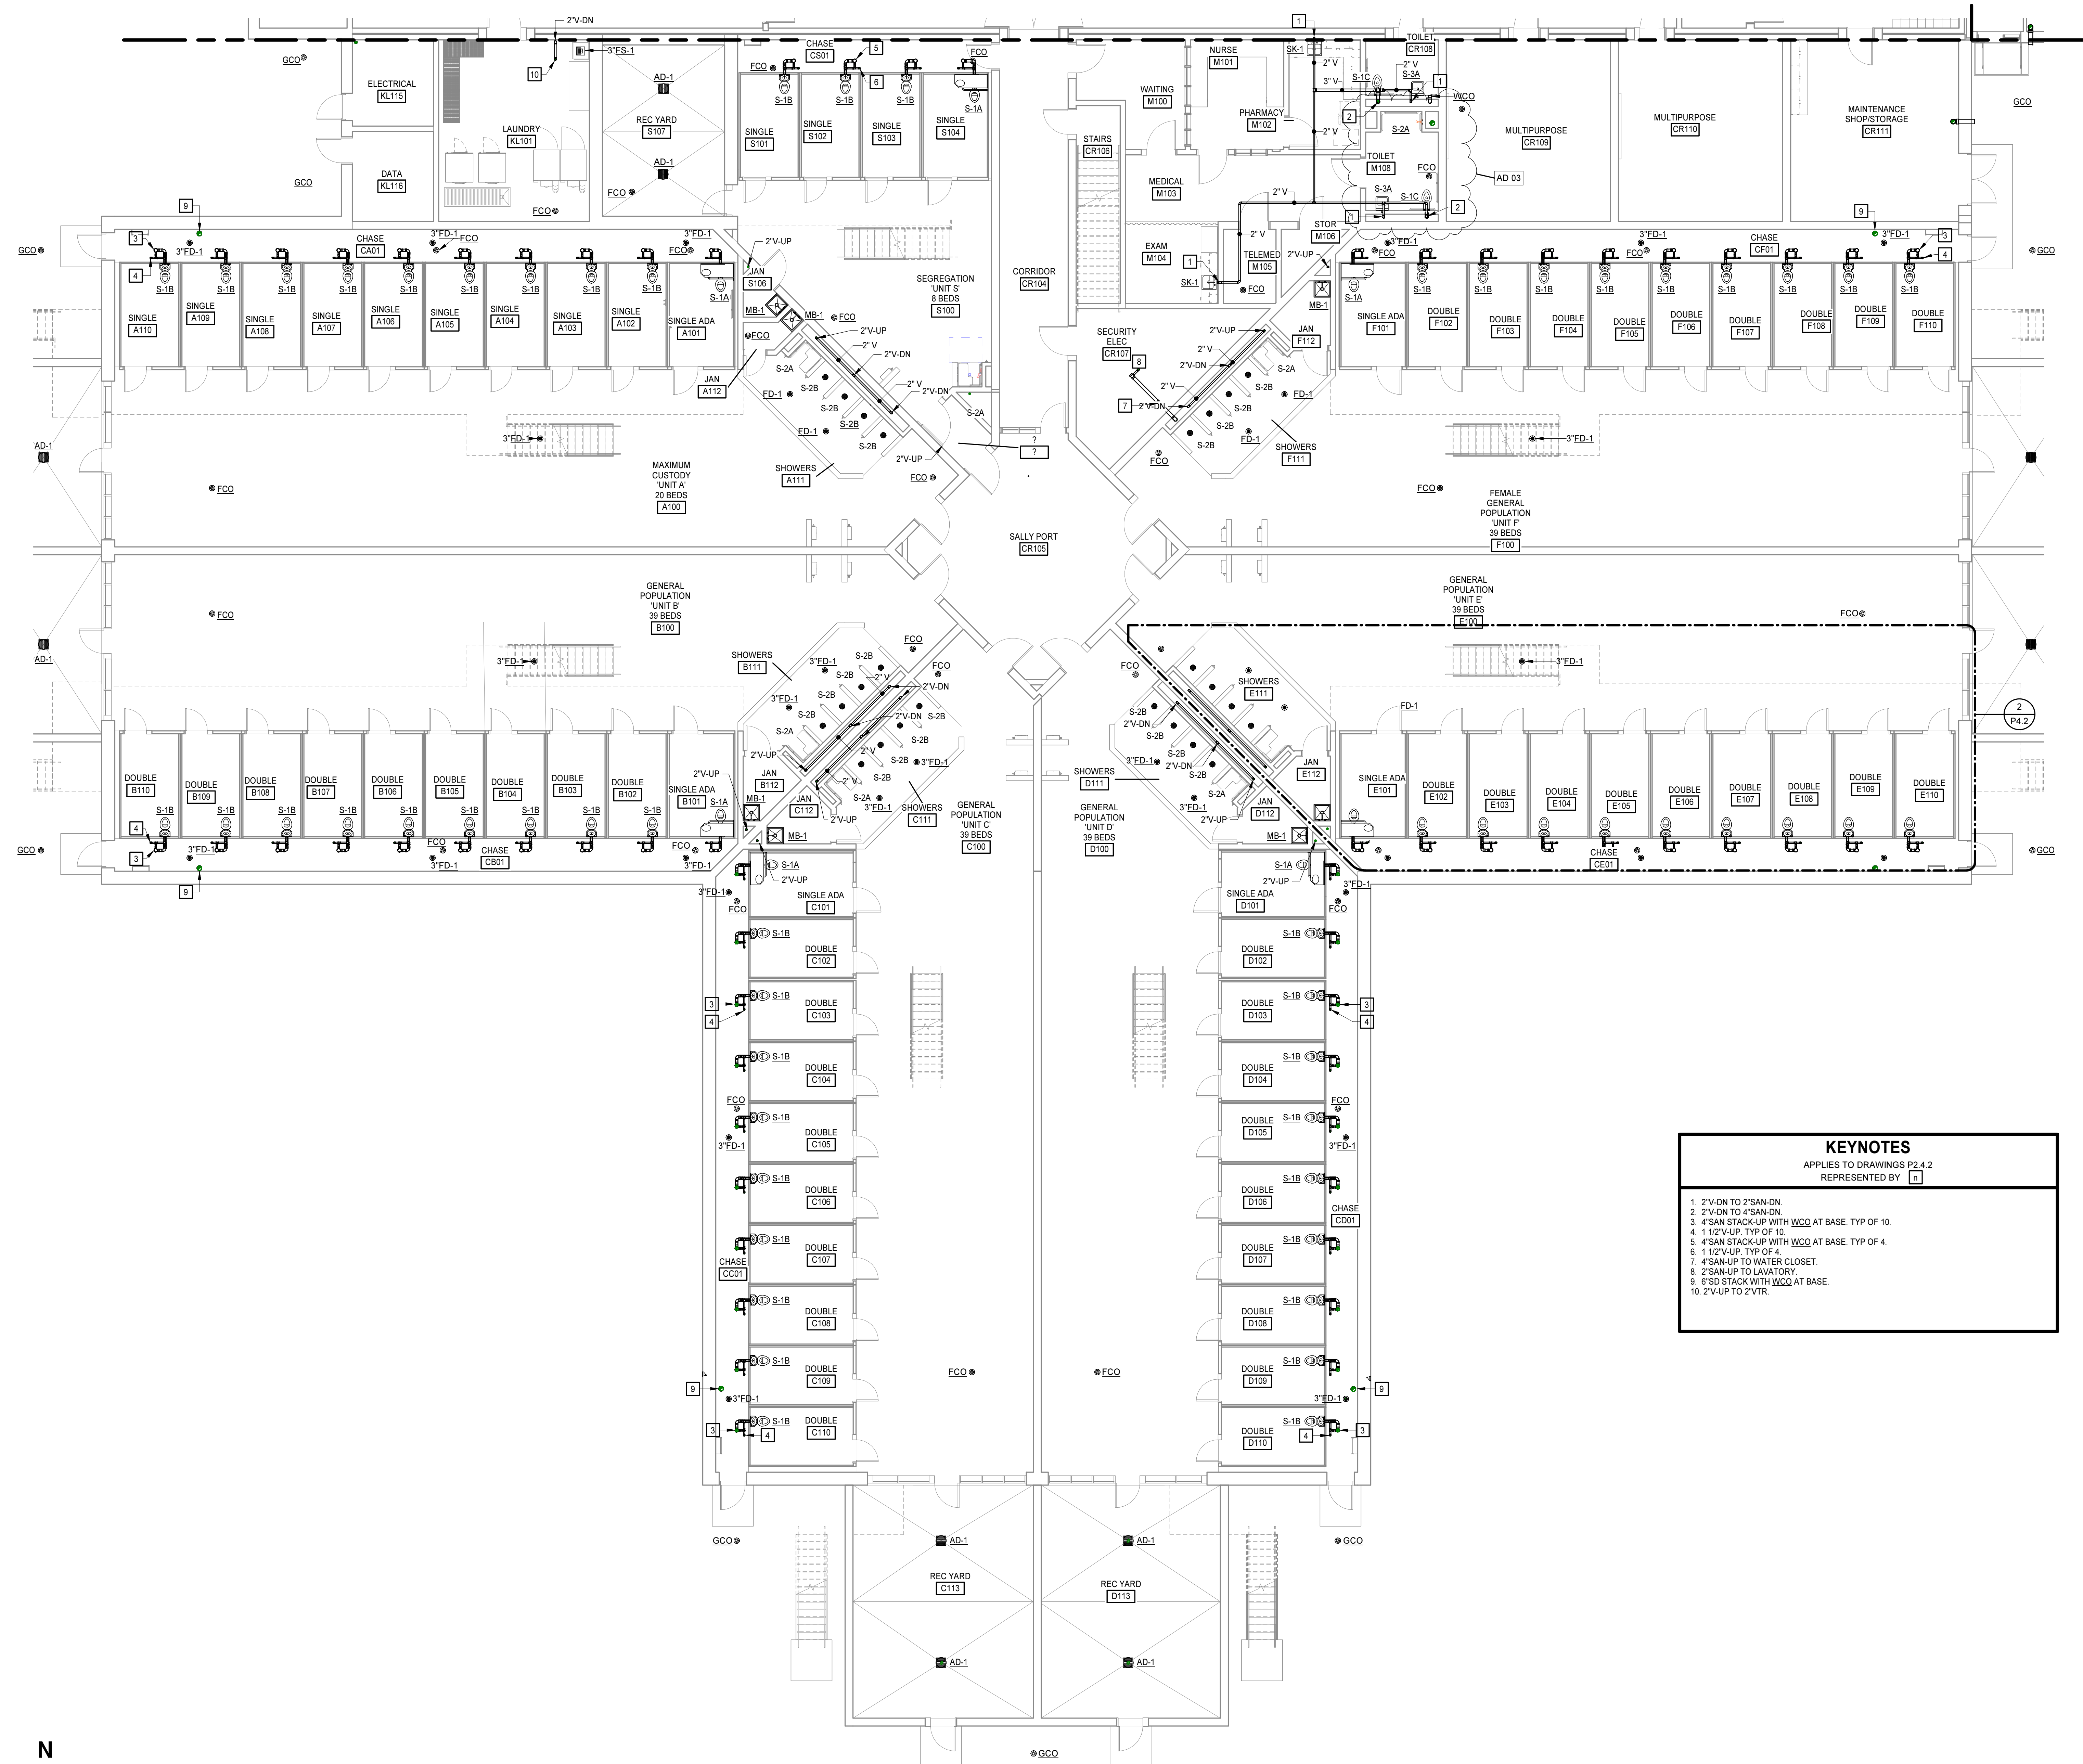


KEYNOTES	
APPLIES TO DRAWINGS P2.4.2 REPRESENTED BY [Symbol]	
1.	2"V-DN TO 2"SAN-DN
2.	2"V-DN TO 4"SAN-DN
3.	4"SAN STACK-UP WITH WCO AT BASE, TYP OF 10.
4.	1 1/2"V-UP, TYP OF 10.
5.	4"SAN STACK-UP WITH WCO AT BASE, TYP OF 4.
6.	1 1/2"V-UP, TYP OF 4.
7.	4"SAN-UP TO WATER CLOSET.
8.	2"SAN-UP TO LAVATORY.
9.	6"SD STACK WITH WCO AT BASE.
10.	2"V-UP TO 2"VTR.

FIRST FLOOR PLAN - PART B - SANITARY - ALTERNATE
 1/8" = 1'-0"


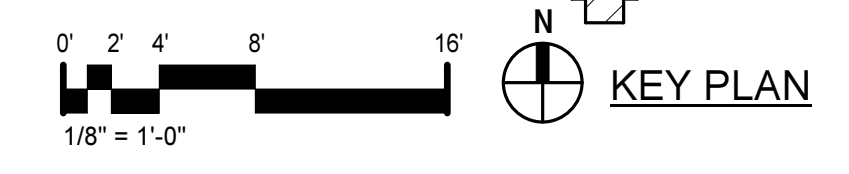


6/12/2024 9:29:30 AM

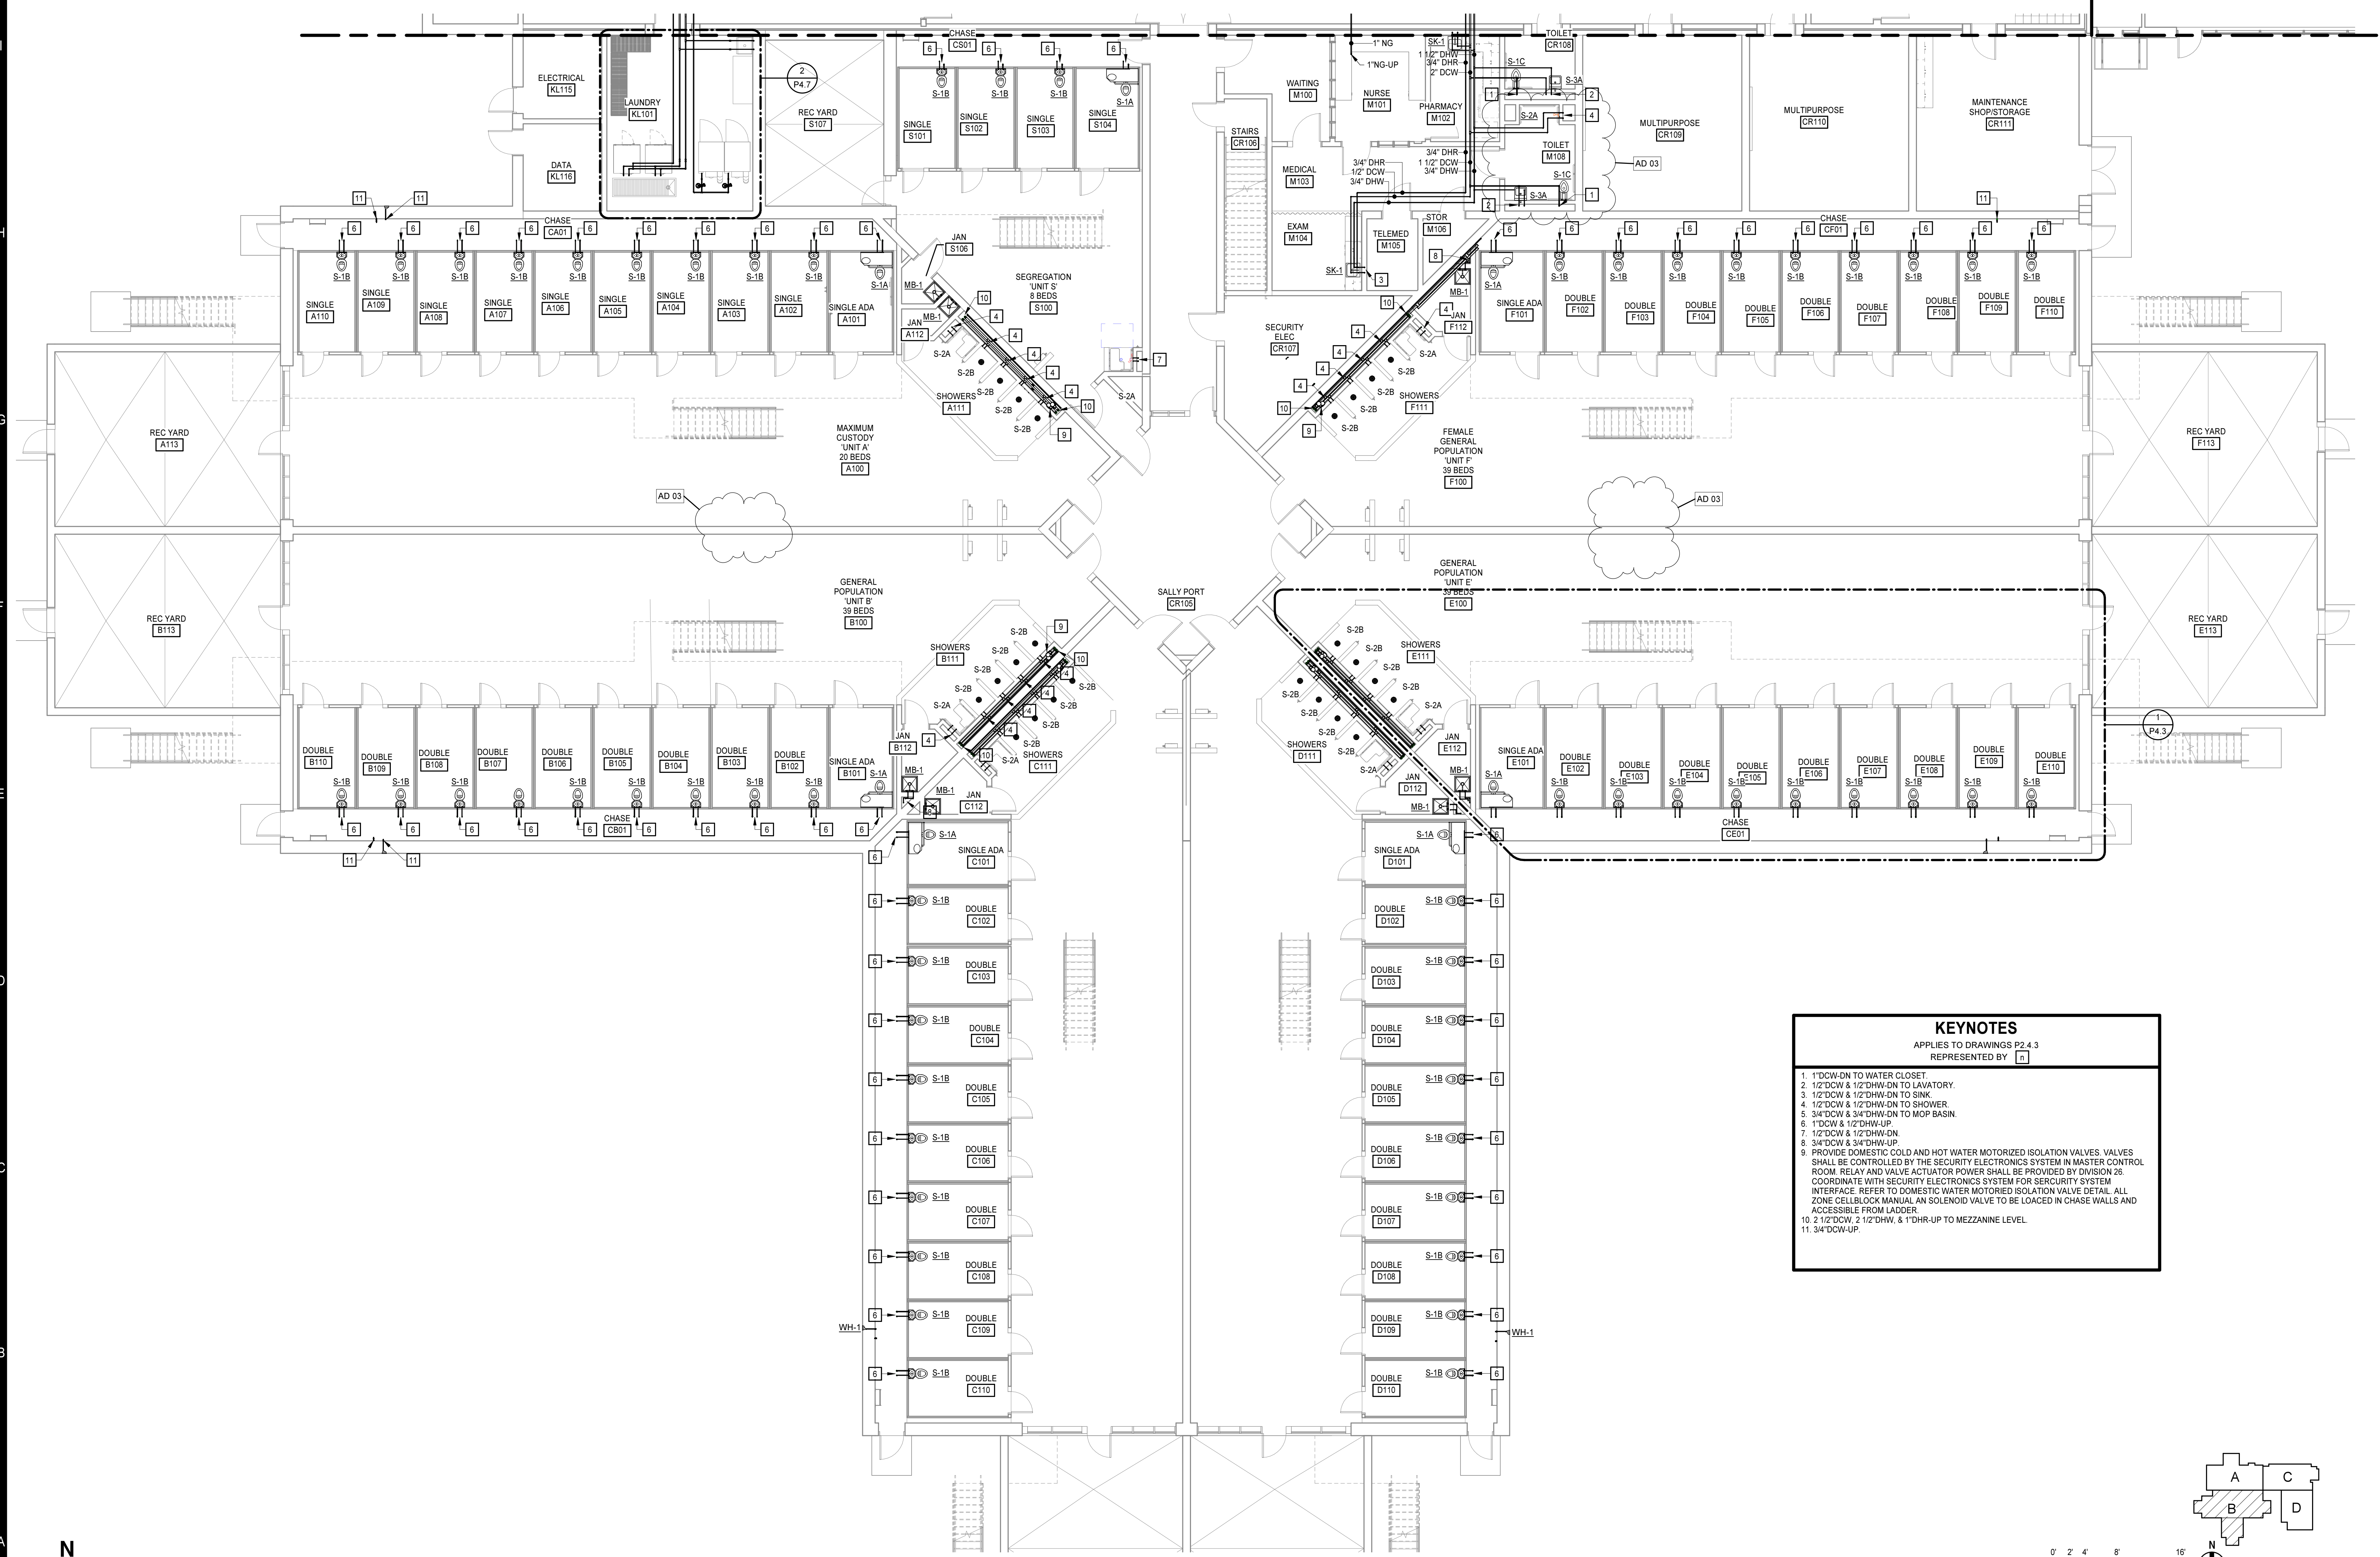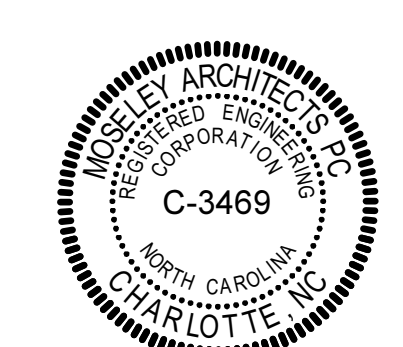

KEYNOTES
 APPLIES TO DRAWINGS P2.4.3
 REPRESENTED BY [Symbol]

- 1" DCW-DN TO WATER CLOSET
- 1/2" DCW & 1/2" DHW-DN TO LAVATORY
- 1/2" DCW & 1/2" DHW-DN TO SINK
- 1/2" DCW & 1/2" DHW-DN TO SHOWER
- 3/4" DCW & 3/4" DHW-DN TO MOP BASIN
- 1" DCW & 1/2" DHW-UP
- 1/2" DCW & 1/2" DHW-DN
- 3/4" DCW & 3/4" DHW-UP
- PROVIDE DOMESTIC COLD AND HOT WATER MOTORIZED ISOLATION VALVES. VALVES SHALL BE CONTROLLED BY THE SECURITY ELECTRONICS SYSTEM IN MASTER CONTROL ROOM. RELAY AND VALVE ACTUATOR POWER SHALL BE PROVIDED BY DIVISION 25. COORDINATE WITH SECURITY ELECTRONICS SYSTEM FOR SECURITY SYSTEM INTERFACE. REFER TO DOMESTIC WATER MOTORIZED ISOLATION VALVE DETAIL. ALL ZONE CEE/LOCK MANUAL. AN SOLENOID VALVE TO BE LOCATED IN CHASE WALLS AND ACCESSIBLE FROM LADDER
- 2 1/2" DCW, 2 1/2" DHW, & 1" DHR-UP TO MEZZANINE LEVEL
- 3/4" DCW-UP

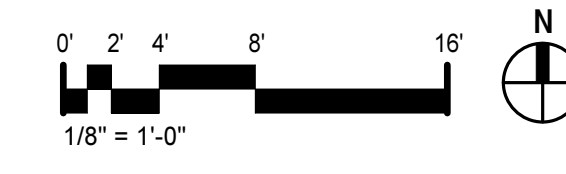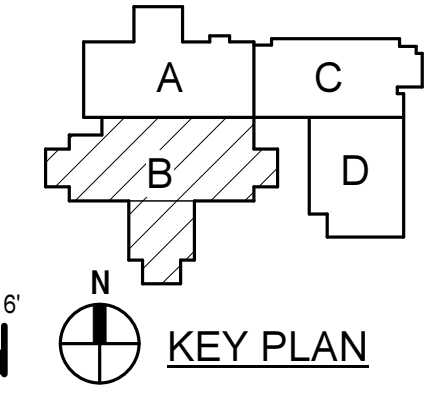

6/12/2024 9:29:39 AM



FIRST FLOOR PLAN - PART B - DOMESTIC - ALTERNATE
 1/8" = 1'-0"

PENDER COUNTY LEC
 PENDER COUNTY, NORTH CAROLINA
 OLD SAVANNAH ROAD BURGAW, NC

PROJECT NO:	811888
DATE:	MAY 1, 2024
REVISIONS:	
DATE:	DESCRIPTION
06/12/2024	AD 03



FIRST FLOOR PLAN - PART B - DOMESTIC - ALTERNATE

P2.4.3

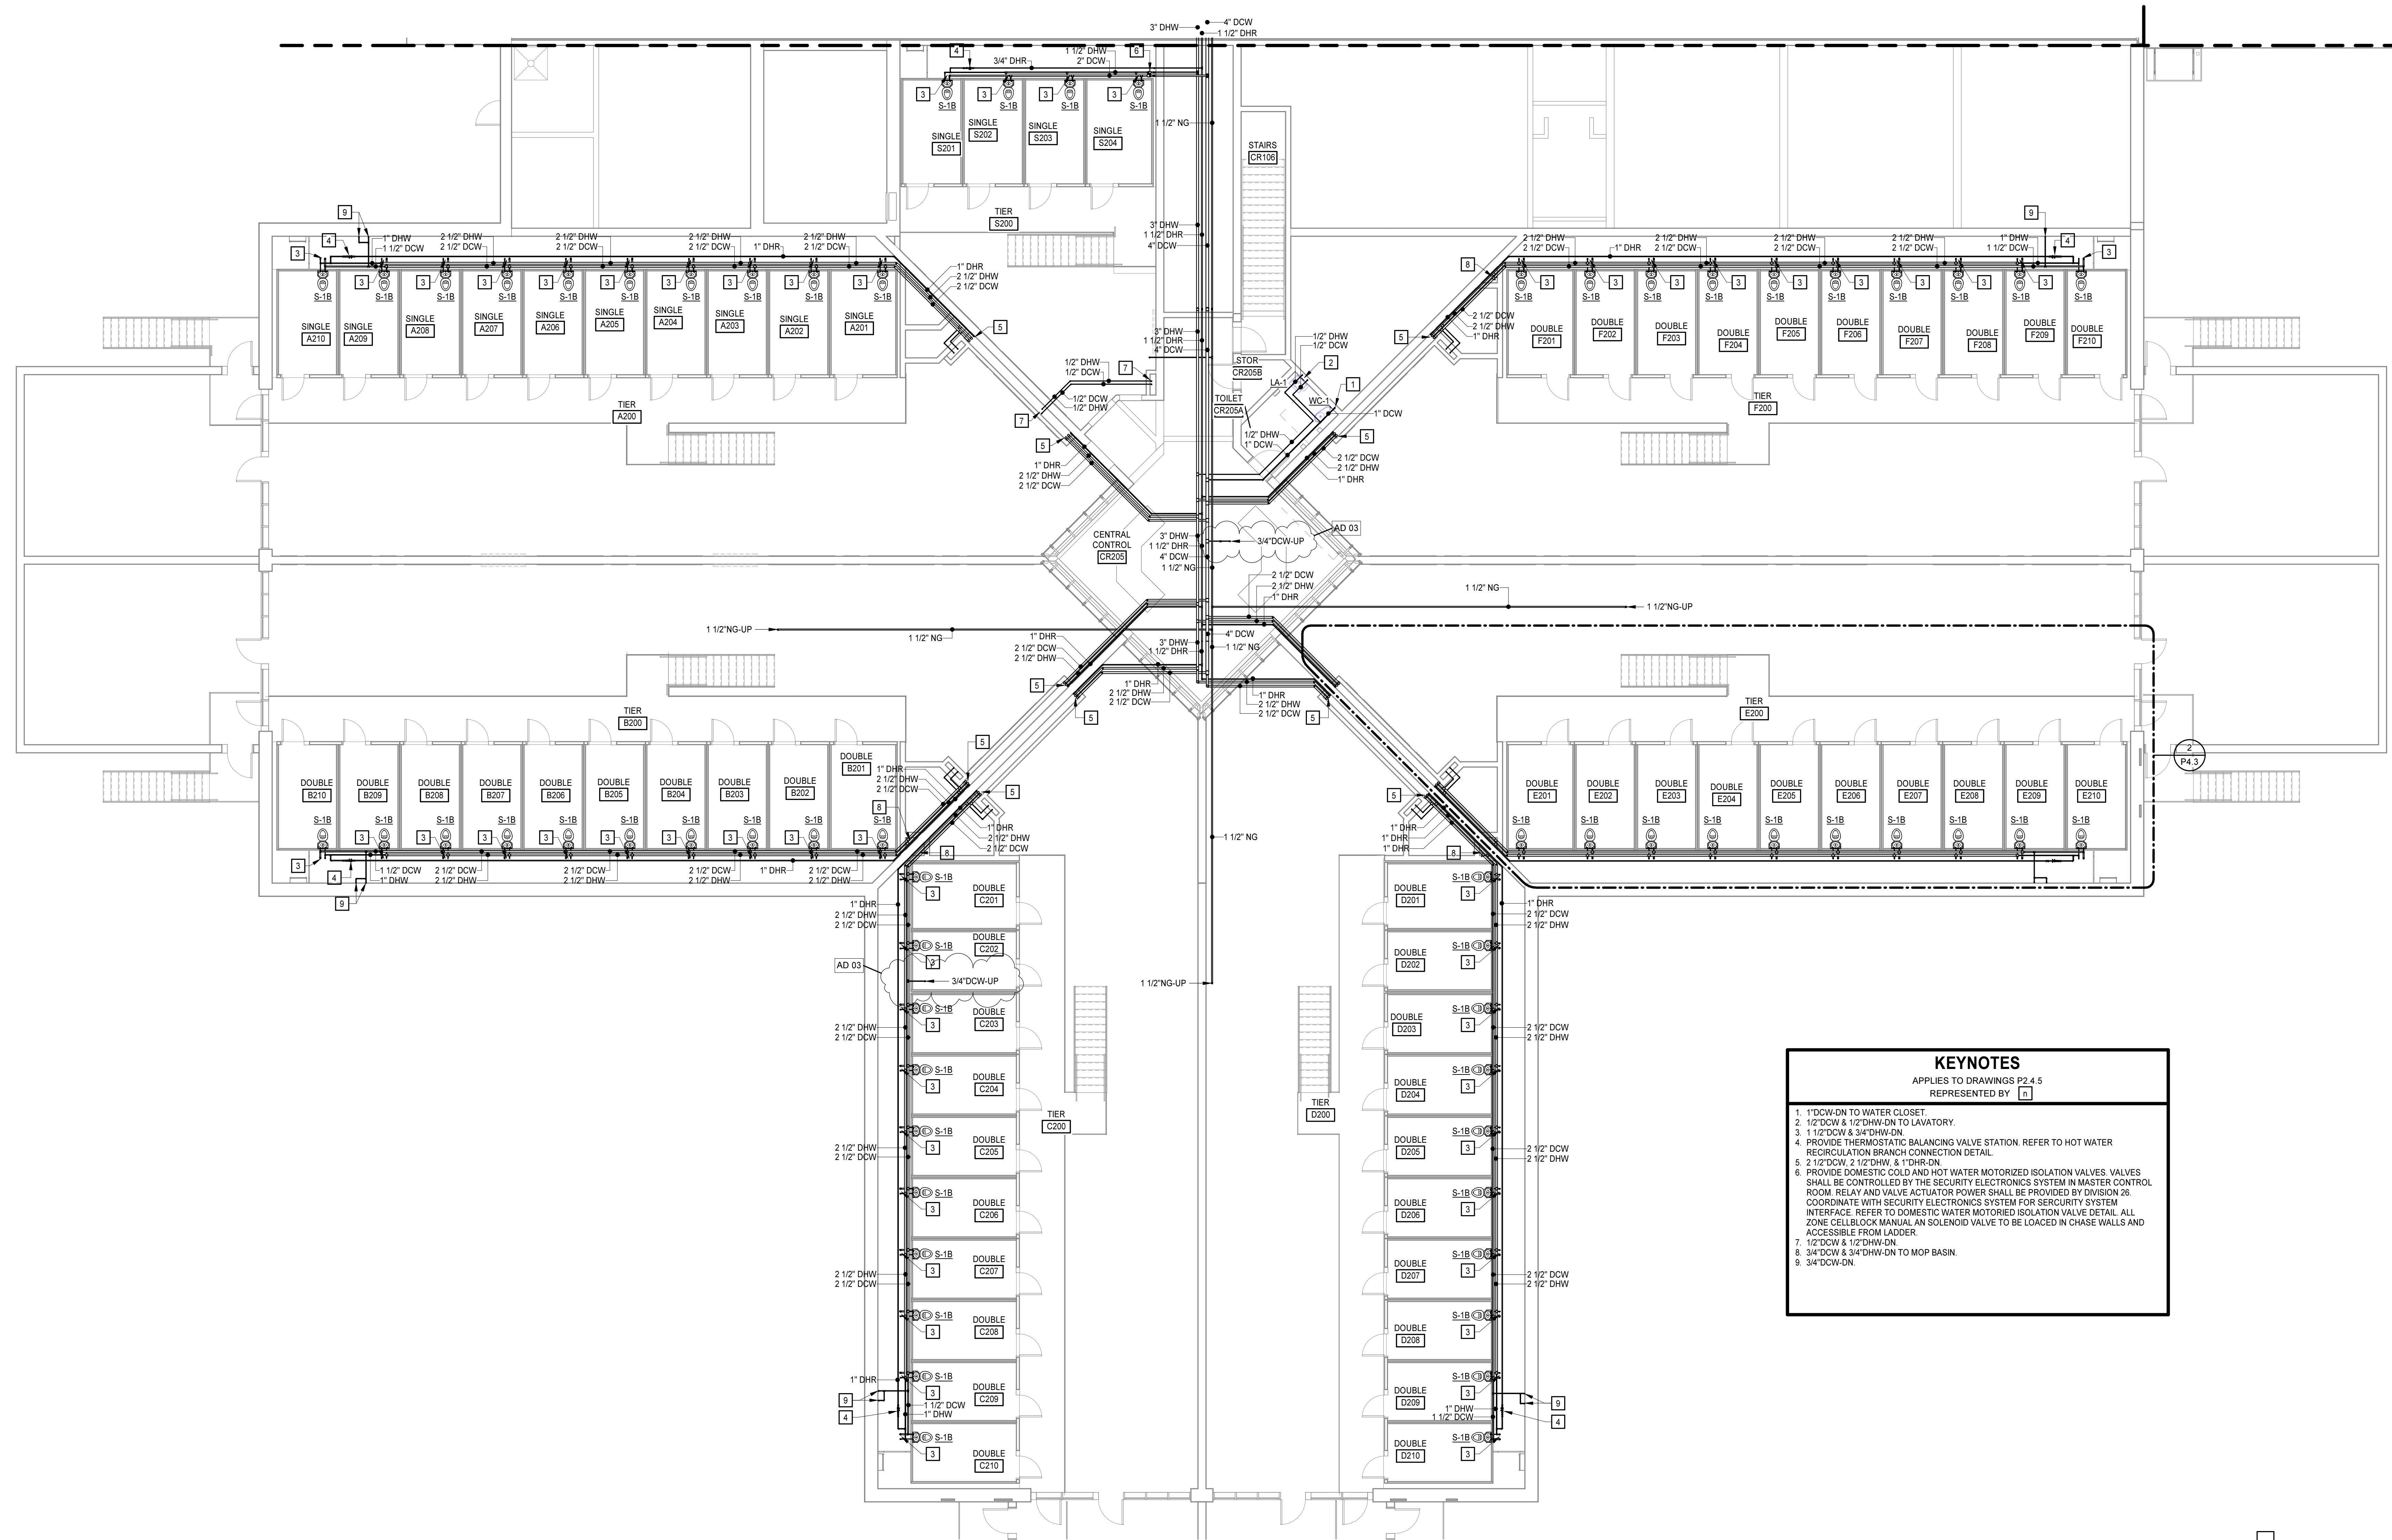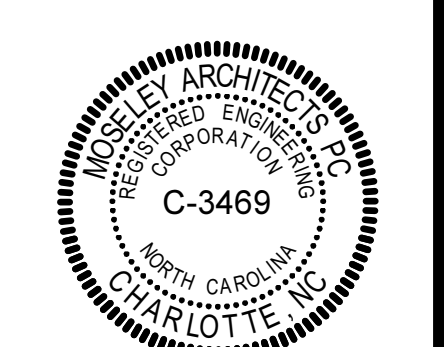

KEYNOTES
 APPLIES TO DRAWINGS P2.4.5
 REPRESENTED BY [N]

- 1/2" DCW-DN TO WATER CLOSET.
- 1/2" DCW & 1/2" DHW-DN TO LAVATORY.
- 1 1/2" DCW & 3/4" DHW-DN.
- PROVIDE THERMOSTATIC BALANCING VALVE STATION. REFER TO HOT WATER RECIRCULATION BRANCH CONNECTION DETAIL.
- 2 1/2" DCW, 2 1/2" DHW, & 1" DHR-DN.
- PROVIDE DOMESTIC COLD AND HOT WATER MOTORIZED ISOLATION VALVES. VALVES SHALL BE CONTROLLED BY THE SECURITY ELECTRONICS SYSTEM IN MASTER CONTROL ROOM. RELAY AND VALVE ACTUATOR POWER SHALL BE PROVIDED BY DIVISION 26. COORDINATE WITH SECURITY ELECTRONICS SYSTEM FOR SECURITY SYSTEM INTERFACE. REFER TO DOMESTIC WATER MOTORIZED ISOLATION VALVE DETAIL. ALL ZONE CELLBLOCK MANUAL AN SOLENOID VALVE TO BE LOADED IN CHASE WALLS AND ACCESSIBLE FROM LADDER.
- 1/2" DCW & 1/2" DHW-DN.
- 3/4" DCW & 3/4" DHW-DN TO MOP BASIN.
- 3/4" DCW-DN.

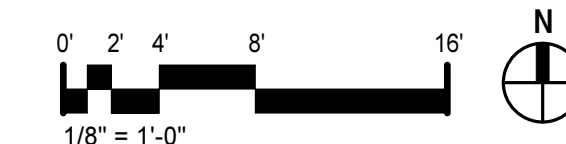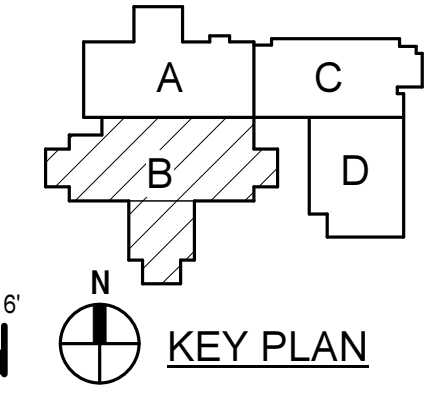

6/12/2024 9:29:48 AM

MEZZANINE LEVEL - PART B - DOMESTIC - ALTERNATE
 1/8" = 1'-0"

PENDER COUNTY LEC

PENDER COUNTY, NORTH CAROLINA
 OLD SAVANNAH ROAD BURGAW, NC


PROJECT NO:	811888
DATE:	MAY 1, 2024
REVISIONS	
DATE	DESCRIPTION
06/12/2024	AD 03

MEZZANINE LEVEL - PART B - DOMESTIC - ALTERNATE

P2.4.5


6/12/2024 9:29:52 AM

J
I
H
G
F
E
D
C
B
A

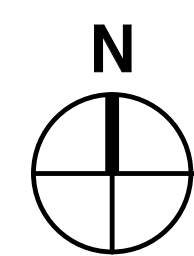


ROOF PLAN - PART B - ALTERNATE - PLUMBING

1/8" = 1'-0"

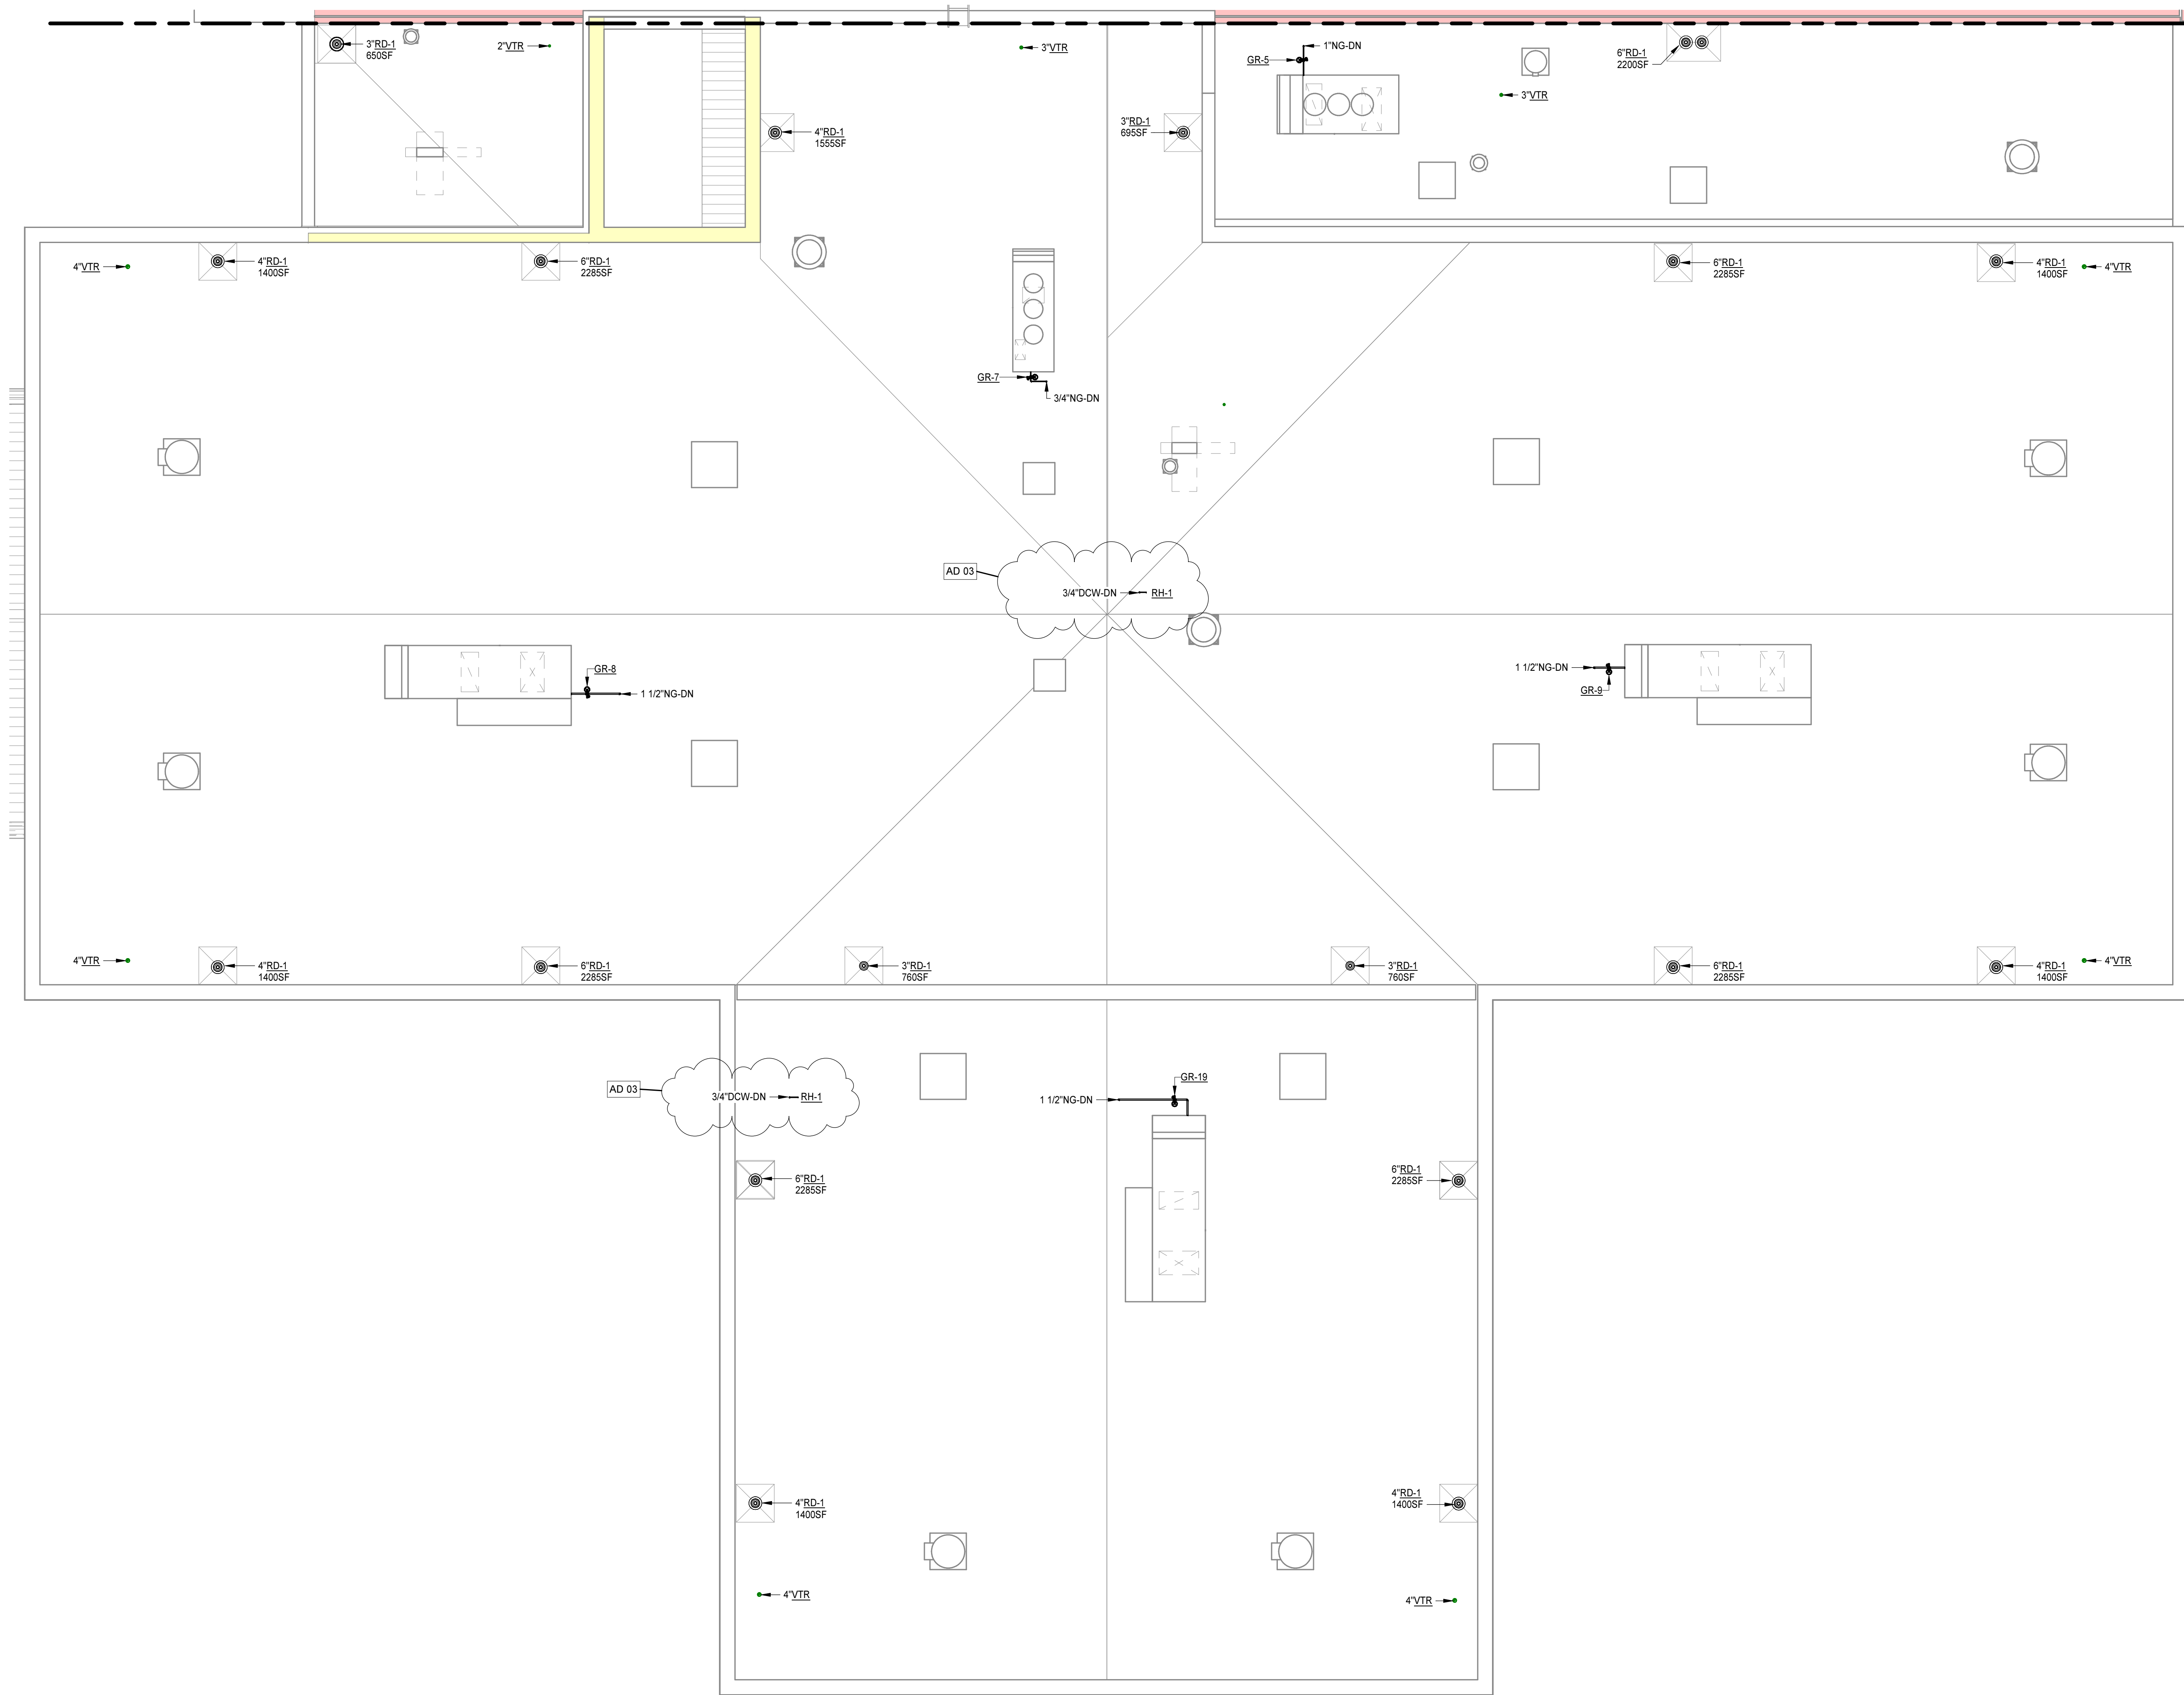

0' 2' 4' 8' 16'
1/8" = 1'-0"

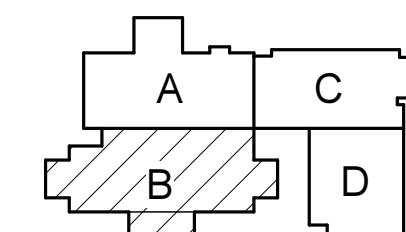

KEY PLAN


PROJECT NO:	611888
DATE:	MAY 1, 2024
REVISIONS	
DATE	DESCRIPTION
06/12/2024	AD 03

**ROOF PLAN - PART B -
PLUMBING -
ALTERNATE**

P2.4.6


PENDER COUNTY LEC

**PENDER COUNTY, NORTH CAROLINA
OLD SAVANNAH ROAD BURGAW, NC**

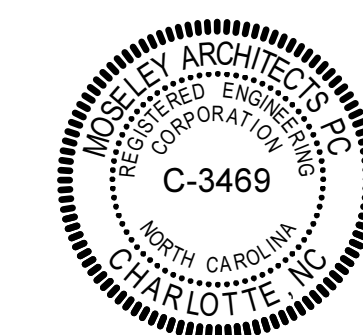


MOSELEYARCHITECTS

6210 ARDREY KELL ROAD - THE HUB AT WAVERLY, SUITE #25 - CHARLOTTE, NC 28277
PHONE (704) 540-3755 FAX (704) 540-3754
MOSELEYARCHITECTS.COM

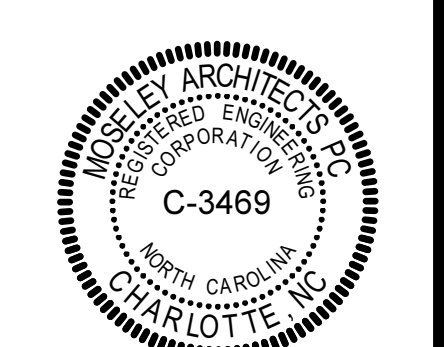


PROJECT NO:	811888
DATE:	MAY 1, 2024
REVISIONS:	
DATE:	DESCRIPTION
06/12/2024	AD 03

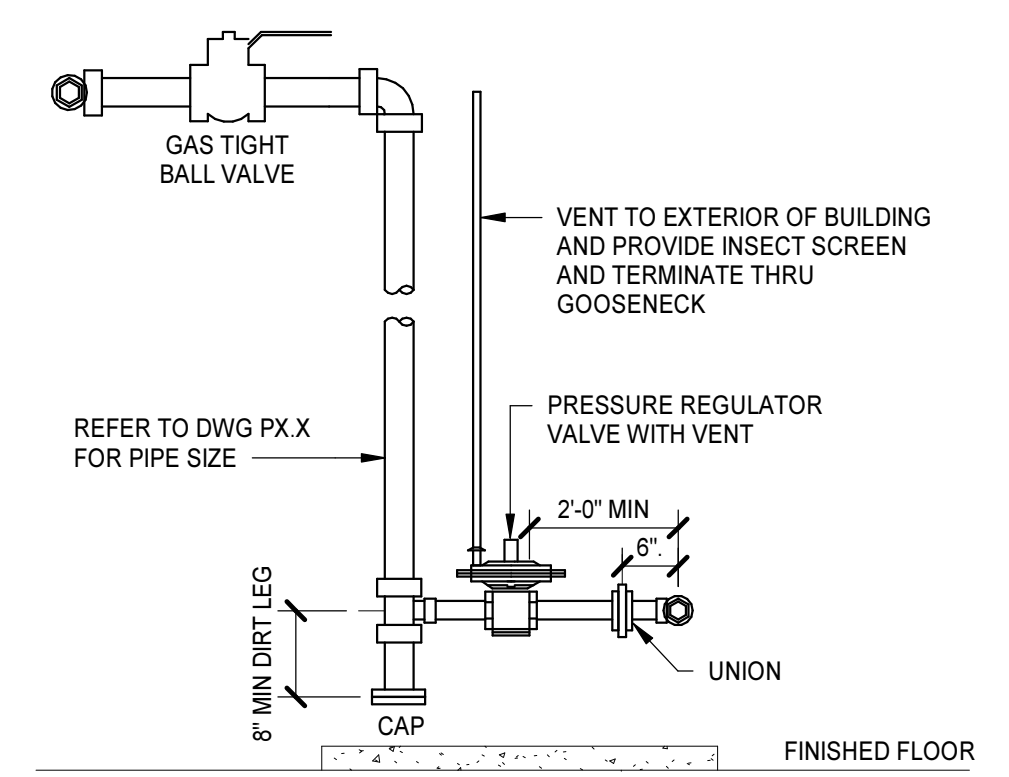


GAS PIPE CONNECTION DETAIL
 NO SCALE


NOTES:
 1. REGULATOR AND GAS PIPING FROM DIRT LEG TO EQUIPMENT SHALL BE SIZED IN ACCORDANCE WITH MANUFACTURERS RECOMMENDATIONS.
 2. REGULATOR SHALL MEET EQUIPMENT MANUFACTURER PRESSURE AND FLOW REQUIREMENTS.
 3. ALL REGULATOR VENTS SHALL TERMINATE A MINIMUM OF 10'-0" AWAY FROM ALL OUTSIDE AND FRESH AIR INTAKES AND OPERABLE DOORS AND WINDOWS.

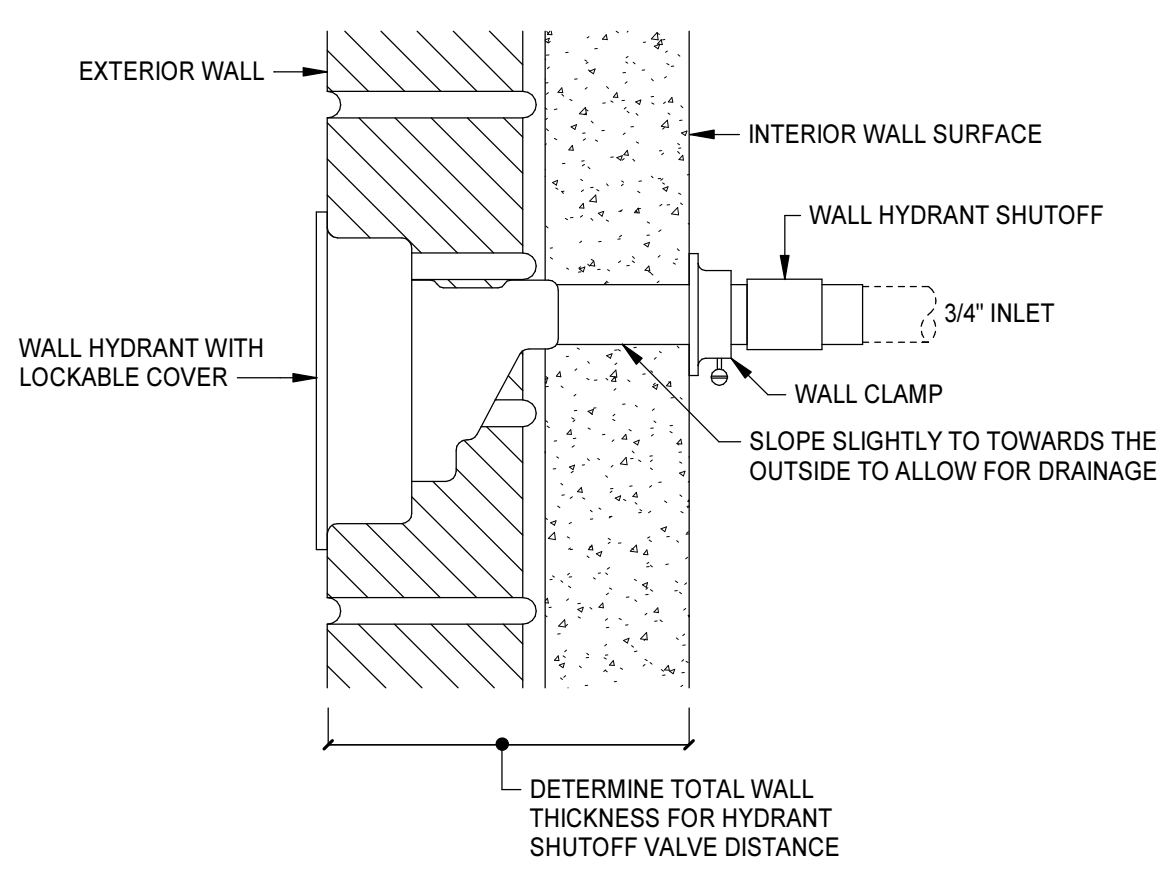


EXTERIOR WALL HYDRANT DETAIL
 NO SCALE

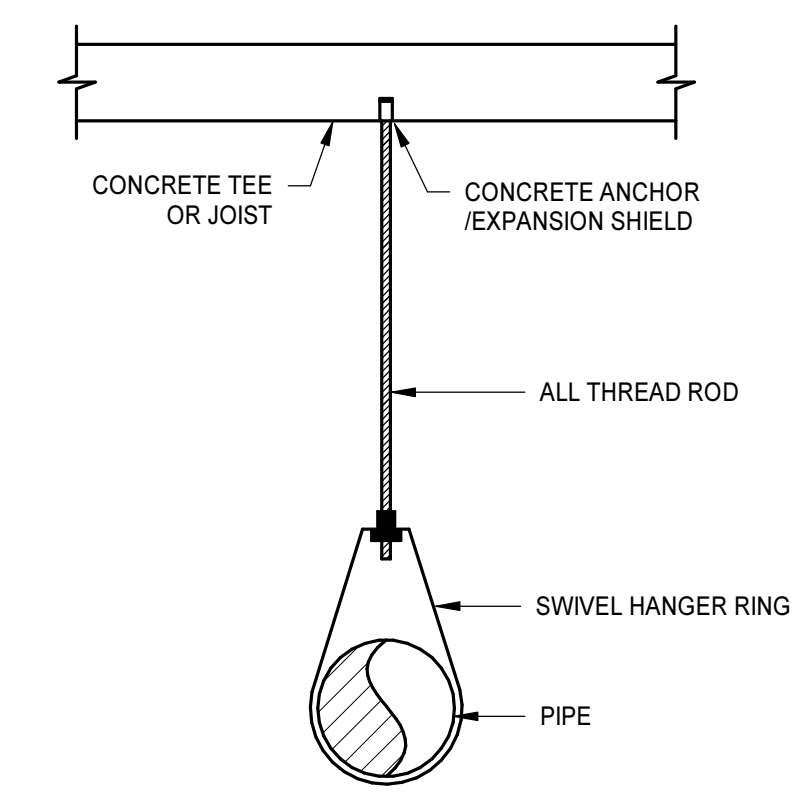

TYPICAL HANGER IN CONCRETE
 NO SCALE

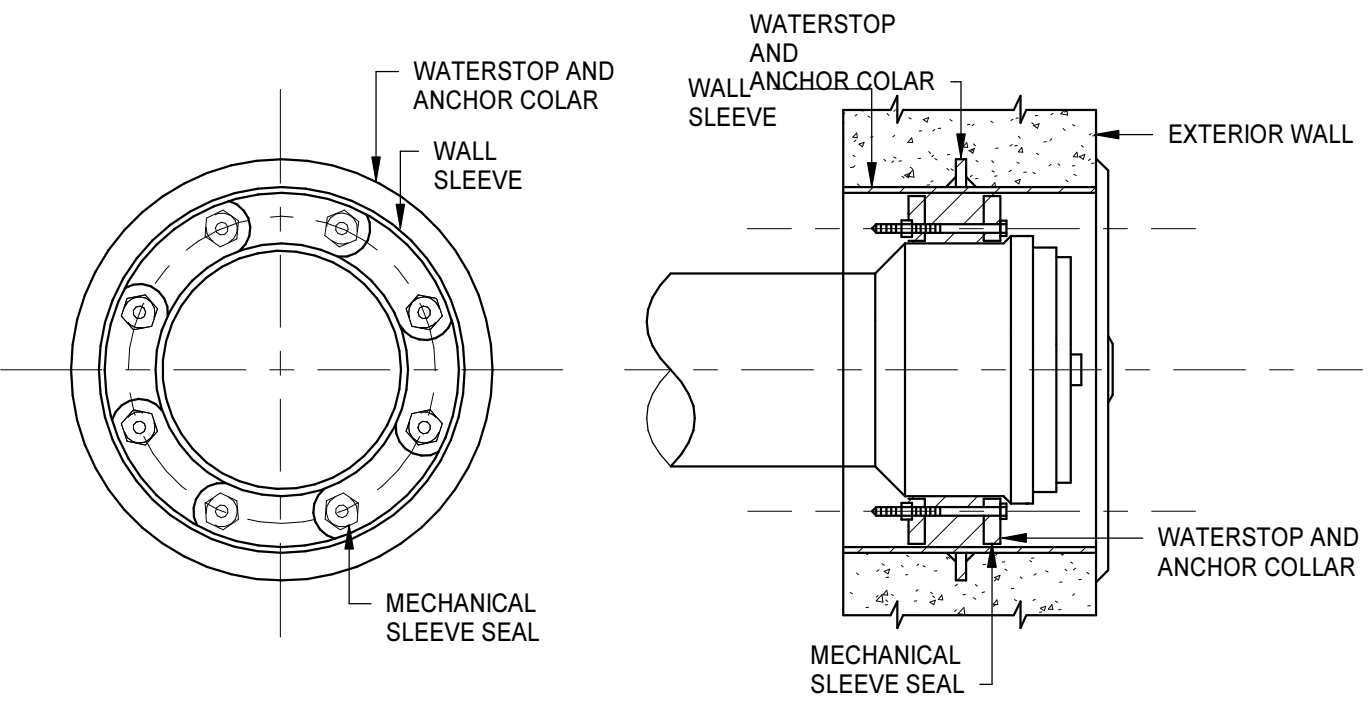


MECHANICAL SLEEVE SEAL DETAIL
 NO SCALE

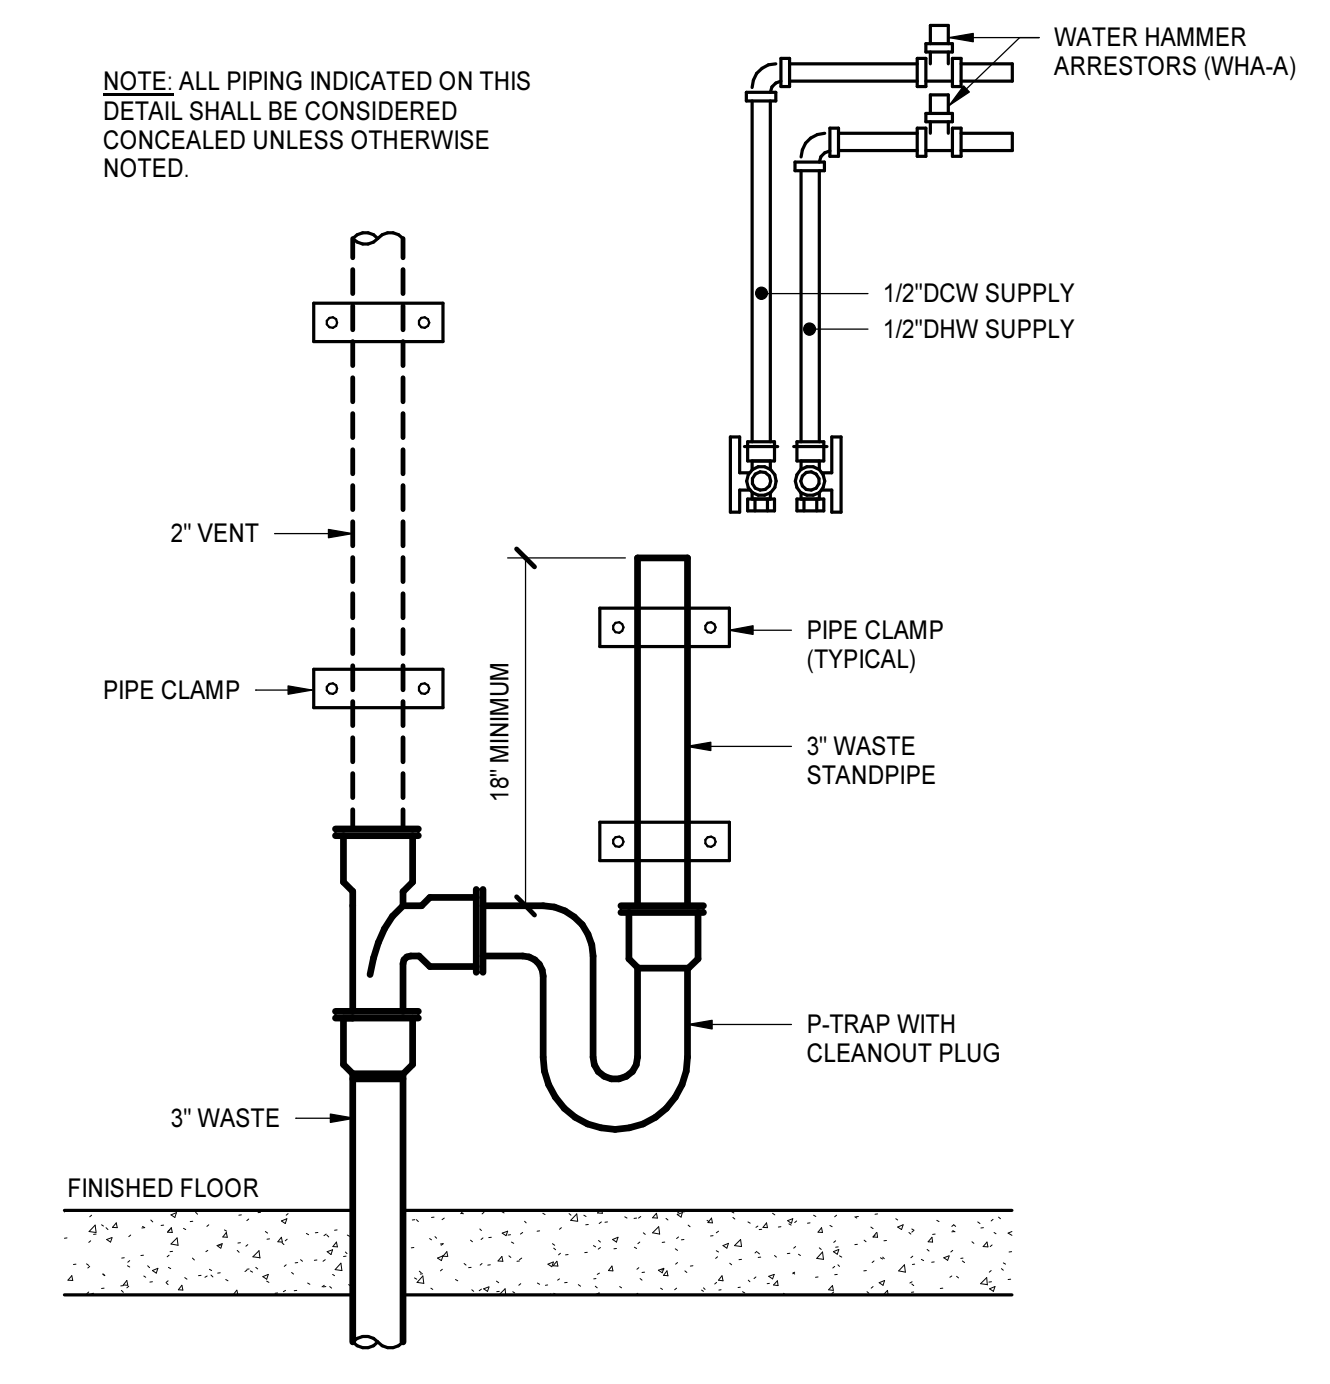


WASHING MACHINE STANDPIPE DRAIN DETAIL
 NO SCALE

FINISHED CEILING ALTERNATIVE POSITION 1 FINISHED CEILING


- NOTES:
1. PIPING DOWNSTREAM OF SUPPLY STOPS NOT SHOWN FOR CLARITY. ALL REQUIRED FIXTURE AND EQUIPMENT CLEARANCES AND ACCESS SHALL BE MAINTAINED.
 2. PRIMARY POSITION SHALL BE USED UNLESS OTHERWISE APPROVED. ALTERNATE POSITION 1 MAY BE USED WHERE CEILING HEIGHT DOES NOT EXCEED 10'. ALTERNATE POSITION 2 REQUIRES DETAILED EXAMPLE AND PRIOR APPROVAL.
 3. PRIMARY POSITION (AS INDICATED): LOCATE VALVE IN SURFACE-MOUNTED OR RECESSED LOCKABLE STAINLESS STEEL WALL BOX WITH ALL PIPING PRIOR TO SUPPLY STOPS CONCEALED IN WALL. BOX POSITION SHALL BE LOCATED COMPLETELY UNDER FIXTURE WHENEVER POSSIBLE.
 4. ALTERNATIVE POSITION 1 (CONCEALED ABOVE CEILING): LOCATE VALVE ABOVE CEILING AND PROVIDE ACCESS PANEL FOR NON-ACCESSIBLE CEILINGS.
 5. ALTERNATIVE POSITION 2 (EXPOSED TUCKED HIGH UNDER FIXTURE): LOCATE VALVE HIGH BELOW FIXTURE OUT OF SIGHT AND PROVIDE WITH MOUNTING BRACKET TO ENSURE VALVE STAYS IN-PLACE.

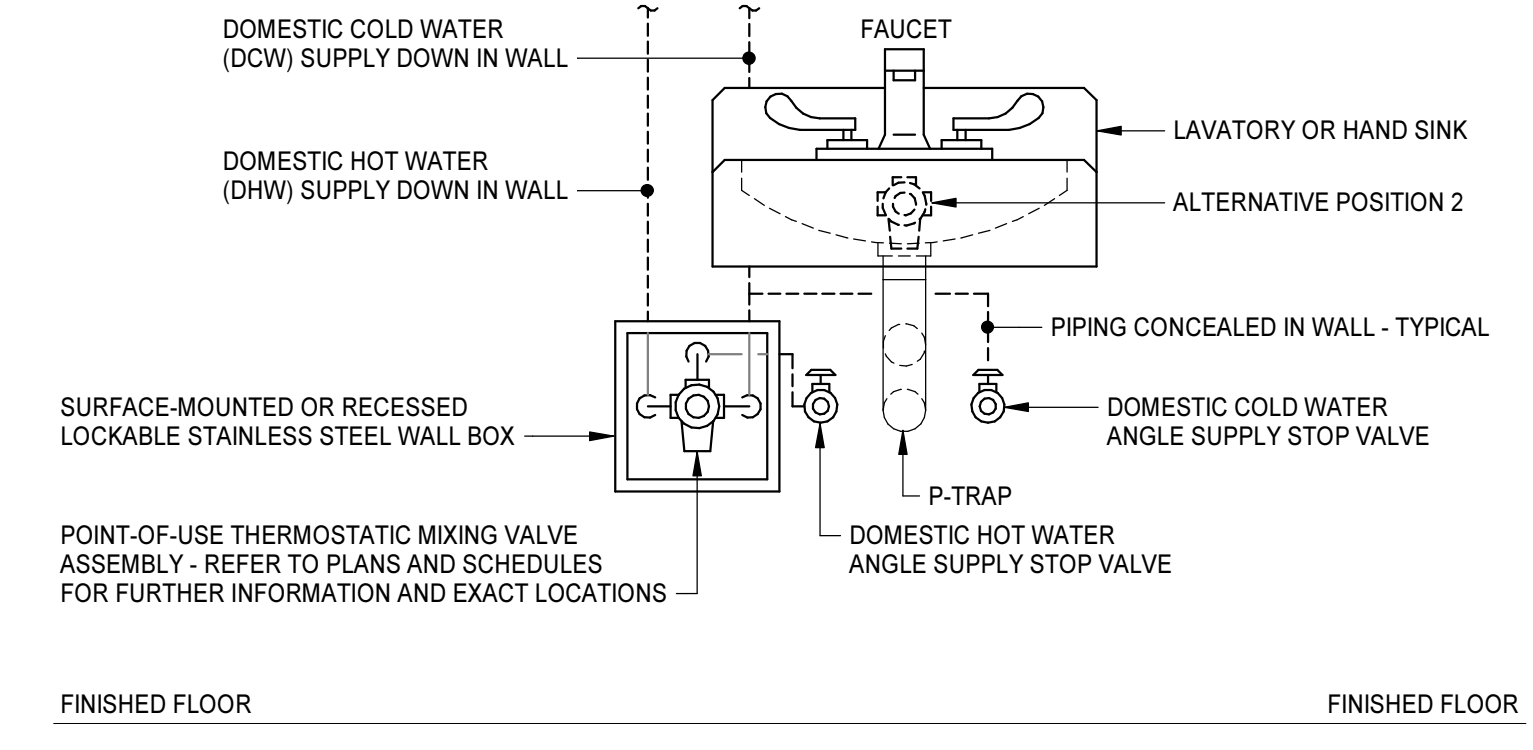



ASSE-1070 POINT-OF-USE VALVE DETAIL
 NO SCALE

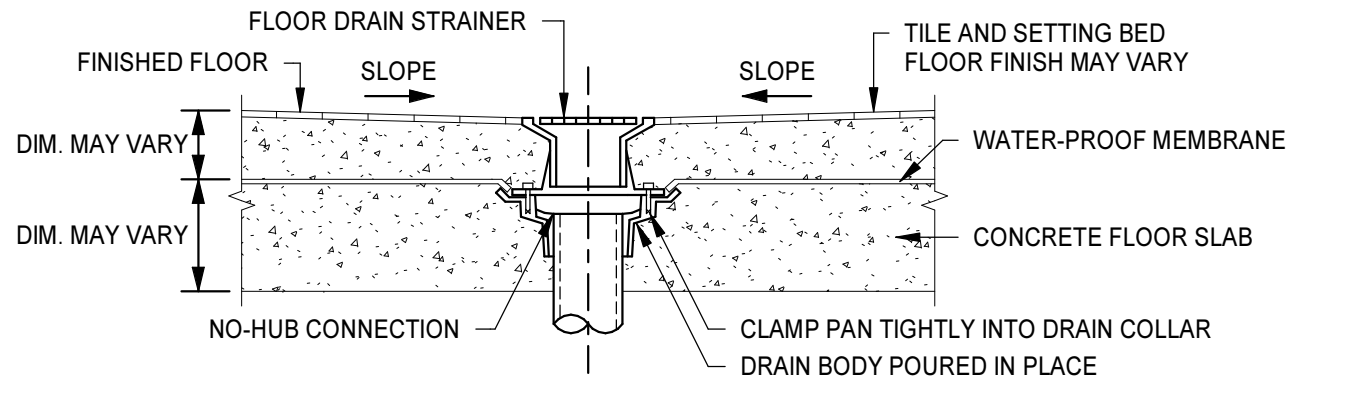


FLOOR DRAIN IN OPEN AREA DETAIL
 NO SCALE

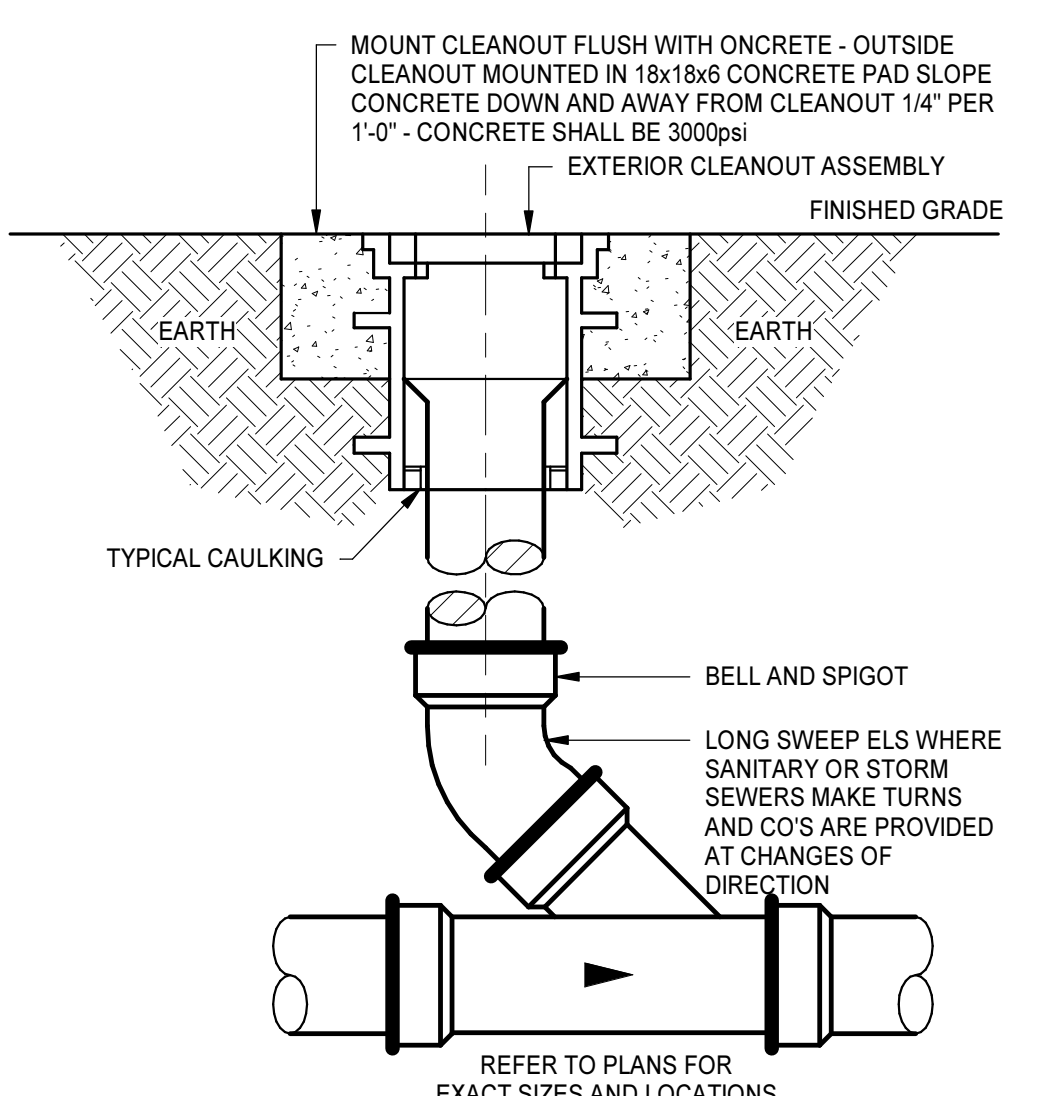

EXTERIOR YARD CLEANOUT DETAIL
 NO SCALE

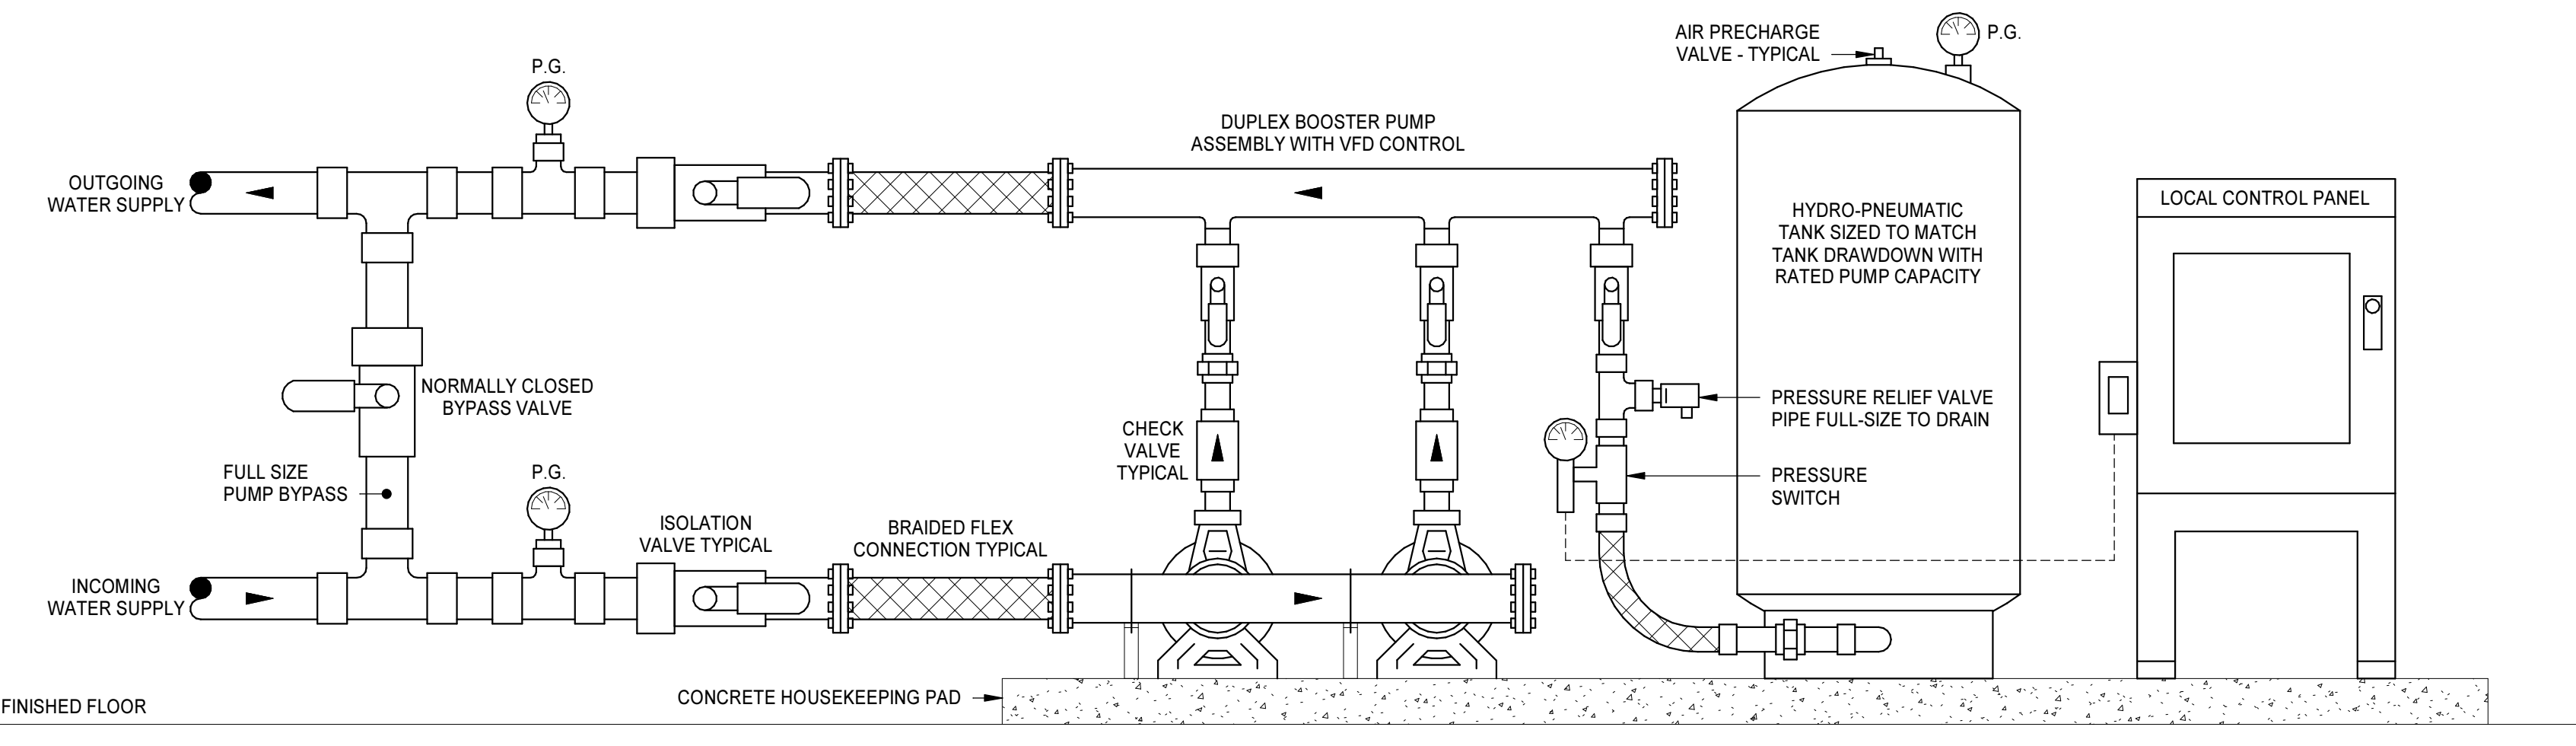
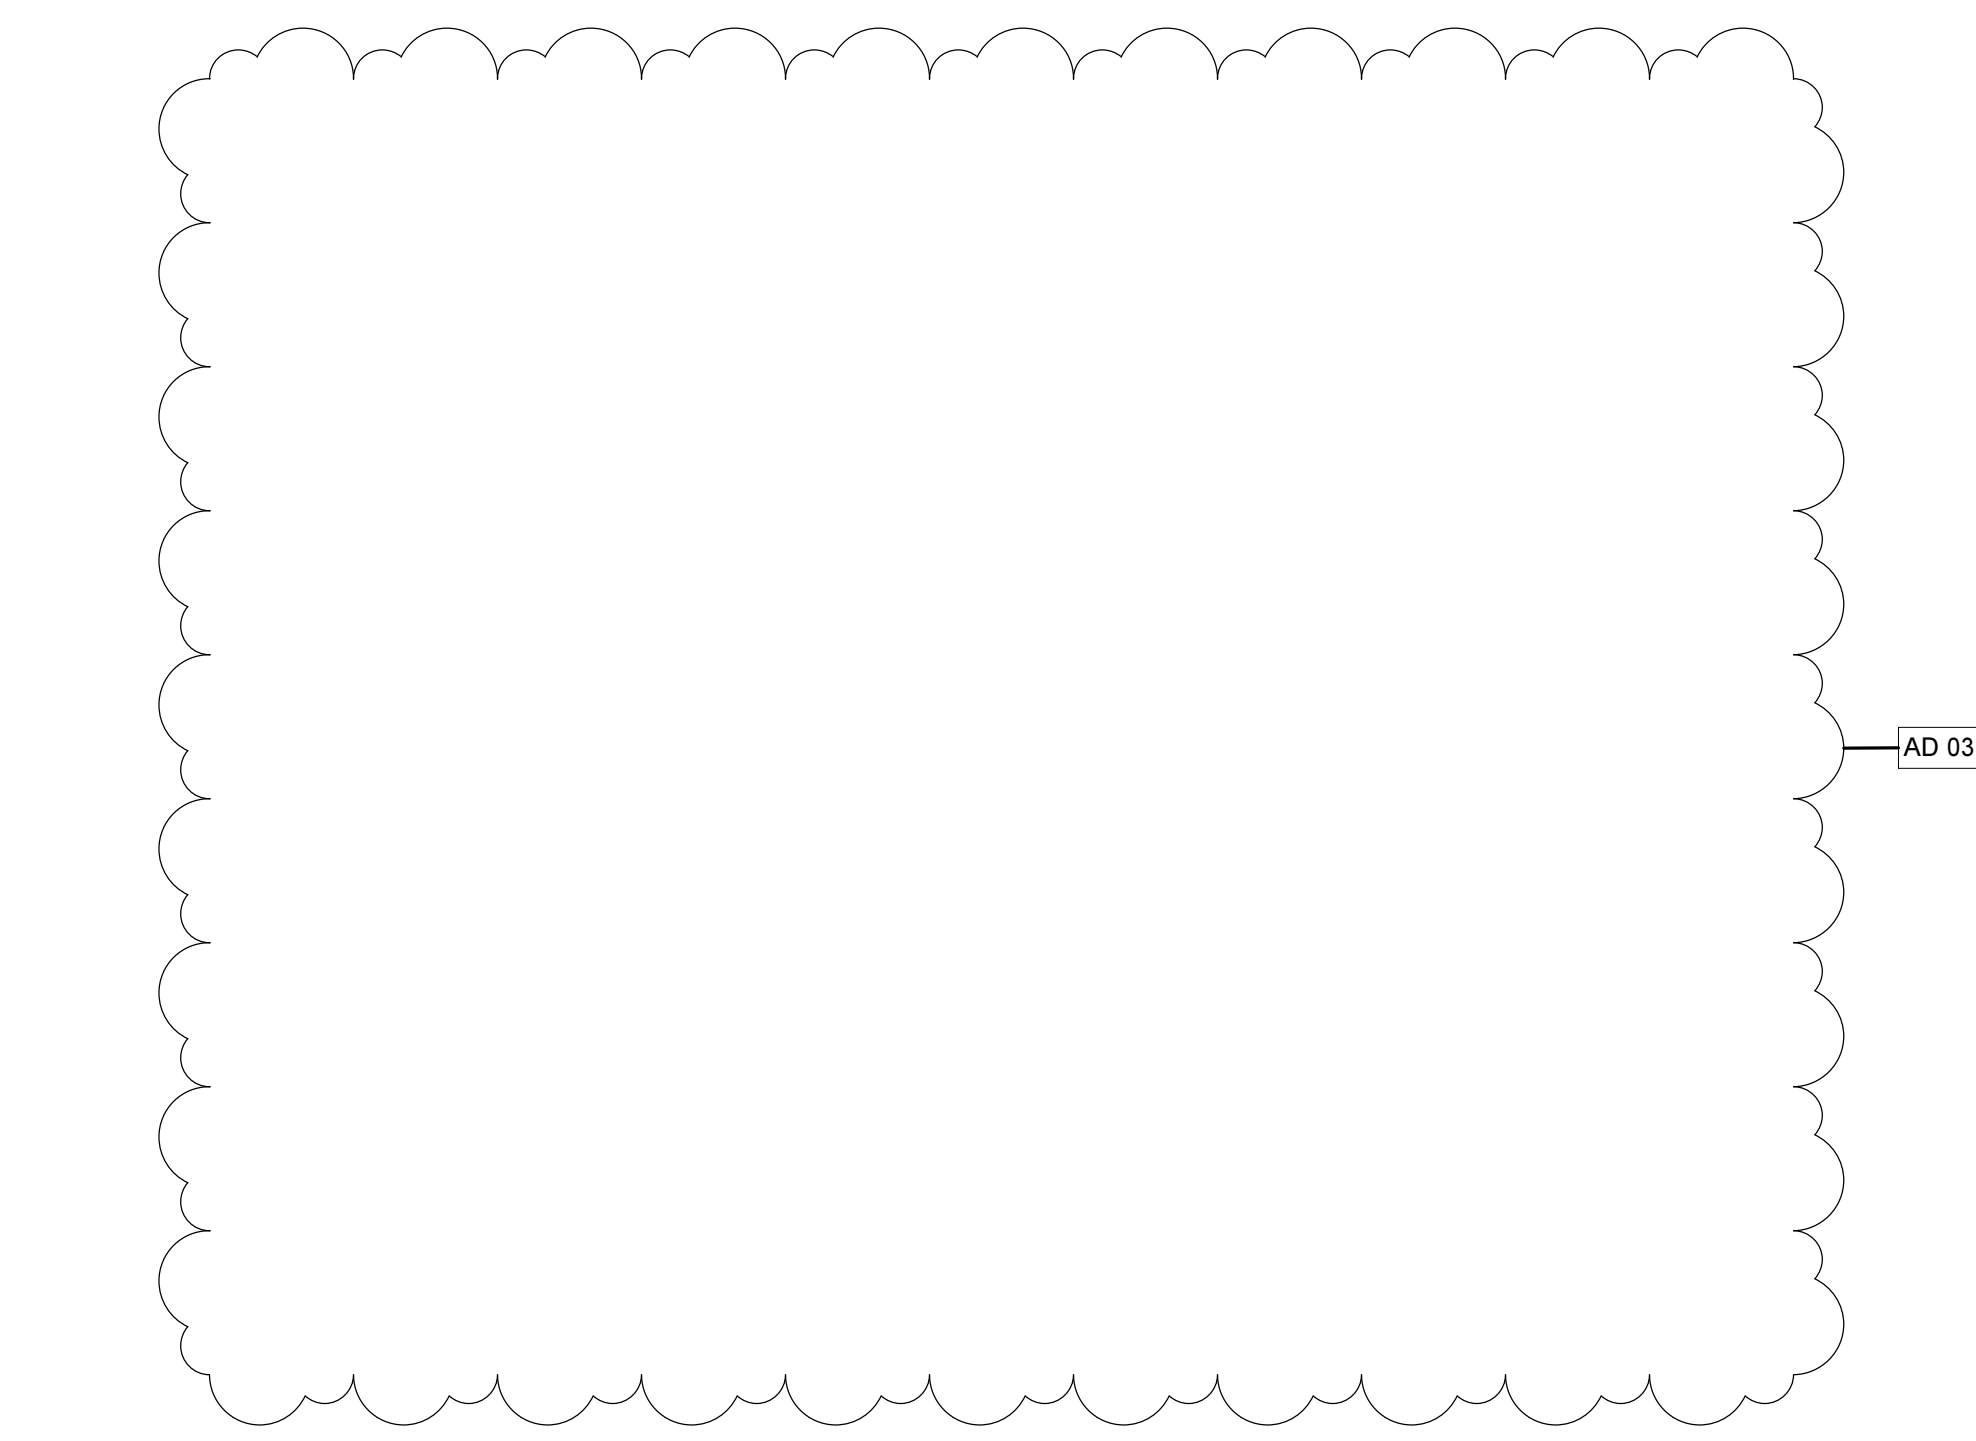


DUPLEX DOMESTIC BOOSTER PUMP DETAIL
 NO SCALE

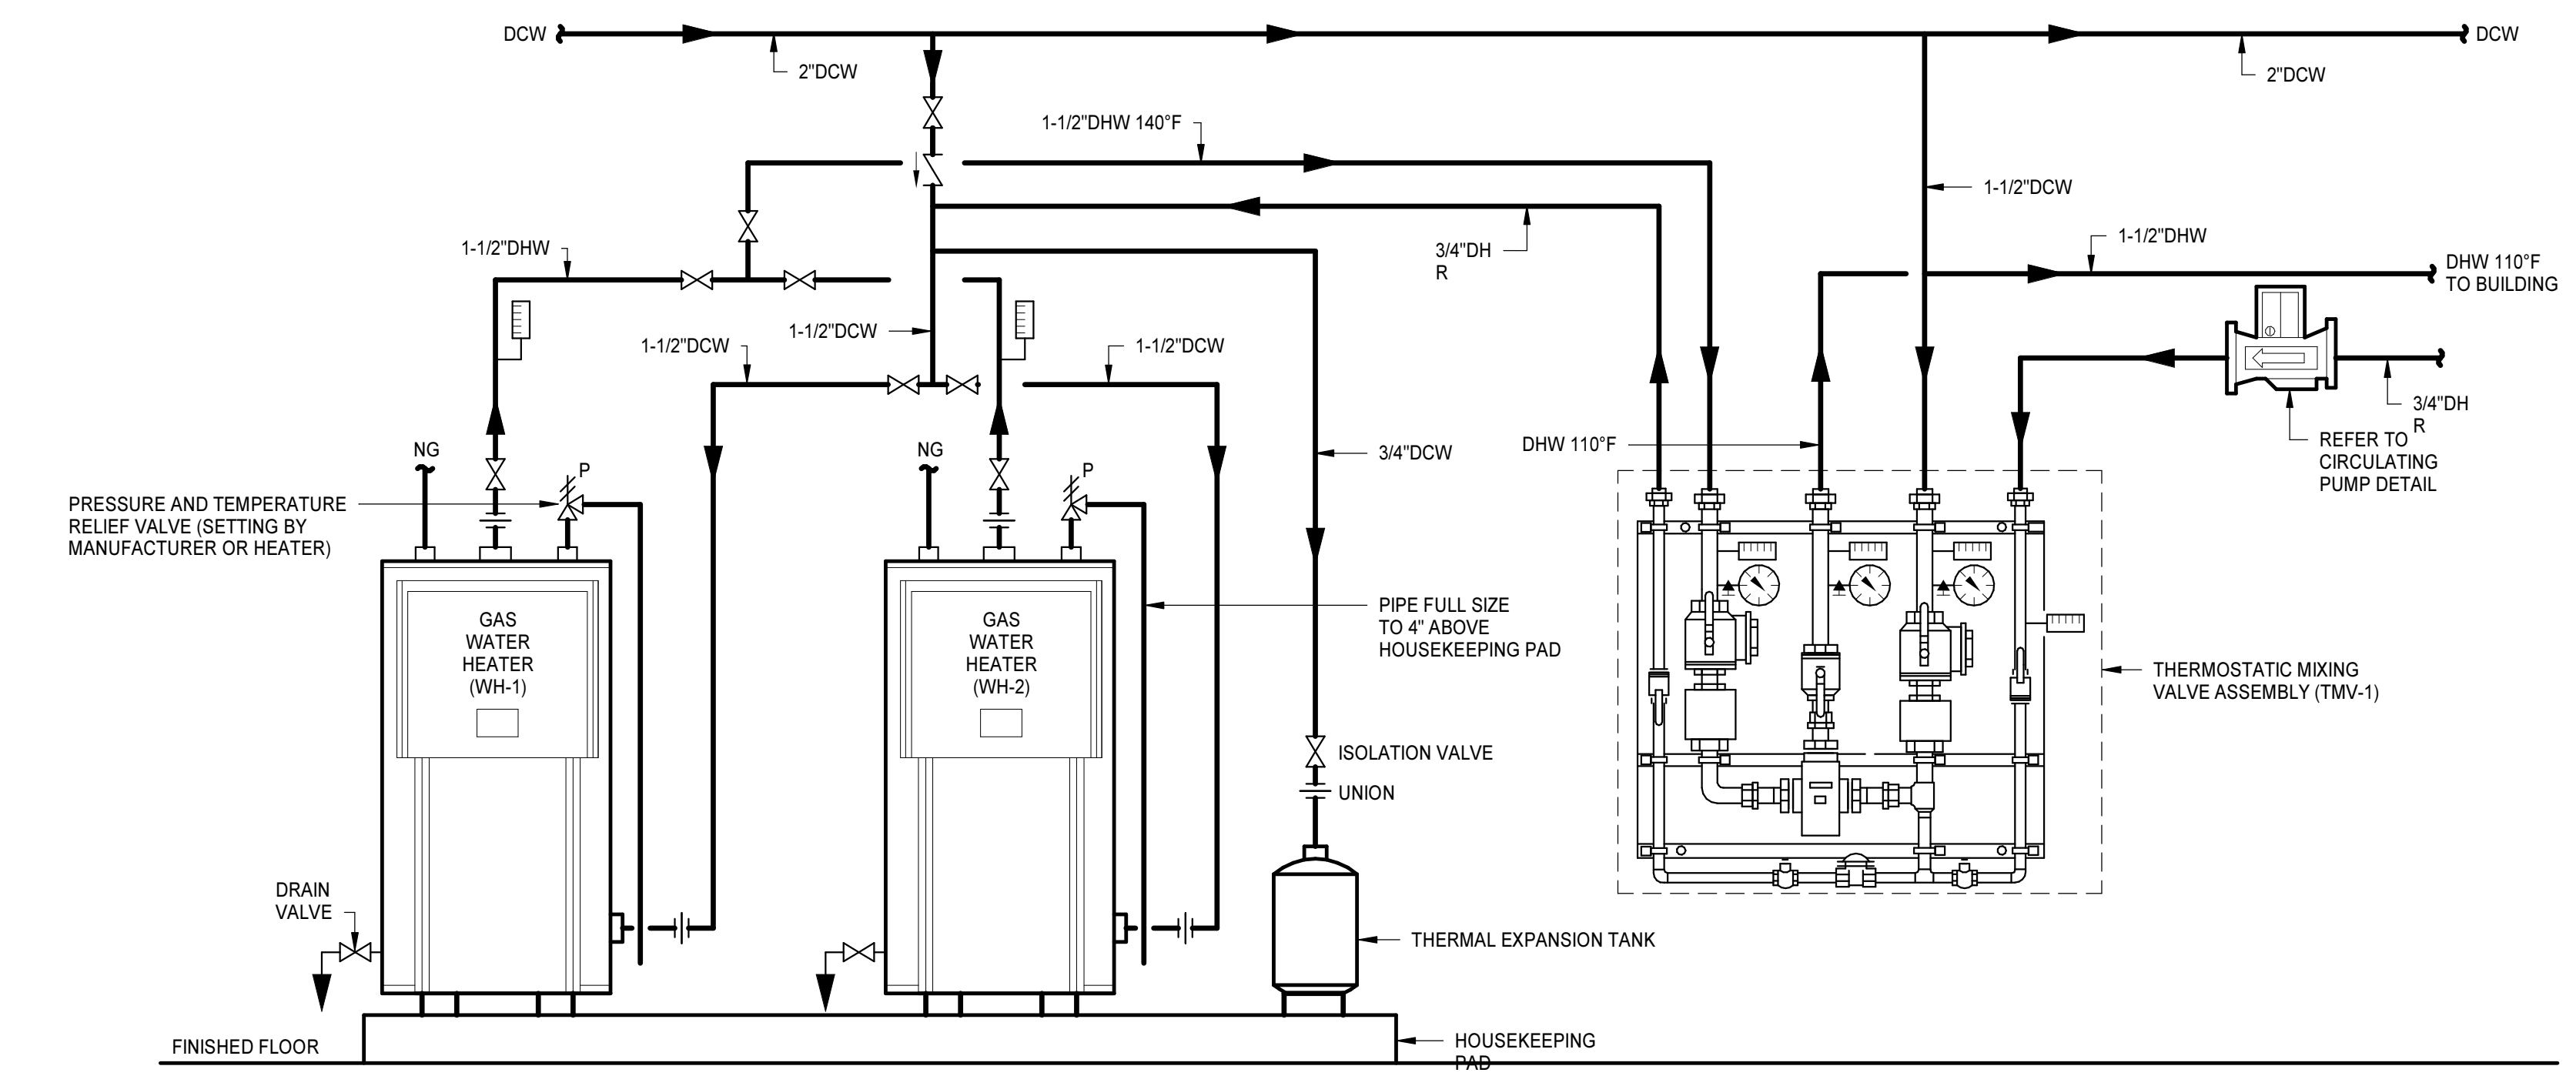


DOMESTIC WATER HEATER DETAIL
 NO SCALE

NOTES:
 1. REFER TO GAS CONNECTION AND GAS PIPE CONNECTION DETAILS AND MANUFACTURER'S RECOMMENDATIONS FOR FINAL GAS EQUIPMENT CONNECTIONS, PRESSURE REQUIREMENTS, AND FLOW REQUIREMENTS.
 2. WHERE WATER HEATERS ARE MANIPULATED TOGETHER IN PARALLEL REFER TO MANUFACTURER'S RECOMMENDED INSTALLATION PIPING ARRANGEMENTS AND PROVIDE EQUAL LEG PIPING FOR INLET AND OUTLET MANIFOLD PIPING OR ALTERNATIVE APPROVED METHOD FOR BALANCING FLOW AND PRESSURE TO AND FROM EACH HEATER.

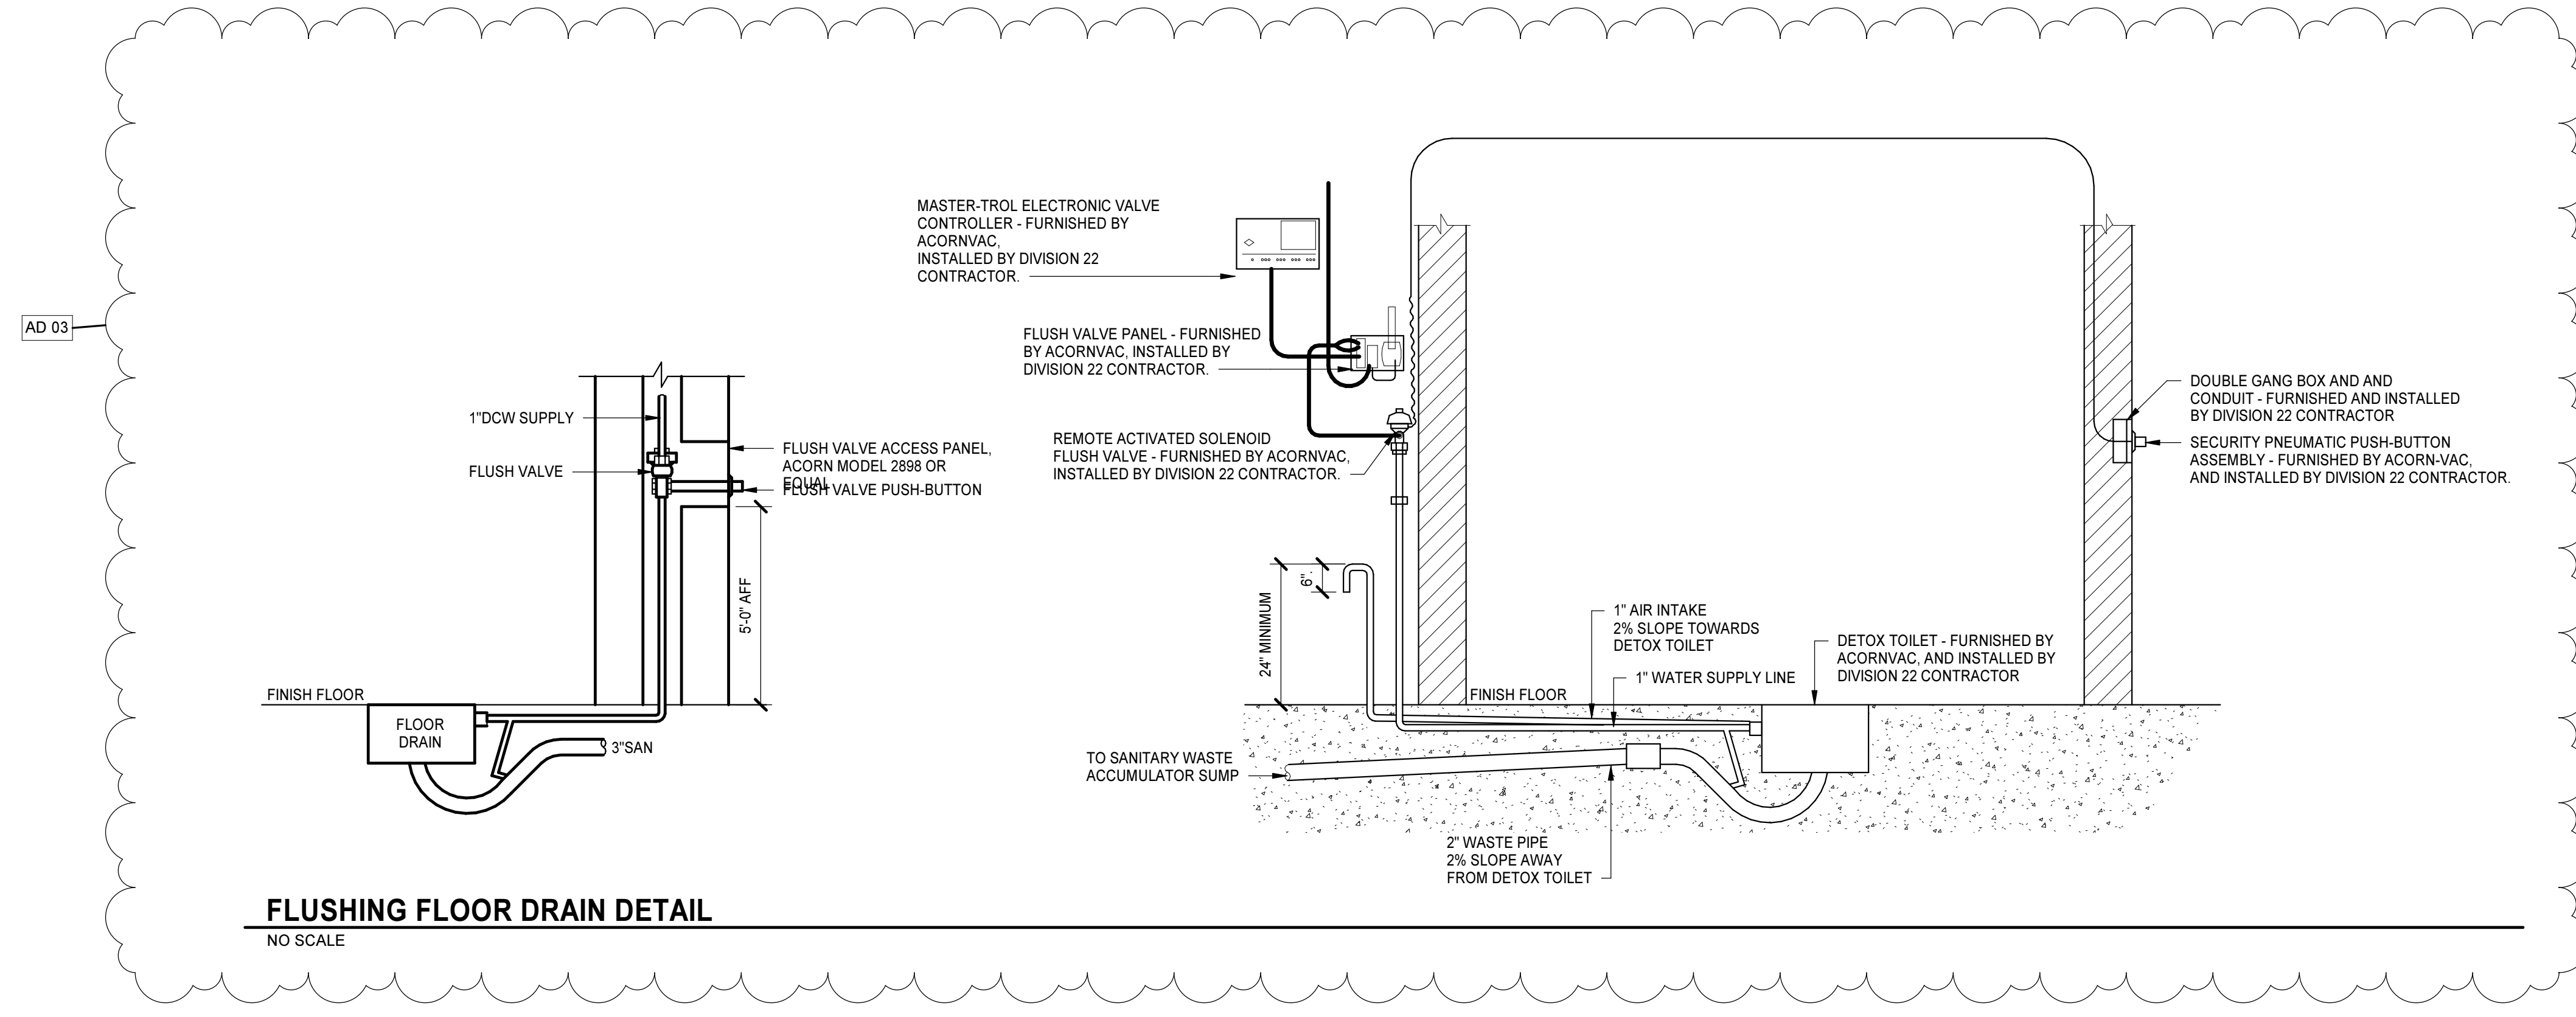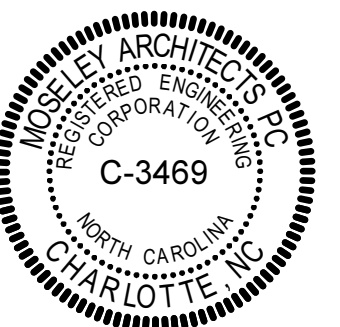


FLUSHING FLOOR DRAIN DETAIL
 NO SCALE

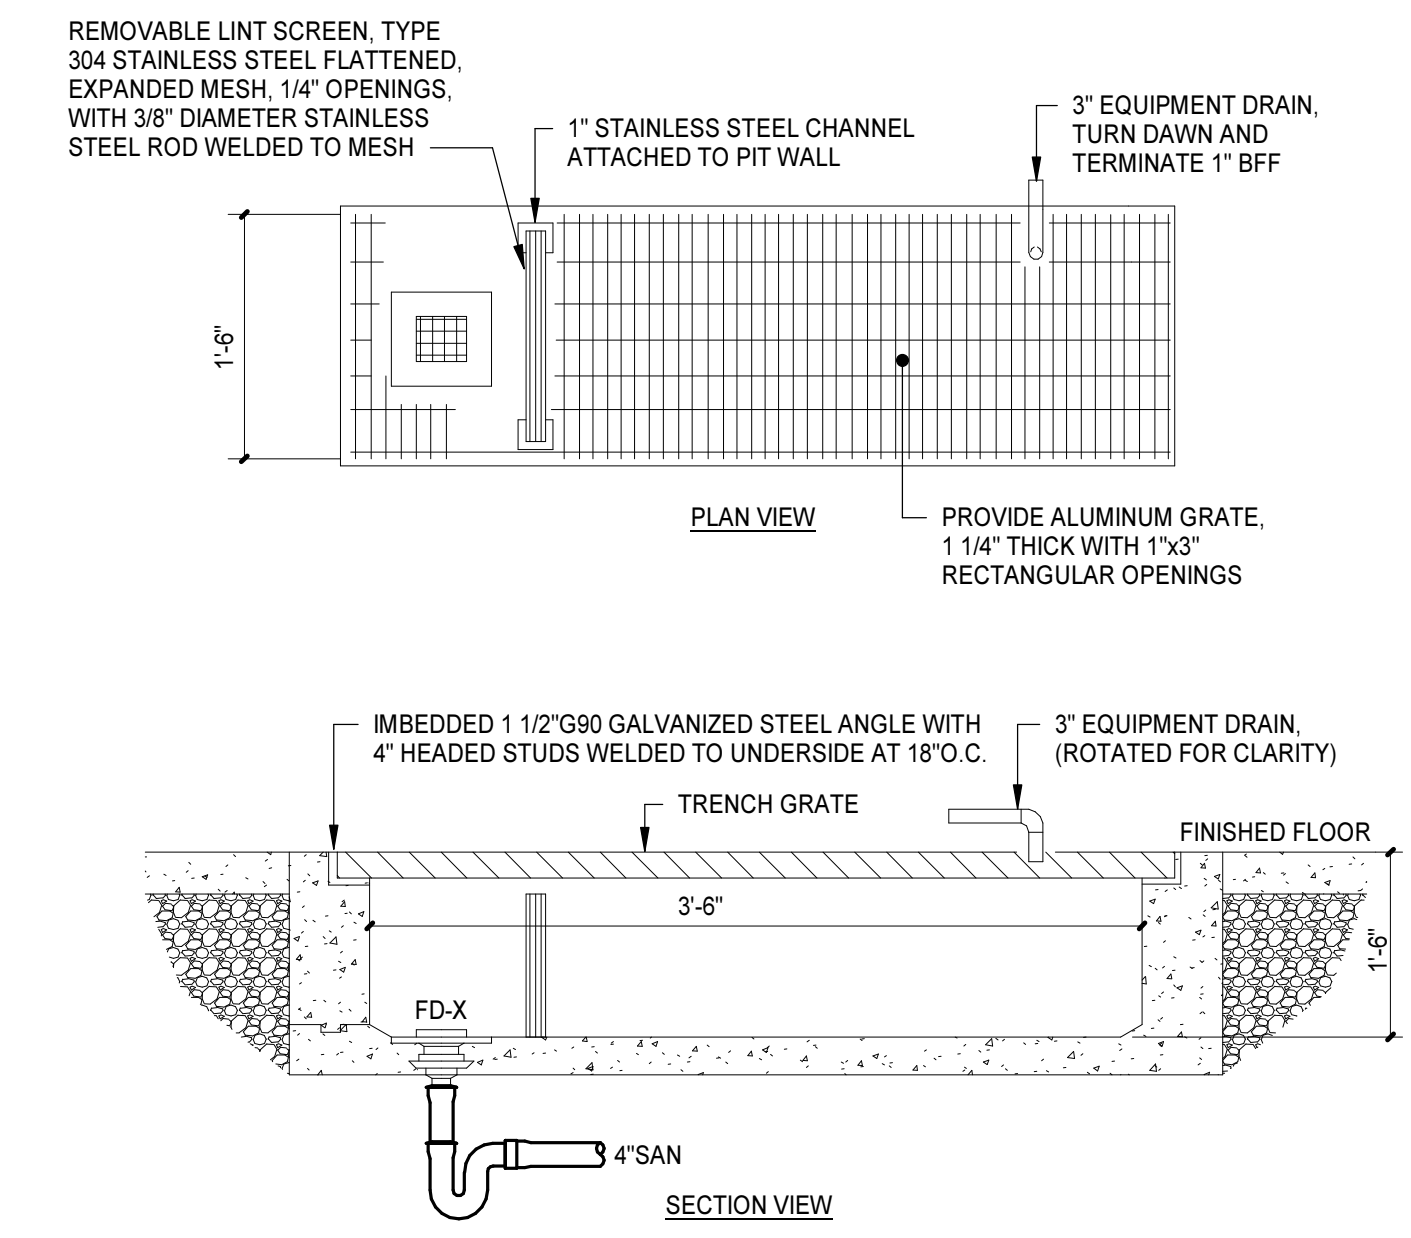


LAUNDRY EXTRACTOR TRENCH DRAIN DETAIL
 NO SCALE


NOTES:
 1. REFER TO MANUFACTURER'S WRITTEN INSTALLATION PROCEDURES AND RECOMMENDATIONS AND CHECKLIST.
 2. INTERCEPTORS MUST BE INSTALLED IN ACCORDANCE WITH ALL RELEVANT FEDERAL, PROVINCIAL/STATE, AND LOCAL CODES, INCLUDING LOCAL PLUMBING CODE.

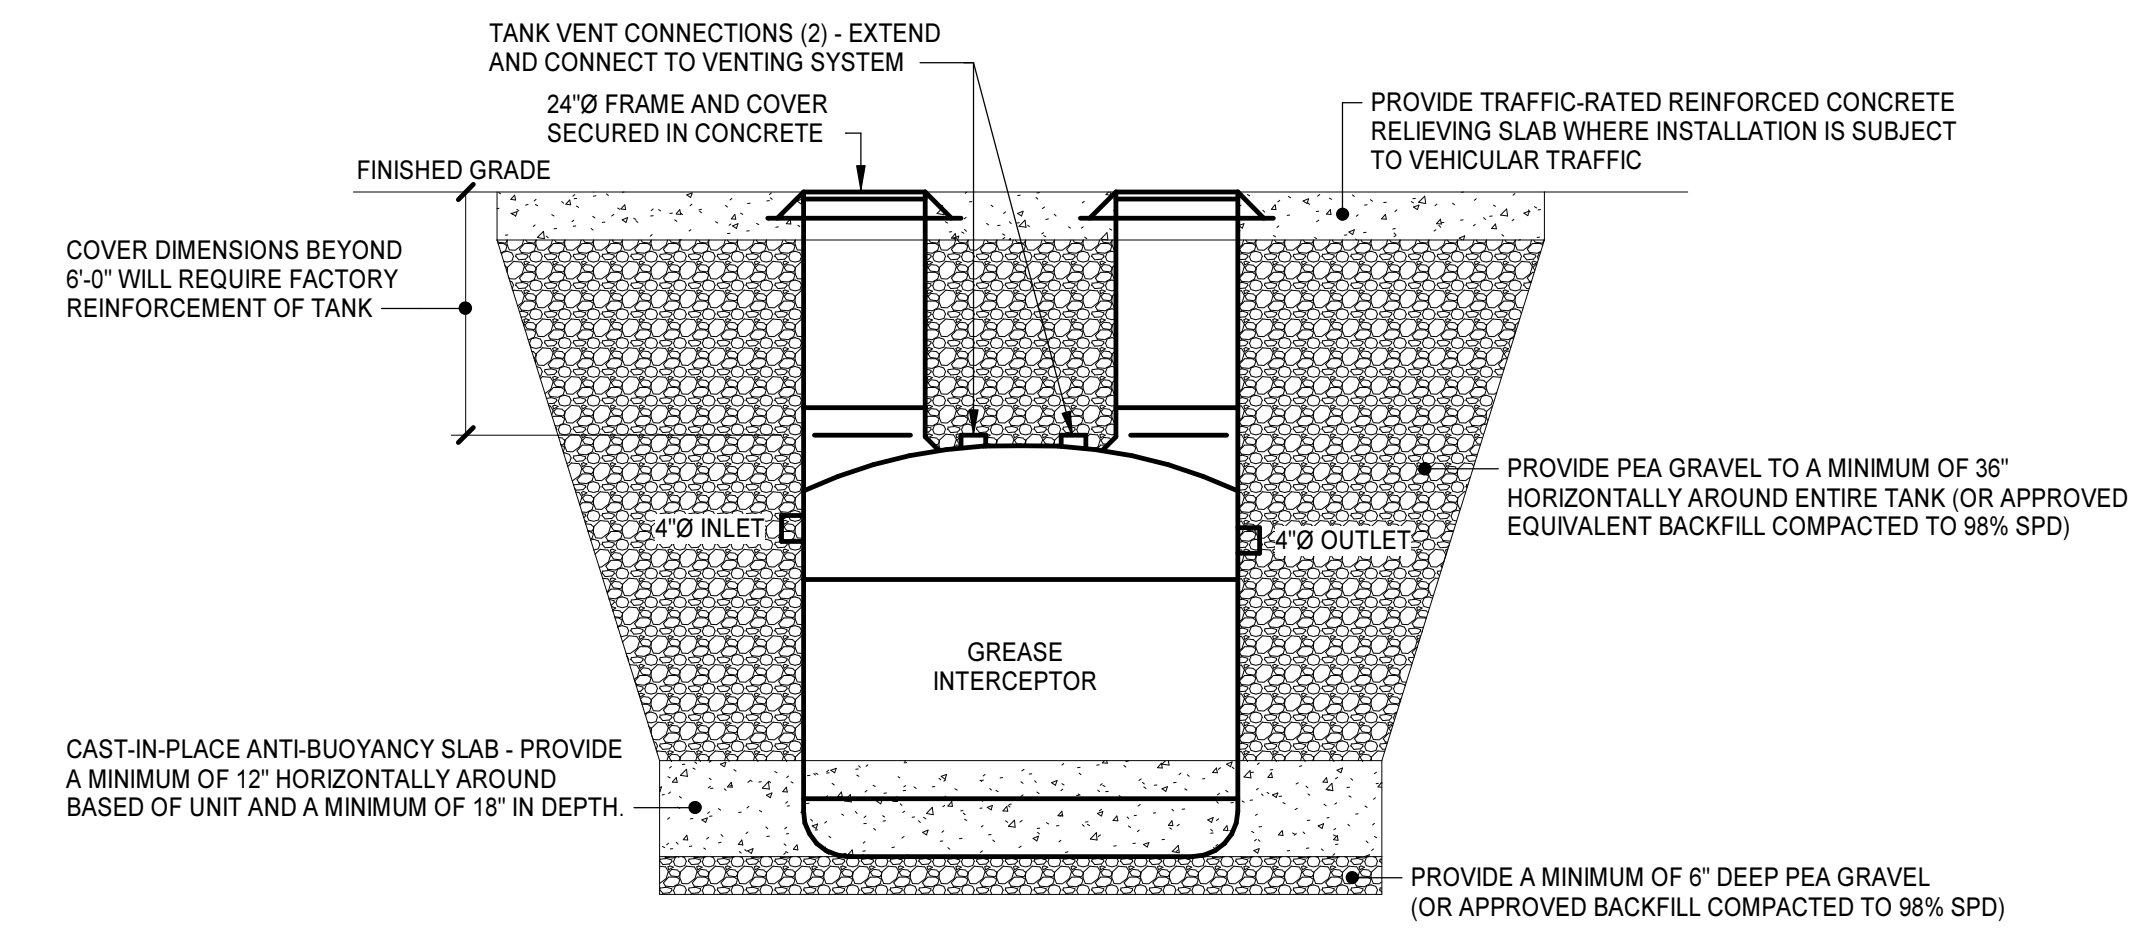


GREASE INTERCEPTER DETAIL
 NO SCALE

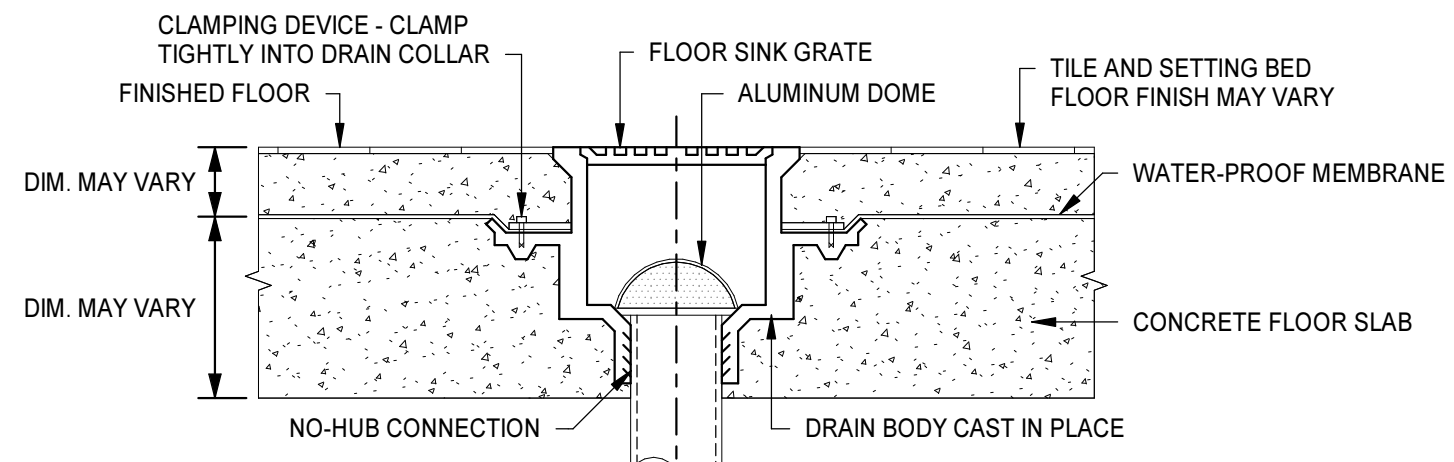


FLOOR SINK DETAIL - FLUSH
 NO SCALE

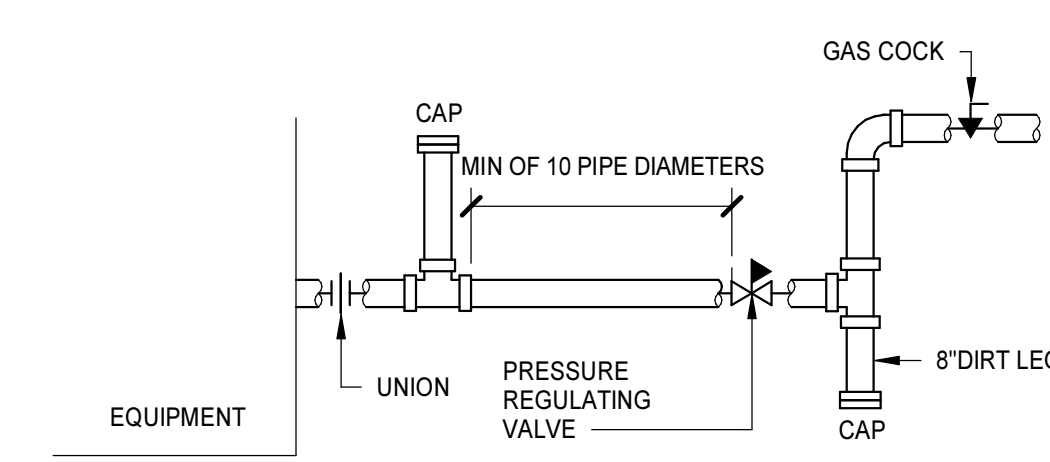

GAS CONNECTION DETAIL
 NO SCALE

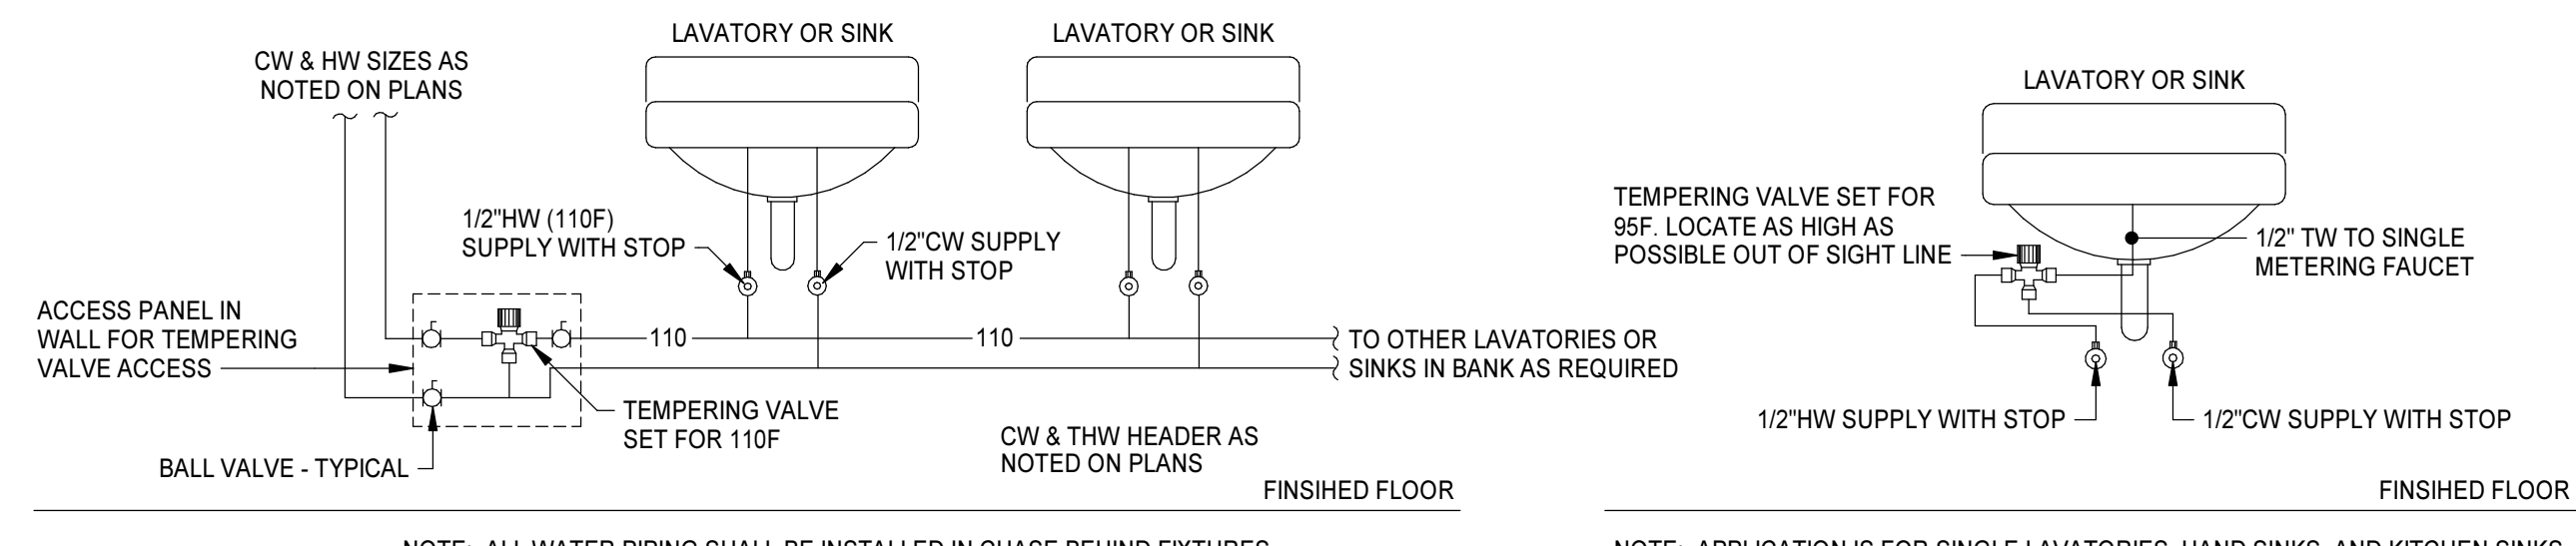


LAVATORY SUPPLY DETAIL
 NO SCALE

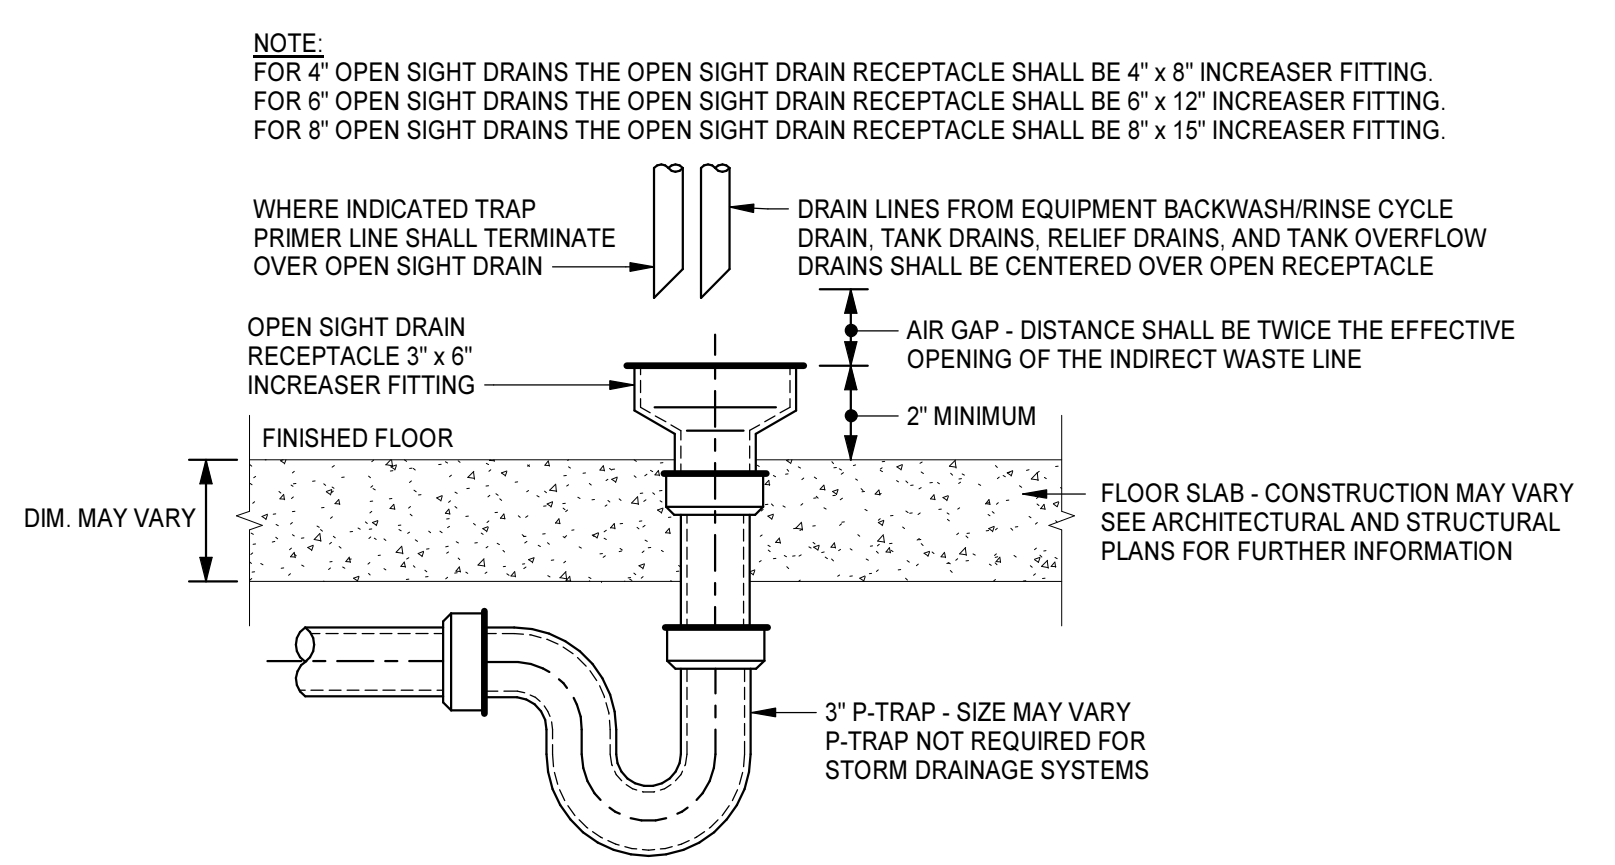

OPEN SIGHT DRAIN DETAIL
 NO SCALE

PROJECT NO:	811888
DATE:	MAY 1, 2024
REVISIONS	
DATE	DESCRIPTION
06/12/2024	AD 03

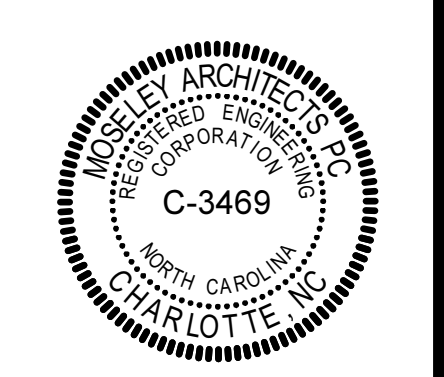

PROJECT NO:	811888
DATE:	MAY 1, 2024
REVISIONS	
DATE	DESCRIPTION
06/12/2024	AD 03

DRAIN AND CLEANOUT SCHEDULE

TAG	BASIS OF DESIGN		STRAINER/GRATE	NOTES
	MANUFACTURER	MODEL		
AD-1	JOSAM	23506-2-VP-X	14" x 14"	2, 3
DSN-1	JOSAM	25010-BS	DOWNSPOUT NOZZLE	
FCO	JOSAM	55000-SS-SD-41-VP-Z	FLOOR CLEANOUT	<varies>
FD-1	JOSAM	30000-SS-PD-2-VP-X	6" ROUND	<varies>
FD-2	JOSAM	32100-SS-81-VP	9" ROUND	2, 3
FS-1	JOSAM	48344A-VP-33-35-X	10" x 10"	HALF GRATE
GCO	JOSAM	55000-SS-SD-41-VP-Z	GROUND CLEANOUT	<varies>
RD-1	JOSAM	21500-3022-VP-X	15" ROUND	3
SRD-1	JOSAM	21500-3-16-22-VP-X	15" ROUND	<varies>
TD-1	JOSAM	76004-7	69" x 6"	
WCO	JOSAM	58910-19	WALL CLEANOUT	

NOTES:
 1. PROVIDE EMERGENCY SECONDARY DRAIN WITH 2" INTEGRAL WATER DAM.
 2. PROVIDE ALL FLOOR DRAINS CONNECTED TO THE SANITARY SEWER SYSTEM WITH TRAP GUARD INSERTS UNLESS OTHERWISE NOTED.
 3. ALL ROOF DRAINS, SANITARY DRAINS AND CLEANOUTS TO HAVE ADJUSTABLE HEIGHT TOP.

PLUMBING FIXTURE SCHEDULE

TAG	FIXTURE	HEIGHT A.F.F.	BASIS OF DESIGN	PIPE SIZE				NOTES
				COLD WATER	HOT WATER	VENT	SOIL WASTE	
EEWS-1	COMBINATION EMERGENCY EYEWASH/SHOWER STATION	FLOOR MOUNTED	FIXTURE: BRADLEY S193148FP8 VALVE: BRADLEY S19-1100 EFX220	1/2"	1/2"	1 1/2"	1 1/2"	
EWC-1	BI-LEVEL WATER COOLER (ACCESSIBLE) w/ BOTTLE STATION	TOP OF BUBBLER AT 34", TRAY AT 34 7/16" A.F.F.	FIXTURE: ELKAY L8TL8VWSSP	1/2"		1 1/2"	1 1/2"	1
HB-1	HOSE BIBB	CENTERLINE OF OUTLET AT 18"	FIXTURE: ZURN Z1341-XL	3/4"				
LA-1	WALL-HUNG LAVATORY (ACCESSIBLE) WITH MANUALLY-OPERATED FAUCET	RIM AT 34"	FIXTURE: ZURN Z5310 FAUCET: ZURN 81101XL-G-HCT-25M	1/2"	1/2"	1 1/2"	1 1/2"	1, 3
LA-2	COUNTER MOUNTED LAVATORY (ACCESSIBLE) WITH MANUALLY-OPERATED FAUCET	COUNTER MOUNTED REFER TO ARCH DRAWINGS	FIXTURE: ZURN Z5110 FAUCET: ZURN 81101XL-G-HCT-25M	1/2"	1/2"	1 1/2"	1 1/2"	1, 3
MB-1	MOP BASIN (36" x 36")	RIM AT 12"	FIXTURE: FIKT T583002 FAUCET: ZURN ZK3M1-XL-CS-HCT	3/4"	3/4"	2"	3"	
RH-1	ROOF HYDRANT (FREEZE-RESISTANT)	ROOF DECK	FIXTURE: ZURN Z1383XL-AC-VB	3/4"				
SH-1	INDIVIDUAL SHOWER (ACCESSIBLE)	CONTROLS AT 42", SHOWERHEAD AT 72"	VALVE: ZURN Z7301-SS-MT-DV2P-HW-H9-S9	1/2"	1/2"	2"	2"	1, 4
SH-2	INDIVIDUAL SHOWER (ACCESSIBLE)	CONTROLS AT 42", SHOWERHEAD AT 72"	VALVE: ZURN Z7301-SS-MT-DV2P-HW-H9-S9	1/2"	1/2"	2"	2"	1, 4
SH-3	INDIVIDUAL SHOWER	CONTROLS AT 42", SHOWERHEAD AT 78"	VALVE: ZURN Z7301-SS-MT-DV2P-HW-H9-S9	1/2"	1/2"	2"	2"	1, 4
SK-1	SINK - SINGLE BASIN	COUNTER MOUNTED REFER TO ARCH DWGS	FIXTURE: ELKAY LRAD-221855 FAUCET: ZURN Z8230D-XL-CP4-3M	1/2"	1/2"	1 1/2"	1 1/2"	1, 3
SK-2	UTILITY SINK	RIM AT 30"	FIXTURE: ELKAY WNSF81902 FAUCET: ZURN Z8230D-XL-HCT-3F	1/2"	1/2"	1 1/2"	1 1/2"	1, 3
SK-3	ARMORY SINK	RIM AT 28"	FIXTURE: ELKAY ESSW2118C FAUCET: ZURN Z843M-XL-CS-HCT	1/2"	1/2"	1 1/2"	1 1/2"	1, 3
UR-1	URINAL (ACCESSIBLE)	RIM AT 17"	FIXTURE: ZURN Z5735	3/4"		2"	2"	1
WC-1	FLOOR MOUNTED WATER CLOSET (ACCESSIBLE)	TOP OF SEAT 17"	FIXTURE: ZURN Z5655-BWL1-AM VALVE: ZURN Z8000AV-HET	1"		2"	4"	1, 2
WC-2	FLOOR MOUNTED WATER CLOSET	TOP OF SEAT 15"	FIXTURE: ZURN Z5655-BWL1-AM VALVE: ZURN Z8000AV-HET	1"		2"	4"	2
WH-1	WALL HYDRANT	CENTERLINE OF OUTLET AT 18"	FIXTURE: ZURN Z1320XL-CL-WC	3/4"				
WSB-1	ICE MAKER OUTLET BOX	BOTTOM AT 8"	FIXTURE: ZURN Z1320XL-CL-WC	1/2"				

NOTES:
 1. THIS ACCESSIBLE FIXTURE, ACCESSORIES AND INSTALLATION SHALL CONFORM TO THE USBC AND ASAD ADA STANDARDS FOR ACCESSIBLE DESIGN.
 2. LOCATE FLUSH ACTUATORS ON WIDE SIDE OF STALLS OR APPROACH AREAS.
 3. PROVIDE ASSE-1070 CERTIFIED MIXING VALVE IN STAINLESS STEEL WALL CABINET, ABOVE CEILING, OR BELOW FIXTURE ACCESSIBLE BUT CONCEALED FROM VIEW.
 4. PROVIDE ASSE-1019 CERTIFIED MIXING VALVE.
 5. PROVIDE ASSE-1071 CERTIFIED EMERGENCY MIXING VALVE IN STAINLESS STEEL WALL CABINET.
 6. PROVIDE DISHWASHER HOOK-UP WHERE DISHWASHER IS PRESENT, CONNECT HW IN SINK BASE AND CONNECT SANITARY THRU AIR GAP FITTING OR HIGH LOOP HOSE DRAIN INTO DISHWASHER TAIL PIECE SINK DRAIN.

GAS WATER HEATER SCHEDULE

TAG	BASIS OF DESIGN		LOCATION	CAPACITY (GALLONS)	RECOVERY RATE (GPH)	TEMPERATURE RISE (°F)	TEMPERATURE SETTING (°F)	TYPE	FUEL DATA		ELECTRICAL DATA			NOTES
	MANUFACTURER	MODEL							INPUT RATE (BTUH)	MAX INLET PRESSURE (INCHES W.C.)	VOLTAGE	PHASE	HERTZ	
GWH-1	A.O. SMITH	CYCLONE LARGE VOLUME BTHL-250	MECHANICAL KL111	250	285	100	160	NATURAL GAS	250,000	14.00	120	1	60	1
GWH-2	A.O. SMITH	CYCLONE LARGE VOLUME BTHL-250	MECHANICAL KL111	250	285	100	160	NATURAL GAS	250,000	14.00	120	1	60	1
GWH-3	A.O. SMITH	CYCLONE LARGE VOLUME BTHL-250	MECHANICAL KL111	250	285	100	160	NATURAL GAS	250,000	14.00	120	1	60	1
GWH-4	A.O. SMITH	CYCLONE LARGE VOLUME BTHL-250	MECHANICAL KL111	250	285	100	160	NATURAL GAS	250,000	14.00	120	1	60	1
GWH-5	A.O. SMITH	CYCLONE MXI BTH-150A	JAN 177	100	223	80	140	NATURAL GAS	150,000	14.00	120	1	60	1
GWH-6	A.O. SMITH	CYCLONE MXI BTH-150A	JAN 177	100	223	80	140	NATURAL GAS	150,000	14.00	120	1	60	1

1. PROVIDE PARALLEL INSTALLATIONS WITH PRECISION CUT EQUAL LEG PIPING, REVERSE-RETURN MANIFOLD PIPING, OR MANUFACTURER'S MANIFOLD INSTALLATION KIT. REFER TO MANUFACTURER'S INSTALLATION REQUIREMENTS AND RECOMMENDATIONS.

TANK SCHEDULE

TAG	BASIS OF DESIGN		LOCATION	SYSTEM TYPE	TANK TYPE	OPERATING DATA			CONNECTION SIZE		NOTES	
	MANUFACTURER	MODEL				CAPACITY (GAL)	AIR PRE-CHARGE PRESSURE (PSI)	ASME CODE CONSTRUCTION (YES/NO)	INLET (IN)	OUTLET (IN)		
ET-1	AMTROL	THERM-X-TROL ST-120V-C	MECHANICAL KL111	DHW	EXPANSION	68.00	35.00	55.00	YES	1 1/4"	1 1/4"	1
ET-2	AMTROL	THERM-X-TROL ST-30V-C-DD	JAN 177	DHW	EXPANSION	14.00	9.00	55.00	YES	3/4"	3/4"	1

1. REFER TO MANUFACTURER'S RECOMMENDATIONS FOR FINAL PIPING ARRANGEMENT.

ELECTRIC WATER HEATER SCHEDULE

TAG	BASIS OF DESIGN		LOCATION	CAPACITY (GALLONS)	RECOVERY RATE (GPH)	TEMPERATURE RISE (°F)	TEMPERATURE SETTING (°F)	INPUT RATE (KW)	ELECTRICAL DATA			NOTES
	MANUFACTURER	MODEL							VOLTAGE	PHASE	HERTZ	
EWH-1	AO SMITH	DEN-40	SRT STORAGE W103	40	24	100	140	6	480	3	60	

SECURITY PLUMBING FIXTURE SCHEDULE

TAG	FIXTURE	HEIGHT A.F.F.	BASIS OF DESIGN	PIPE SIZE				NOTES
				COLD WATER	HOT WATER	VENT	SOIL WASTE	
S-1A	PENAL COMBINATION FIXTURE (ACCESSIBLE)	TOP OF SEAT AT 17"-19"	FIXTURE: WILLOUGHBY 4886 SERIES	1/2"	1/2"	2"	4"	<varies>
S-1B	PENAL COMBINATION FIXTURE	TOP OF SEAT AT 15"	FIXTURE: WILLOUGHBY 1546 SERIES	1/2"	1/2"	2"	4"	<varies>
S-1C	FLOOR MOUNTED PENAL WATER CLOSET (ACCESSIBLE)	TOP OF SEAT AT 17"-19"	FIXTURE: WILLOUGHBY ETW-1490-FM	1"	1/2"	2"	4"	<varies>
S-1D	PENAL COMBINATION FIXTURE (ACCESSIBLE)	TOP OF SEAT AT 17"-19"	FIXTURE: WILLOUGHBY 1545 SERIES	1/2"	1/2"	2"	1 1/2"	<varies>
S-2A	SHOWER (ACCESSIBLE)	CONTROLS AT 42", SHOWERHEAD AT 72"	FIXTURE: WILLOUGHBY WRS-FA-ADA-WH SERIES	1/2"	1/2"	1 1/2"	2"	1, 3, 4
S-2B	SHOWER	CONTROLS AT 42", SHOWERHEAD AT 72"	FIXTURE: WILLOUGHBY WRS-FA SERIES	1/2"	1/2"	1 1/2"	2"	3, 4
S-3A	WALL MOUNTED PENAL LAVATORY FIXTURE (ACCESSIBLE)	RIM AT 33"	FIXTURE: WILLOUGHBY ES-1015-HC	1/2"	1/2"	1 1/2"	1 1/2"	<varies>
S-DT1	IN FLOOR REMORE FLUSH DETOX TOILET	FLOOR MOUNTED	FIXTURE: WILLOUGHBY FD-1400	1 1/2"	1/2"	2"	3"	

NOTES:
 1. THIS ACCESSIBLE FIXTURE, ACCESSORIES AND INSTALLATION SHALL CONFORM TO THE USBC AND ASAD ADA STANDARDS FOR ACCESSIBLE DESIGN.
 2. PROVIDE PNEUMATIC CONCEALED ACCESSIBLE PUSH-BUTTON WATER CLOSET FLUSH VALVE. PROVIDE WHA-A FOR EACH CELL FIXTURE.
 3. PROVIDE PNEUMATIC METEERING VALVE ASSEMBLY WITH LIGATURE-RESISTANT PUSH BUTTONS. COORDINATE EXACT LOCATIONS WITH PLANS AND SCHEDULES.
 4. PROVIDE ASSE 1060 CERTIFIED MIXING VALVE.

INTERCEPTOR AND SEPERATOR SCHEDULE

TAG	BASIS OF DESIGN		LOCATION	OPERATING DATA			ELECTRICAL DATA			CONNECTION SIZE		NOTES
	MANUFACTURER	MODEL		FLOW (GPM)	CAPACITY (GALLONS)	CONTAMINATE RETENTION VOLUME (GAL)	VOLTAGE	PHASE	HERTZ	INLET (IN)	OUTLET (IN)	
GI-1	SCHIER	GB-1000	BELOW GRADE	100	1000	789	120	1	60	4"	4"	
OI-1	STRIEM	OS-50	BELOW GRADE	50	57	40	120	1	60	4"	4"	

NOTES:
 1. PROVIDE GREASE INTERCEPTOR UNIT WITH FOGS MONITORING ALARM SYSTEM WITH REMOTE LOCATED PANEL.
 2. PROVIDE INTERCEPTOR WITH CONCRETE ANCHORING PAD, DEADMAN ANCHORS, OR MANUFACTURER RECOMMENDED ANCHORING METHOD AND ALL ASSOCIATED INSTALLATION ACCESSORIES.
 3. PROVIDE INTERCEPTOR WITH CONCRETE RELIEVING SLAB AND TRAFFIC-RATED COVERS AND ACCESSORIES FOR INSTALLATIONS SUBJECT TO VEHICULAR TRAFFIC.
 4. PROVIDE INTERCEPTOR WITH PUMPED REMOTE DRAW-OFF. VERIFY FINAL INSTALLATION DOES NOT EXCEED RISE AND RUN LIMITATIONS OF PUMPED REMOTE DRAW-OFF SYSTEM.

INSULATION SCHEDULE

SERVICE	LOCATION	TEMPERATURE	INSULATION	JACKETING	WEATHERPROOFING	MINIMUM INSULATION THICKNESS	NOTES
						PIPES SIZE (IN)	THICKNESS (IN)
DOMESTIC COLD WATER	INDOORS	40°F - 60°F	ELASTOMERIC	ASJ	NONE	0.50-1.00	1.00
DOMESTIC HOT WATER AND HOT WATER RETURN	INDOORS	100°F - 200°F	MOLDED FIBERGLASS	ASJ	NONE	0.50-1.00	1.00
						1.25-1.50	1.50
						2.00-4.00	2.00
						0.50-1.00	1.00
						1.25-1.50	1.50
						2.00-4.00	2.00
TEPID WATER AND TEPID WATER RETURN	INDOORS	60°F - 90°F	MOLDED FIBERGLASS	ASJ	NONE	0.50-1.00	1.00
STORM DRAINAGE	INDOORS	40°F - 60°F	MOLDED FIBERGLASS	ASJ	NONE	2.00-12.00	1.00
EXTERIOR DOMESTIC COLD WATER	OUTDOORS	40°F - 60°F	MOLDED FIBERGLASS	ASJ	ALUMINUM JACKET	0.50-4.00	2.00
HEAT EXCHANGER	INDOORS	250°F	CALCIUM SILICATE	ALUMINUM JACKET	NONE	N/A	N/A

1. PROVIDE INSULATION FOR INDOOR HORIZONTAL STORM DRAINAGE PIPING INCLUDING DRAIN BODY AND OVERFLOW SECONDARY STORM PIPING.
 2. PROVIDE OUTDOOR PIPING EXPOSED TO FREEZE CONDITIONS, TO RECEIVE HEAT TRACING, INSULATION, AND ALUMINUM JACKETING.
 3. REFER TO SPECIFICATIONS FOR FIELD APPLIED INSULATION.

THERMOSTATIC MIXING VALVE SCHEDULE

TAG	BASIS OF DESIGN		DESIGN FLOW (GPM)	FLOW RANGE (GPM)	MAX P.D. AT DESIGN FLOW	HW SYSTEM TEMPERATURES		CONNECTION SIZES		NOTES
	MANUFACTURER	MODEL				INLET	OUTLET	INLET	OUTLET	
TMV-1	POWERS	LFSH1434TV-AEQ0	100	0.5 - 400	10 PSI	160°F	120°F	2.5	4	2
TMV-2	POWERS	LFSH1435	50	0.5 - 201	10 PSI	160°F	140°F	2	2	2
TMV-3	BRADLEY	S19-2250-RS (EFX50)	5.1 - 22.0	3.0 - 27.0	10 PSI	120°F	85°F	1.5	1.5	1
TMV-4	POWERS	LFSH1434	28	0.5 - 42	5 PSI	160°F	120°F	0.75	0.75	2

1. PROVIDE THERMOSTATIC MIXING VALVE ASSEMBLY WITH LOCKABLE, STAINLESS STEEL, RECESSED WALL MOUNTED CABINET AND TIP GAUGES ON INLETS AND OUTLET.
 2. INSTALL THERMOSTATIC MIXING VALVE ASSEMBLY ON WALL MOUNTED STEEL SUPPORT RACK.

PUMP SCHEDULE

TAG	BASIS OF DESIGN		LOCATION	SYSTEM TYPE	AREA SERVED	PUMP TYPE	OPERATING DATA				ELECTRICAL DATA			CONNECTION SIZE		NOTES	
	MANUFACTURER	MODEL					FLOW (GPM)	MAX DISCHARGE PSI	EFFICIENCY/ ENCLOSURE	POWER (HP)	SPEED (RPM)	VOLTS	PHASE	HERTZ	INLET (IN)		OUTLET (IN)
DWP-1	HYFAB	MVP-850-460	KL111 MECHANICAL	DOMESTIC WATER	MAIN BUILDING	BOOSTER	240	165	ODP	5.00 (X2)	3500	460	3	60	4.00	4.00	1
RCP-1	GRUNDFOS	MAGNA3 40-80 F N	KL111 MECHANICAL	HOT WATER (120F) RECIRCULATION	MAIN BUILDING	CIRCULATION	25.00	20.00	16%	0.389	VARI	120	1	60	1.25	1.25	
RCP-2	GRUNDFOS	MAGNA3 40-80 F N	KL111 MECHANICAL	HOT WATER (140F) RECIRCULATION	KITCHEN / LAUNDRY	CIRCULATION	5.00	6.11	16%	0.389	VARI	120	1	60	0.75	0.75	
RCP-3	GRUNDFOS	MAGNA3 40-80 F N	JAN 177	HOT WATER (120F) RECIRCULATION	911 AREA	CIRCULATION	25.00	20.00	16%	0.389	VARI	120	1	60	0.75	0.75	

1. PROVIDE PACKAGED DUPLEX VARIABLE SPEED DOMESTIC WATER BOOSTER PUMP ASSEMBLY WITH EACH PUMP SIZED FOR 100% OF THE INDICATED OPERATING FLOW WITH VFD CONTROL. EACH PUMP SIZED FOR 262 GPM AT 78" TDH 20PSI BOOST WITH AN OUTLET PRESSURE SETTING OF 50PSI MAXIMUM TO THE BUILDING DOMESTIC WATER SYSTEM.

